
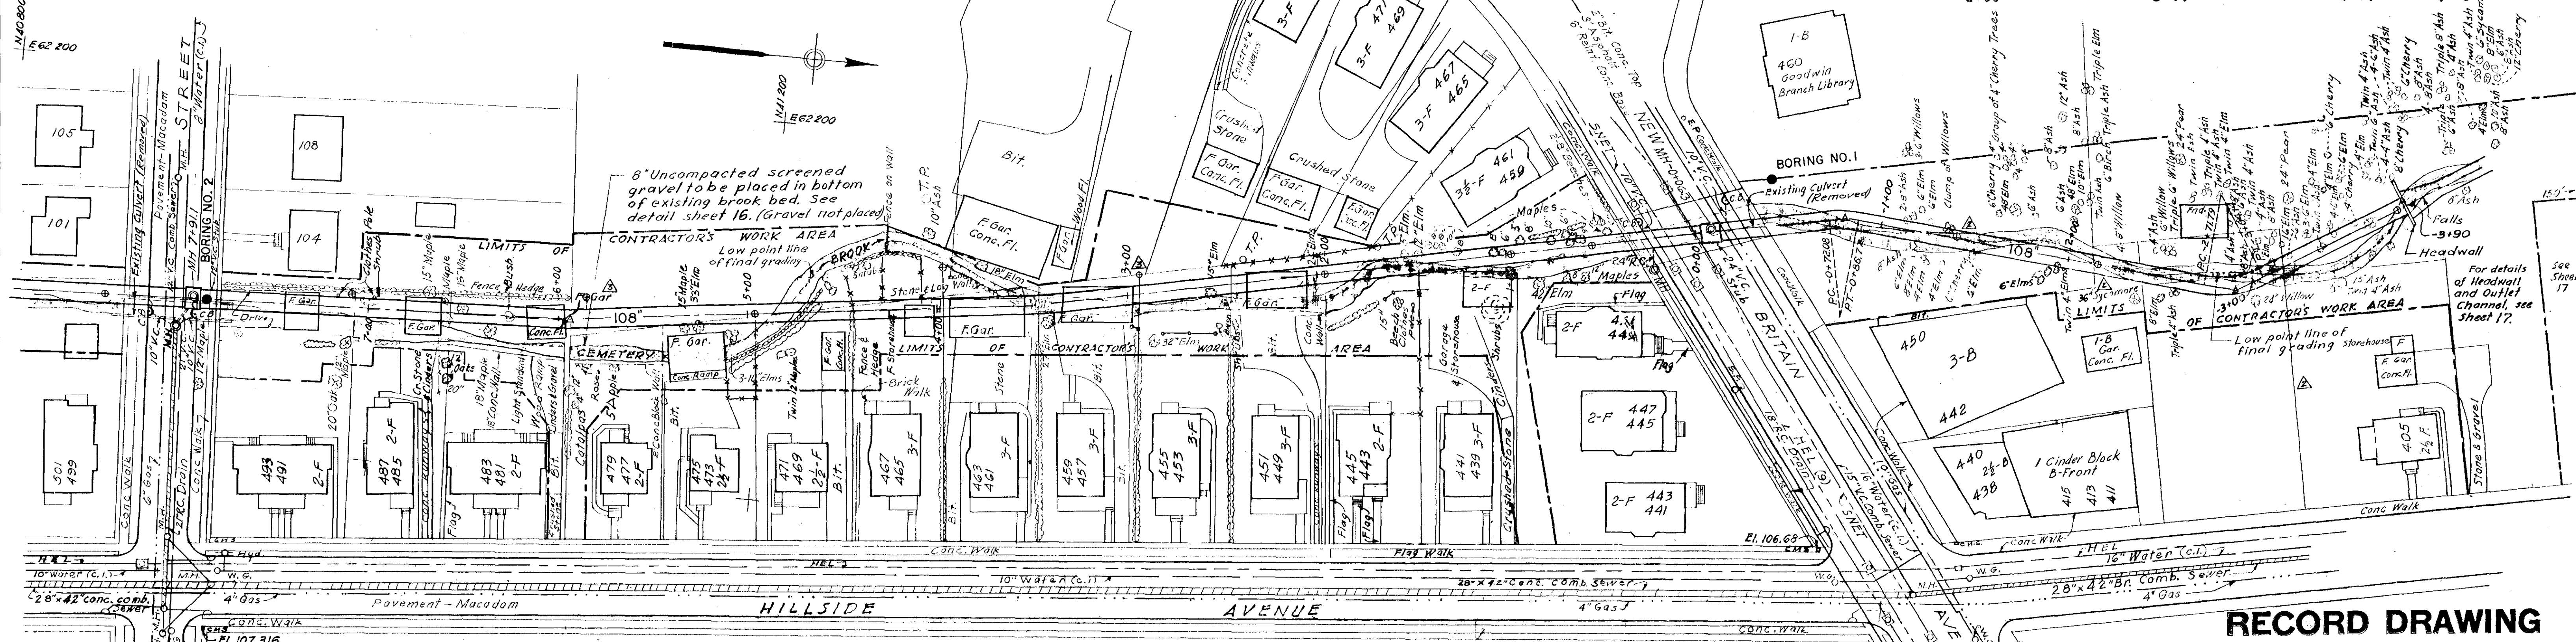


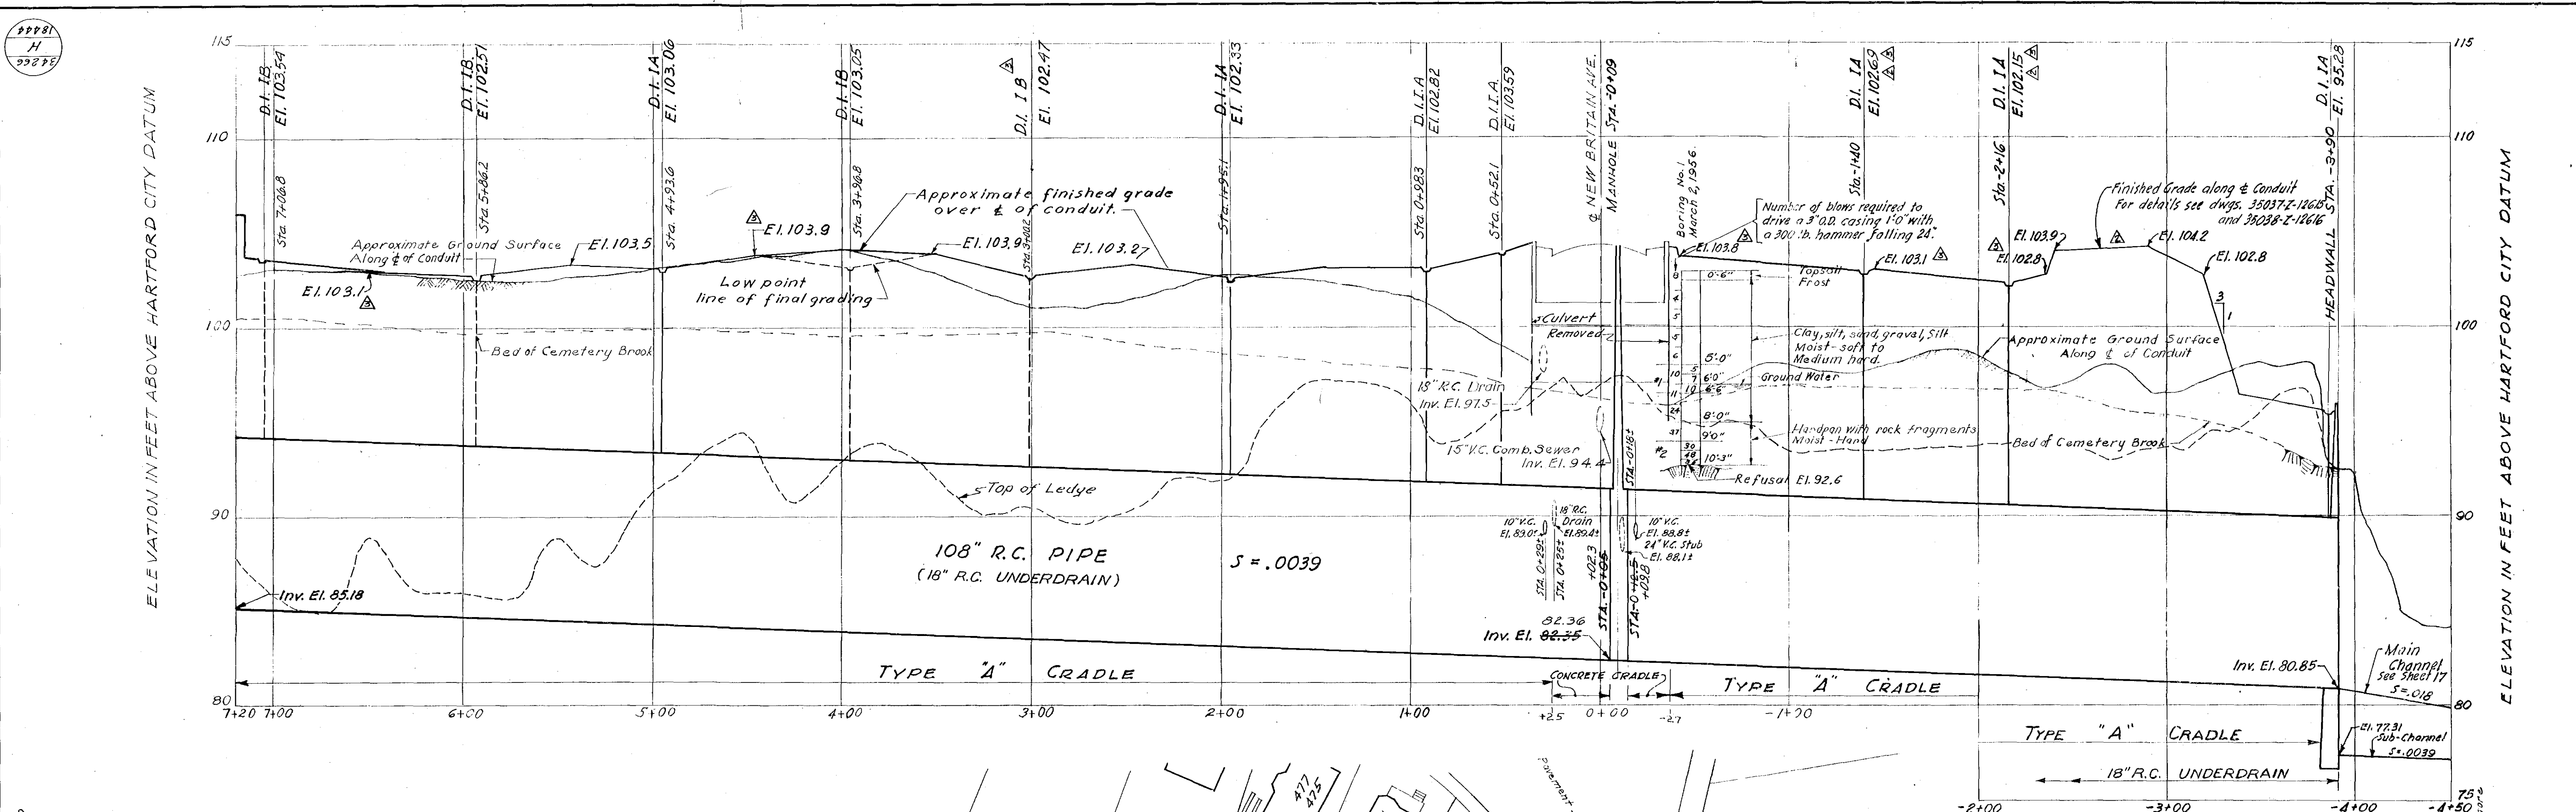

NOTES:

1. For location and bearings of conduit centerline see Sheet 11.
2. Layout of Limits of Contractor's Work Area shown on Sheet 11.
3. Most trees and shrubbery shown were removed to facilitate construction. Replantings not shown.
4. Concrete supports under all utilities crossing conduit trench. See sheets 16 and 19.

REVISION	MADE BY	CHECKED BY	DESCRIPTION
1	Jan. 1960	J.J.K.	S.A.H.
2	Apr. 9, 1958	A.J.P.	R.L.R.
3	Oct. 23, 1957	A.J.P.	R.H.L.
4	July 1, 1957	L.S.B.	S.A.H.

APPROVED

FOR PARK RIVER FLOOD CONTROL COMMISSION

Director: *John W. Raymond* DATE: *5/10/57*

REG. PROF. ENGR. CT. NO. 290

FOR METCALF & EDDY, ENGINEERS

REG. PROF. ENGR. CT. NO. 3422 DATE: *5/10/57*

RECORD DRAWING

PARK RIVER FLOOD CONTROL COMMISSION
HARTFORD, CONNECTICUT

CEMETERY BROOK CONDUIT

PLAN & PROFILE

STA. -4+00 TO STA. 7+20

SCALE, HOR. 1" = 40' VERT. 1" = 4'

METCALF & EDDY
ENGINEERS
BOSTON, MASS.

34266
H
18444

DRAWN BY: *S.A.H.*
TRACED BY: *M.C.*
CHECKED BY: *R.H.L.*