



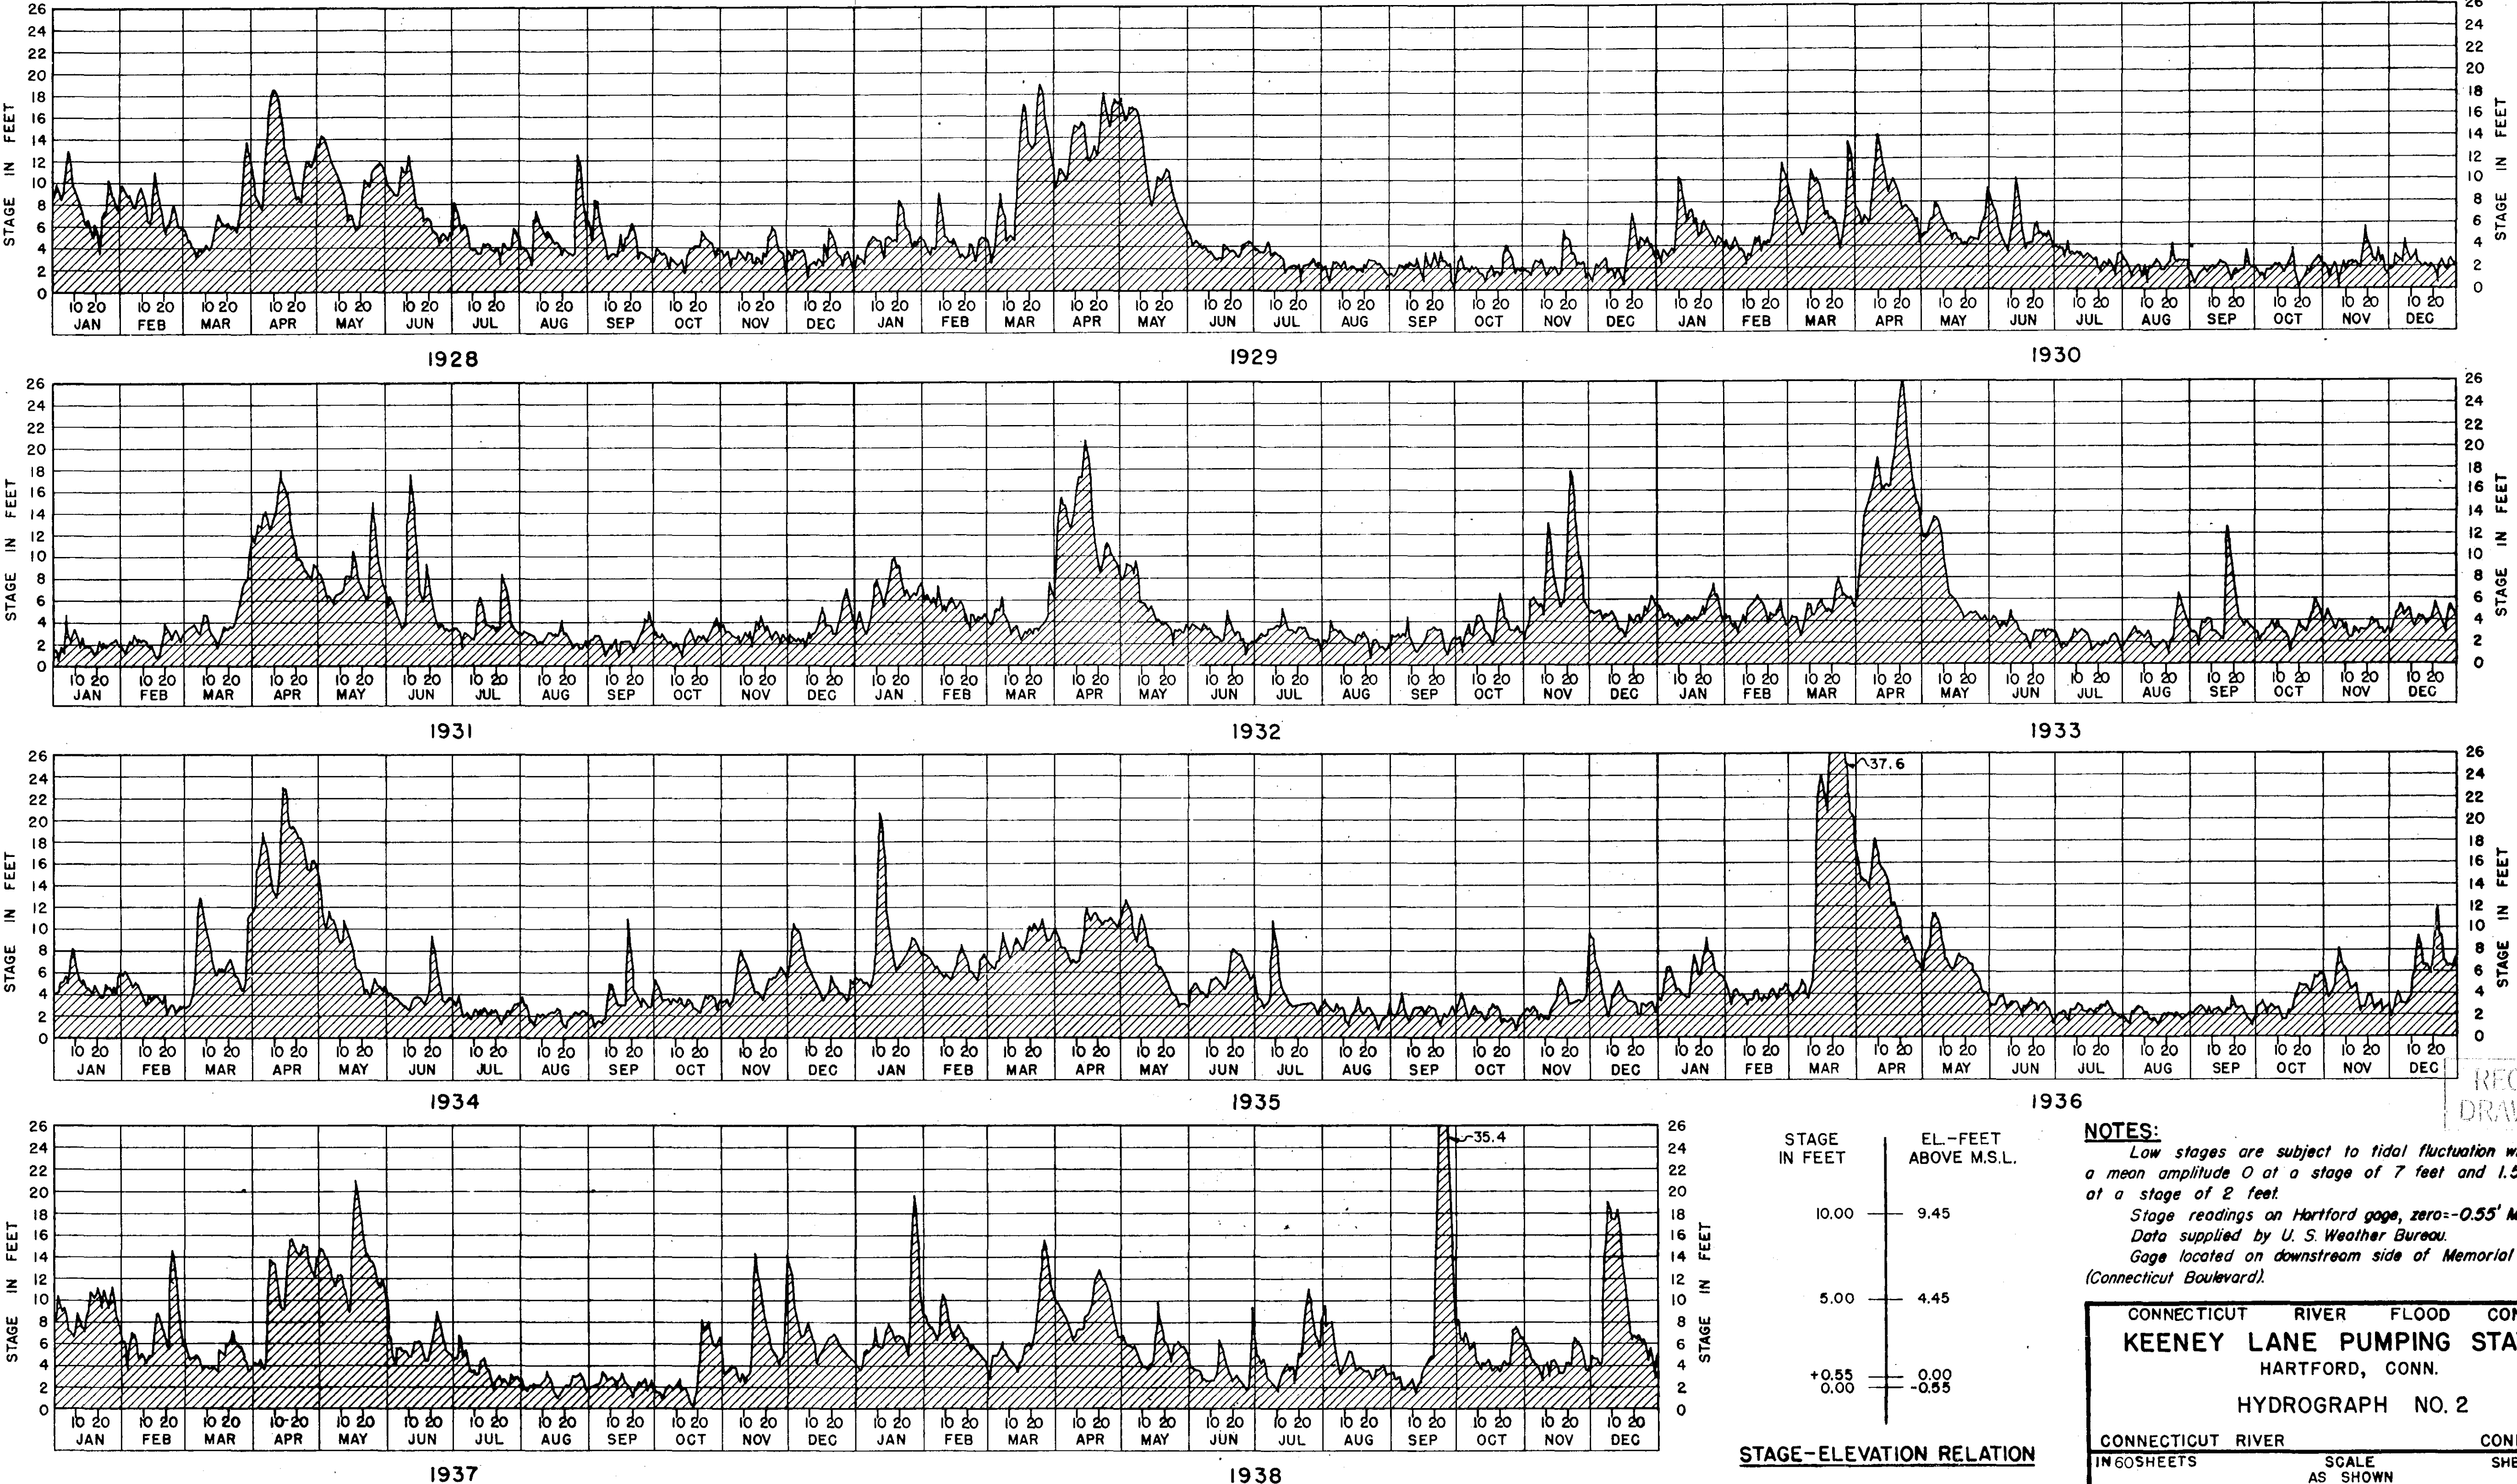

NOTES (con't)
The data contained hereon are not intended as representations or warranties, but are furnished for information only. It is expressly understood that the Government will not be responsible for any deduction, interpretation or conclusion

NOTES (con't)
therefrom made by any bidder or contractor.

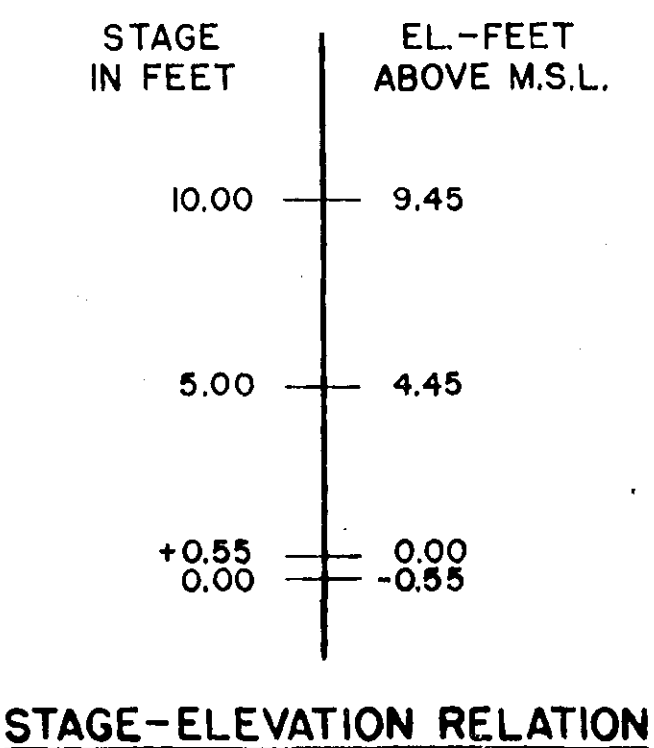

NOTES:
Low stages are subject to tidal fluctuation which has a mean amplitude 0 at a stage of 7 feet and 1.5 feet at a stage of 2 feet.
Stage readings on Hartford gage, zero = -0.55' M.S.L.
Data supplied by U. S. Weather Bureau.
Gage located on downstream side of Memorial Bridge (Connecticut Boulevard).

CONNECTICUT RIVER FLOOD CONTROL			
KEENEY LANE PUMPING STATION			
HARTFORD, CONN.			
HYDROGRAPH NO. 2			
CONNECTICUT RIVER		CONNECTICUT	
IN 60 SHEETS		SHEET NO. 3	
U.S. ENGINEER OFFICE, PROVIDENCE, R.I., JUNE 1944			
SUBMITTED BY: [Signature]		APPROVAL RECOMMENDED: [Signature]	
HEAD, HYDRAULICS SECTION		COL, CORPS OF ENGINEERS	
PREPARED BY: [Signature]		DRAWN BY: W.W.V. & F.C.T.	
HYDRAULICS SECTION		CHECKED BY: C.M.M.	
KEY		FILE NO. OT-3-1229	

RECORD DRAWINGS