
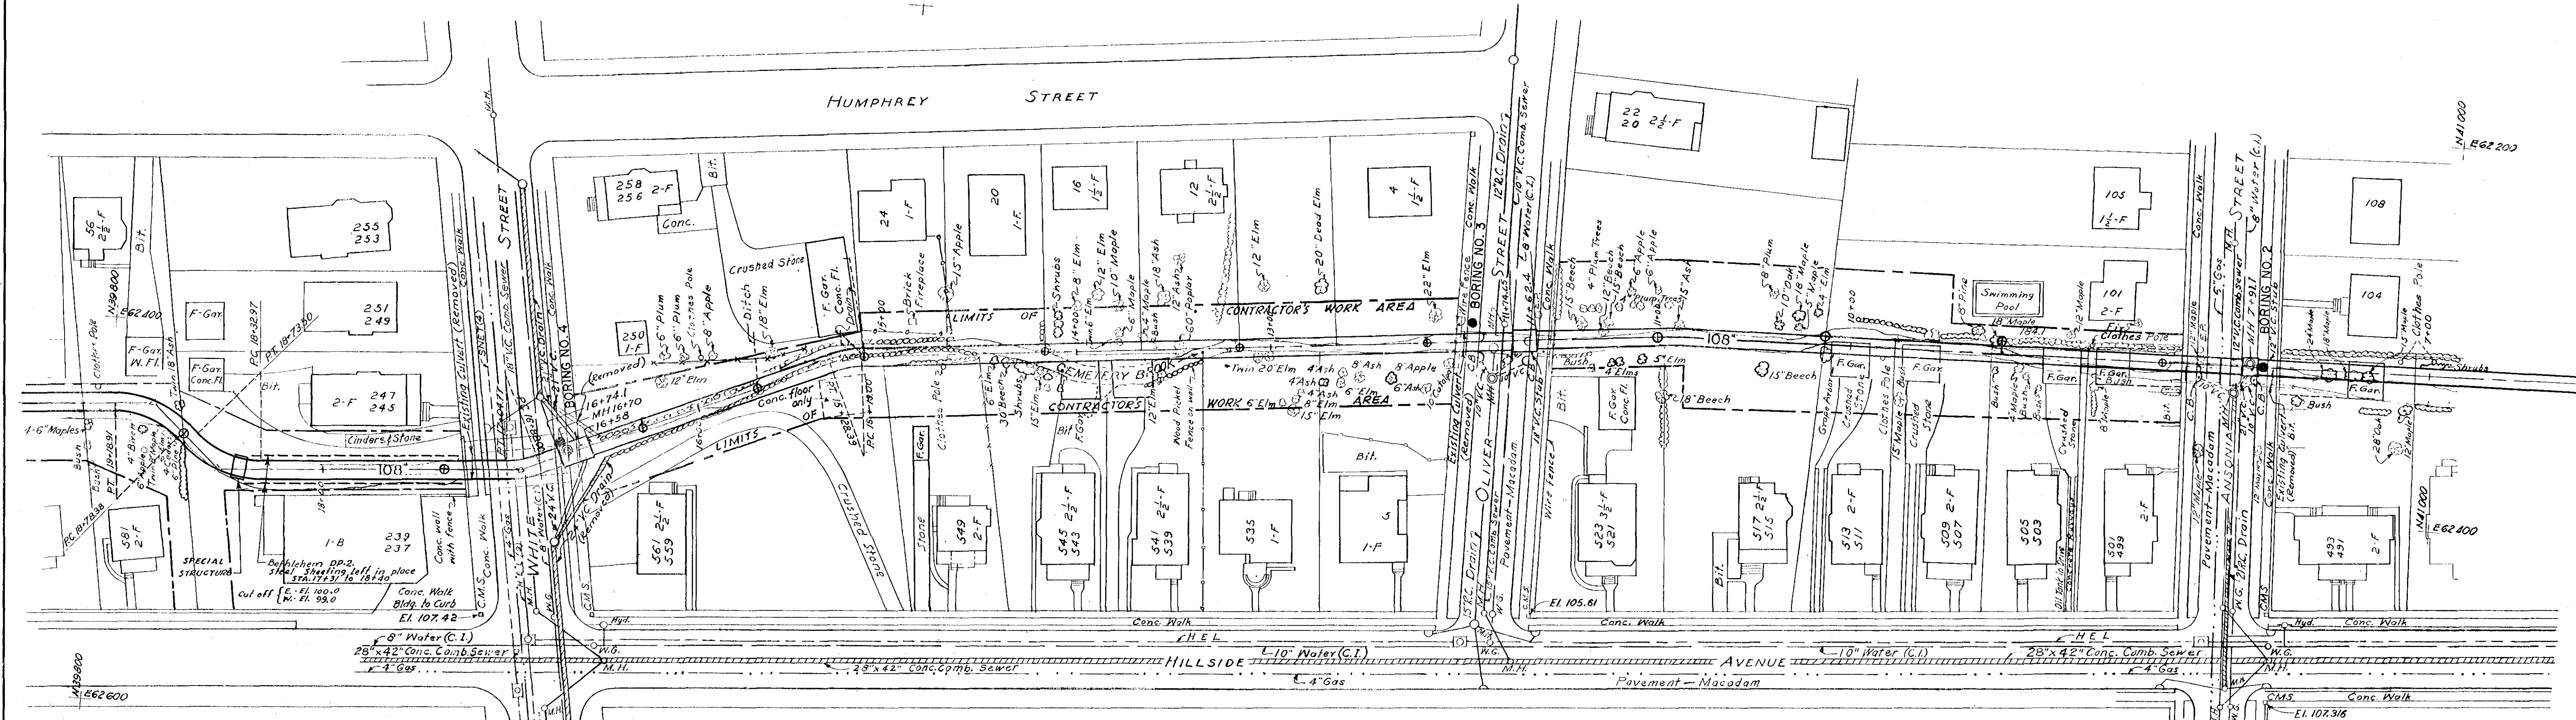


58881
H
19296

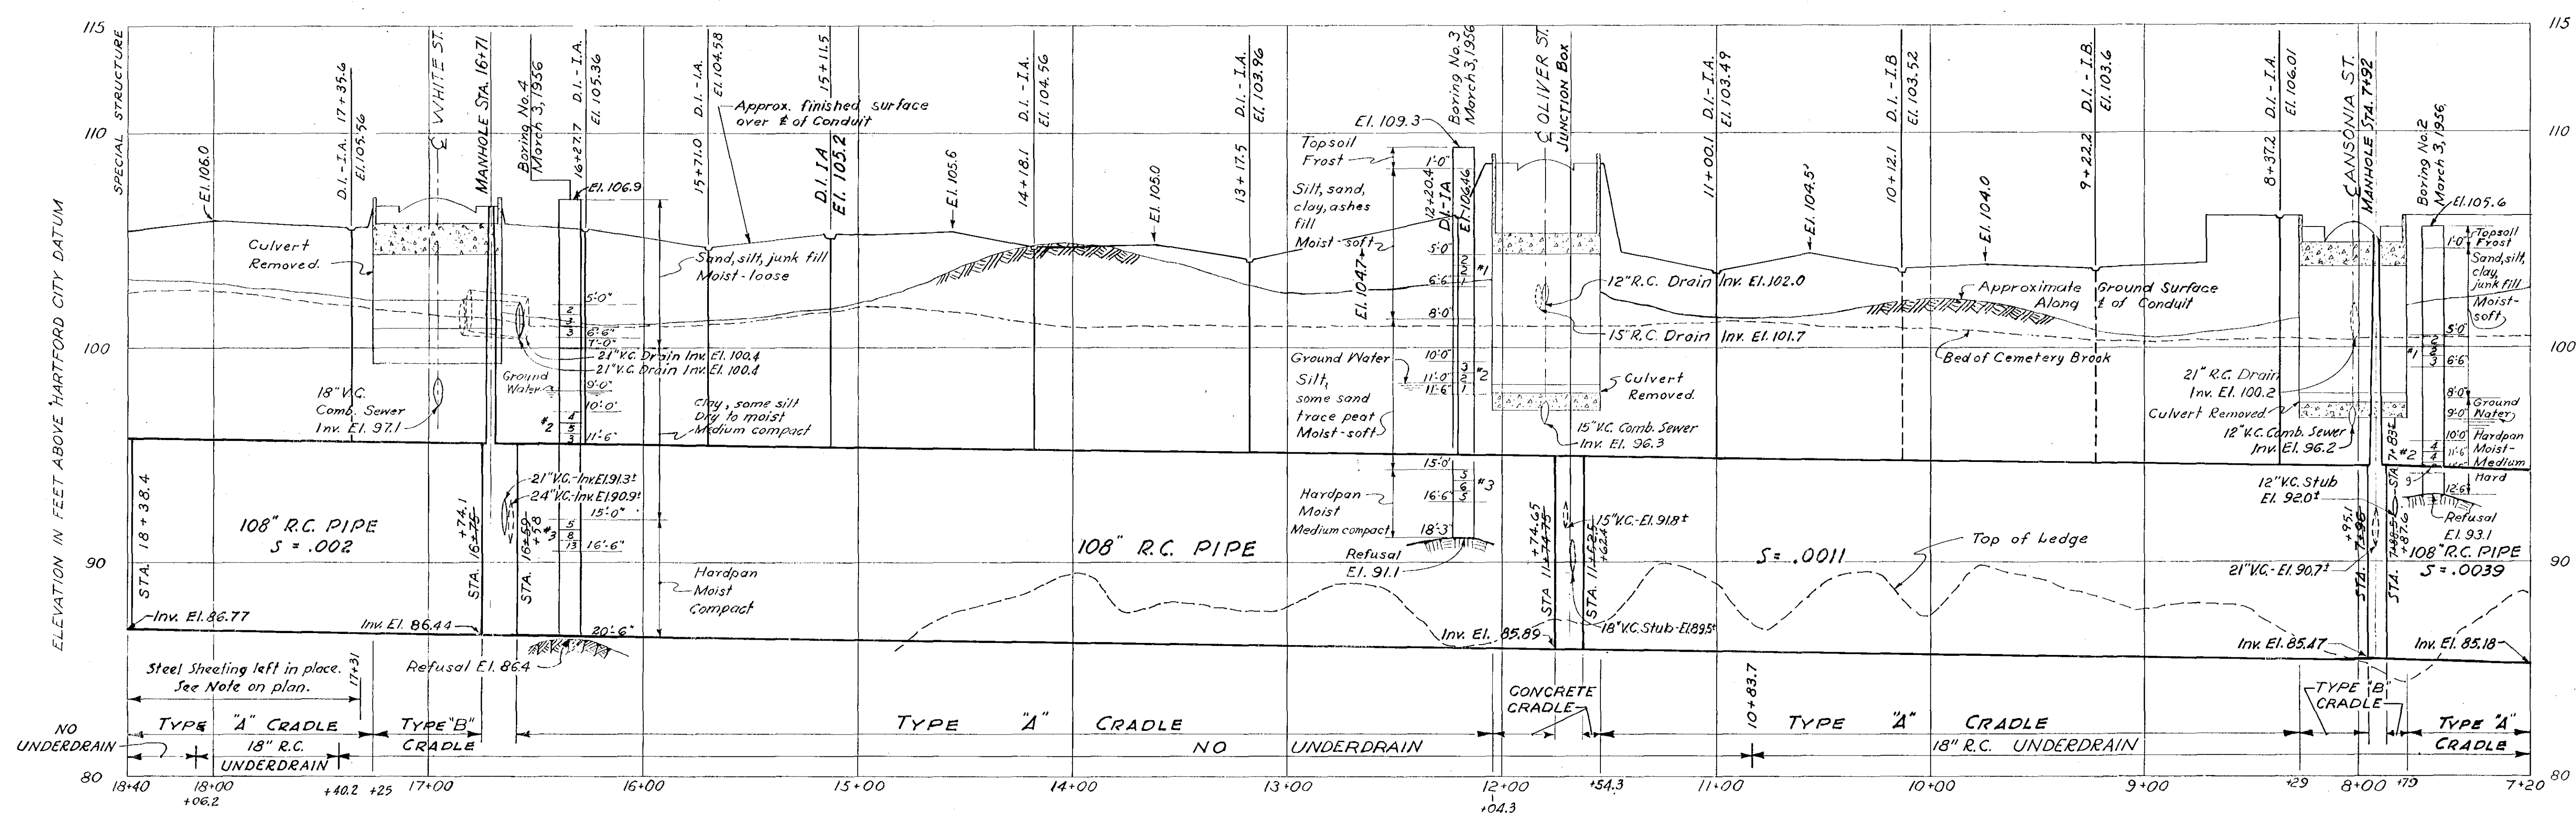

Notes:
1. For location and bearings of conduit centerline see Sheet 11.
2. Layout of "Limits of Contractor's Work Area" shown on Sheet 11.
3. Most trees and shrubbery shown were removed to facilitate construction. Replantings not shown.
4. Concrete supports under all utilities crossing conduit trench. See Sheets 16, 19 and 20.

RECORD DRAWING

DRAWN BY S.A.H.
TRACED BY C.B.
CHECKED BY R.H.L.

REVISION	MADE BY	CHECKED BY	DESCRIPTION
2, Jan. 1940	J.F.G.	S.A.H.	Record Revisions
1, July 1, 1957	L.S.B.	S.A.H.	STATIONING CORRECTIONS CENTER TO CENTER OF CONDUIT

APPROVED	
FOR PARK RIVER FLOOD CONTROL COMMISSION	
John W. Raymond, Jr.	5/10/57
REG. PROF. ENGR. CT. NO. 290	DATE
FOR METCALF & EDDY, ENGINEERS	
John W. Raymond, Jr.	5/10/57
REG. PROF. ENGR. CT. NO. 4322	DATE

PARK RIVER FLOOD CONTROL COMMISSION
HARTFORD, CONNECTICUT
CEMETERY BROOK CONDUIT

PLAN & PROFILE
STA. 7+20 TO STA. 18+40

SCALE, HOR. 1" = 40'
VERT. 1" = 4'

MAY, 1957

METCALF & EDDY
ENGINEERS
BOSTON, MASS.

34267
H
19445