
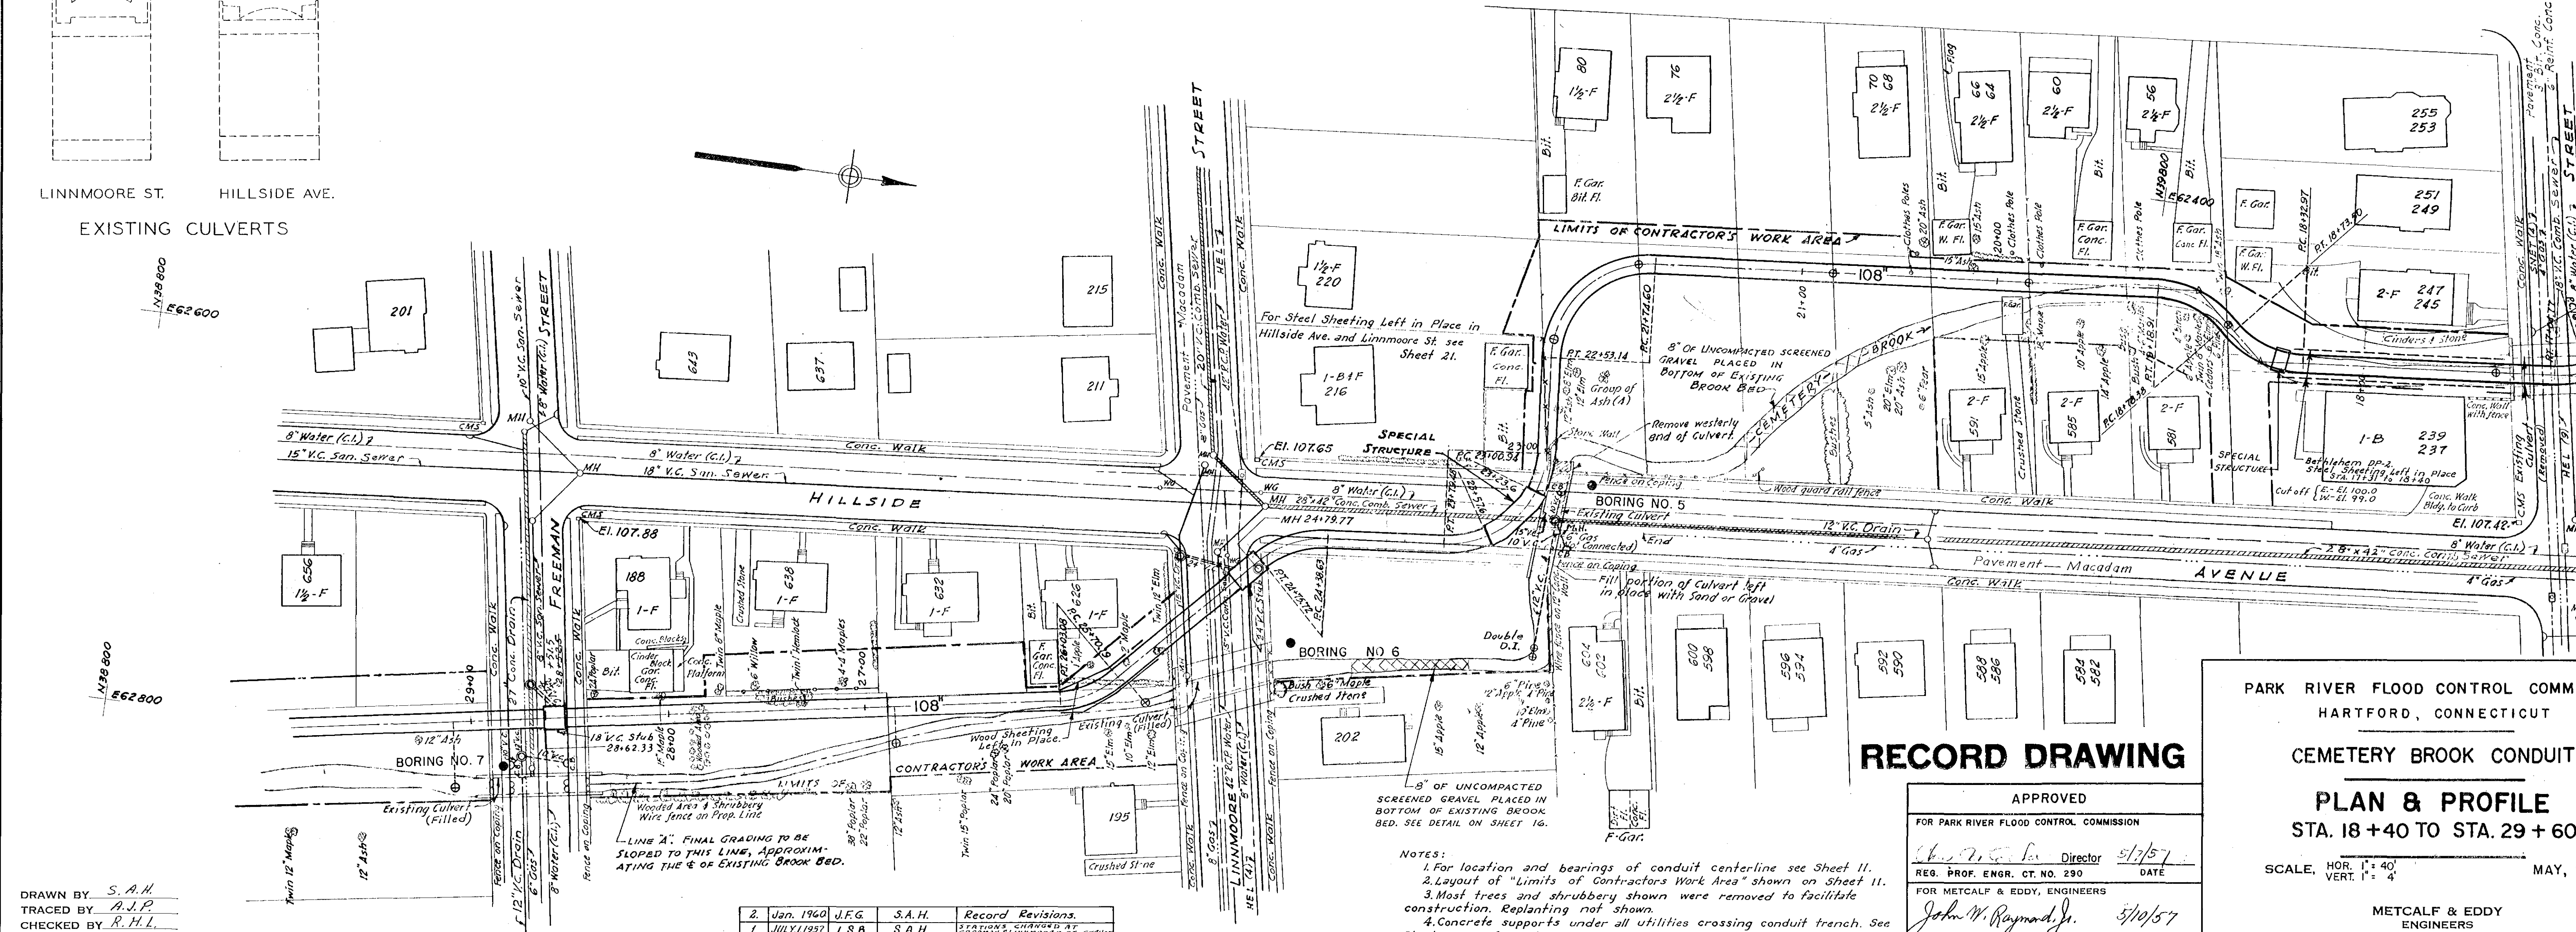


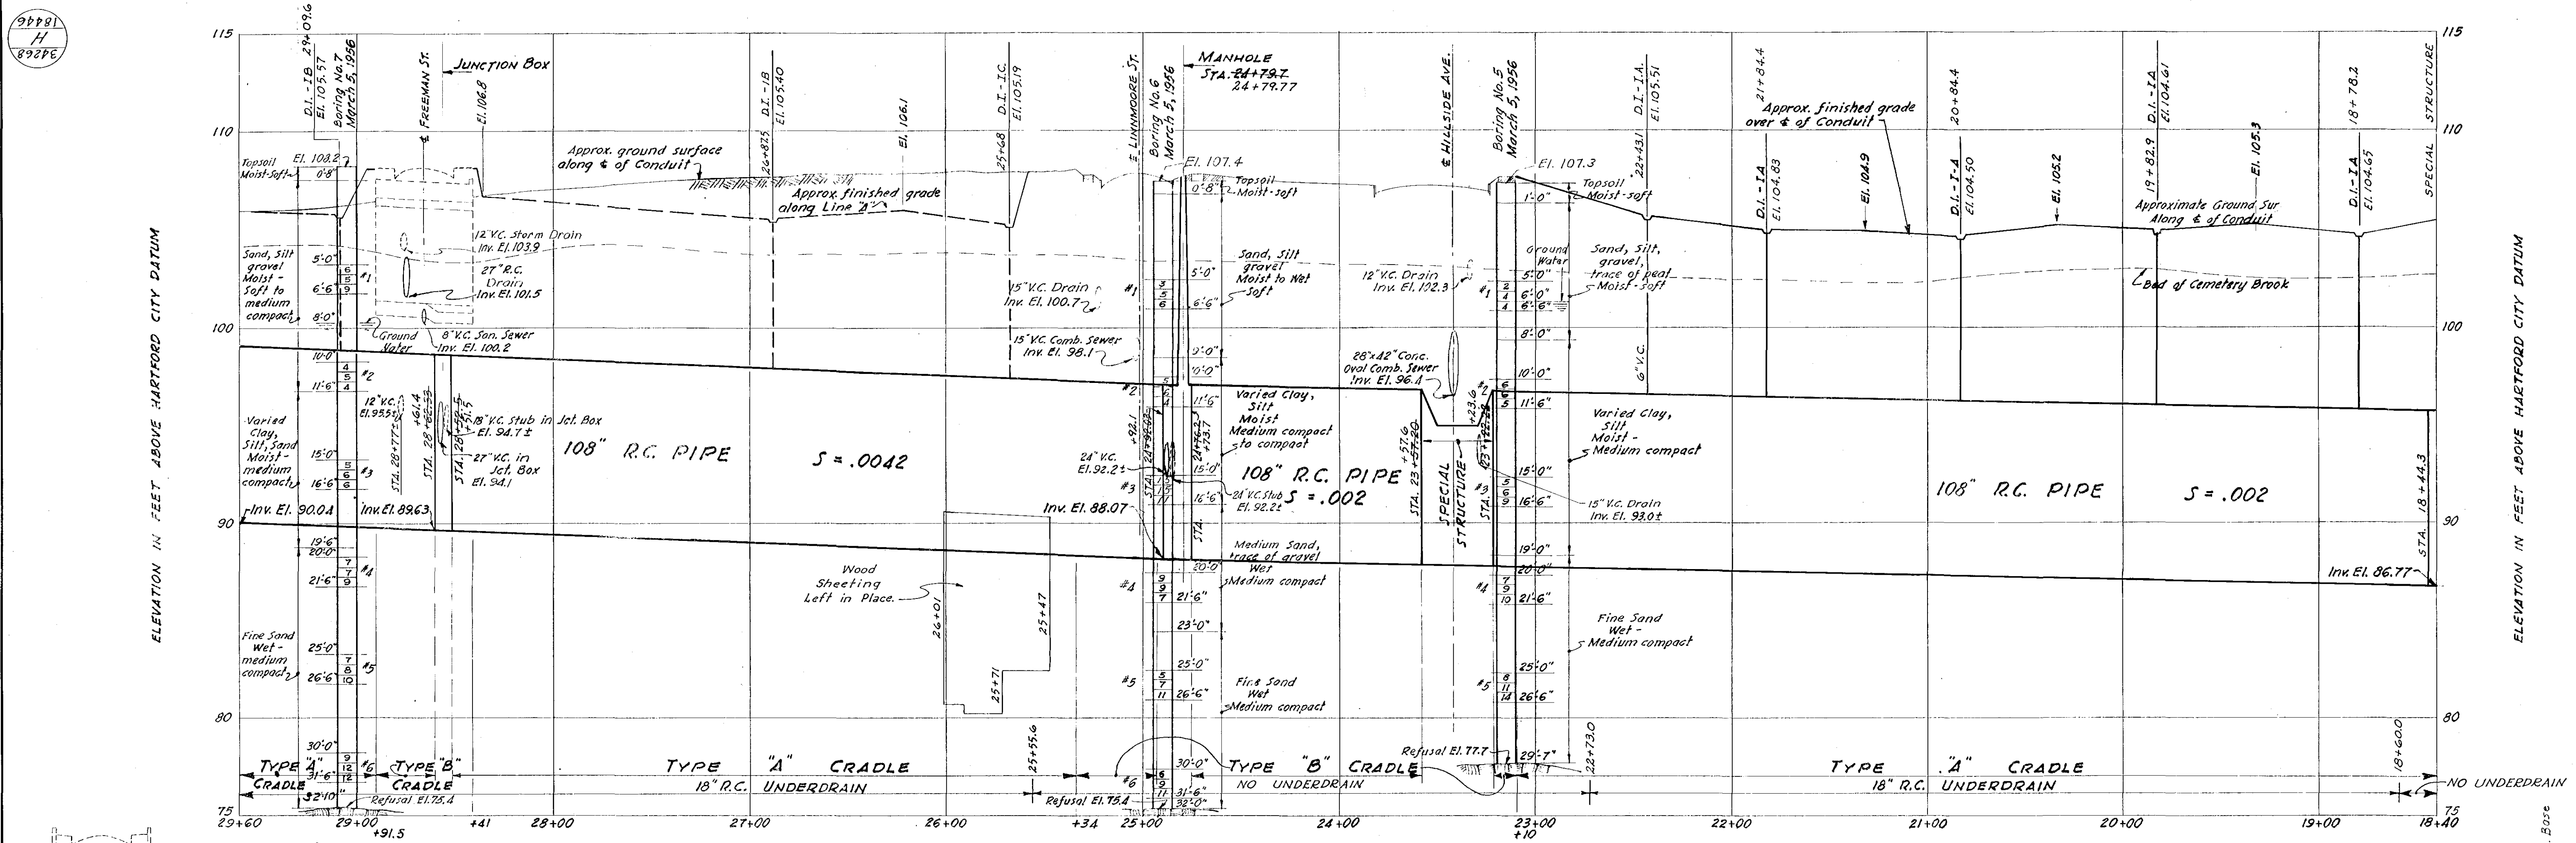

DRAWN BY S.A.H.
 TRACED BY A.J.P.
 CHECKED BY R.H.L.

2. Jan. 1960 J.F.G. S.A.H. Record Revisions.
 1 JULY 1957 L.S.B. S.A.H. 3. Changes shown as per Linna Moore St. street
 REVISION MADE BY CHECKED BY DESCRIPTION

NOTES:
 1. For location and bearings of conduit centerline see Sheet 11.
 2. Limits of Contractor's Work Area shown on Sheet 11.
 3. Most trees and shrubbery shown were removed to facilitate construction. Replanting not shown.
 4. Concrete supports under all utilities crossing conduit trench. See Sheets 16, 20, 21 and 23.

RECORD DRAWING
 APPROVED
 FOR PARK RIVER FLOOD CONTROL COMMISSION
 Director 5/1/57
 REG. PROF. ENGR. CT. NO. 230 DATE
 FOR METCALF & EDDY, ENGINEERS
 John W. Raymond, Jr. 5/10/57
 REG. PROF. ENGR. CT. NO. 3422 DATE

PARK RIVER FLOOD CONTROL COMMISSION
 HARTFORD, CONNECTICUT
 CEMETERY BROOK CONDUIT
PLAN & PROFILE
 STA. 18+40 TO STA. 29+60
 SCALE, HOR. 1" = 40'
 VERT. 1" = 4'
 MAY, 1957
 METCALF & EDDY
 ENGINEERS
 BOSTON, MASS.

CONTRACT 1957-3
 SHEET 4 OF 31