


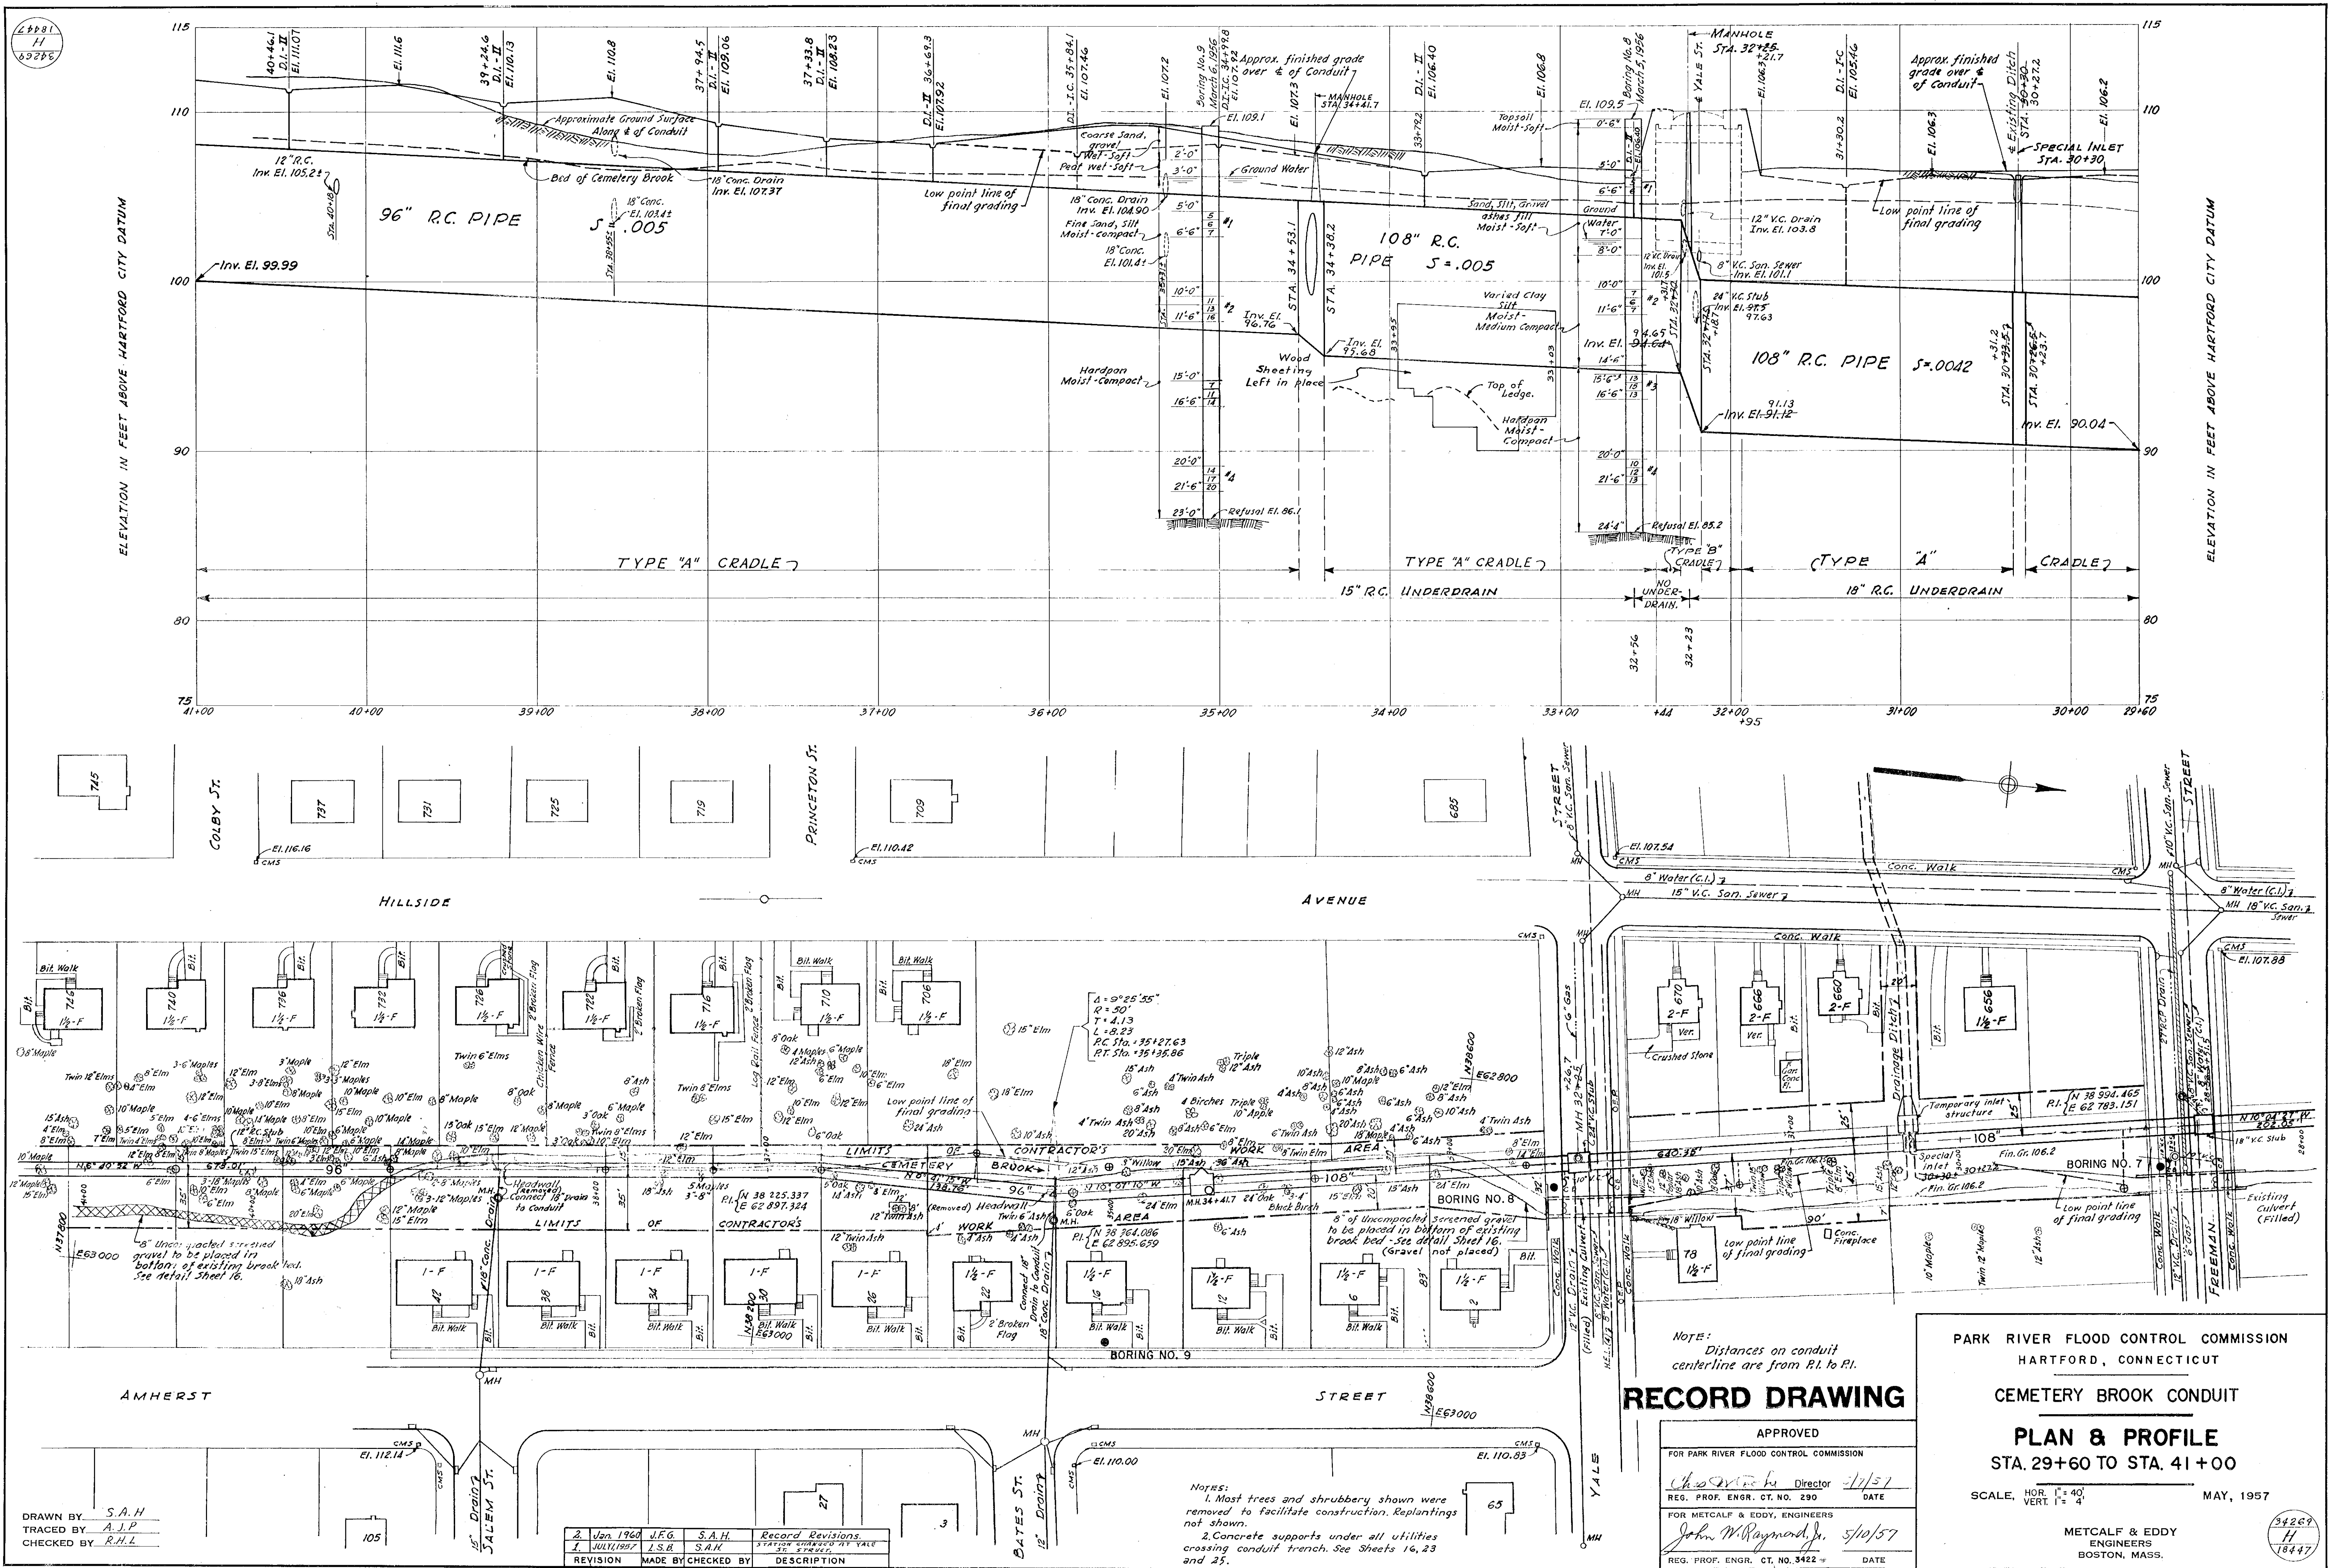

DRAWN BY: S.A.H.
TRACED BY: A.J.P.
CHECKED BY: R.H.L.

REVISION	MADE BY	CHECKED BY	DESCRIPTION
1	Jan 1960 J.F.G.	S.A.H.	Record Revisions
2	Jul 1967 J.S.H.	S.A.H.	3" PAVEMENT CHANGED TO 4" TAKE 3" STREET

NOTES:
1. Most trees and shrubbery shown were removed to facilitate construction. Replantings not shown.
2. Concrete supports under all utilities crossing conduit trench. See Sheets 16, 23 and 25.

RECORD DRAWING

APPROVED
FOR PARK RIVER FLOOD CONTROL COMMISSION
REG. PROF. ENGR. CT. NO. 290
DATE 1/1/57
John W. Raymond, Jr.
REG. PROF. ENGR. CT. NO. 3422
DATE 5/10/57

PARK RIVER FLOOD CONTROL COMMISSION
HARTFORD, CONNECTICUT
CEMETERY BROOK CONDUIT
PLAN & PROFILE
STA. 29+60 TO STA. 41+00
SCALE: HOR. 1"=40'
VERT. 1"=4'
MAY, 1957
METCALF & EDDY
ENGINEERS
BOSTON, MASS.

34269
H
18447