




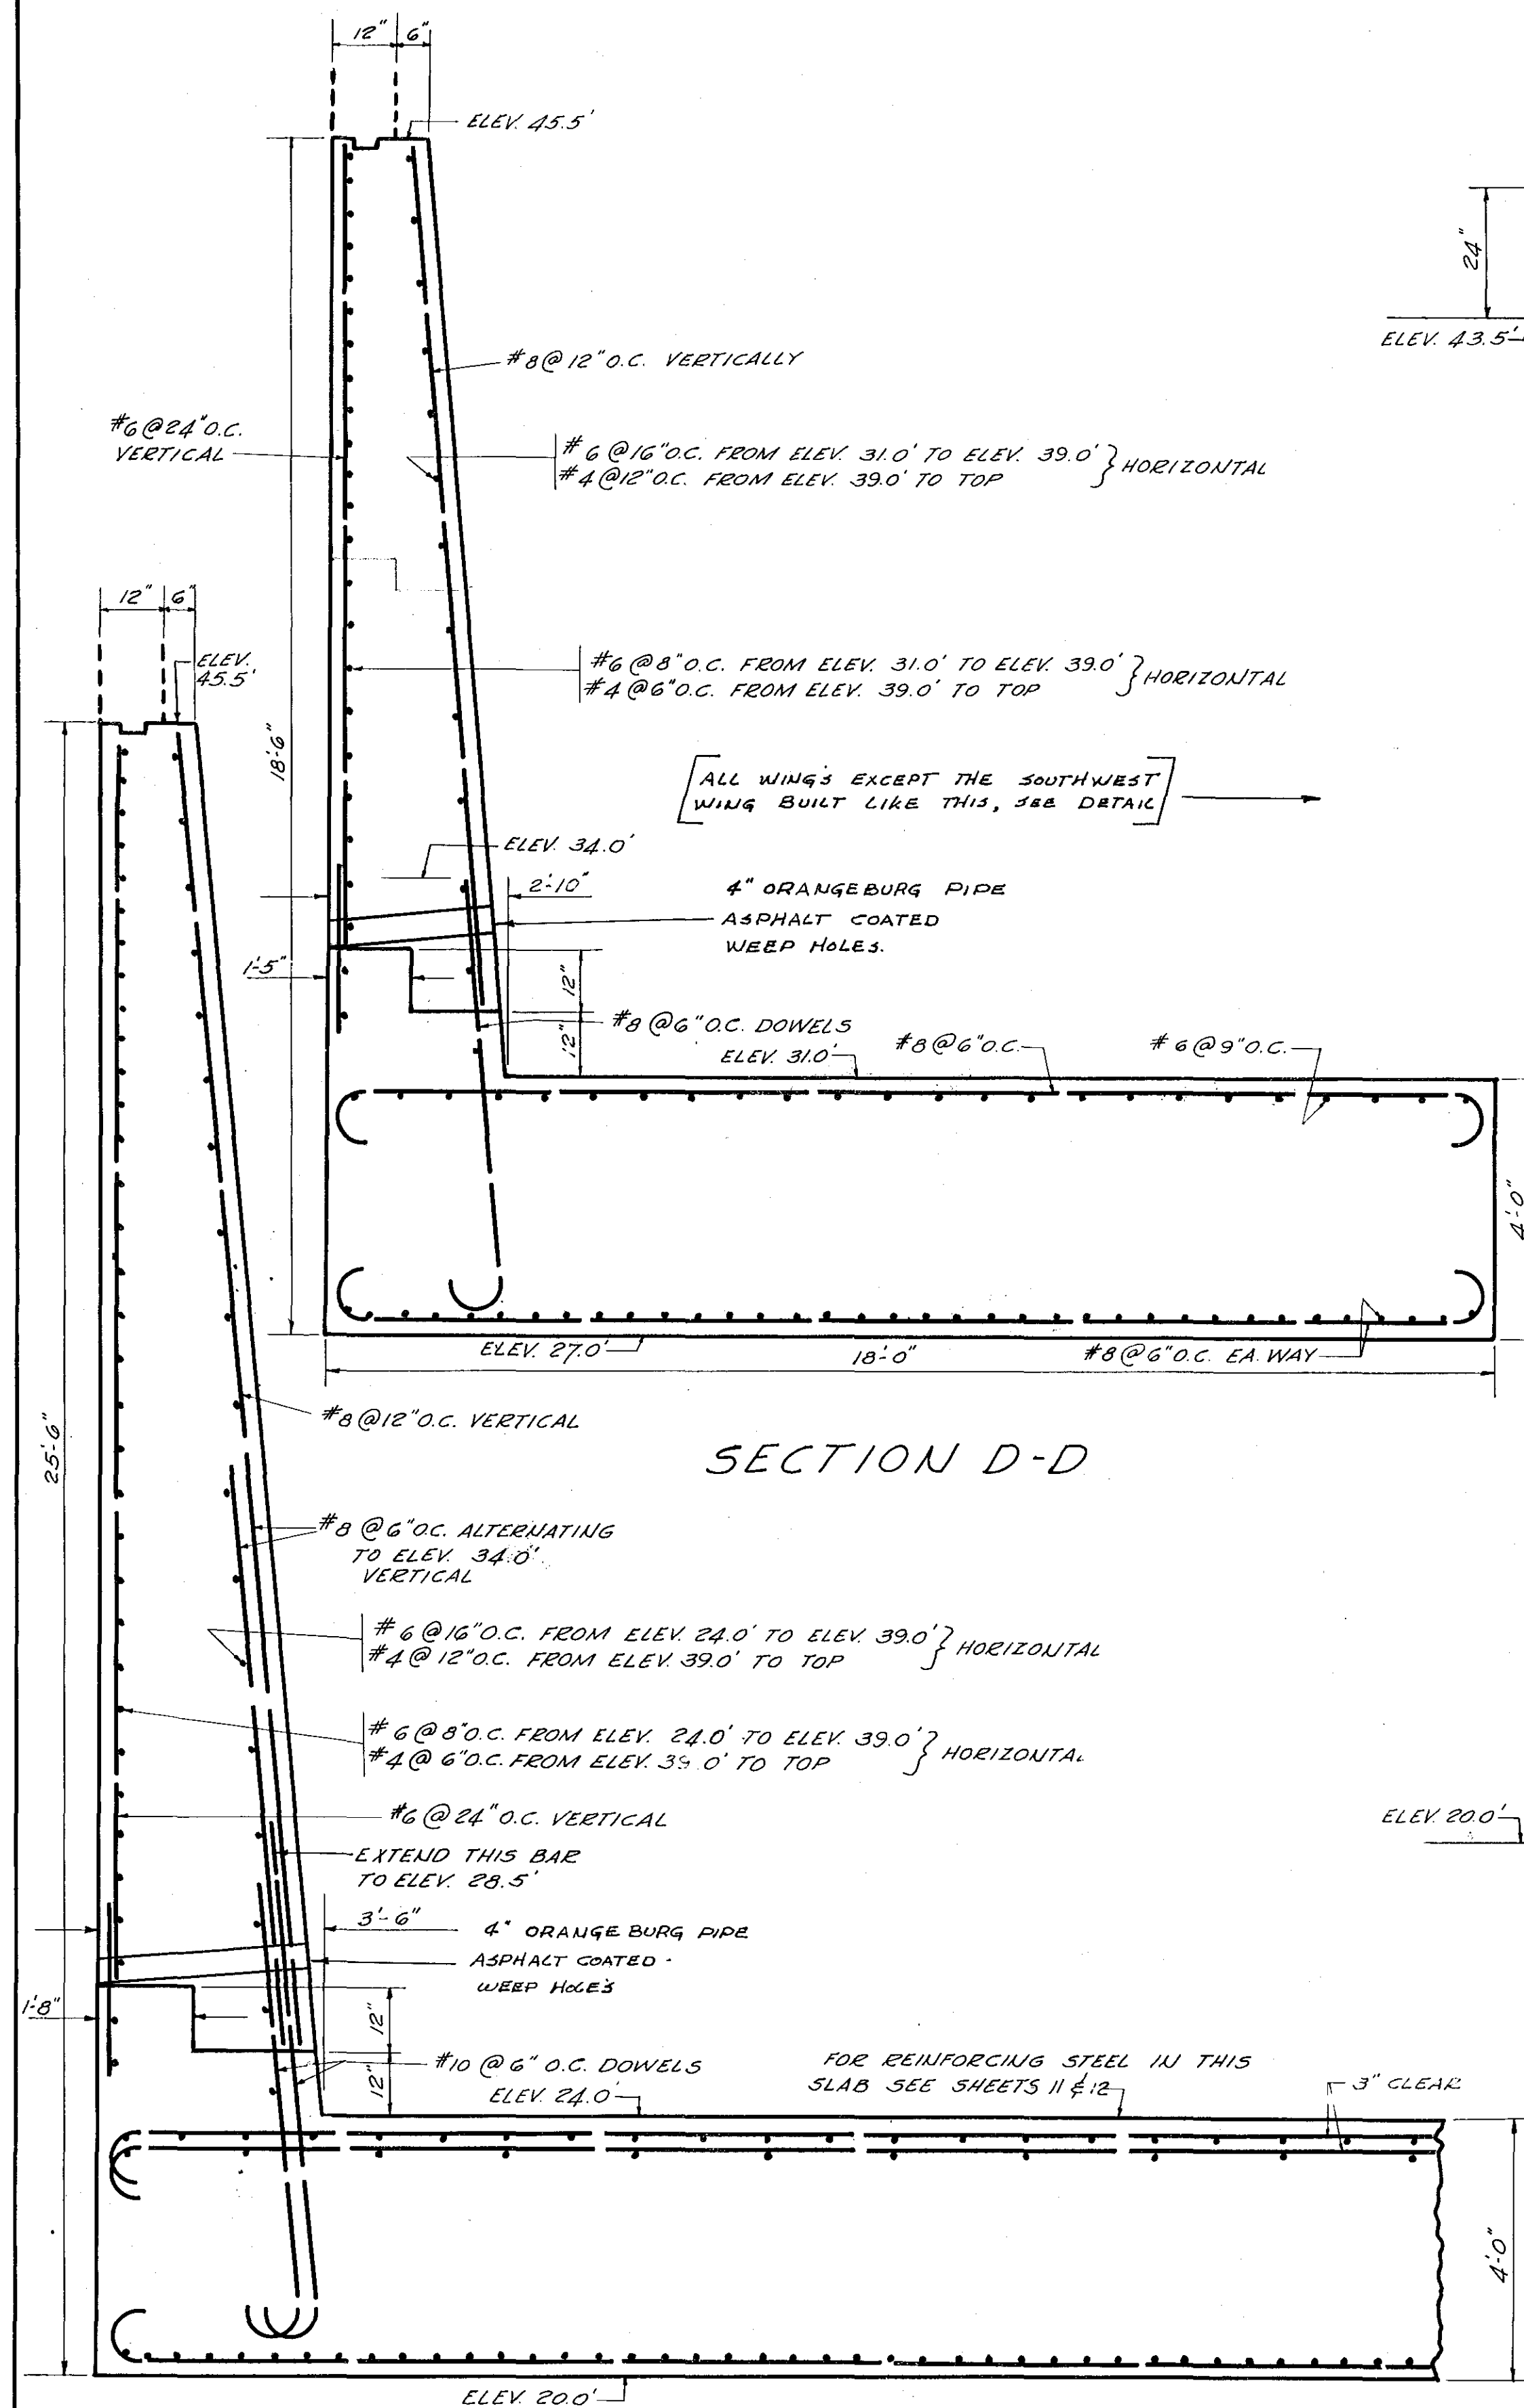



SECTION D-D

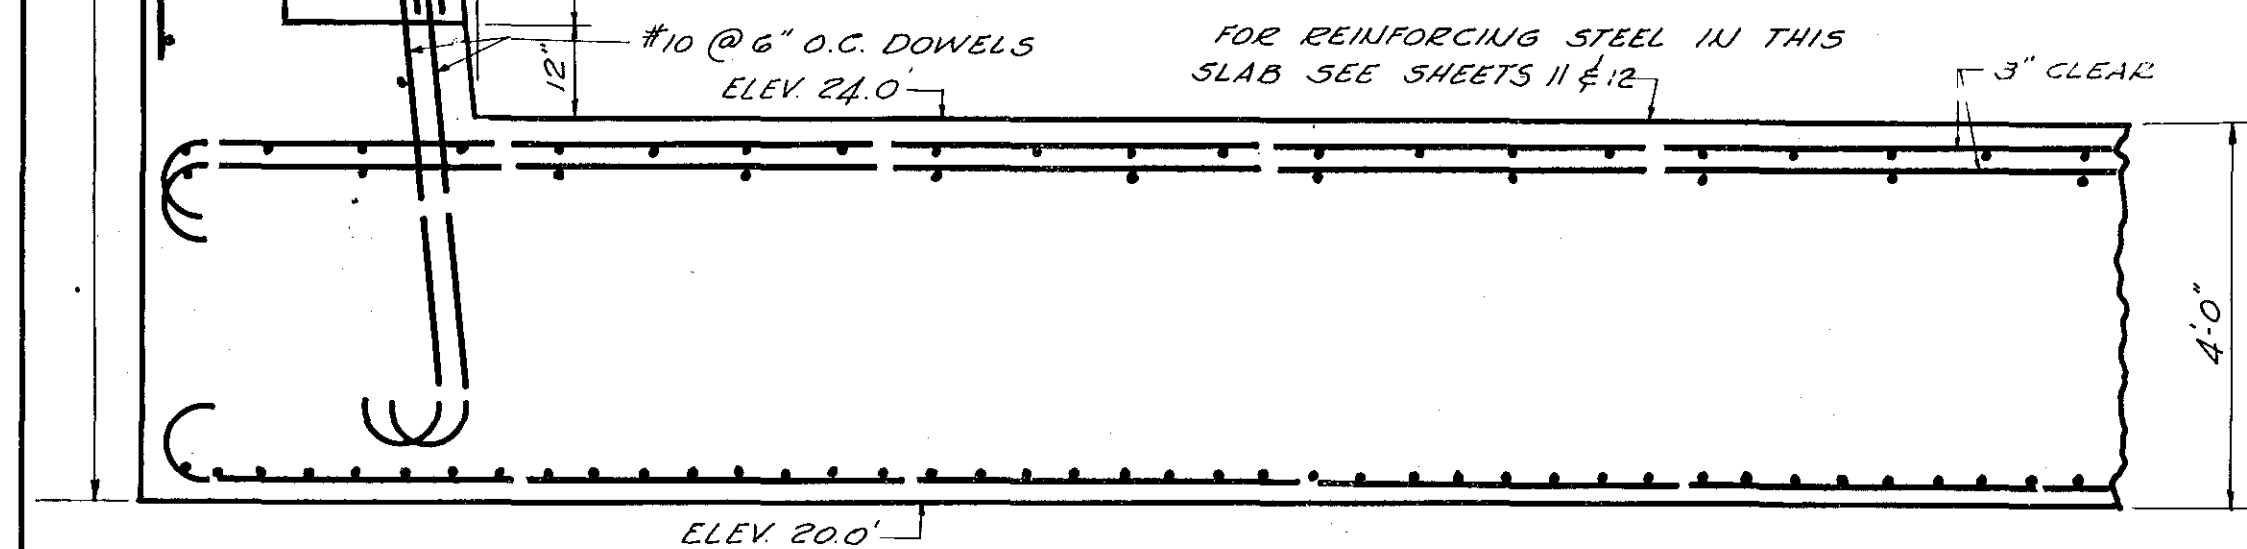


SECTION C-C

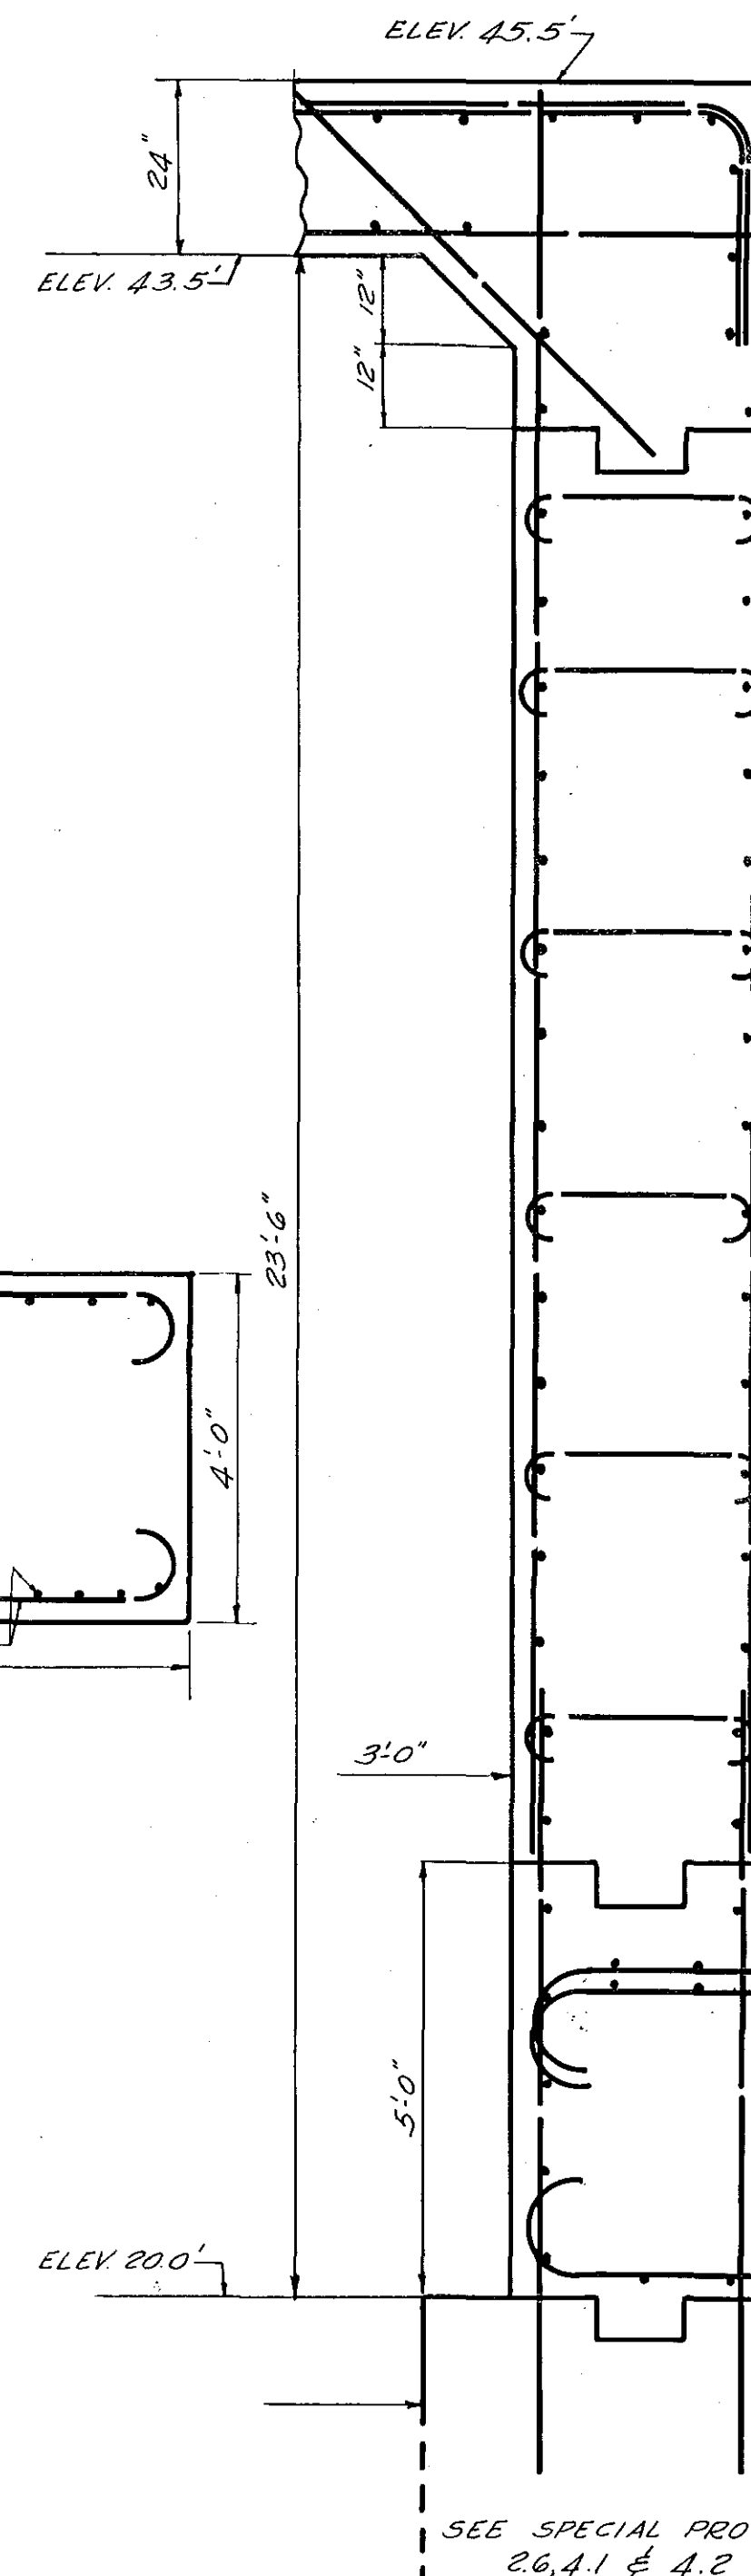

SECTION B-B

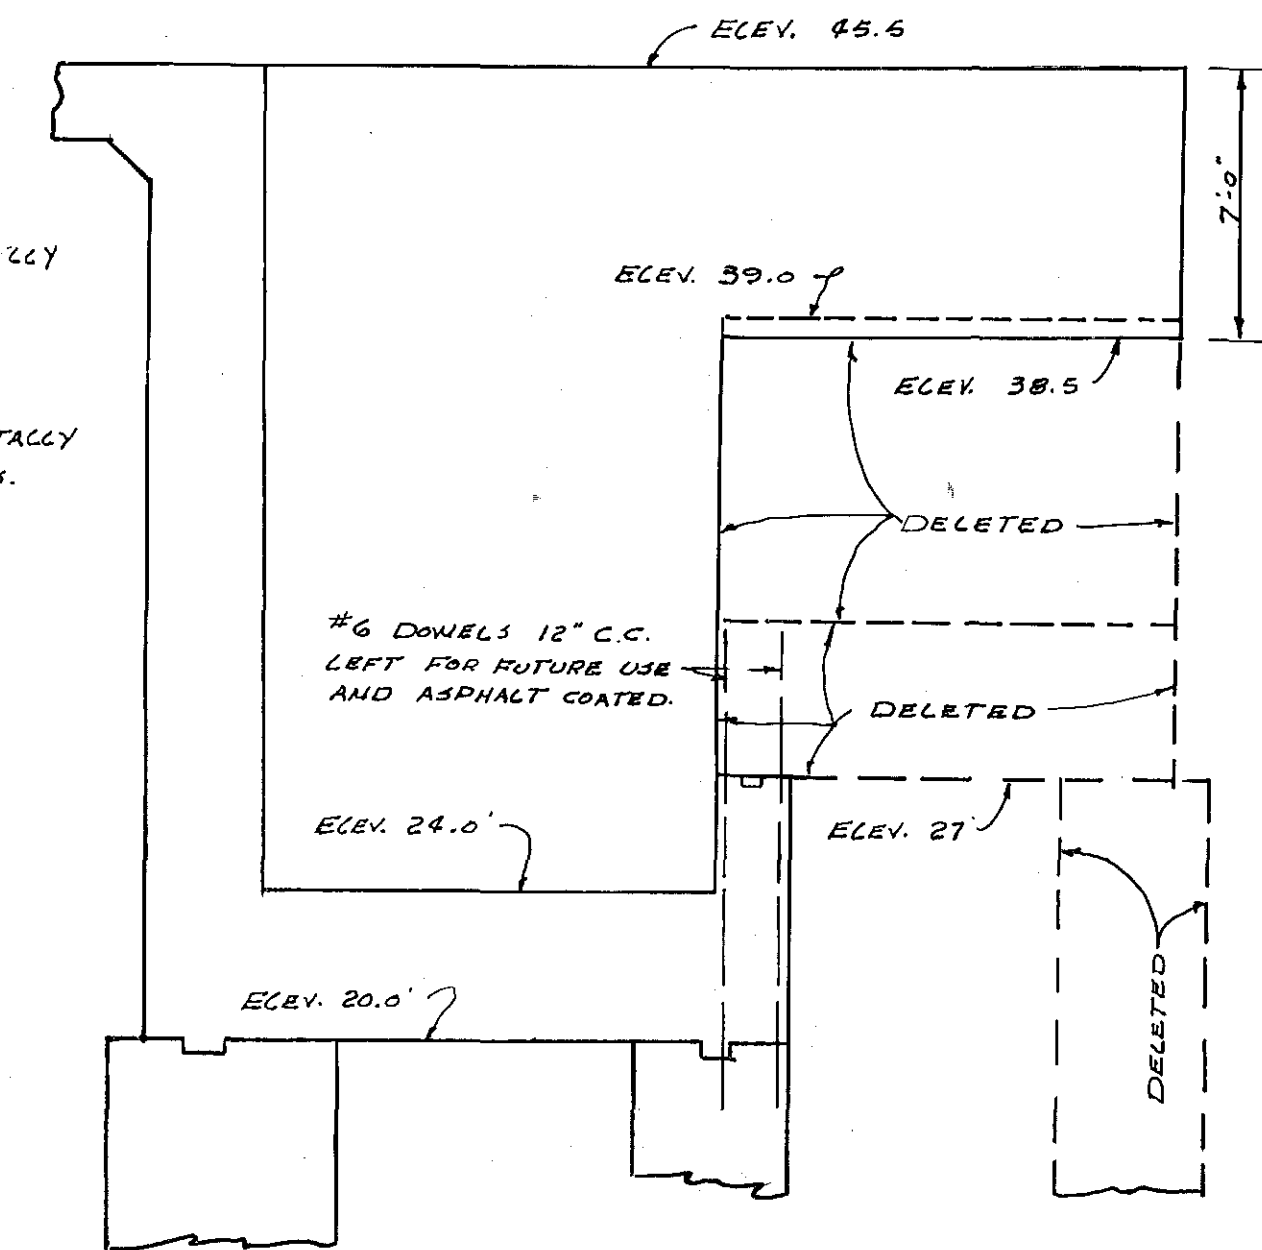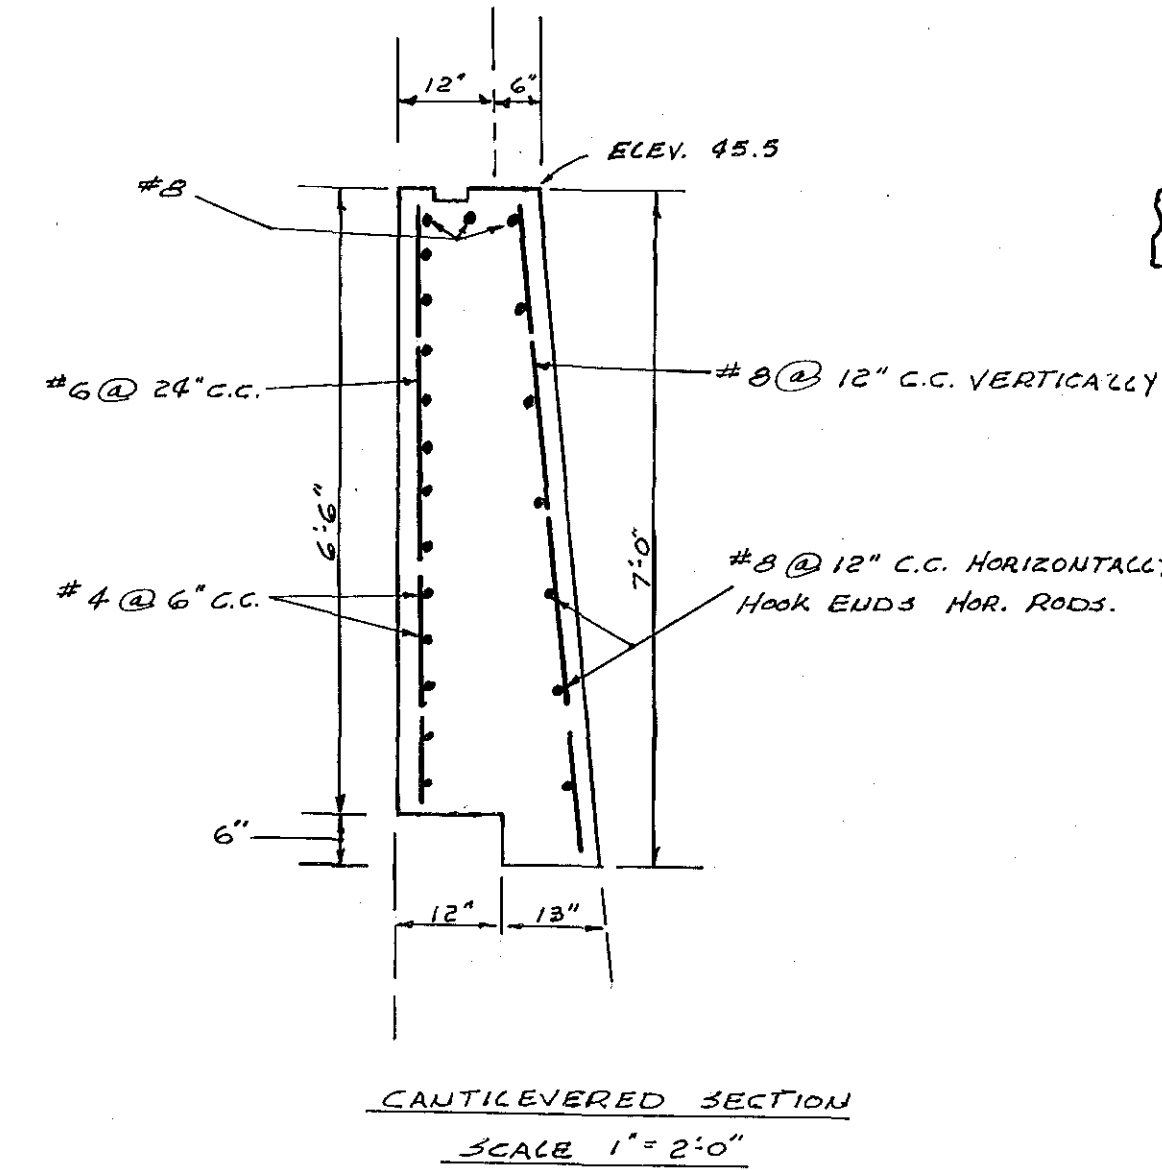

SOUTH WEST WING WALL SHOWING CANTILEVERED SECTION
SCALE 1" = 5'-0"

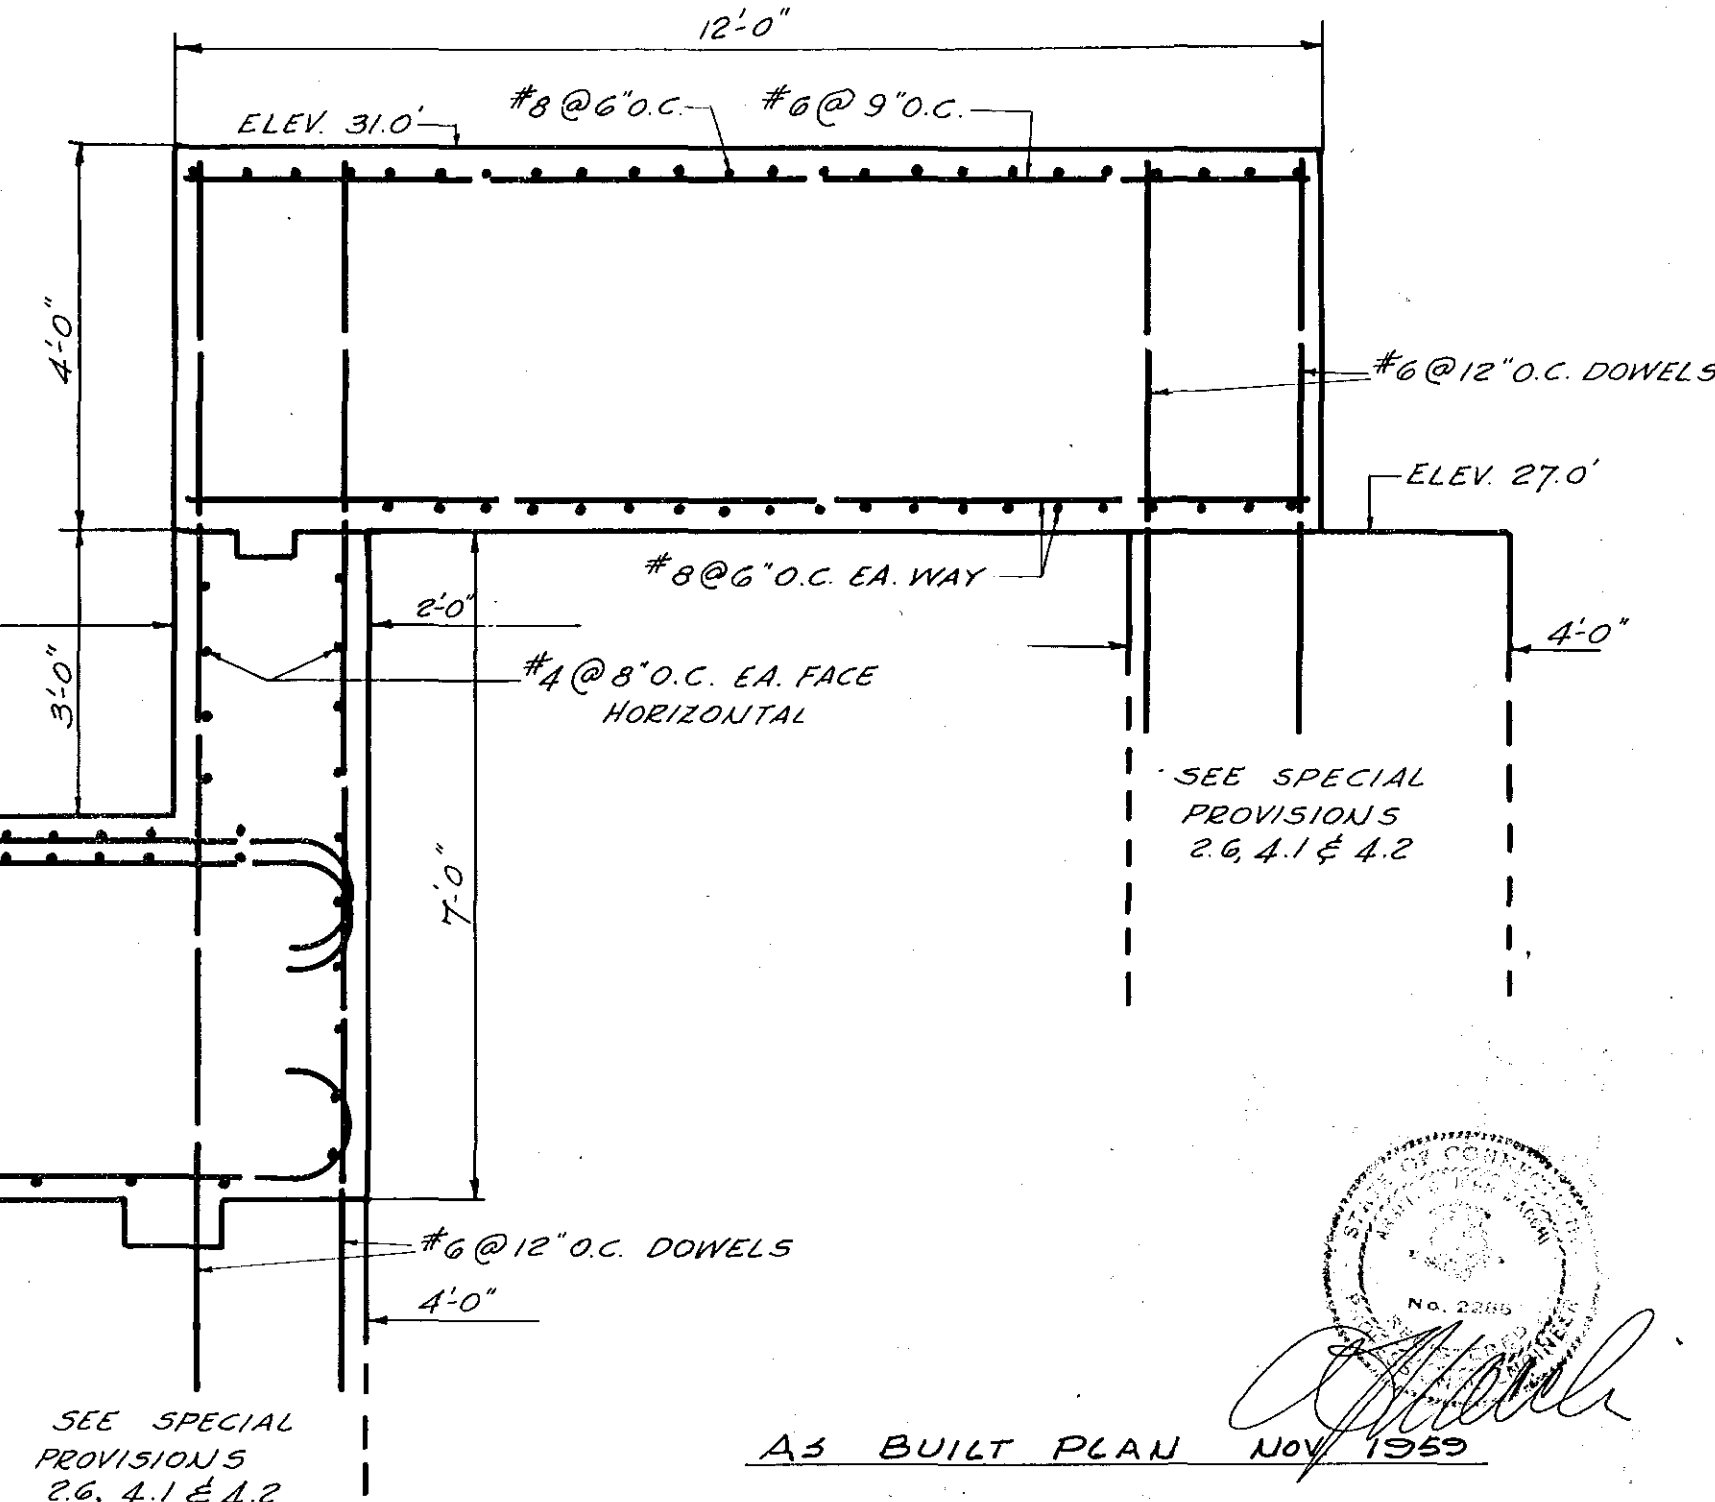

AS BUILT PLAN NOV 1959

GREATER HARTFORD FLOOD COMMISSION HARTFORD, CONNECTICUT	
DESIGNED BY R.E.C. C.K.K. TRACED BY C.K.K. A.J.M. CHECKED BY R.E.C. SCALE 1" = 2'-0" DATE MAY 1959	HAMILTON ST. BRIDGE WING WALL DETAIL SHOWING REINFORCING STEEL SERIAL NO. 000837 DRAWING NUMBER 13 SHEET 13 OF 16
RECOMMENDED BY PE CONN NO 554 APPROVED BY PE CONN NO 290	CHIEF ENGINEER DIRECTOR

SEE OTHER SHEETS FOR FOUNDATION DETAIL.

SEE SPECIAL PROVISIONS 2.6, 4.1 & 4.2

SEE SPECIAL PROVISIONS 2.6, 4.1 & 4.2

