




1848
H
62325

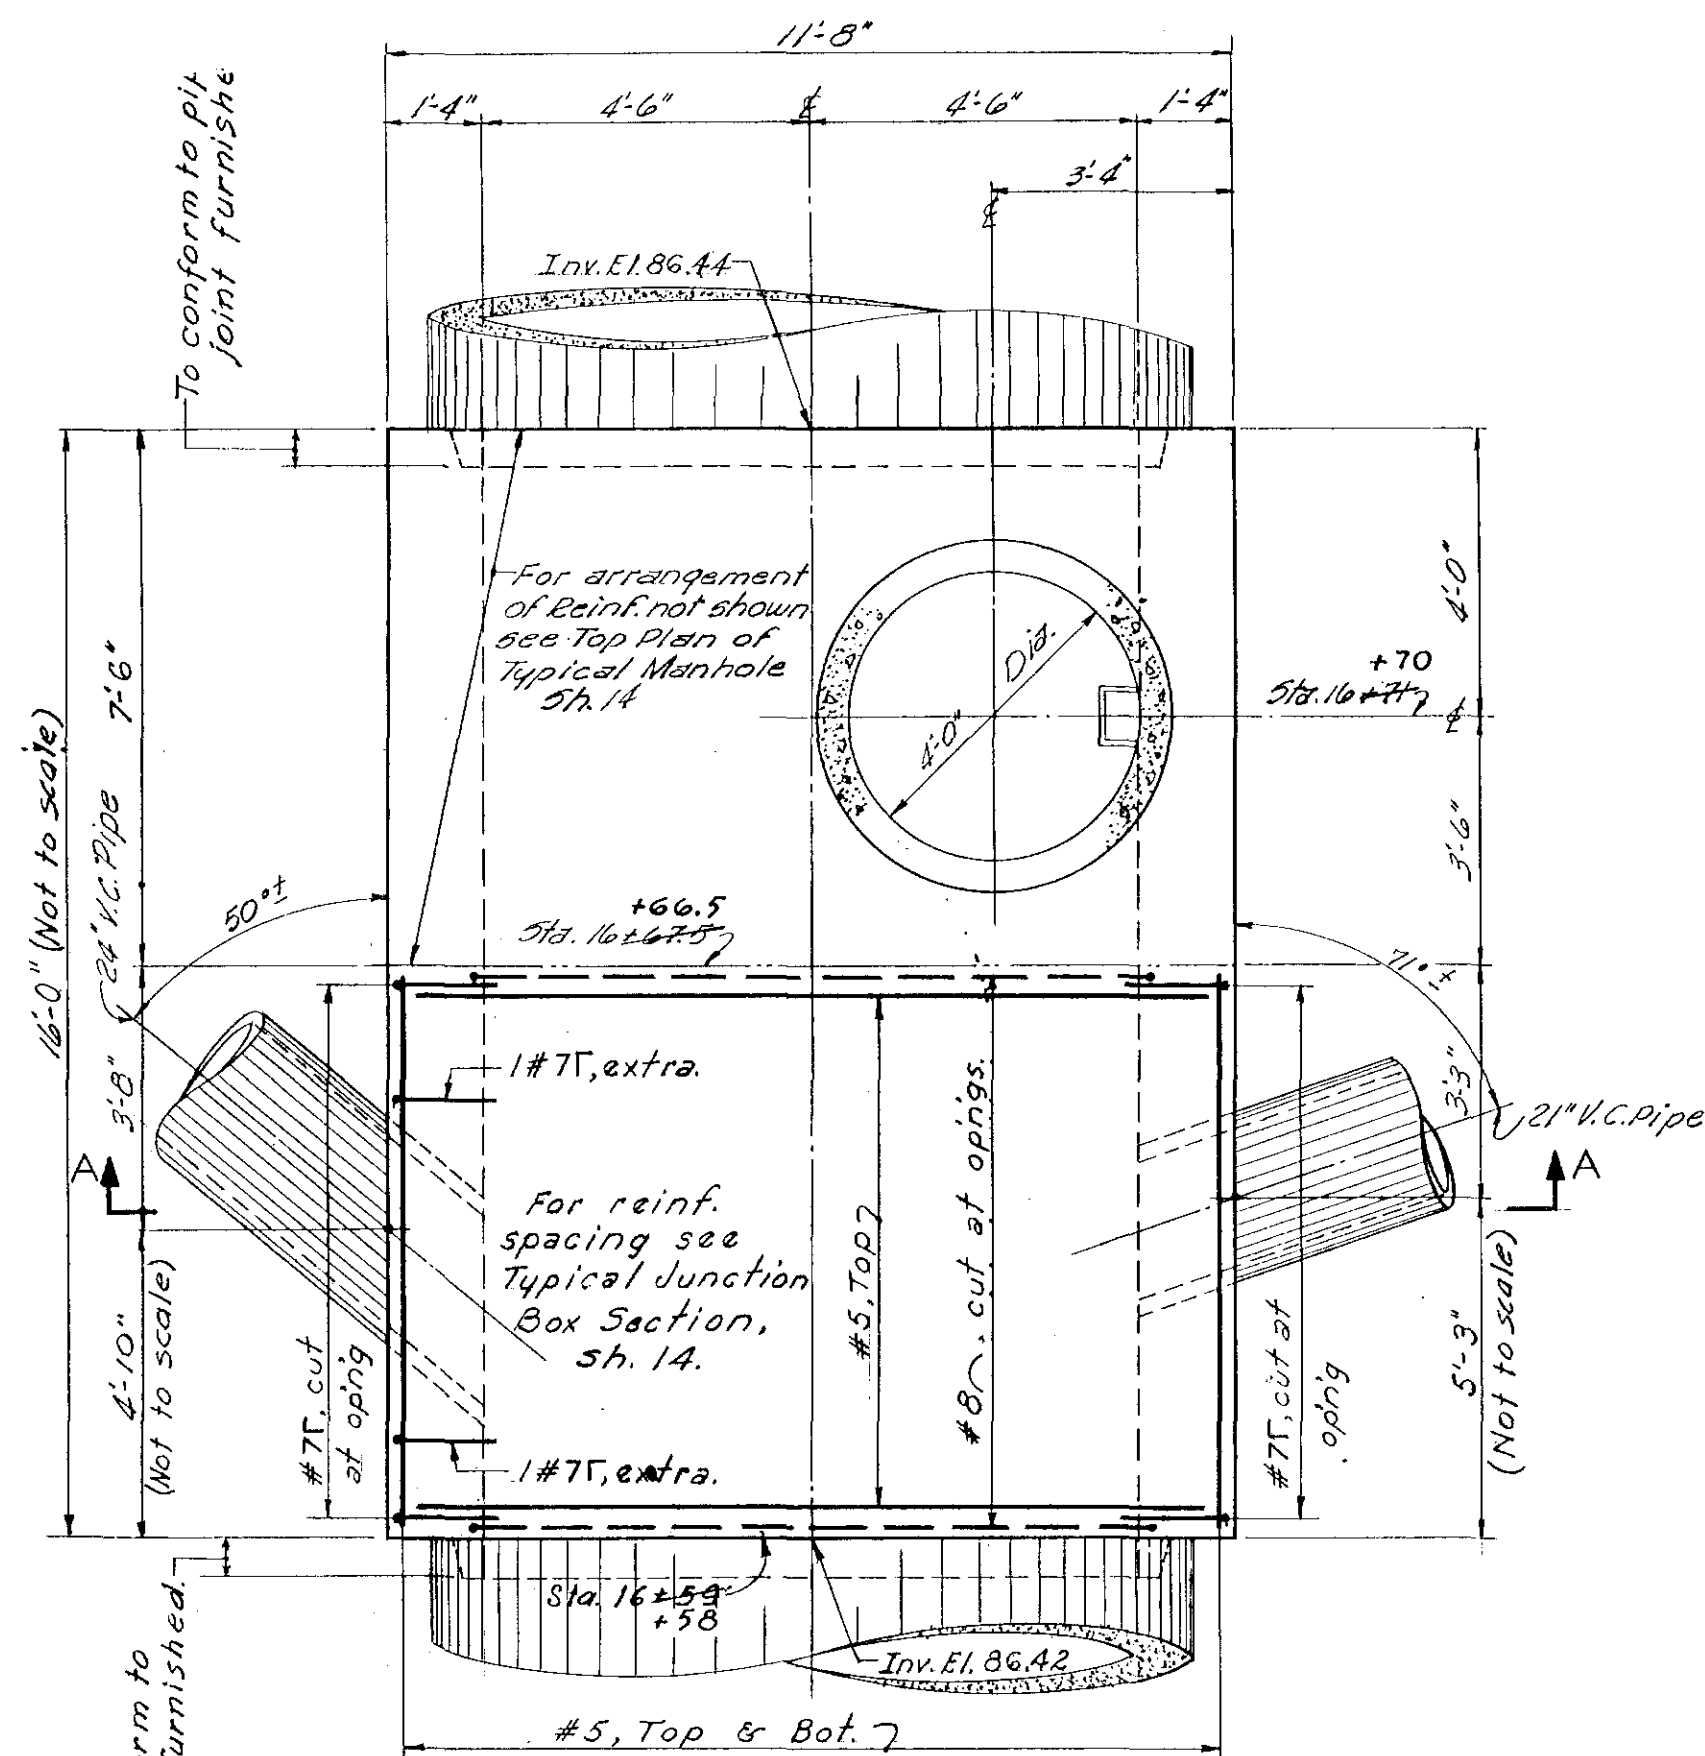


TOP PLAN OF MANHOLE
& JUNCTION BOX AT WHITE ST.

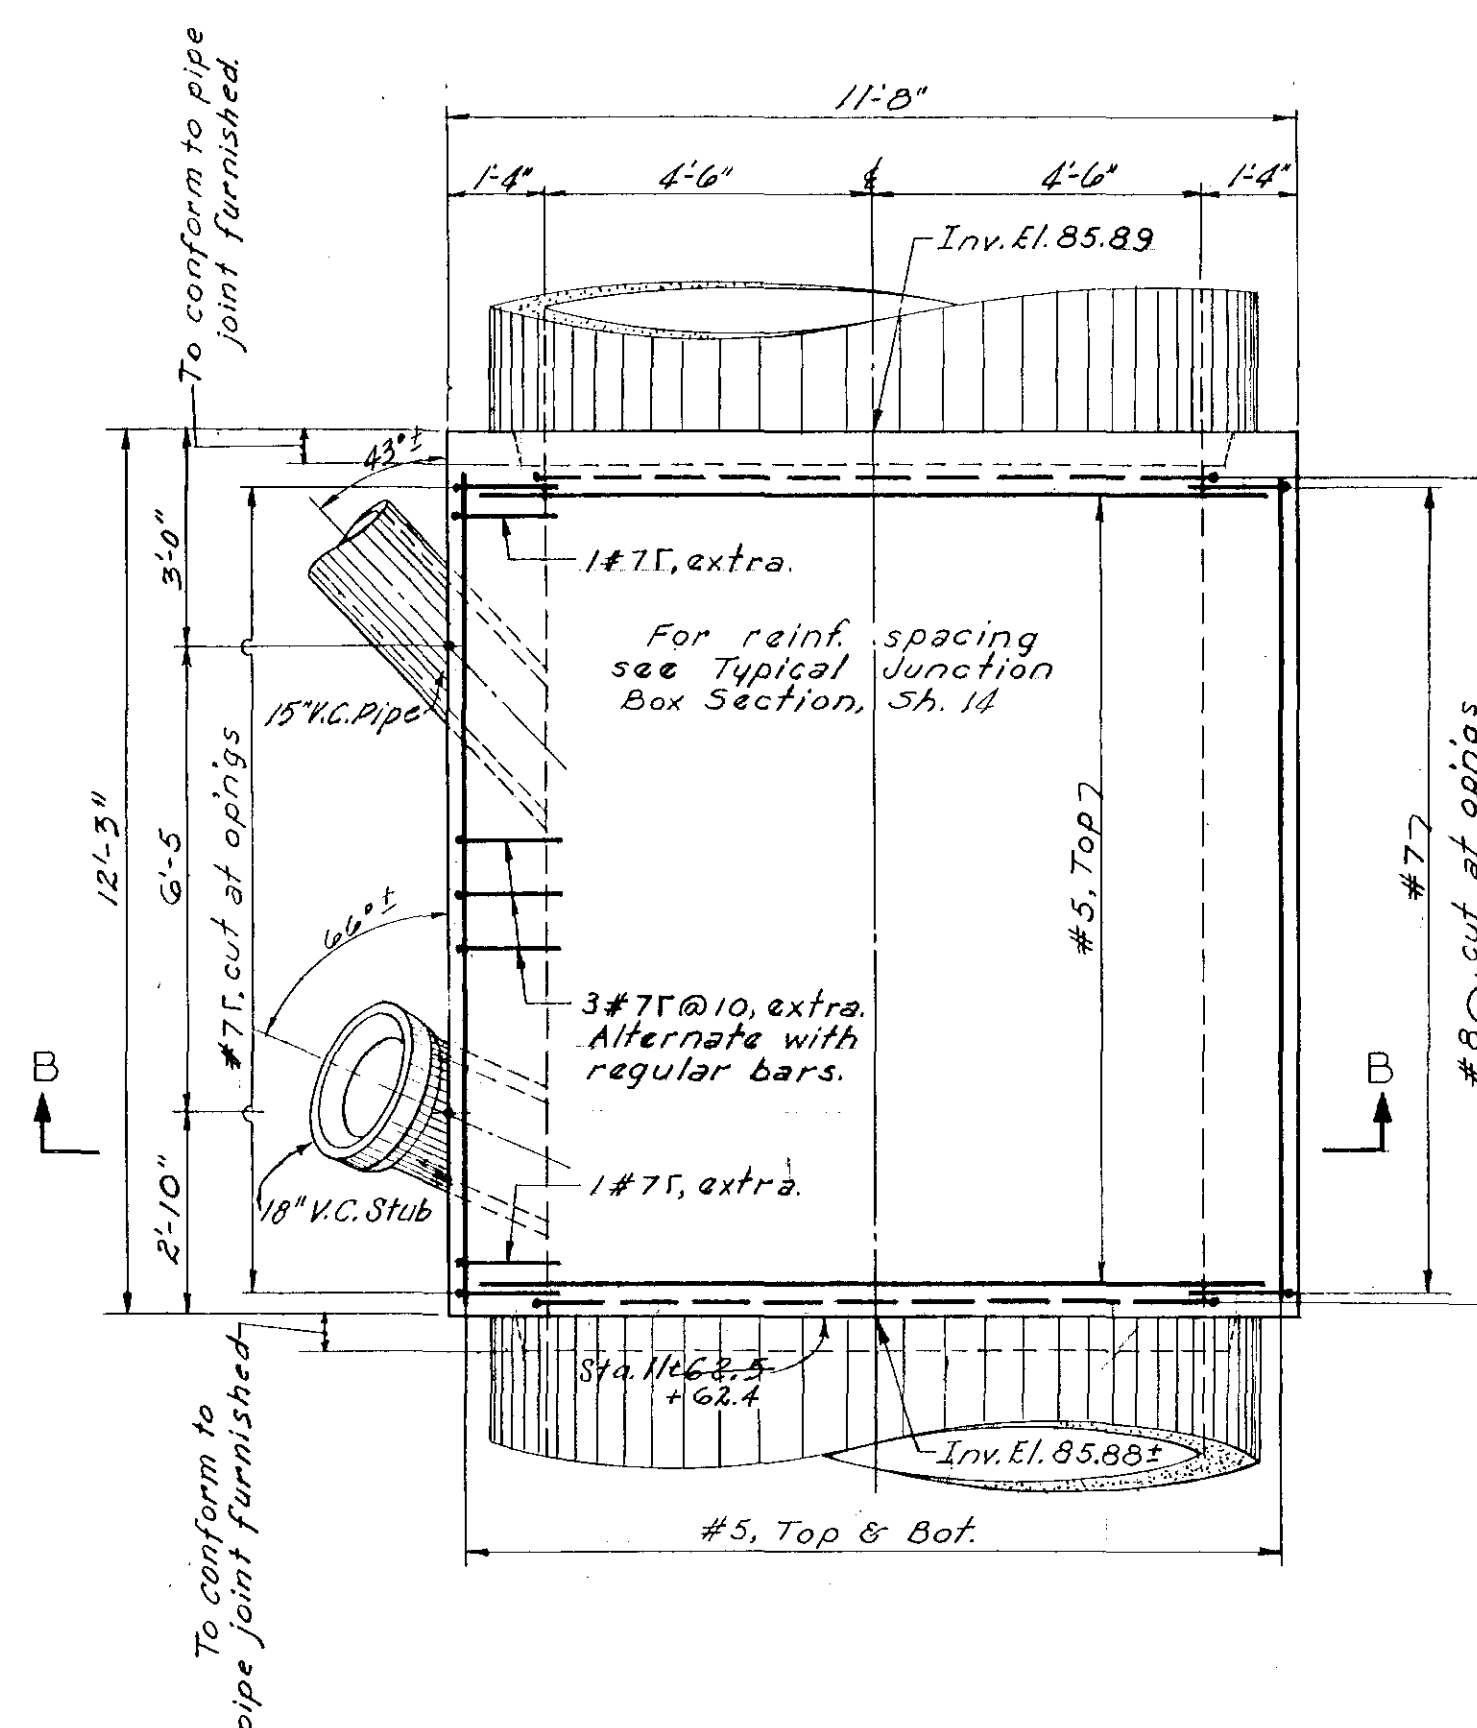


TOP OF JUNCTION BOX
AT OLIVER ST.

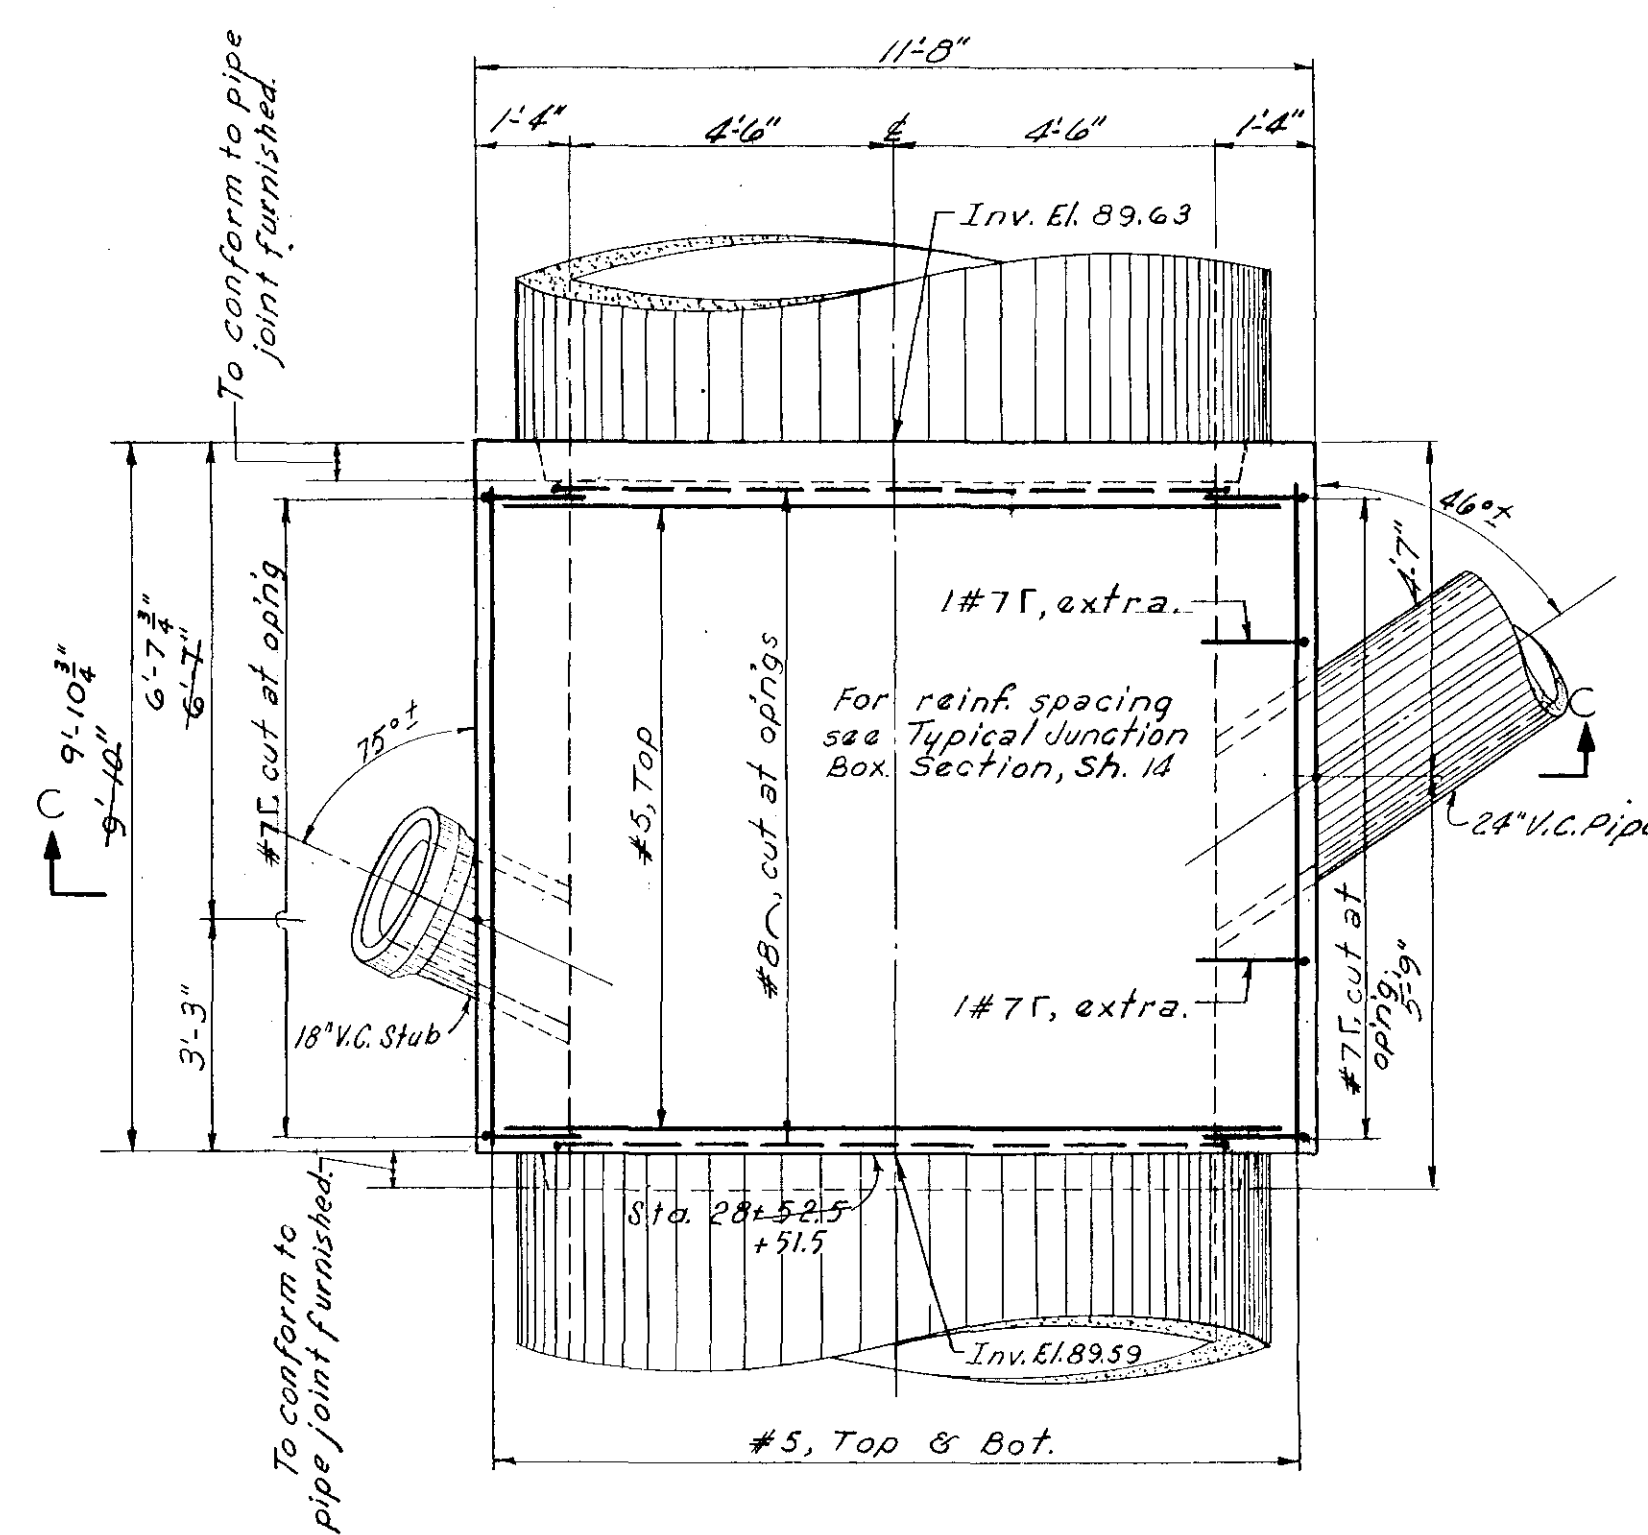


TOP OF JUNCTION BOX
AT FREEMAN ST.

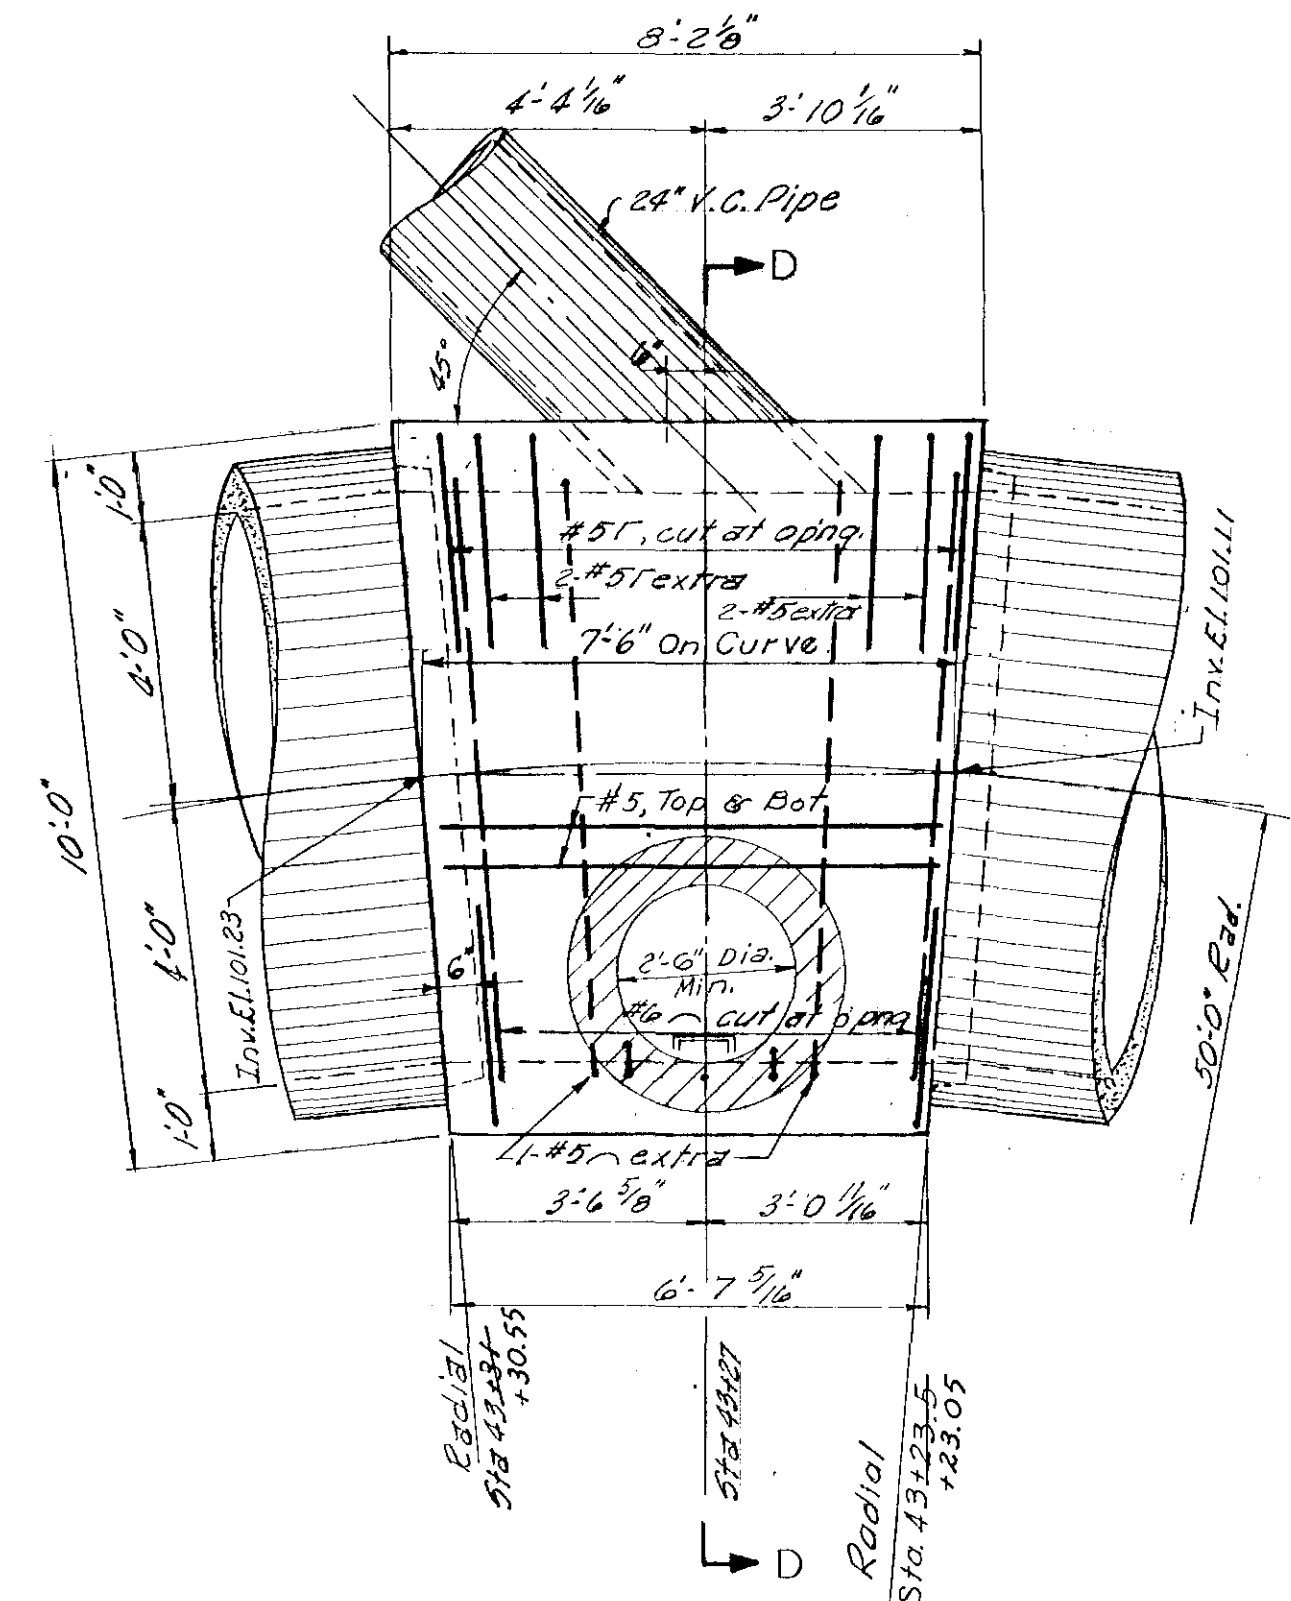


TOP PLAN OF MANHOLE
& JUNCTION BOX AT STA 43+27

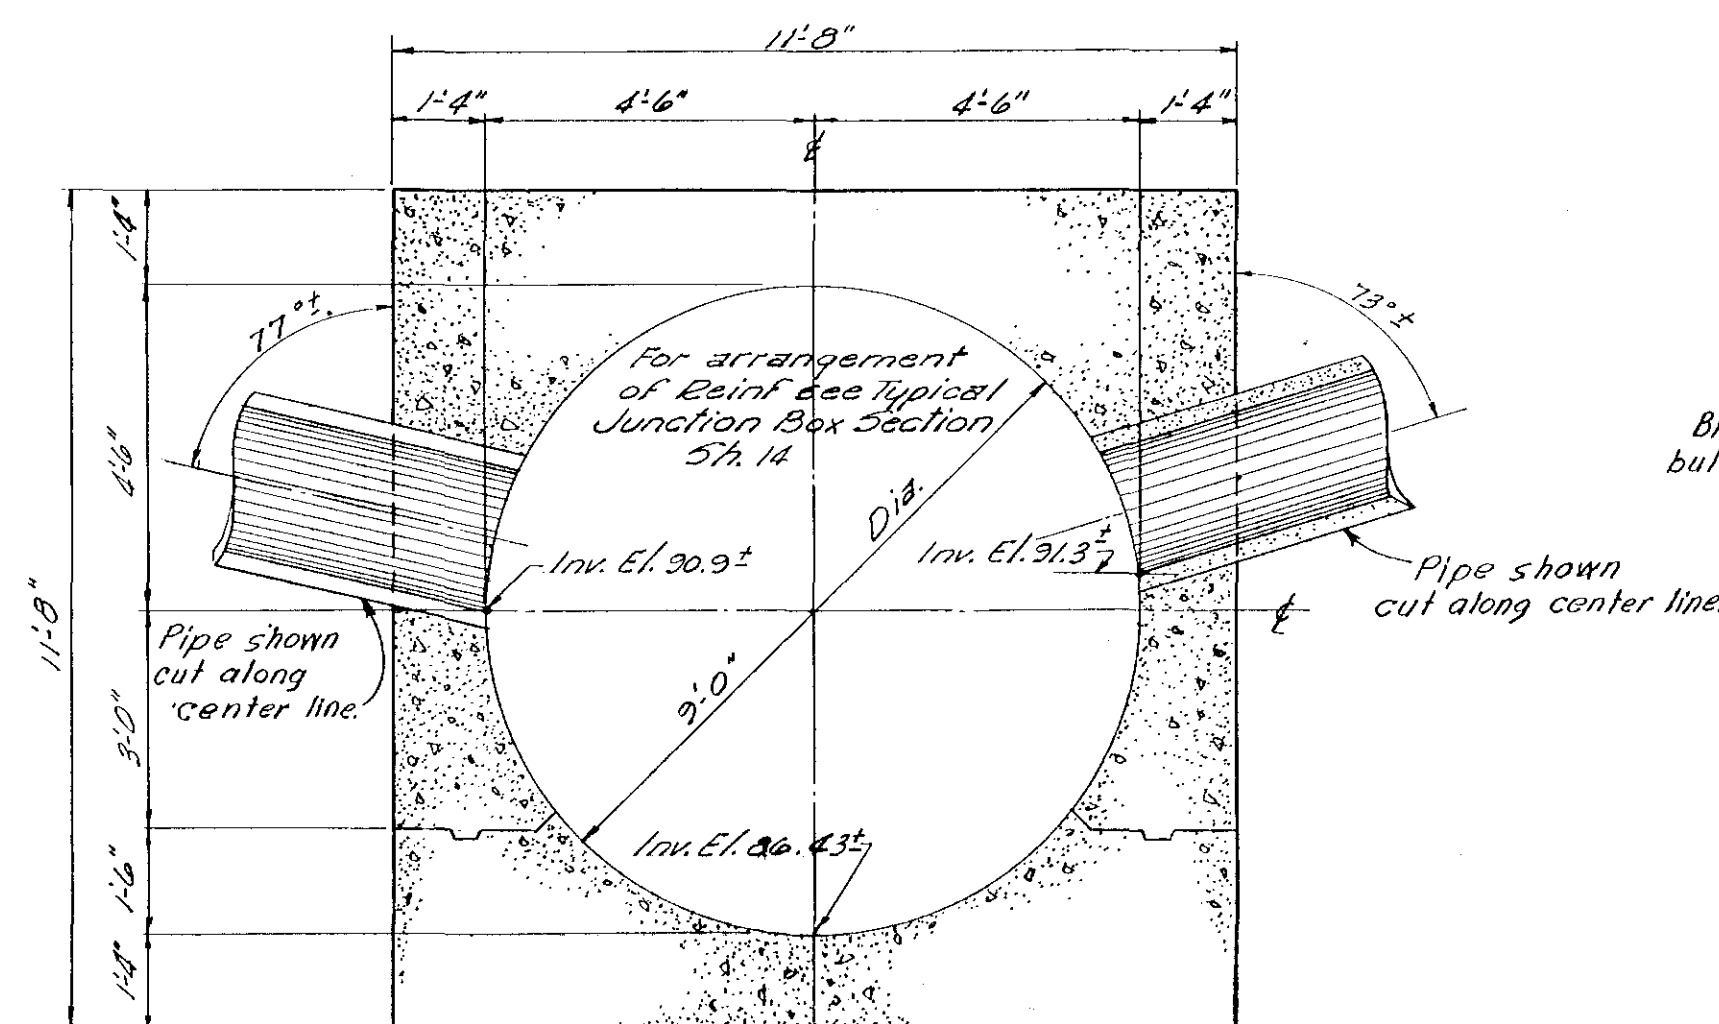


SECTION A - A

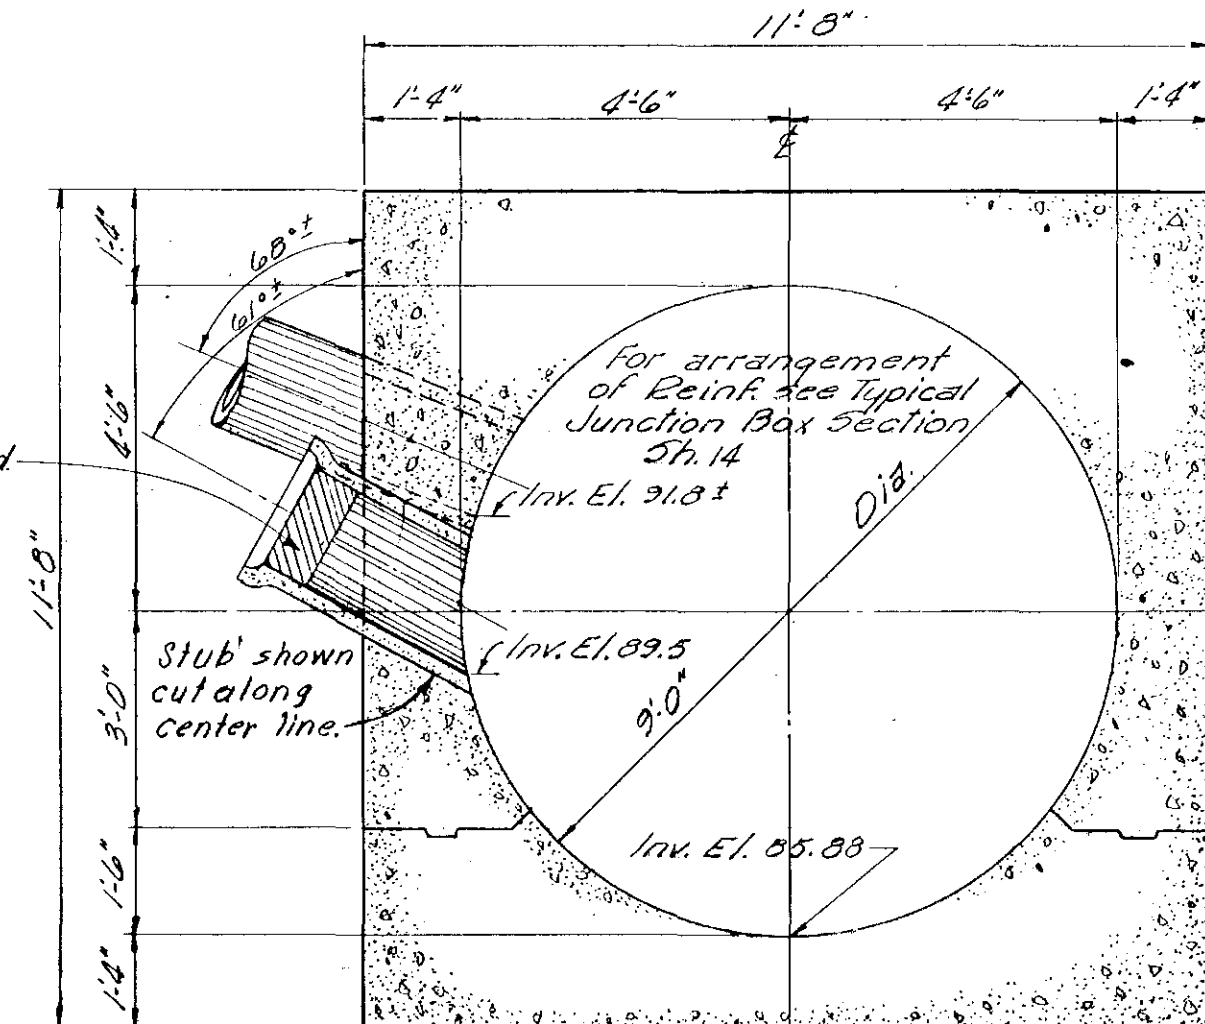

B - B

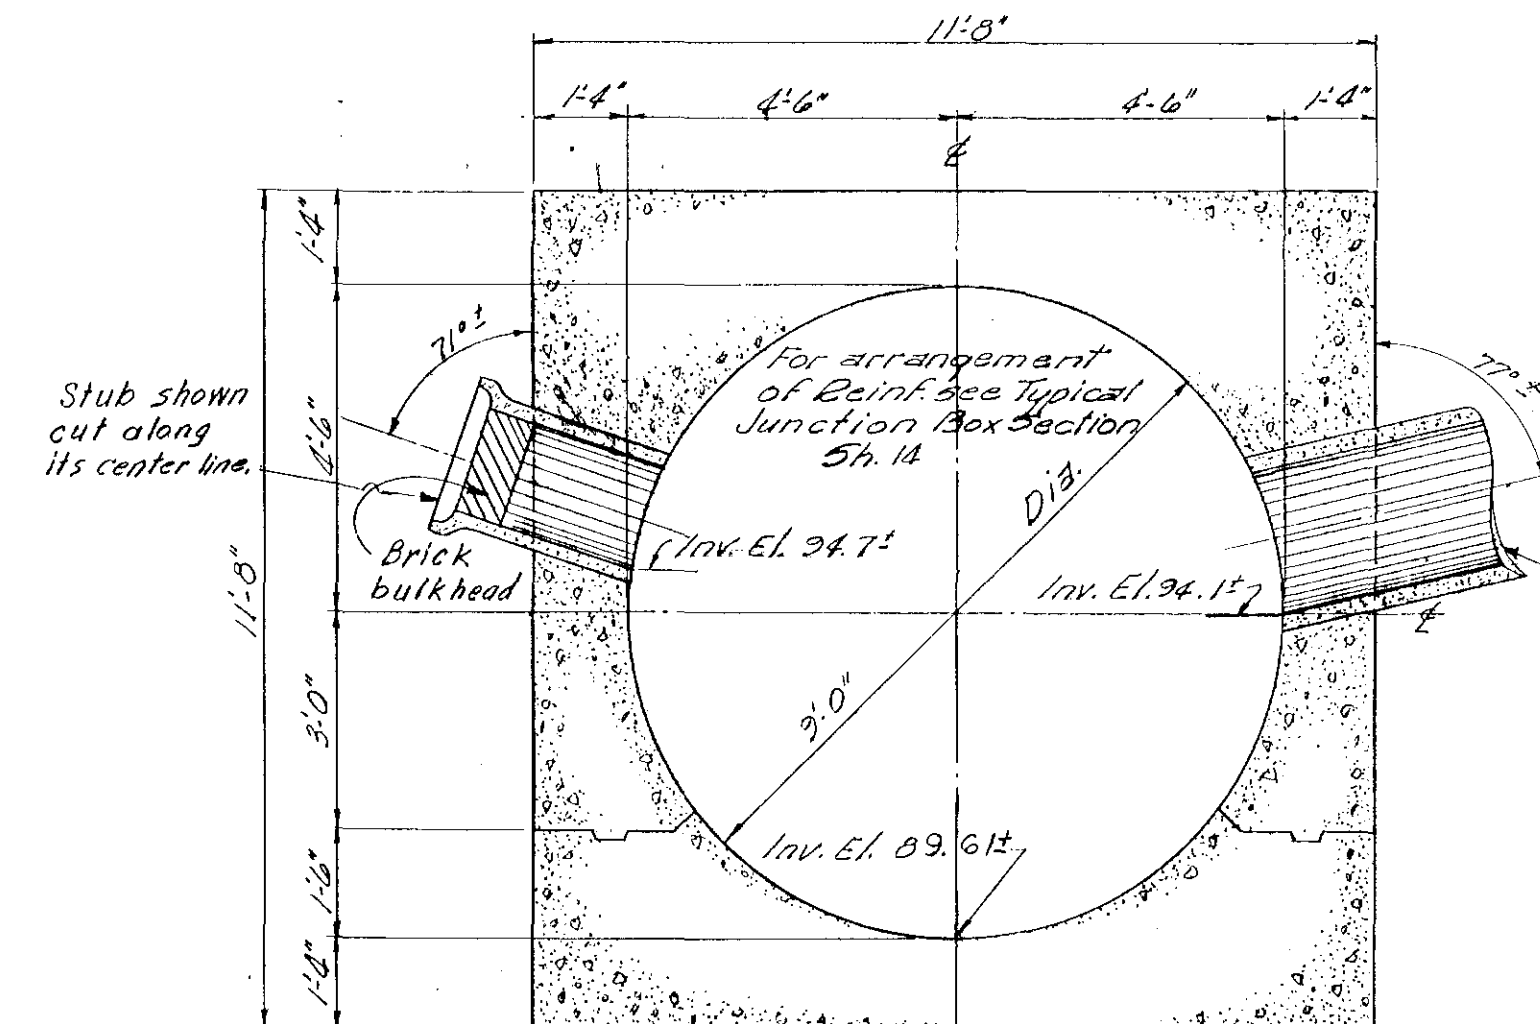

C - C

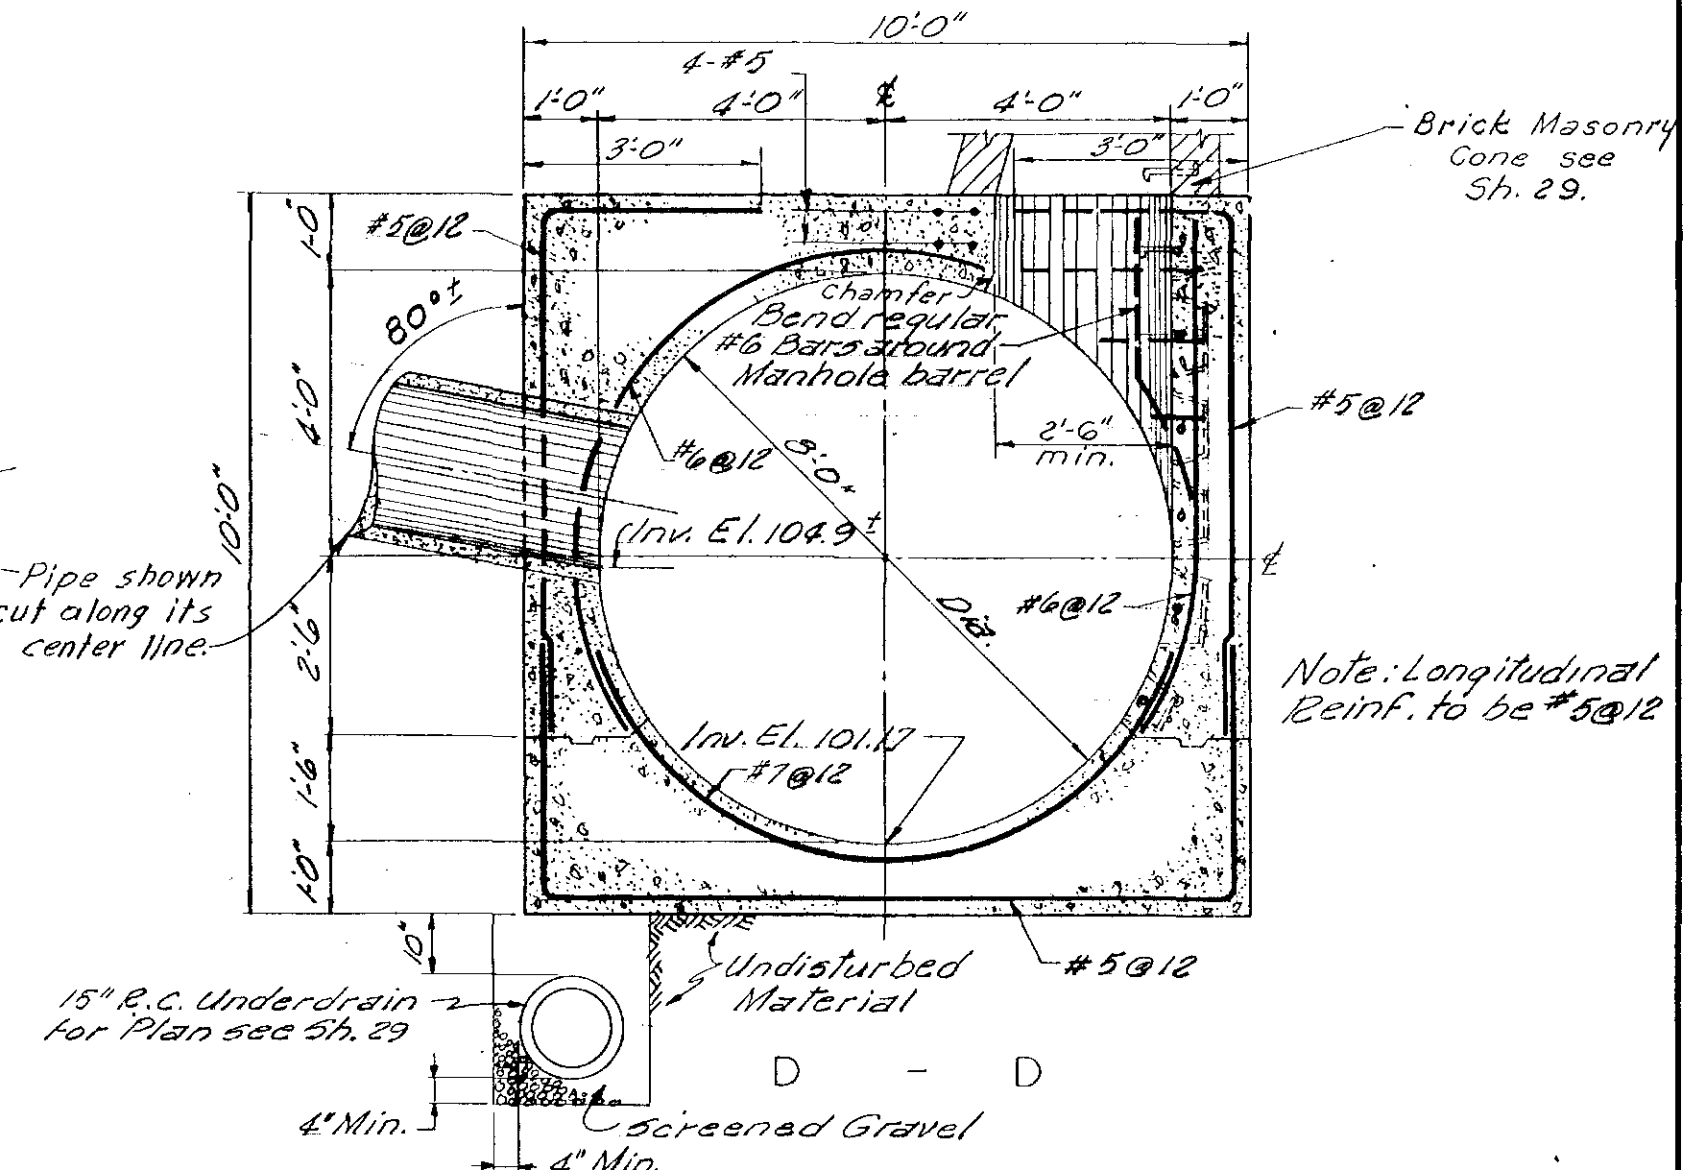

DRAWN BY: D.P.B. S.A.H.
TRACED BY: D.P.B.
CHECKED BY: S.M.O. R.H.L.

REVISION	MADE BY	CHECKED BY	DESCRIPTION
1.	JAN. 1960 J.F.G.	S.A.H.	Record Revisions.
2.	JUNE 14, 1961 L.S.B.	S.A.H.	STUBS REVISED
3.	JUNE 14, 1961 L.S.B.	S.A.H.	UNDERSIDES AND STATIONS CORRECTED. REVISIONS OF STRUCTURE.
4.	JUNE 14, 1961 L.S.B.	S.A.H.	NOTES ADDED

Notes:

- For General Plan at Oliver & White Streets see Sh. 20
- For General Plan at Freeman Street see Sh. 23
- For Details of connection at Sta. 43+27 see Sh. 29
- Connecting Pipes to be cut off flush with inside wall of structure.

RECORD DRAWING

APPROVED	
FOR PARK RIVER FLOOD CONTROL COMMISSION	5/7/57
John W. Raymond, Jr. Director	DATE
REG. PROF. ENGR. CT. NO. 290	
FOR METCALF & EDDY, ENGINEERS	
John W. Raymond, Jr.	5/10/57
REG. PROF. ENGR. CT. NO. 3422	DATE

PARK RIVER FLOOD CONTROL COMMISSION HARTFORD, CONNECTICUT	
CEMETERY BROOK CONDUIT	
MANHOLES AND JUNCTION BOXES	
PLANS AND SECTIONS II	
SCALE, 3/8" = 1'-0"	MAY, 1957
METCALF & EDDY ENGINEERS BOSTON, MASS.	

34277
H
18457