



1981
H
E8285

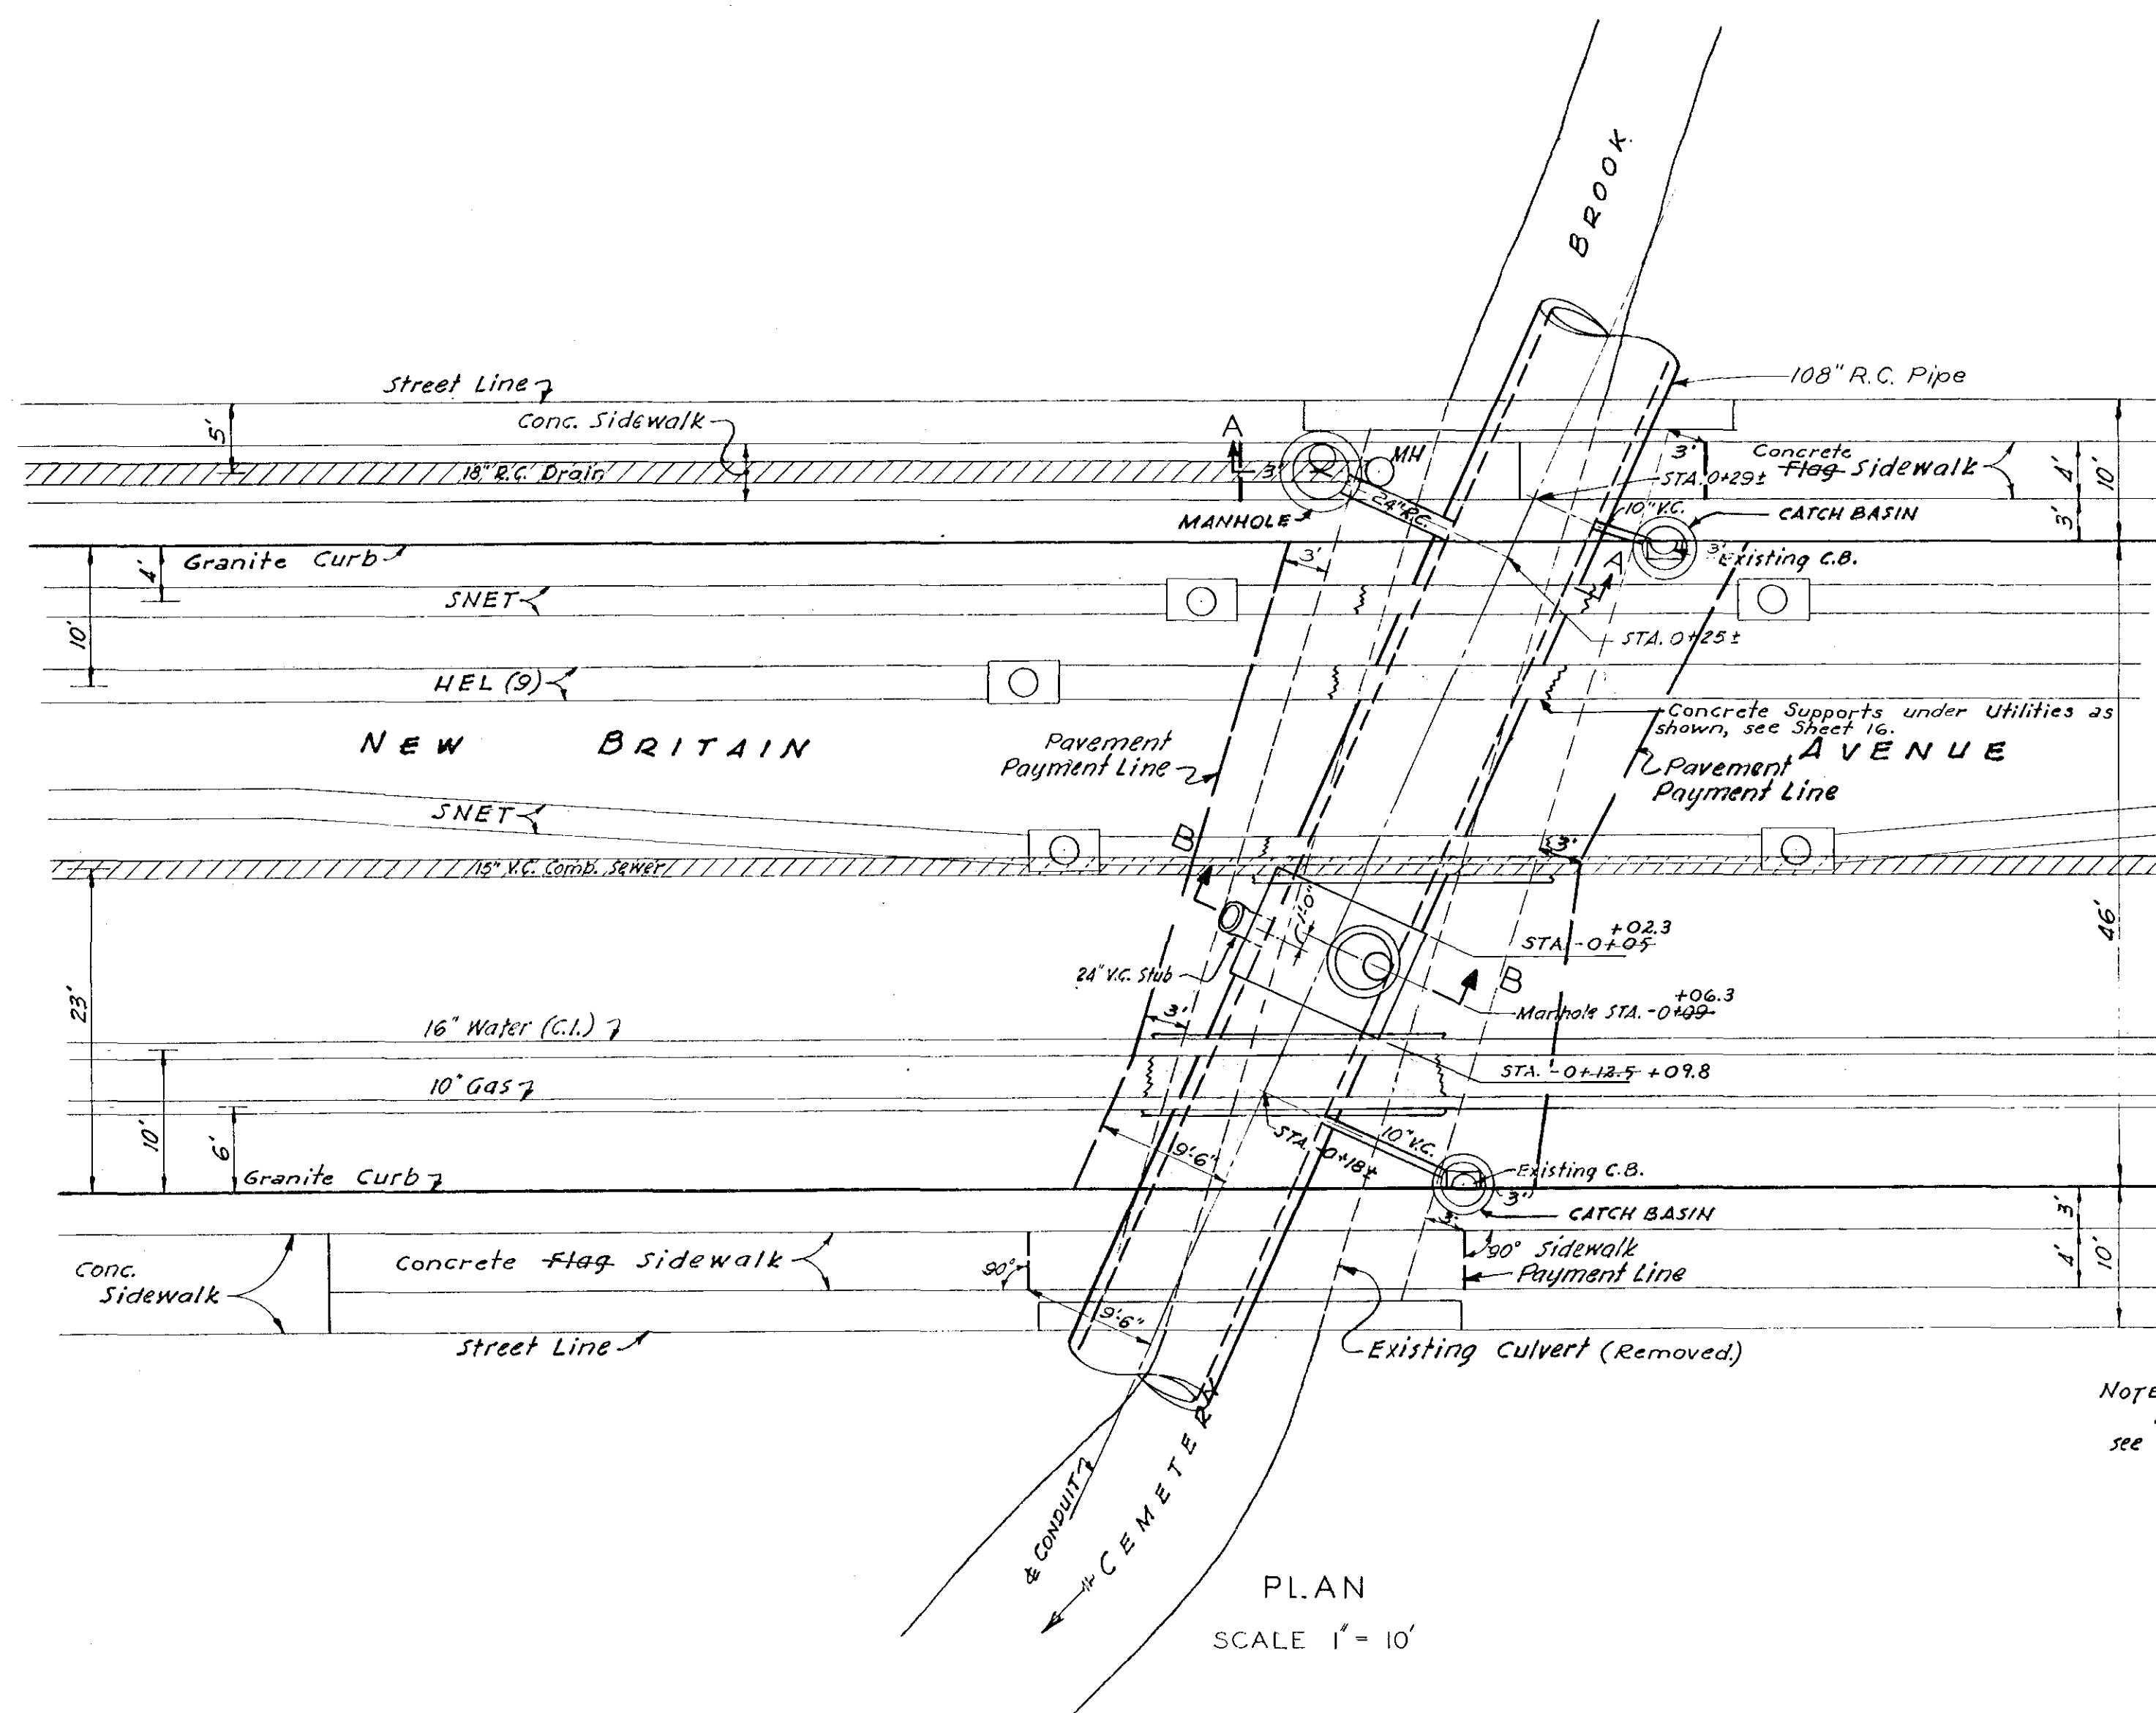


Note: Payment Lines refer to Items 23 and 24, see specifications.


PLAN
SCALE 1" = 10'

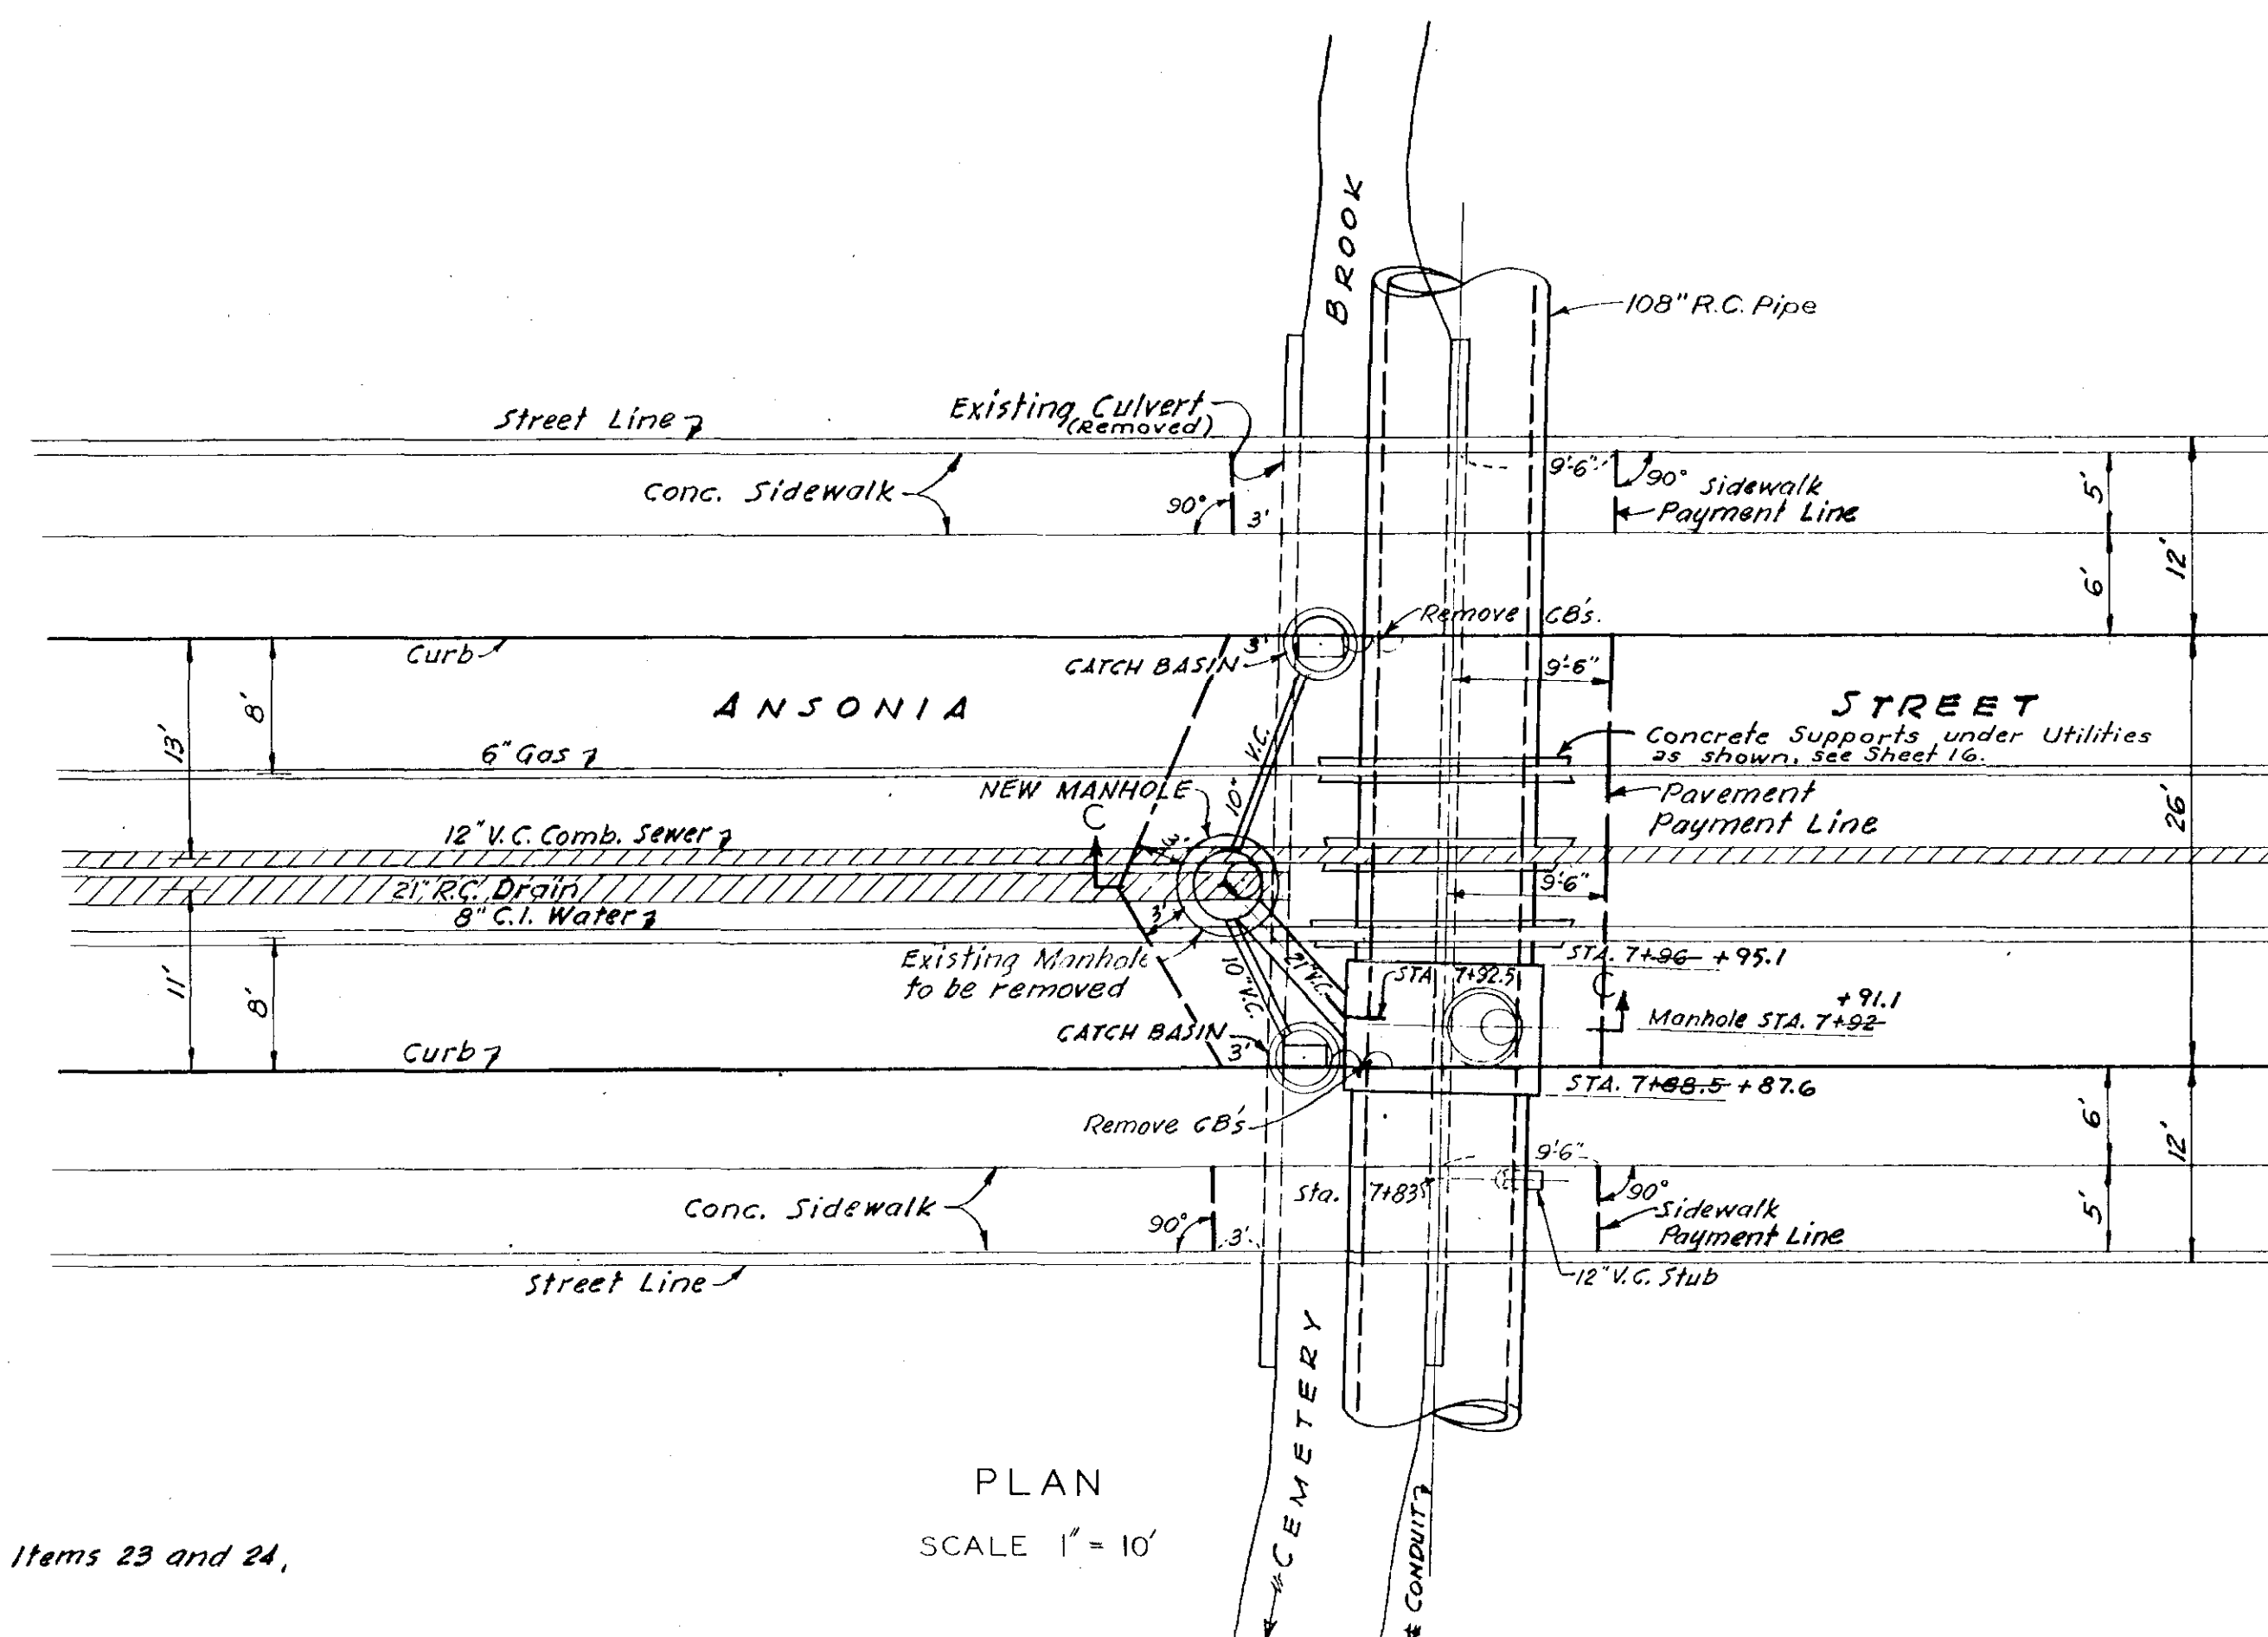


PLAN
SCALE 1" = 10'

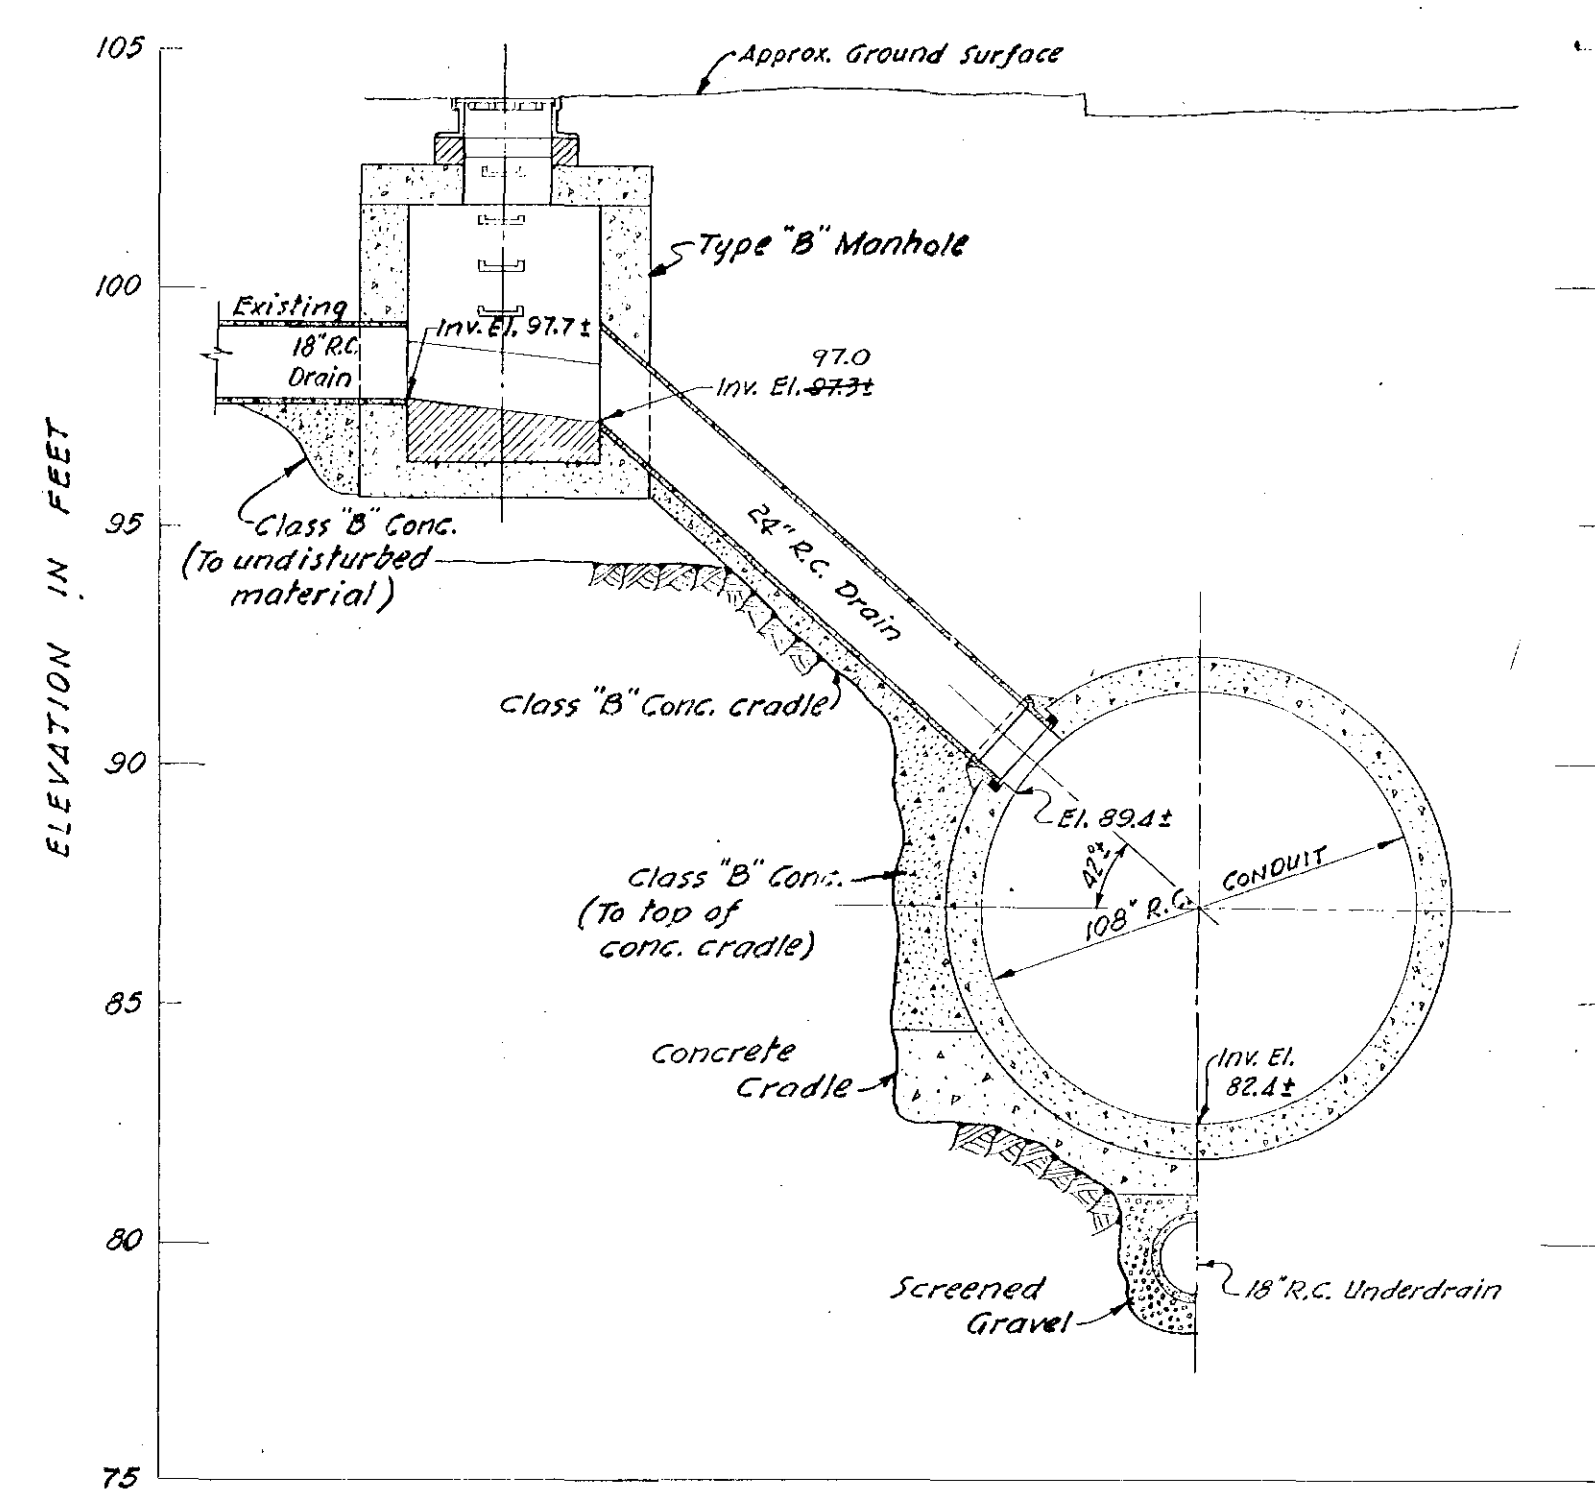

SECTION A - A
SCALE 1" = 4'

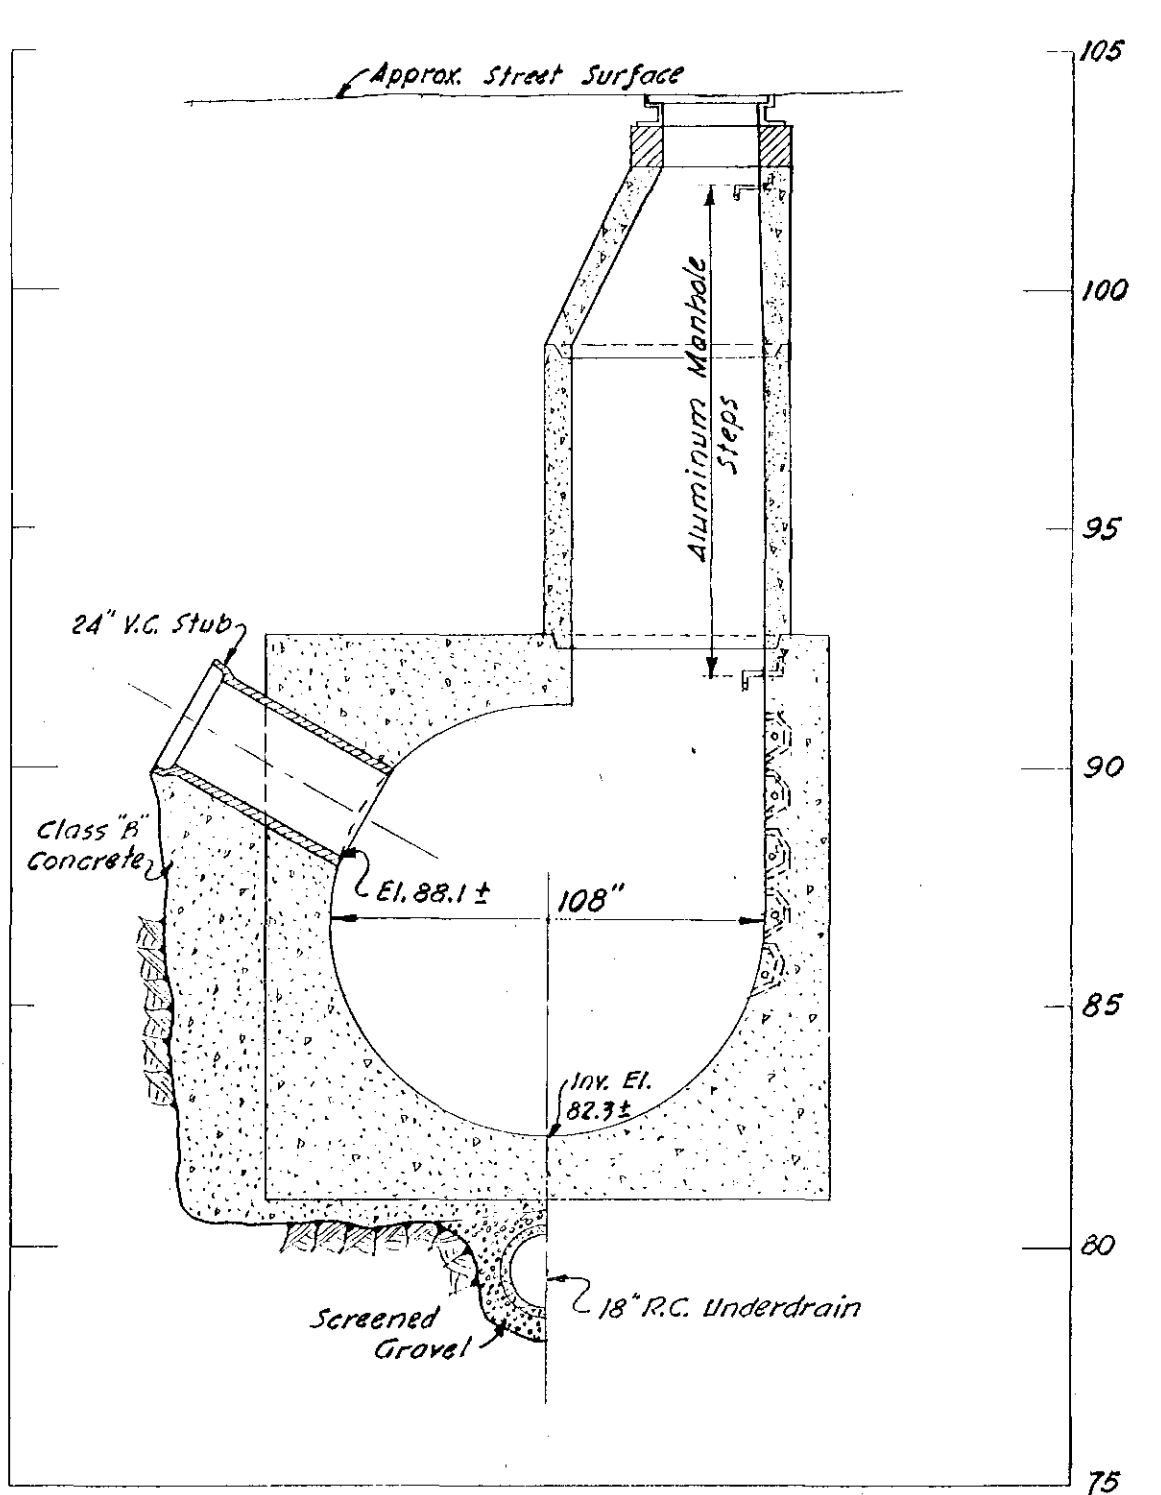

SECTION B - B
SCALE 1" = 4'

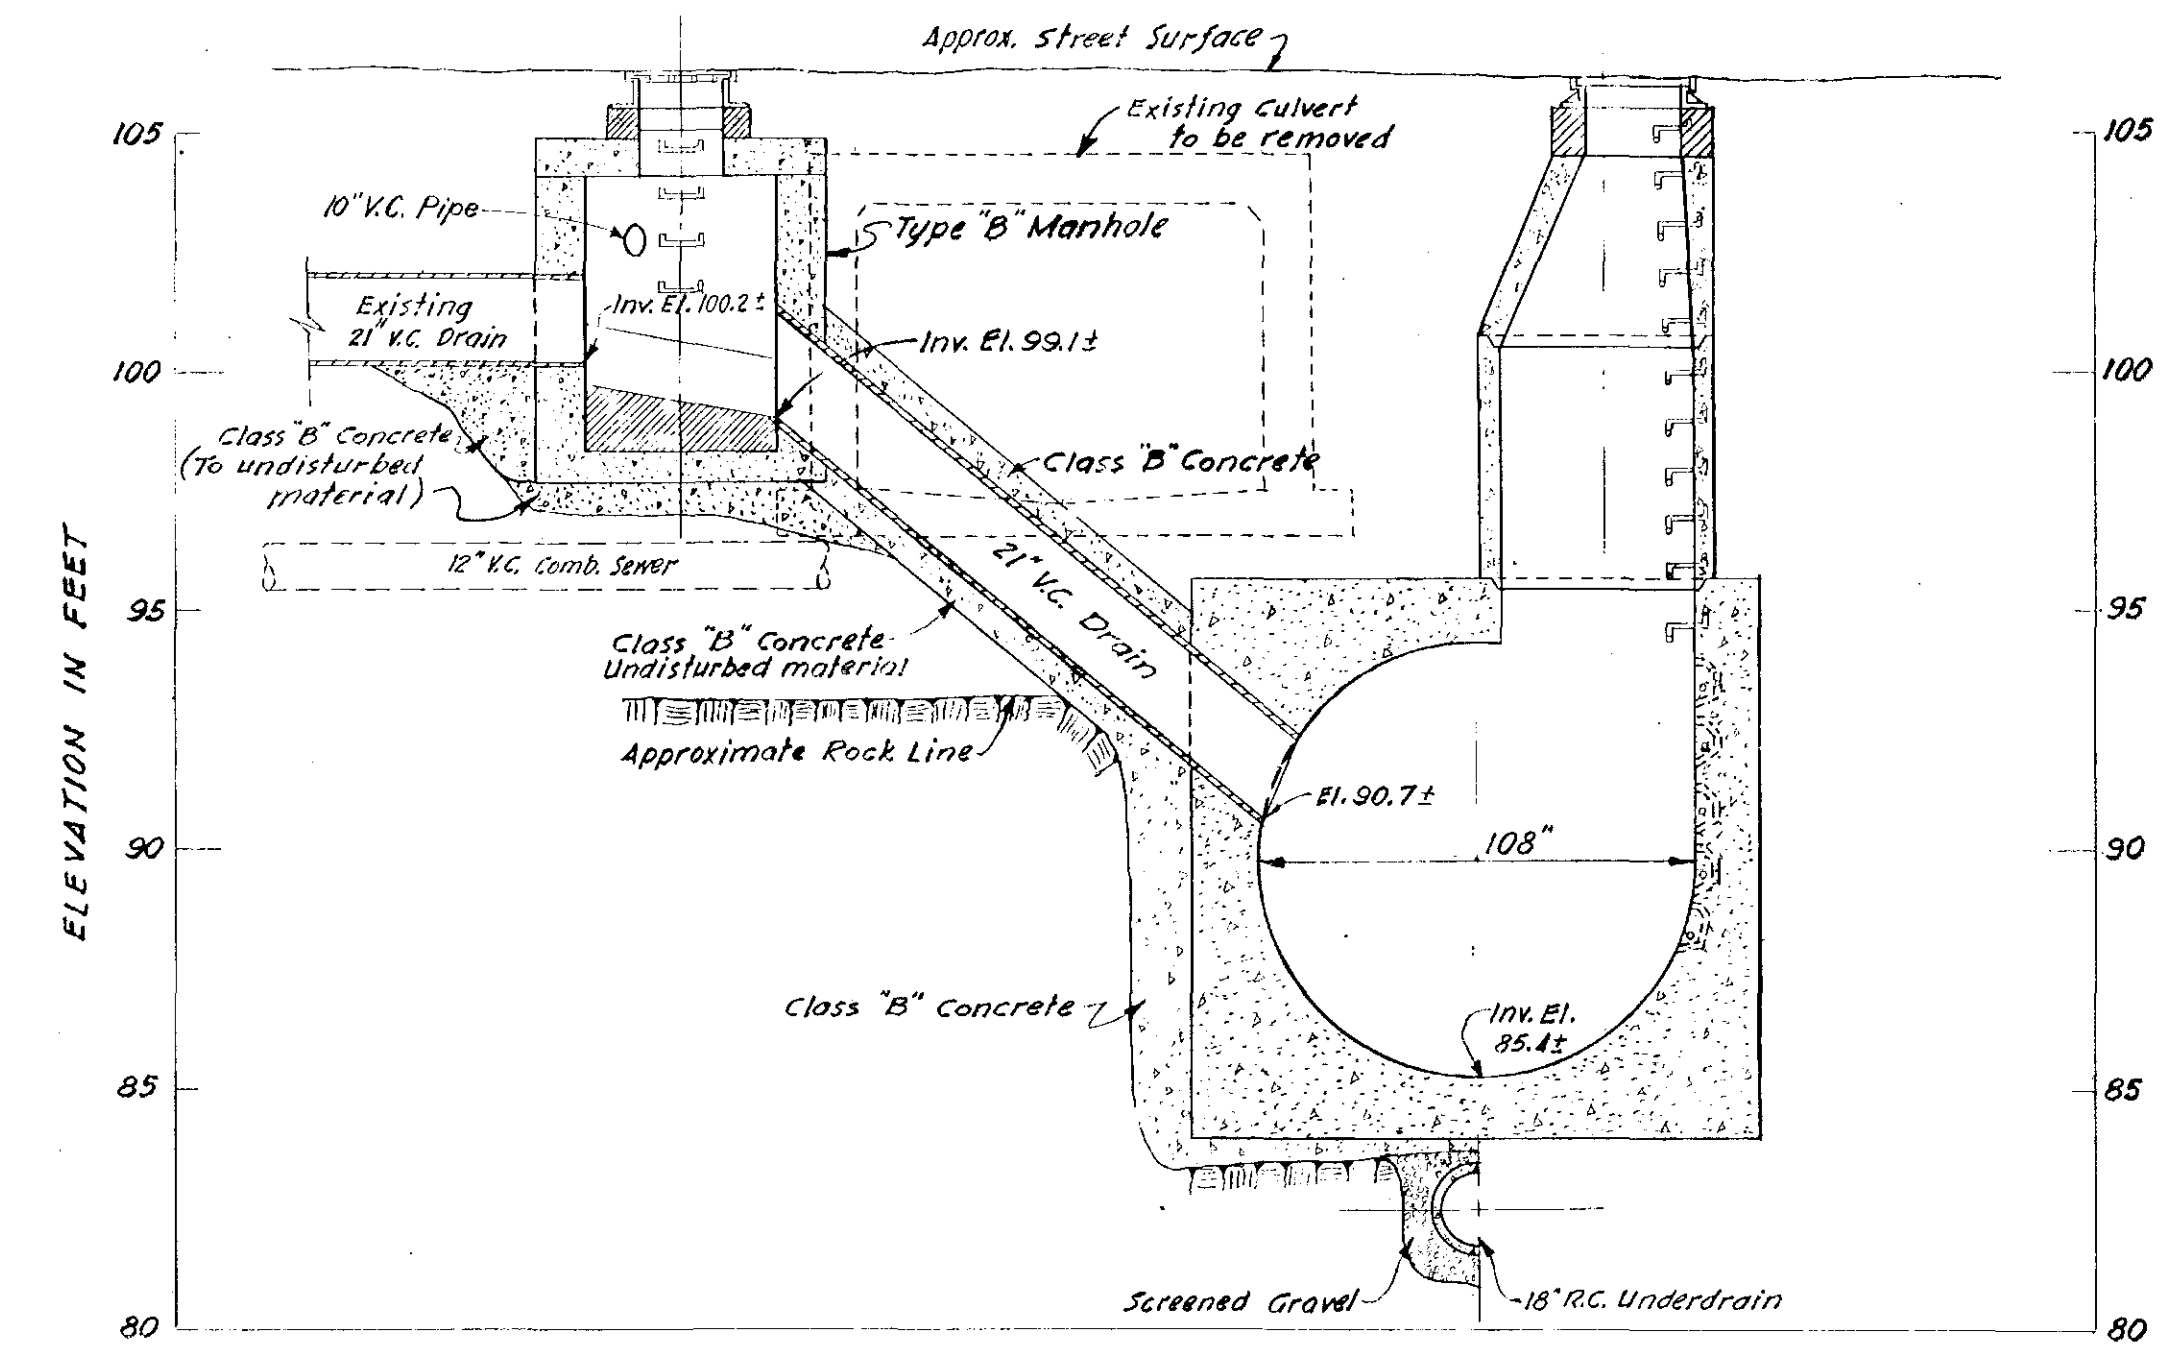

SECTION C - C
SCALE 1" = 4'

DRAWN BY: S.A.H.
TRACED BY: A.J.P.
CHECKED BY: R.H.L.

RECORD DRAWING

REVISION	MADE BY	CHECKED BY	DESCRIPTION
2. Jan. 1960	J.F.G.	S.A.H.	Record Revisions.
1. JULY 1957	L.S.B.	S.A.H.	STATIONED "CHURCH" TO NEW BRITAIN AVE. & ANSONIA ST.

APPROVED	
FOR PARK RIVER FLOOD CONTROL COMMISSION	
Director	5/1/57
REG. PROF. ENGR. CT. NO. 290	DATE
FOR METCALF & EDDY, ENGINEERS	
John W. Raymond, Jr.	5/10/57
REG. PROF. ENGR. CT. NO. 3422	DATE

PARK RIVER FLOOD CONTROL COMMISSION
HARTFORD, CONNECTICUT
CEMETERY BROOK CONDUIT
CONNECTIONS AT NEW BRITAIN AVE.
AND ANSONIA ST.

SCALE, AS SHOWN MAY, 1957

METCALF & EDDY
ENGINEERS
BOSTON, MASS.

34283
H
18461

Contract No. 000 884

CONTRACT 1957-3

SHEET 19 OF 31