

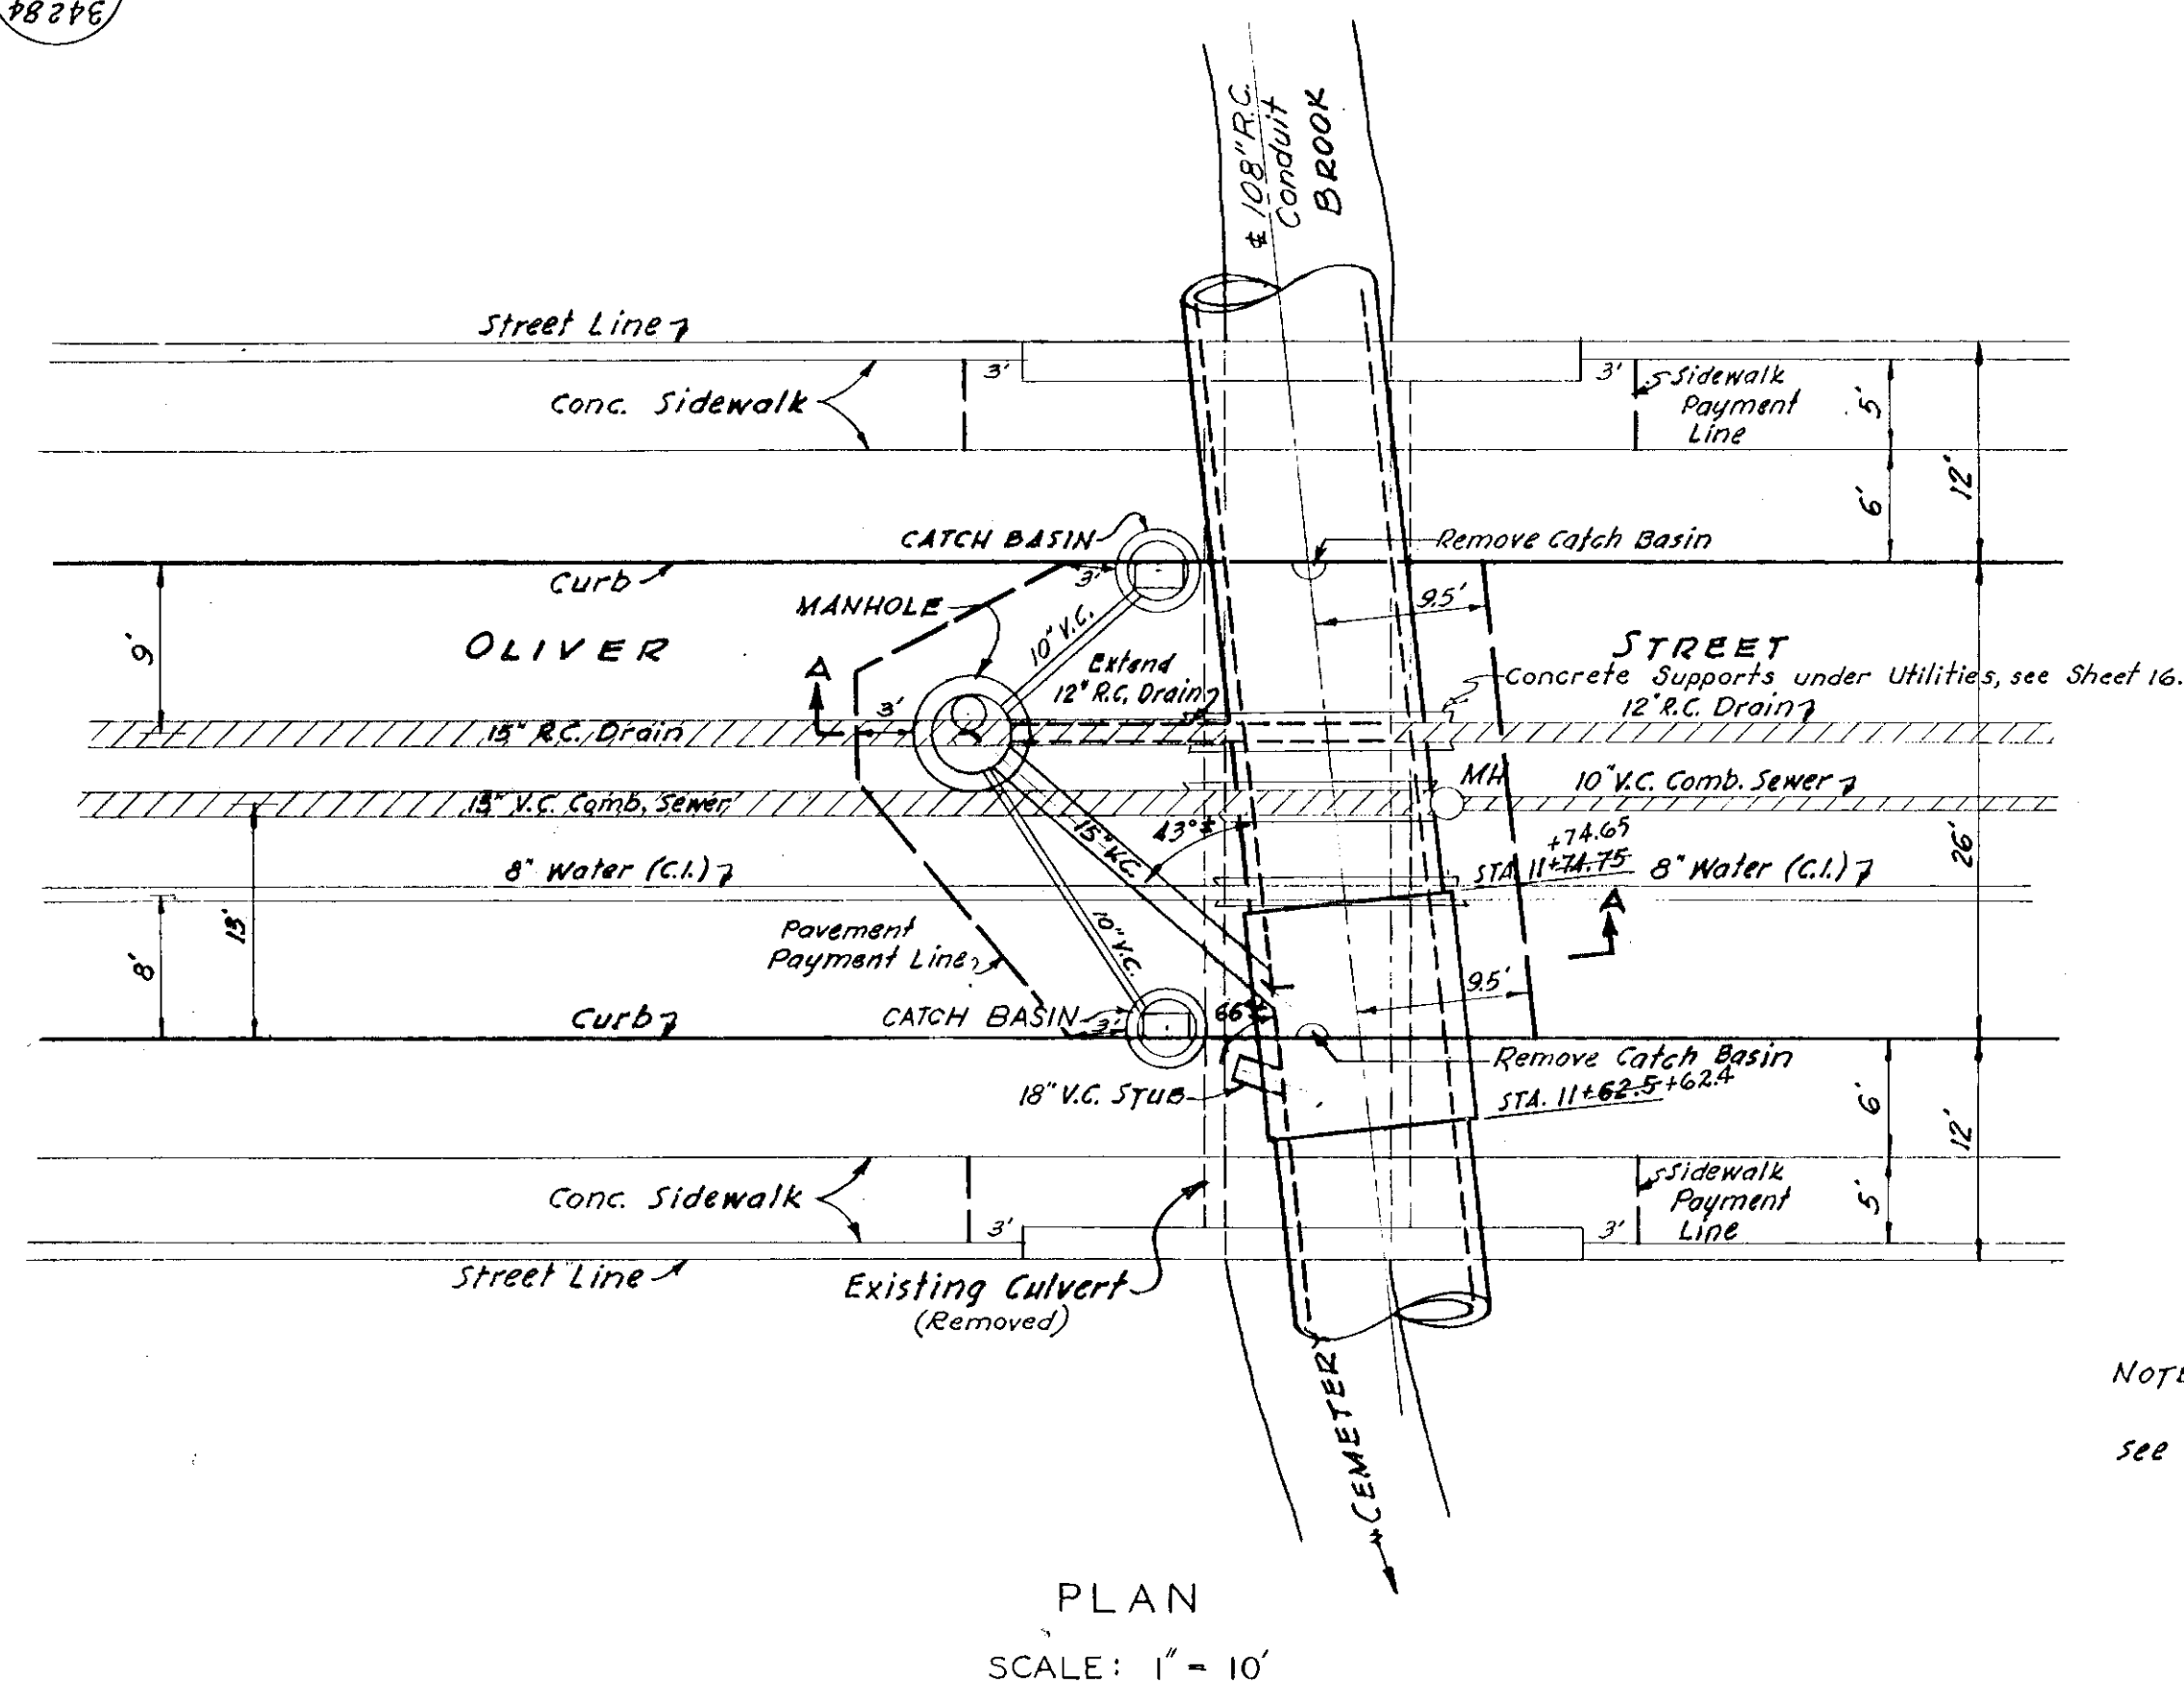
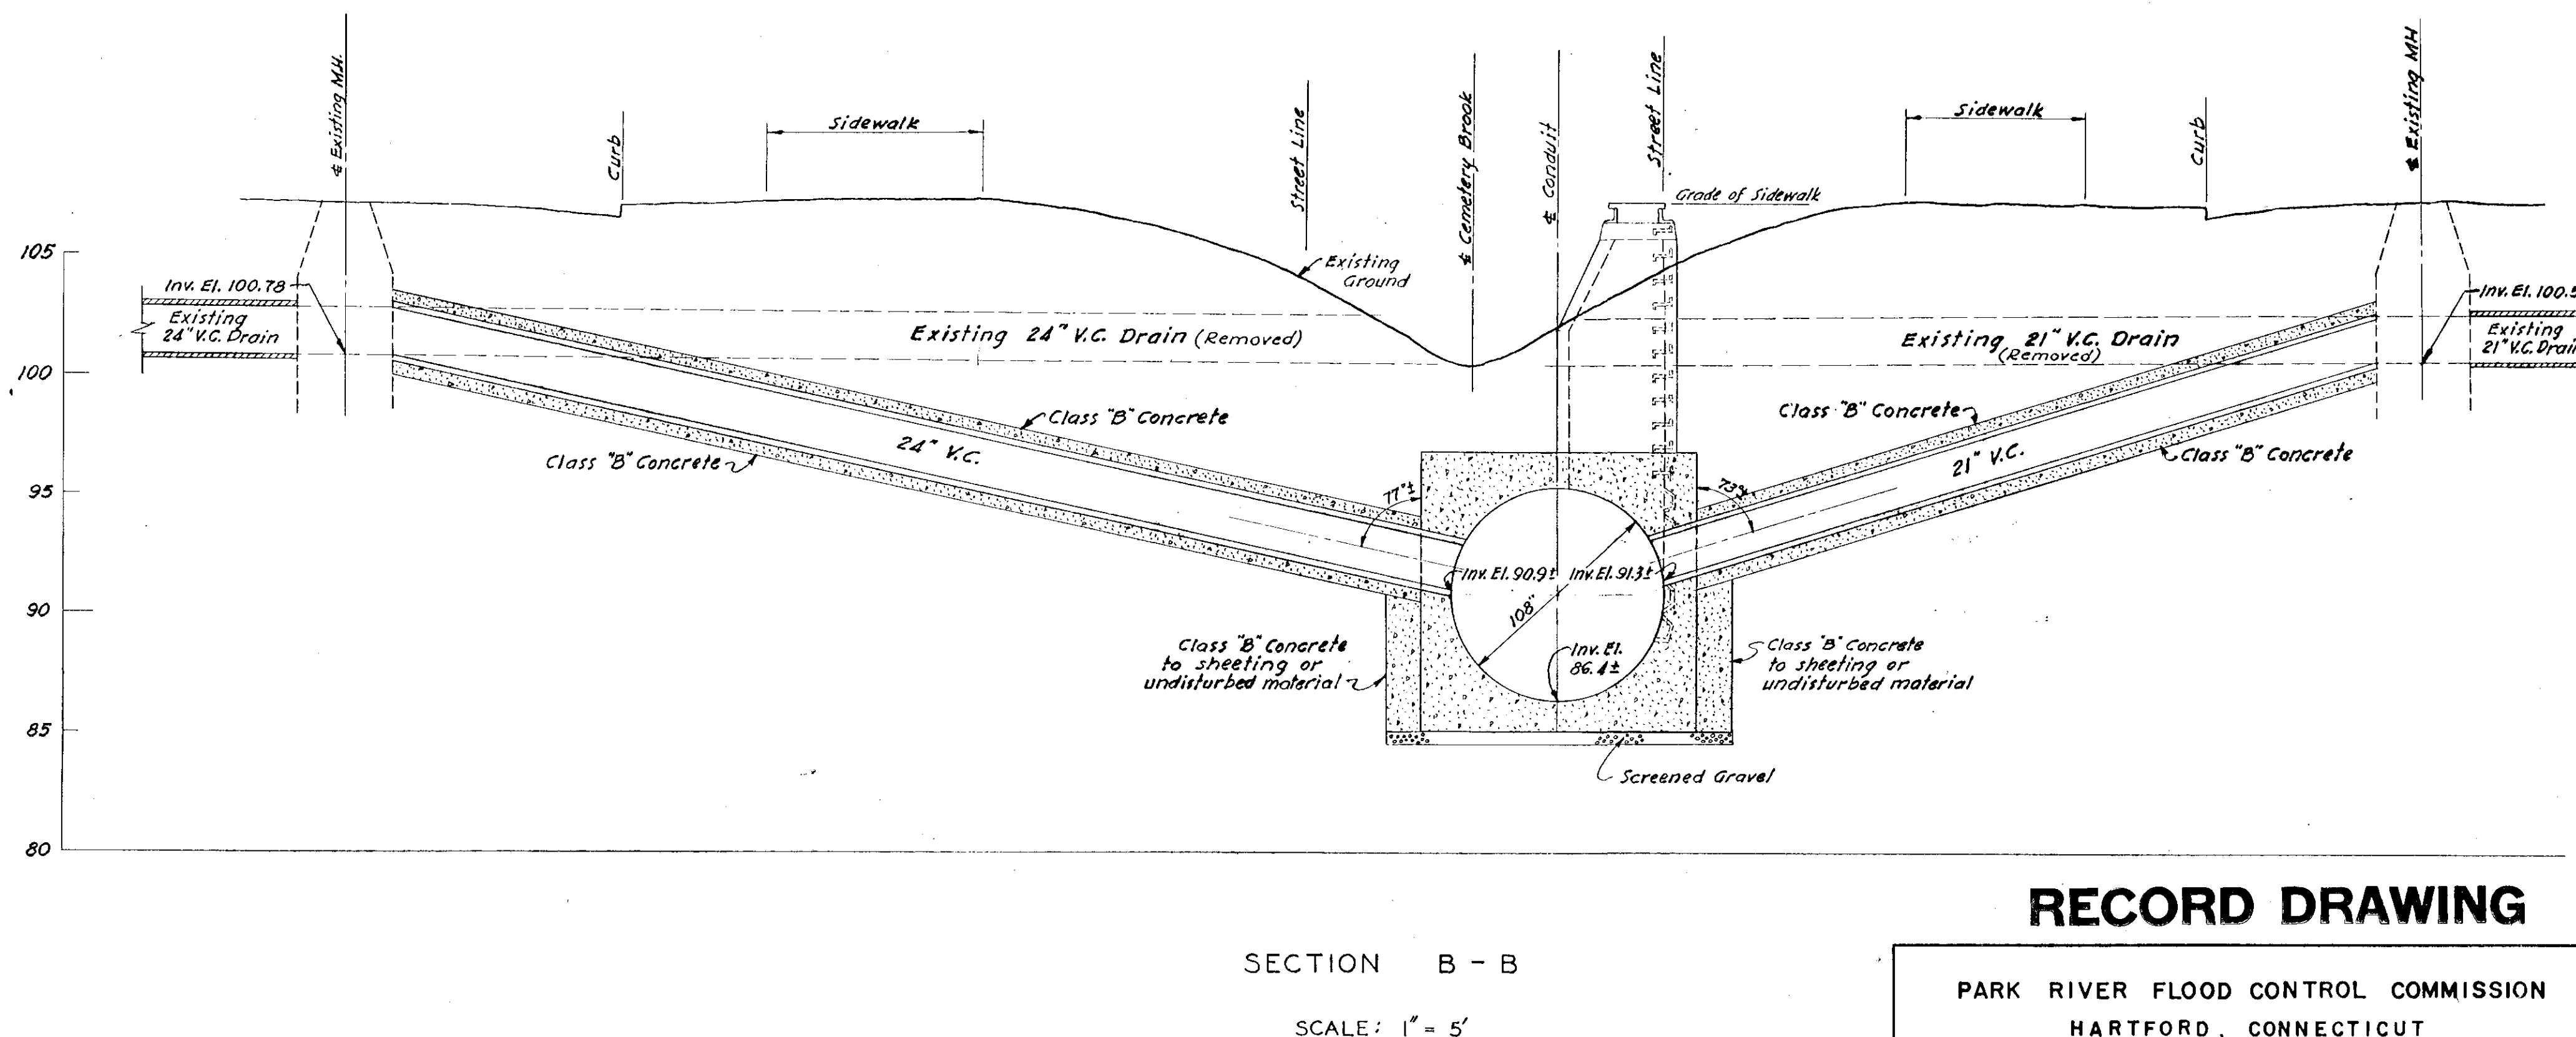


29981
H
38246

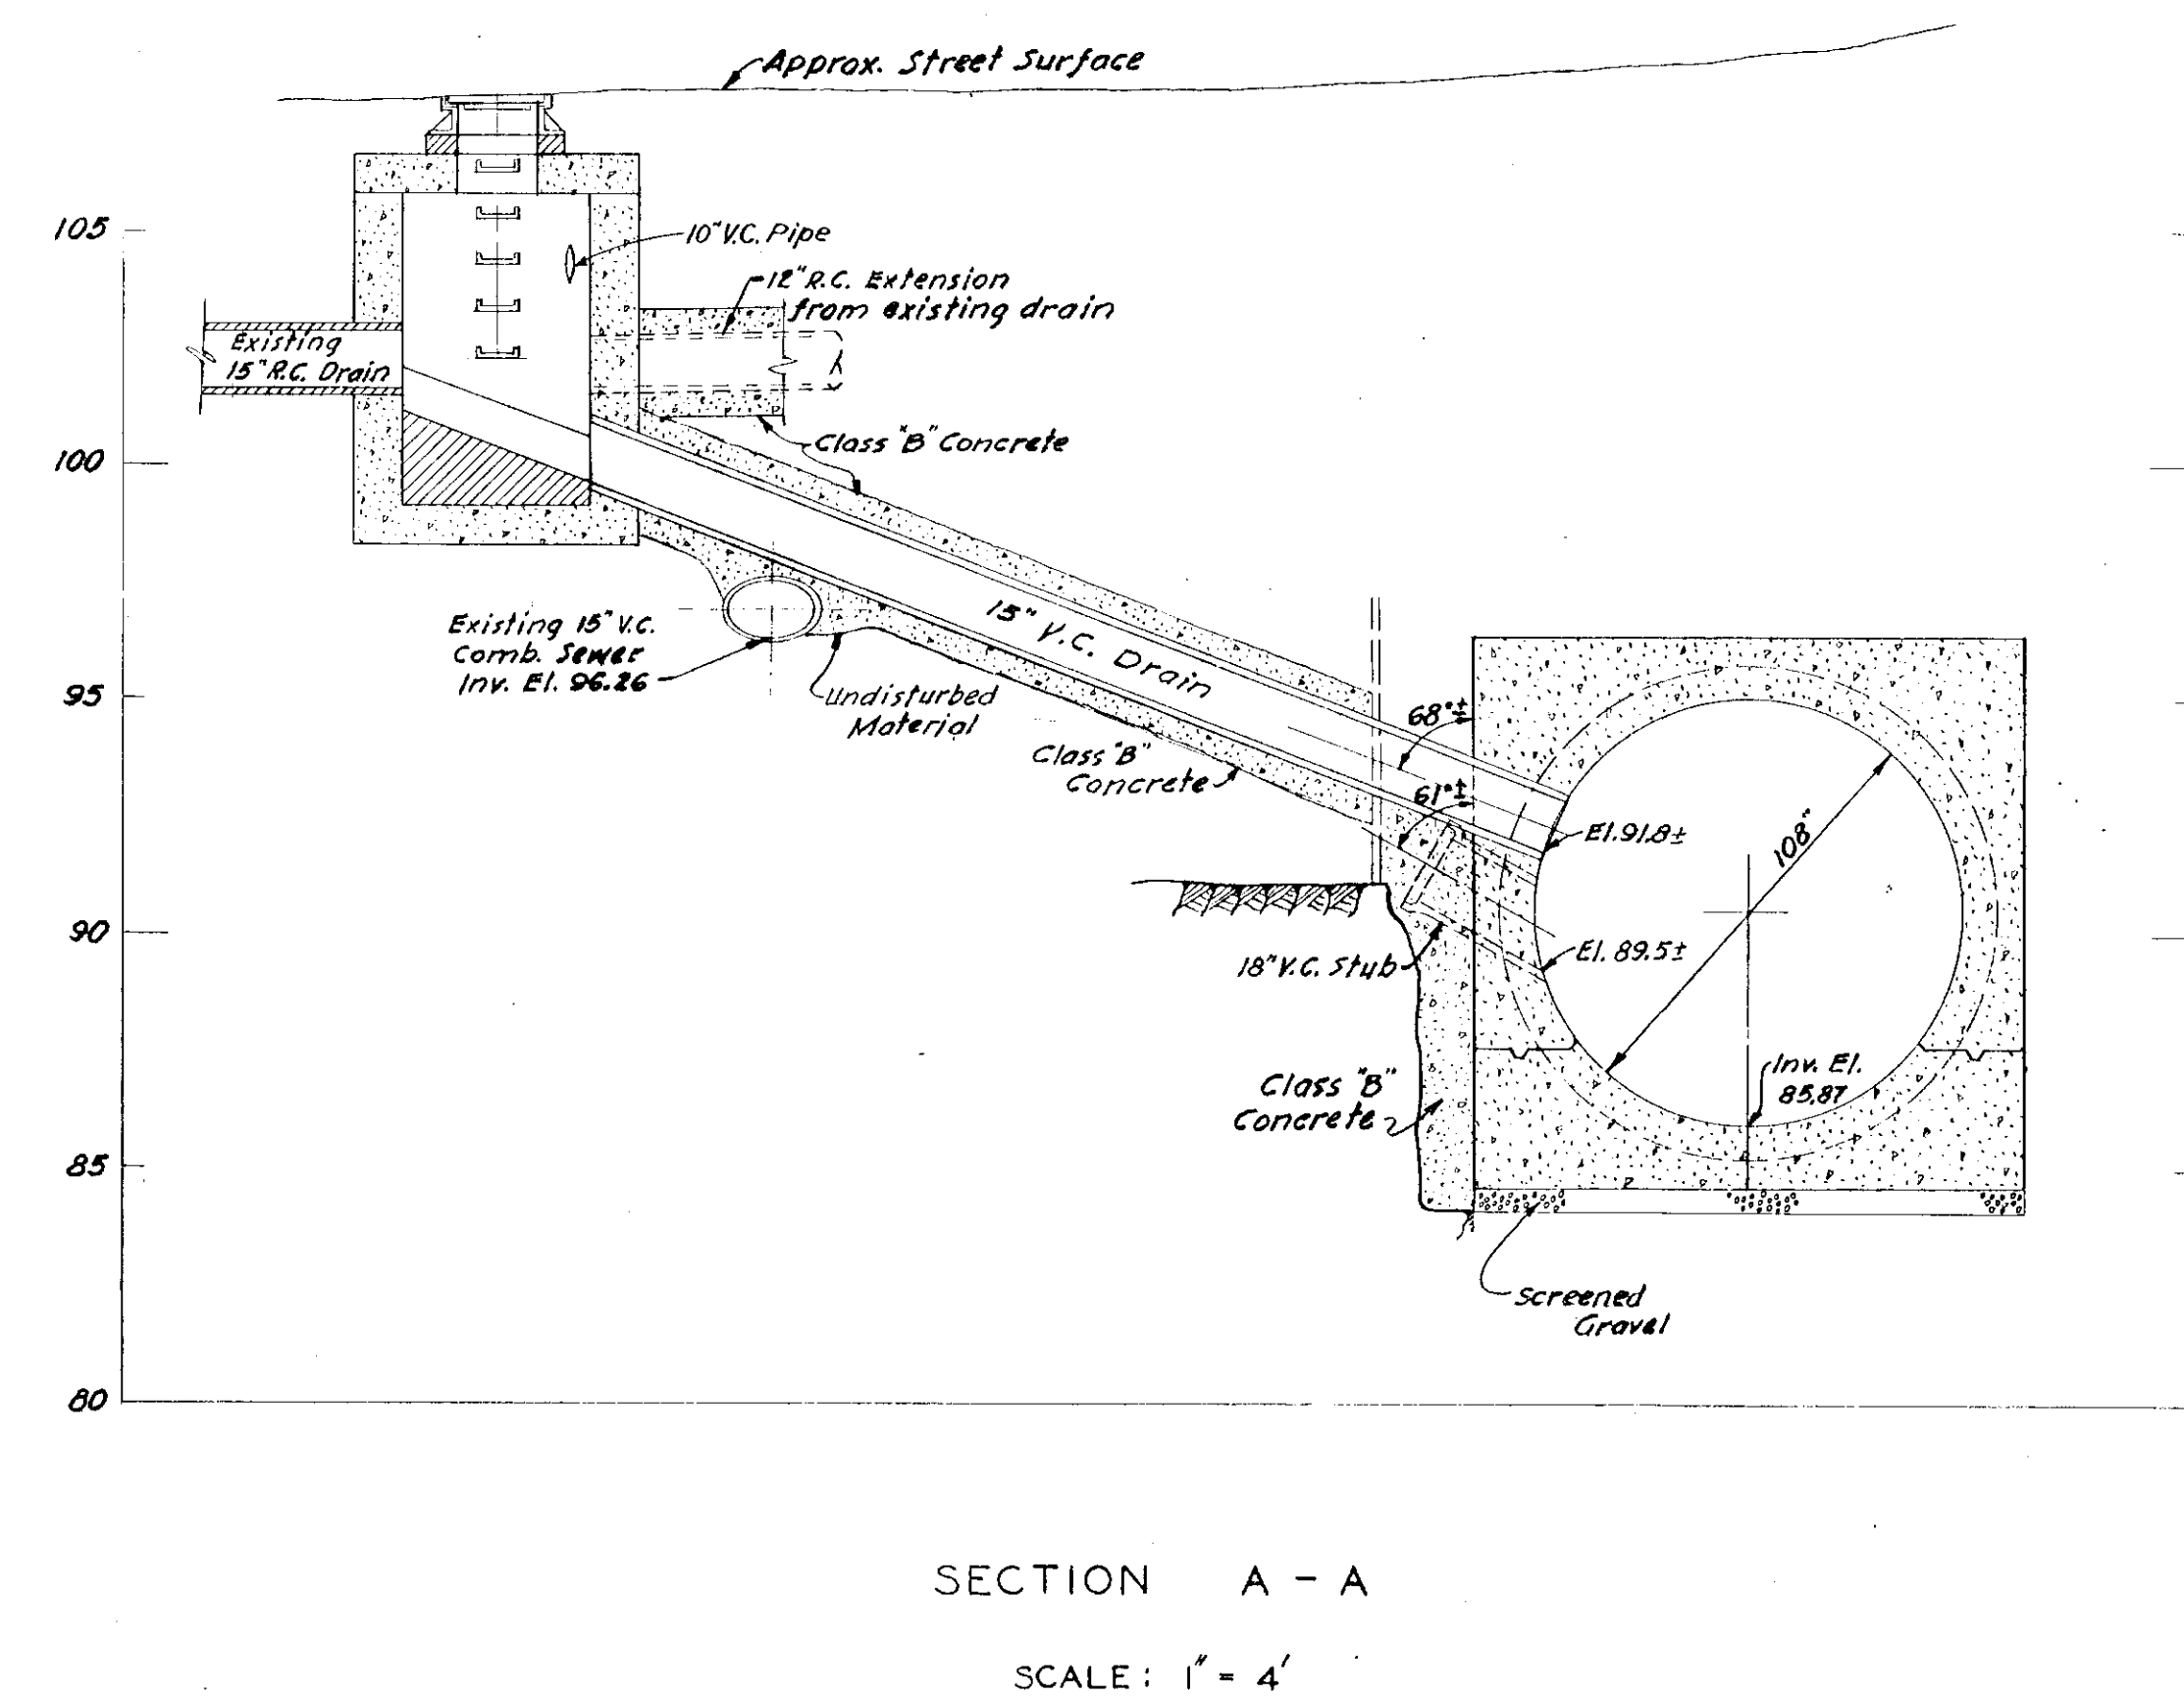

NOTE:
Payment lines refer to Items 23 and 24,
see specifications.

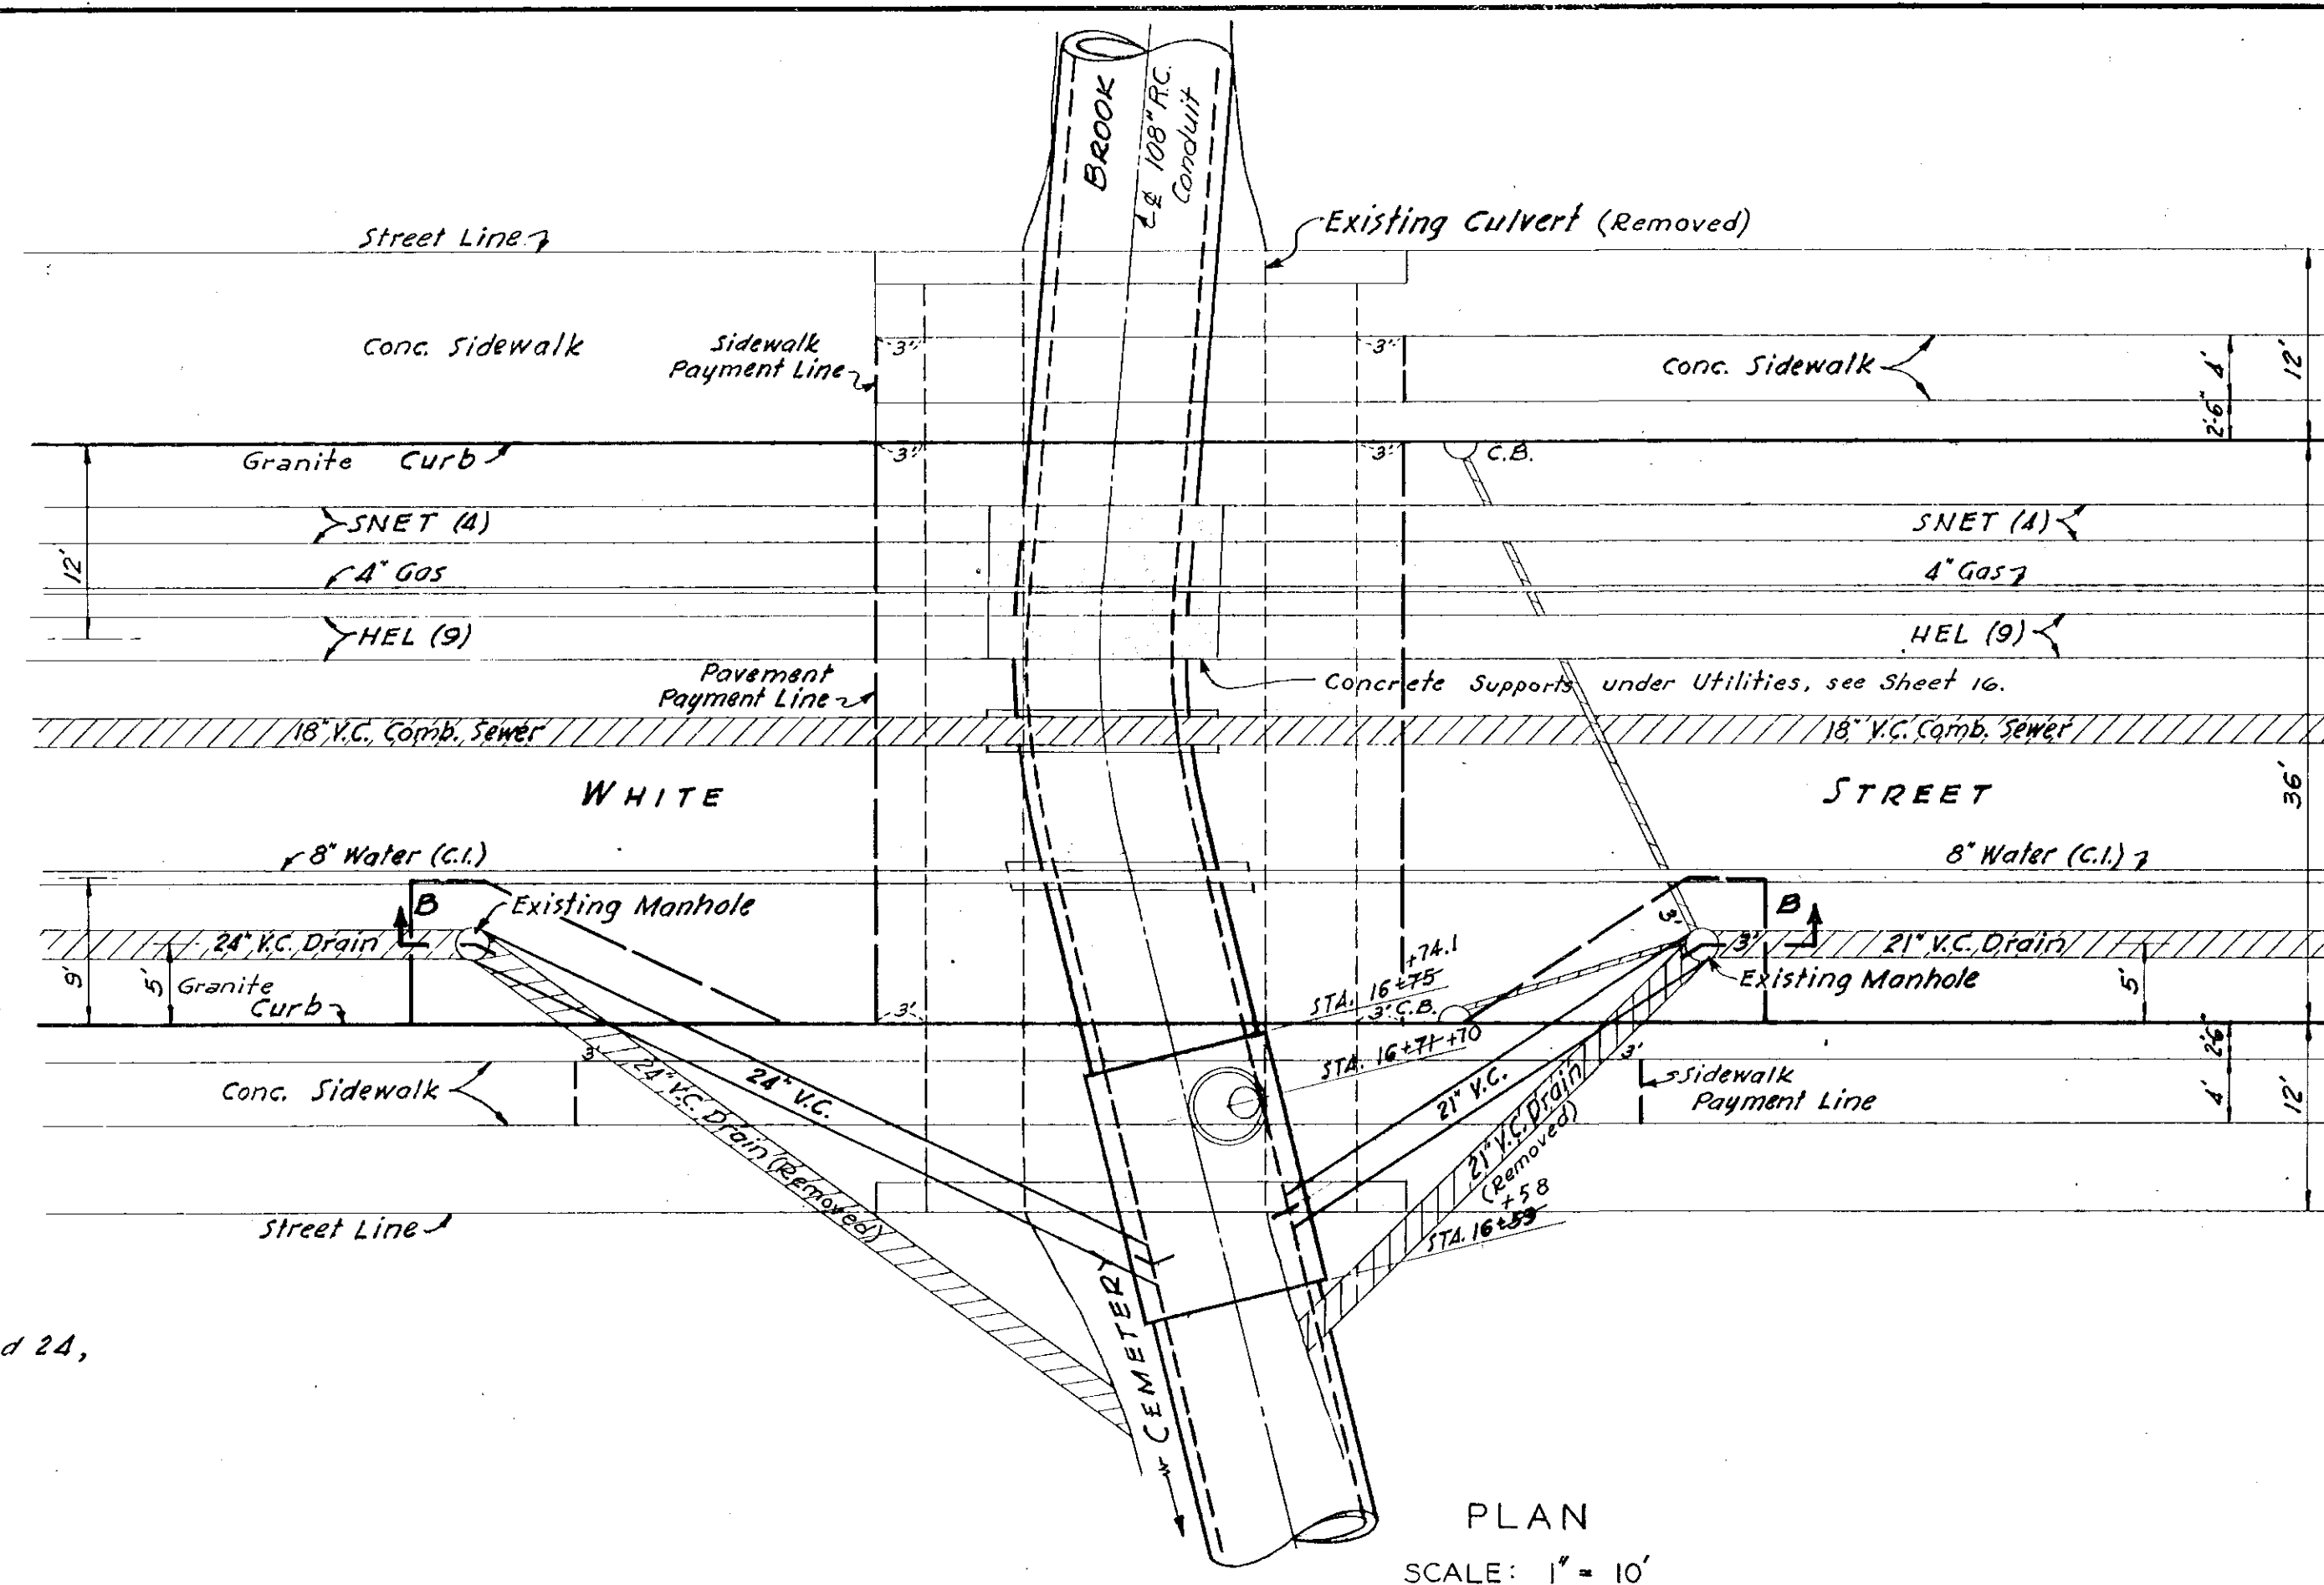

DRAWN BY S.A.H.
TRACED BY R.J.P.
CHECKED BY R.H.L.

REVISION	DATE	BY	CHECKED BY	DESCRIPTION
2.	Jan. 1960	J.F.G.	S.A.H.	Record Revisions.
1.	MAY 11 1957	L.S.B.	S.A.H.	STATION CHANGED AT OLIVER ST.

APPROVED	
<i>Chas. W. Eddy</i>	Director
REG. PROF. ENGR. CT. NO. 290	DATE 5/7/57
FOR METCALF & EDDY, ENGINEERS	
<i>John W. Raymond</i>	5/10/57
REG. PROF. ENGR. CT. NO. 3422	DATE

RECORD DRAWING

PARK RIVER FLOOD CONTROL COMMISSION
HARTFORD, CONNECTICUT

CEMETERY BROOK CONDUIT

CONNECTIONS AT OLIVER ST.
AND WHITE ST.

SCALE, AS SHOWN

MAY, 1957

METCALF & EDDY
ENGINEERS
BOSTON, MASS.

34284
H
18462

Sheet No. 000885

CONTRACT 1957-3

SHEET 20 OF 31