
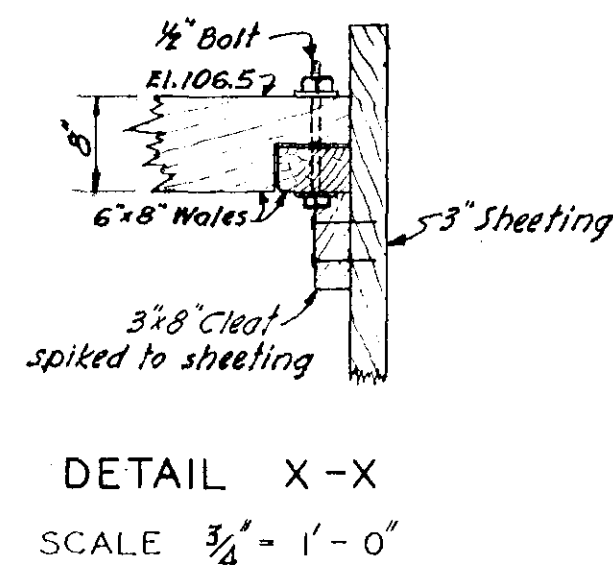
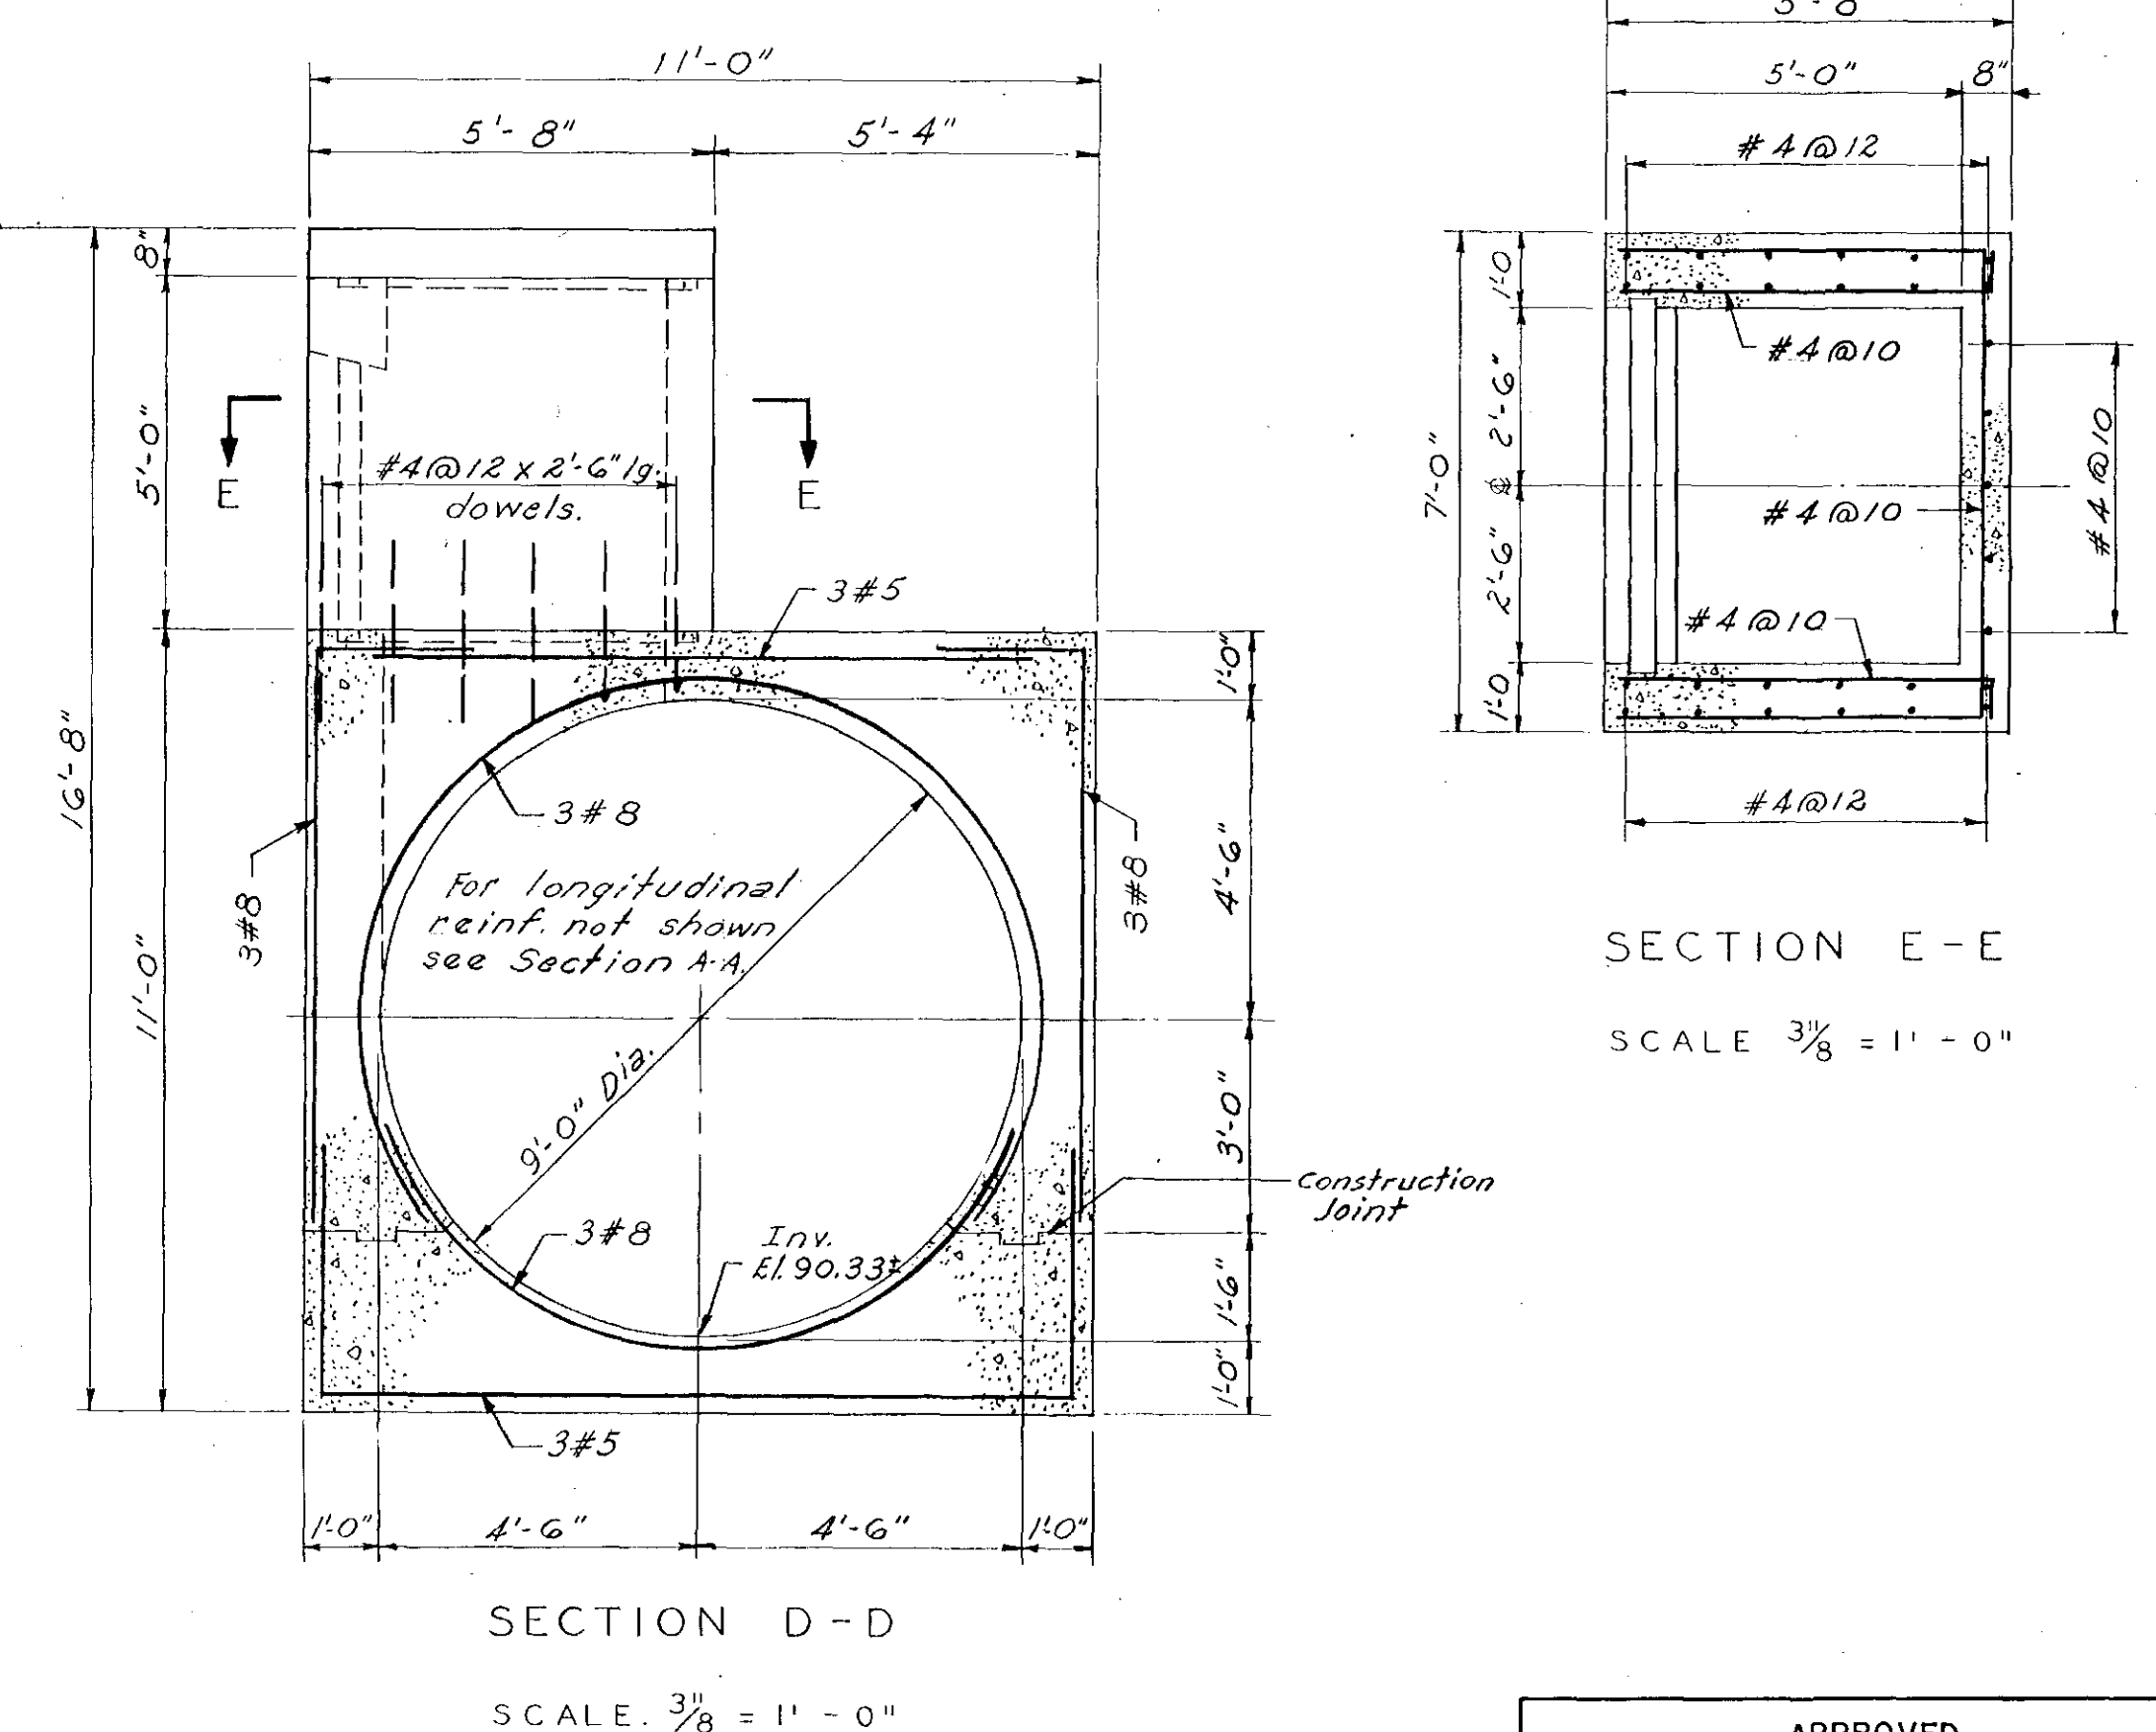
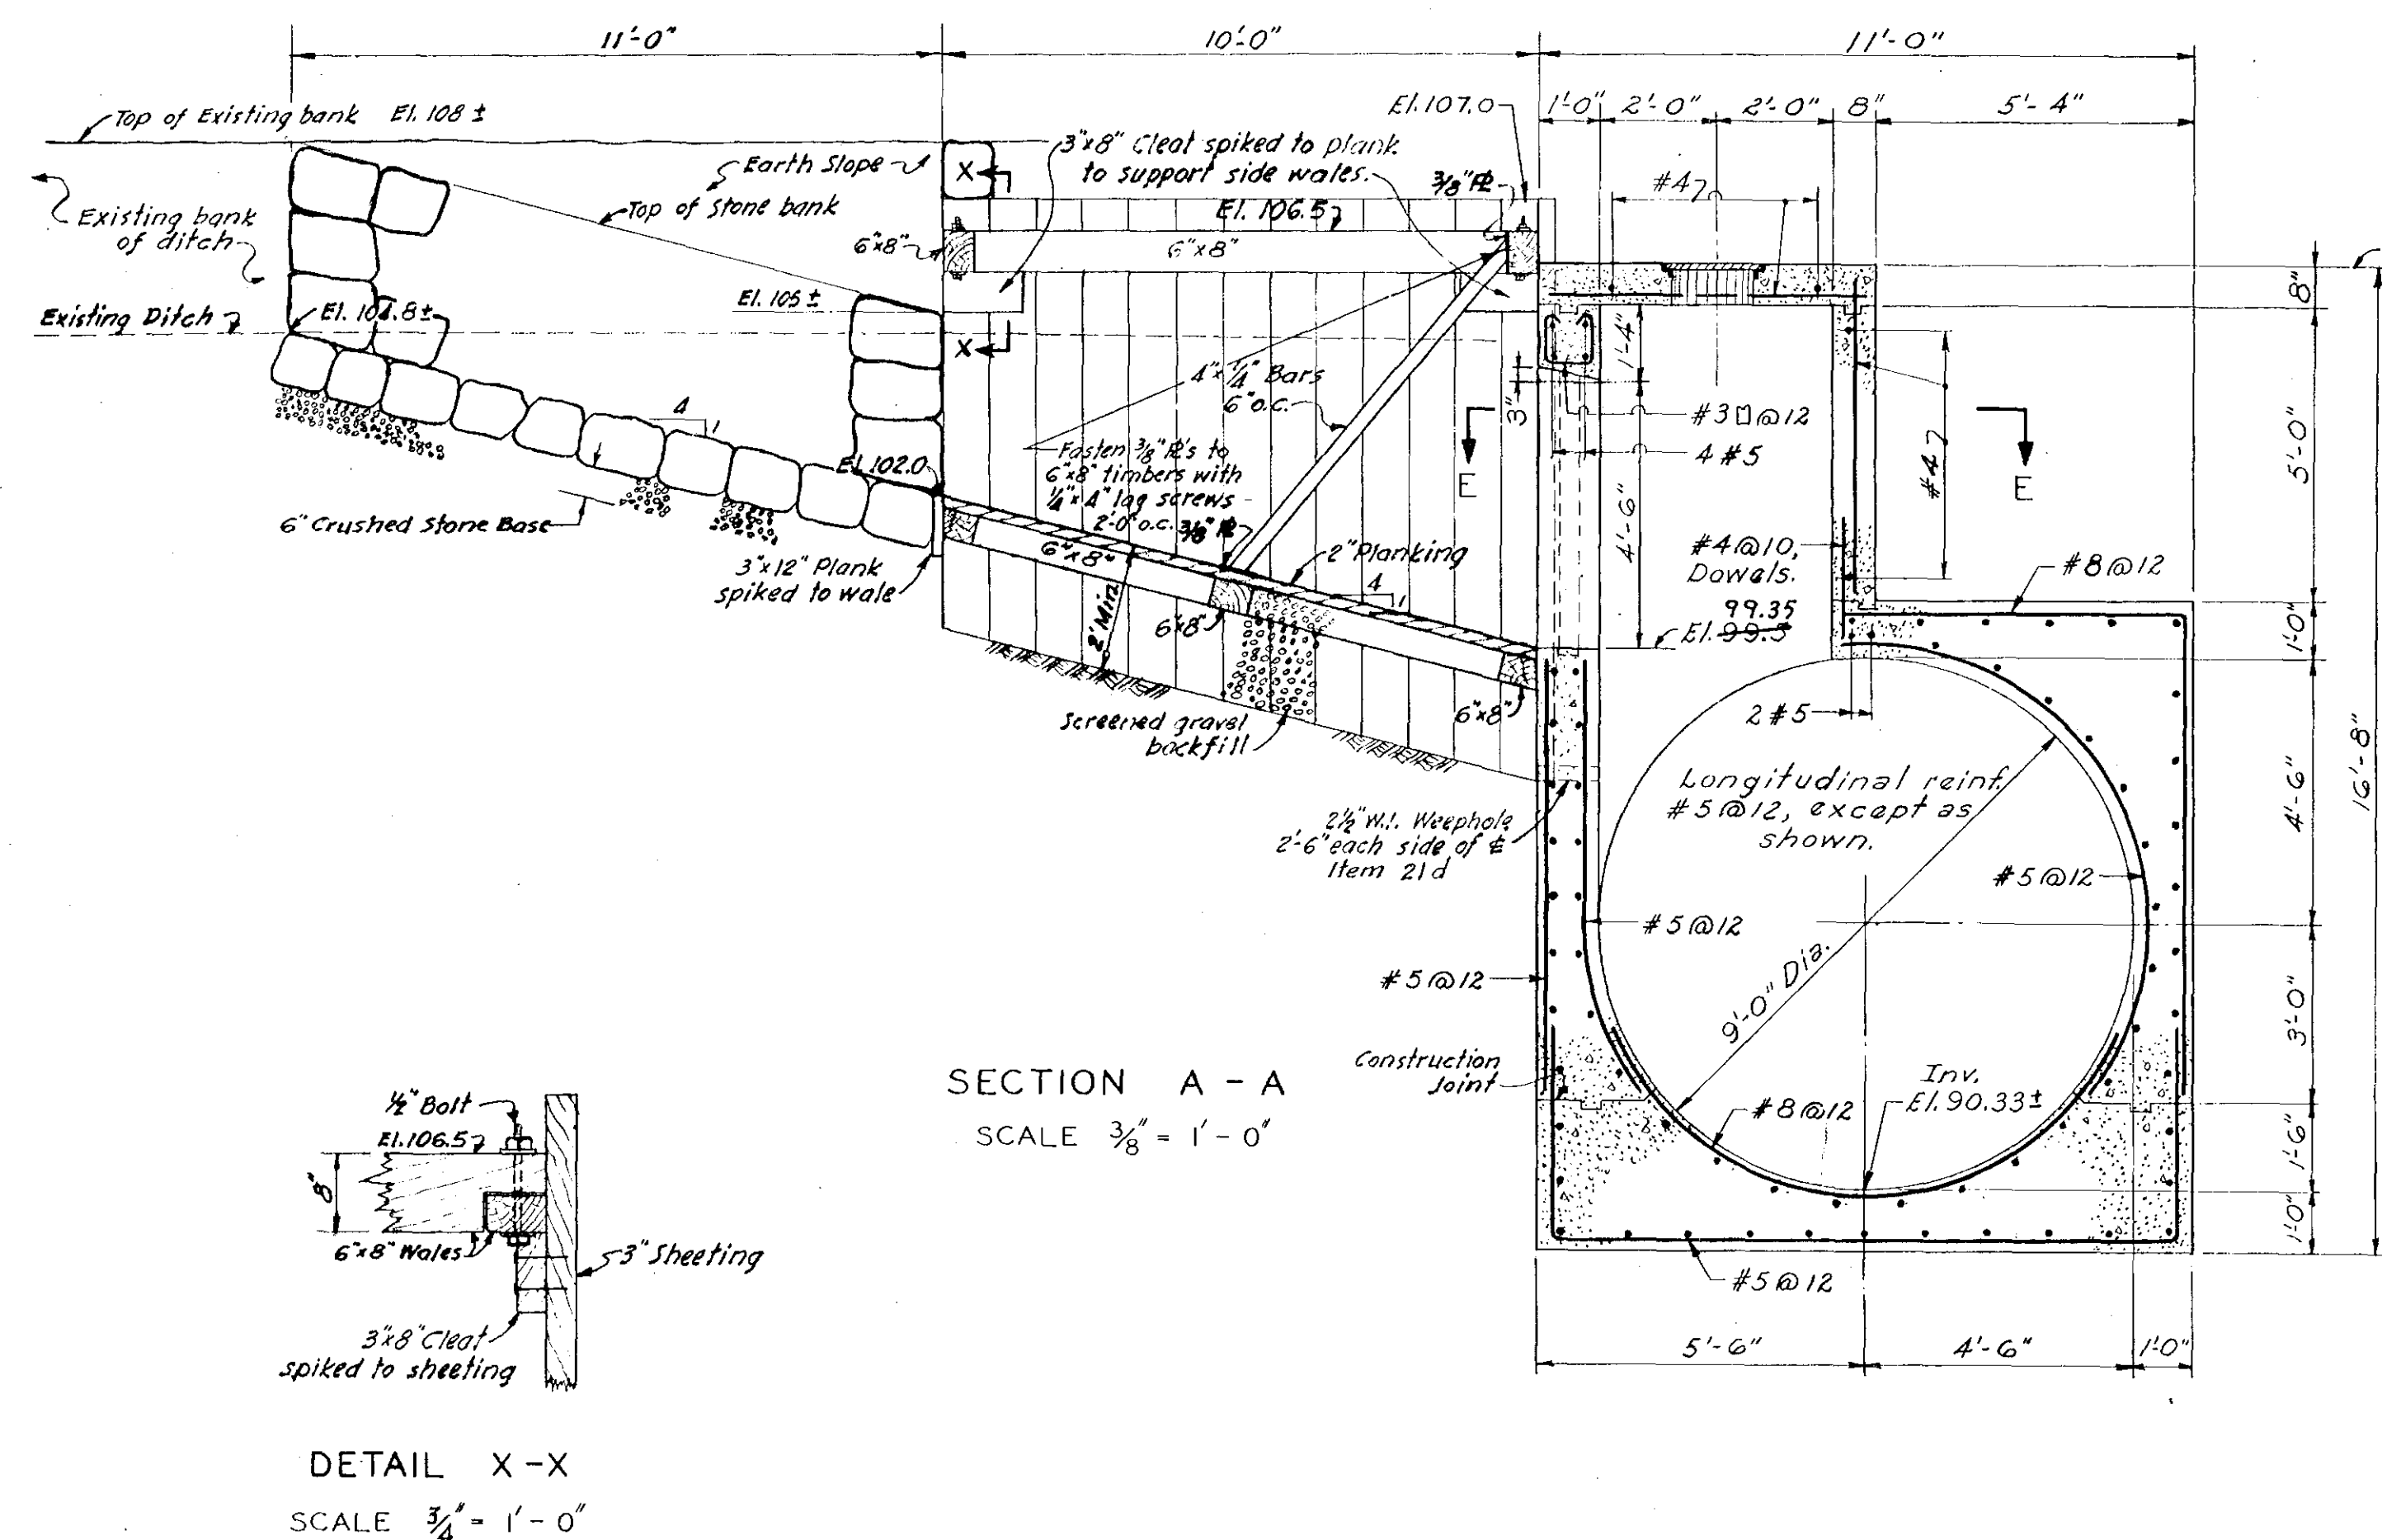
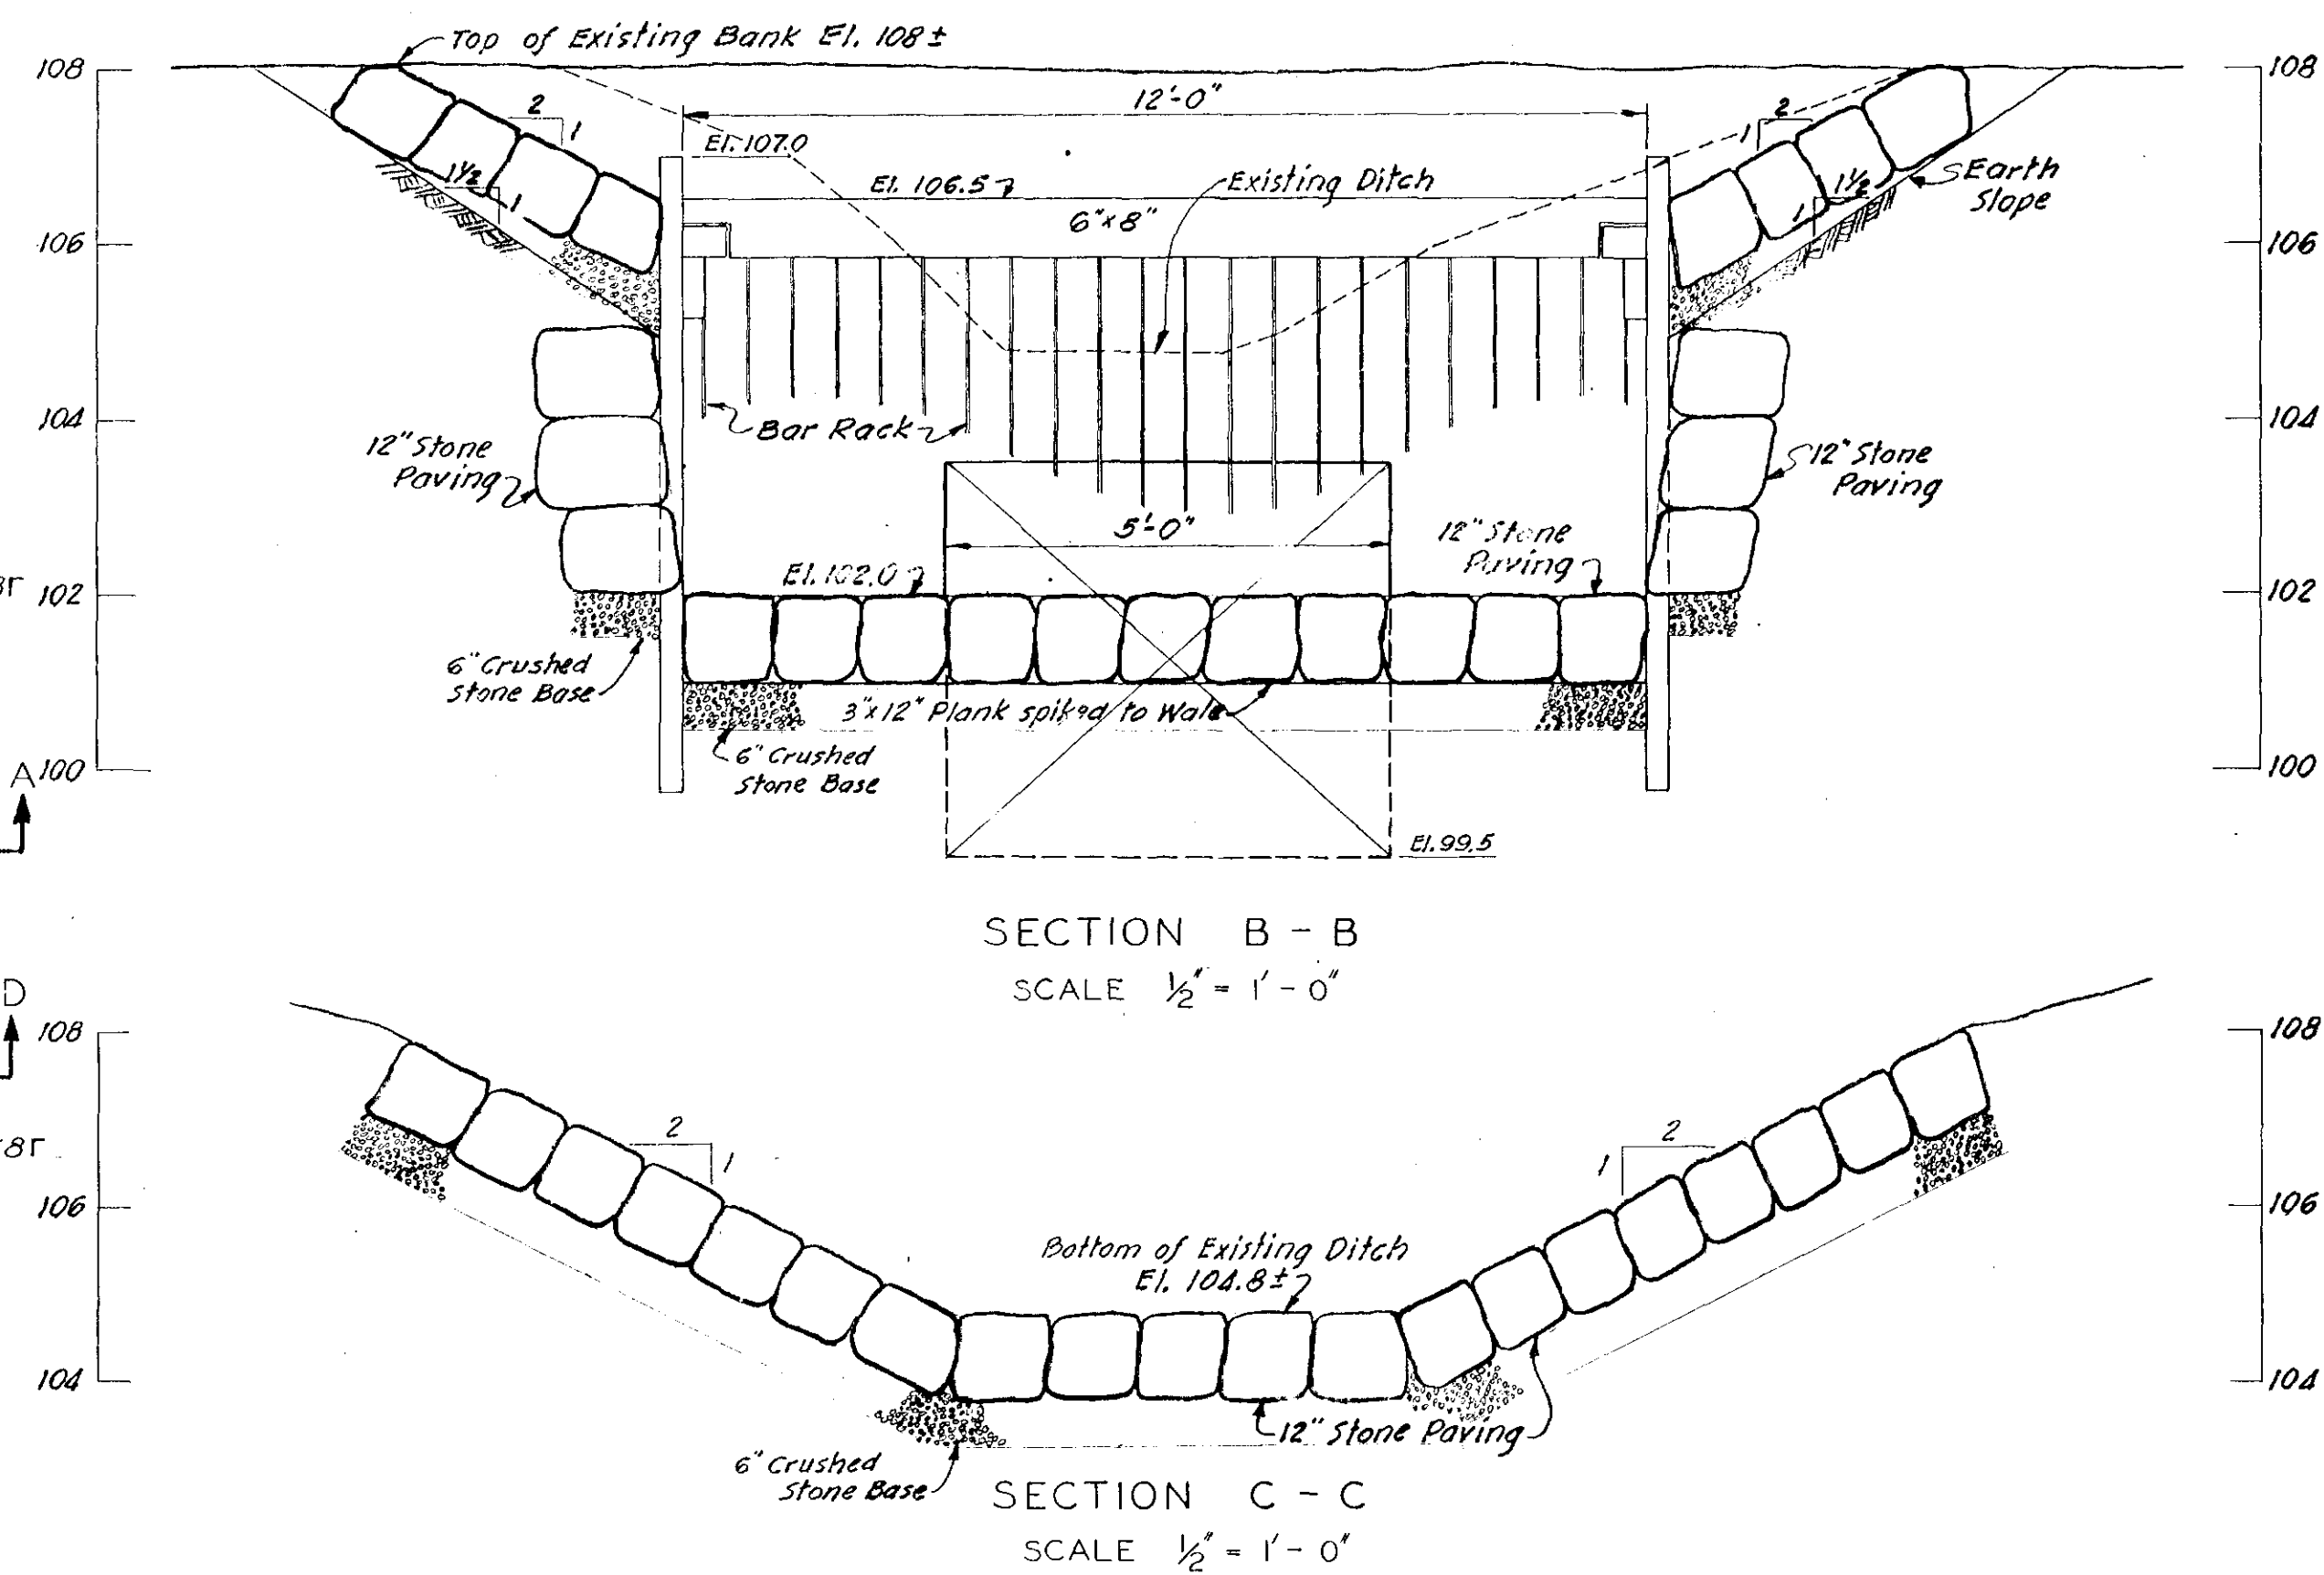


99481
H
882PE

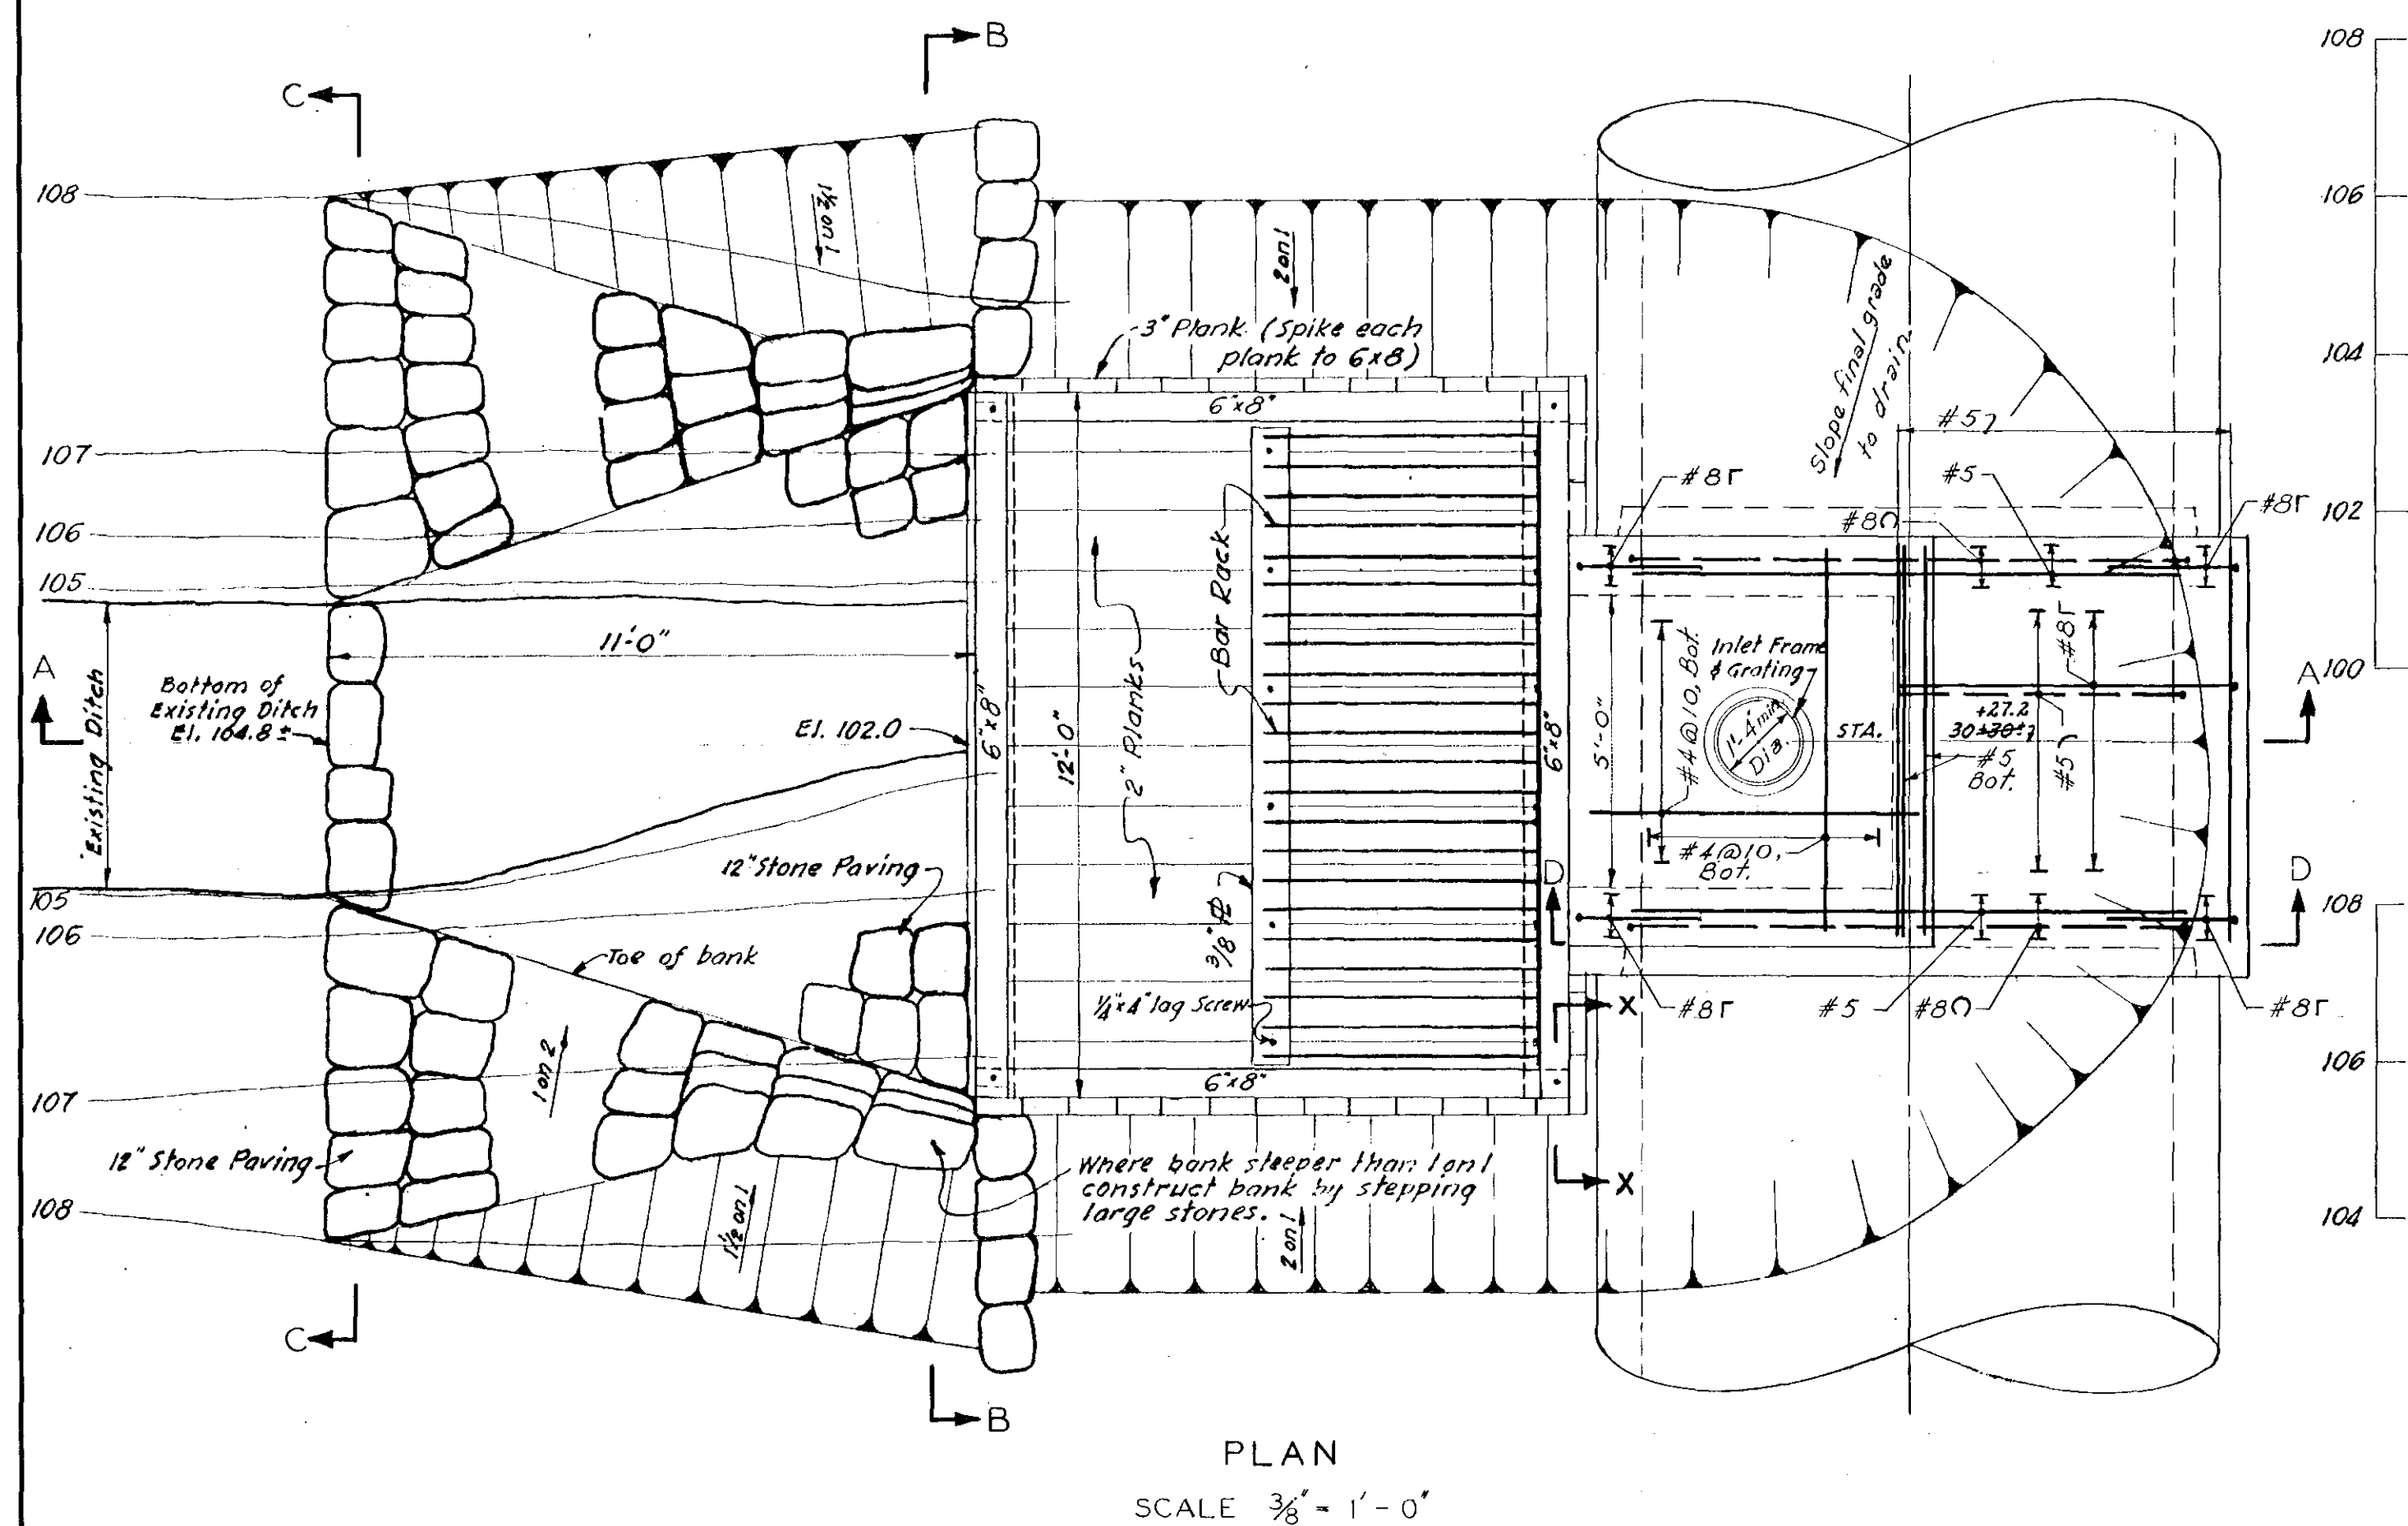

NOTE:
Metropolitan District has replaced temporary connection with pipe.

DRAWN BY J.F.G.-GBH
TRACED BY J.F.G.-AIP
CHECKED BY J.N.O. RHL

REVISION	MADE BY	CHECKED BY	DESCRIPTION
1	Wm. 1960 J.F.G.	S.A.H.	Record Revisions.

APPROVED	
FOR PARK RIVER FLOOD CONTROL COMMISSION	
Chas. W. Eddy, Director	5/1/57
REG. PROF. ENGR. CT. NO. 290	DATE
FOR METCALF & EDDY, ENGINEERS	
John W. Raymond, Jr.	5/10/57
REG. PROF. ENGR. CT. NO. 3422	DATE

RECORD DRAWING

PARK RIVER FLOOD CONTROL COMMISSION
HARTFORD, CONNECTICUT

CEMETERY BROOK CONDUIT

TEMPORARY CONNECTION
FOR DITCH AT STA. 30+27.2

SCALE, AS SHOWN MAY, 1957

METCALF & EDDY
ENGINEERS
BOSTON, MASS.

34288
H
18466

FILED 5/10/57

CONTRACT 1957-3

SHEET 24 OF 31