

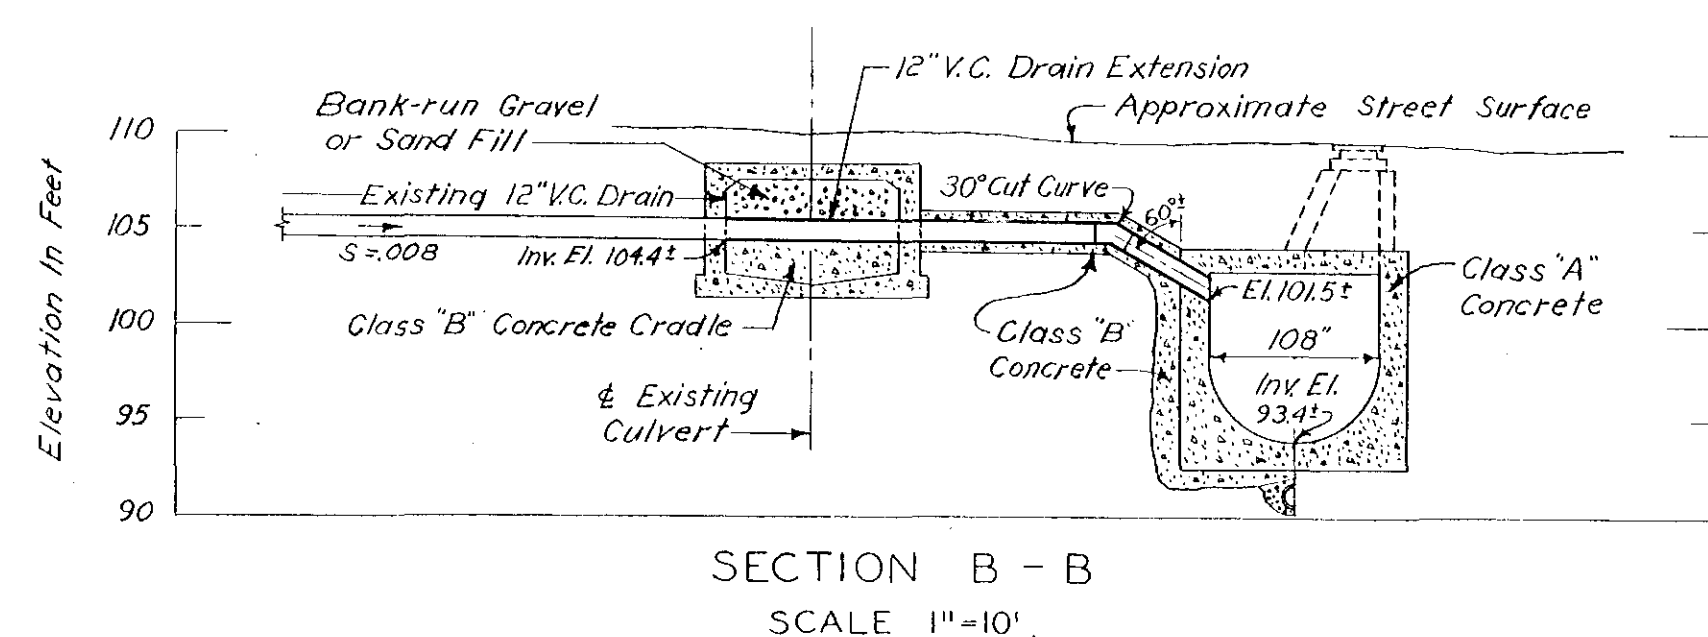
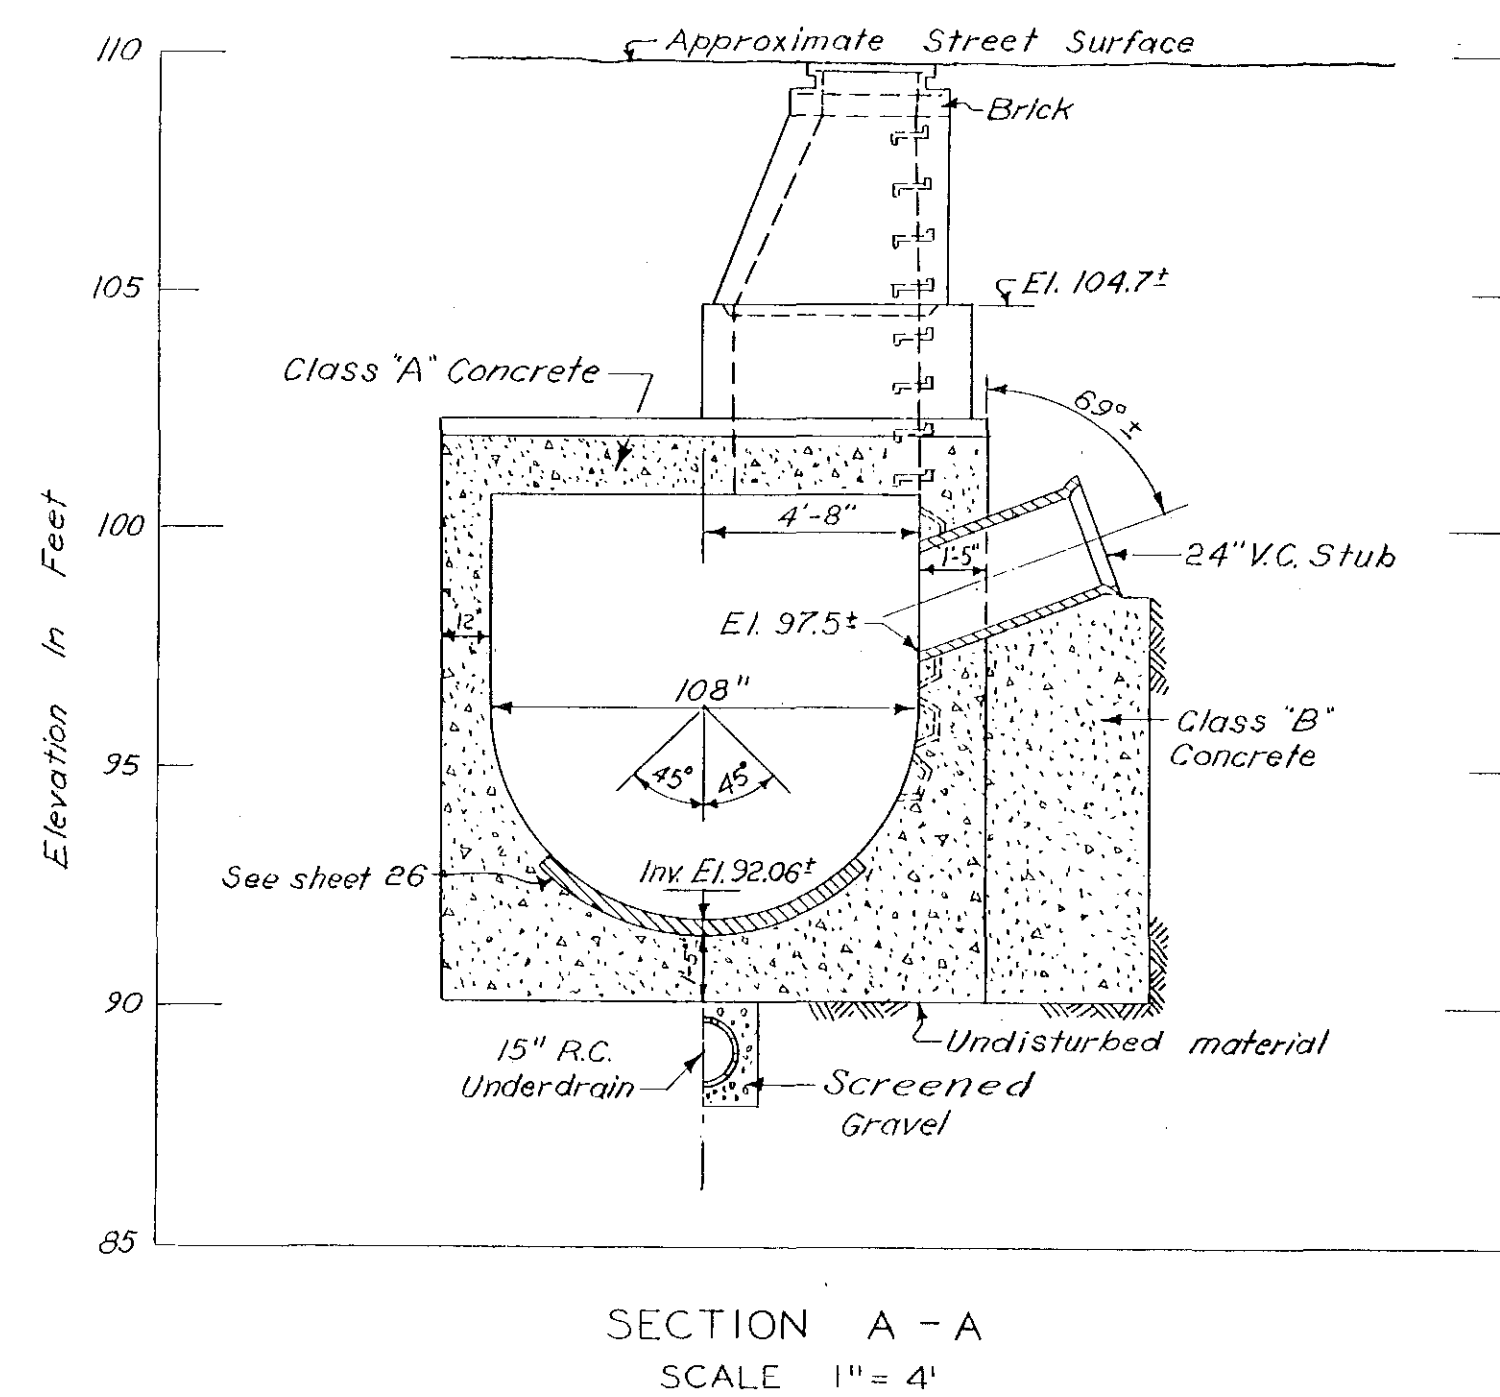
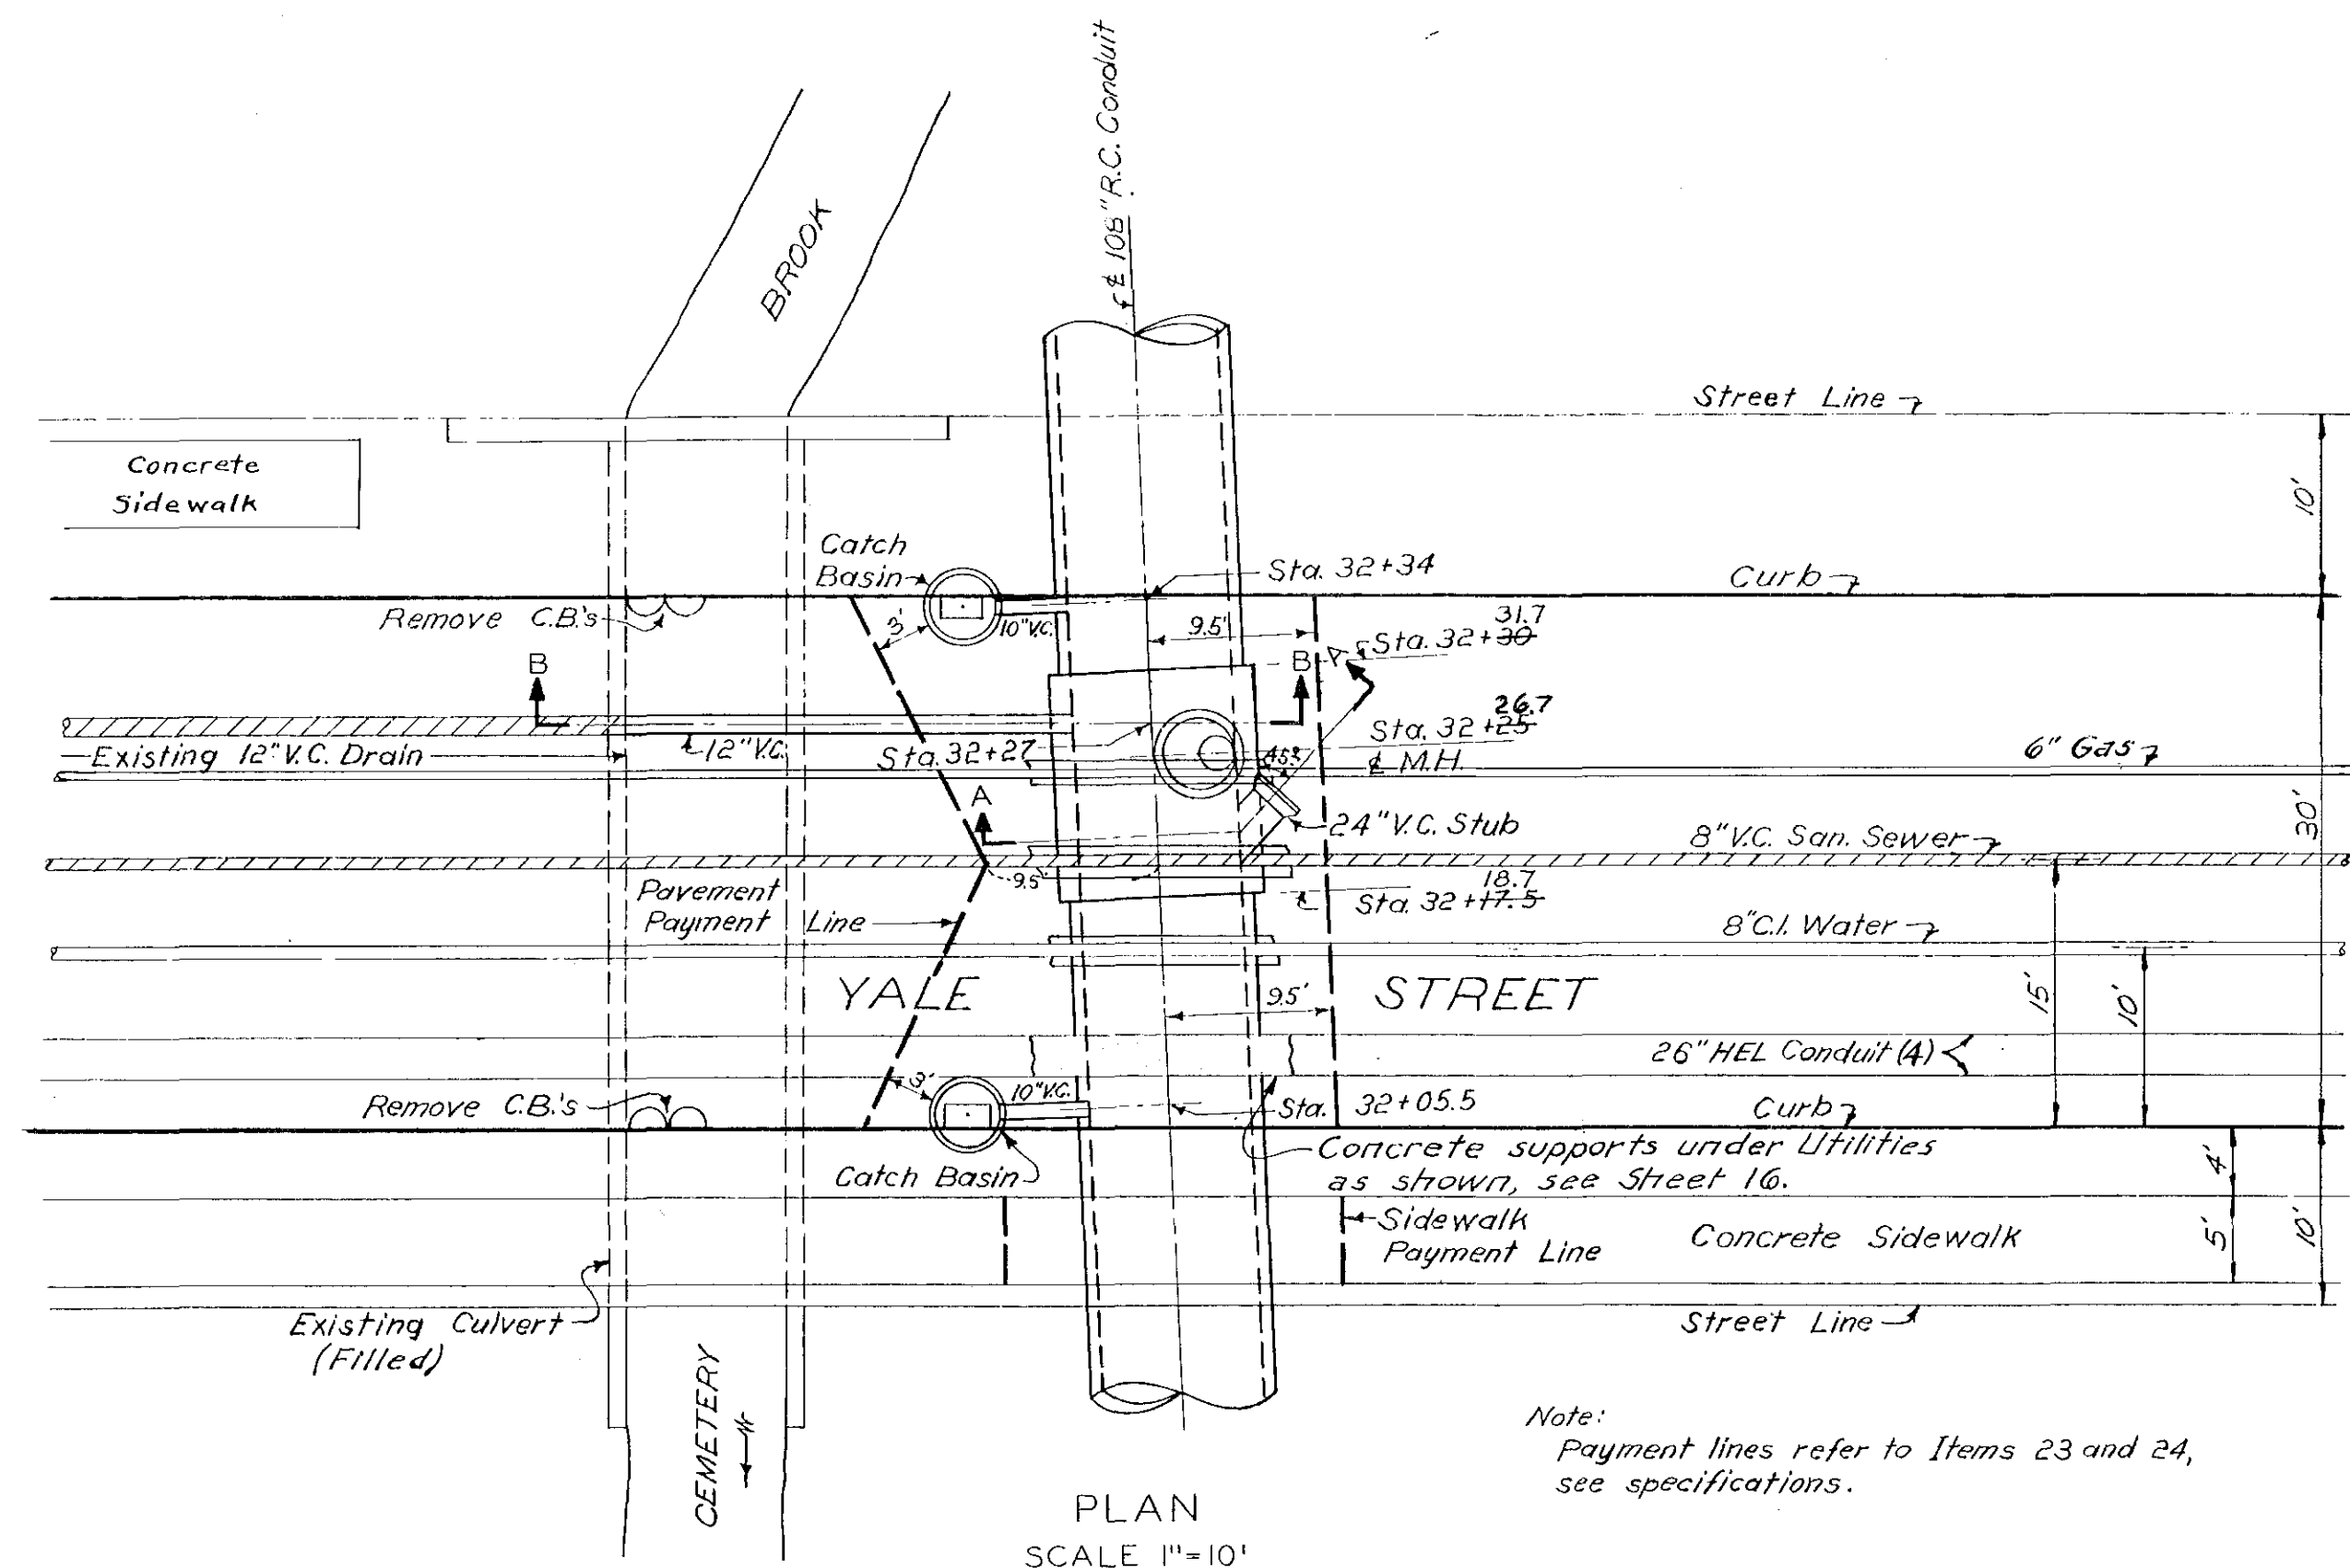
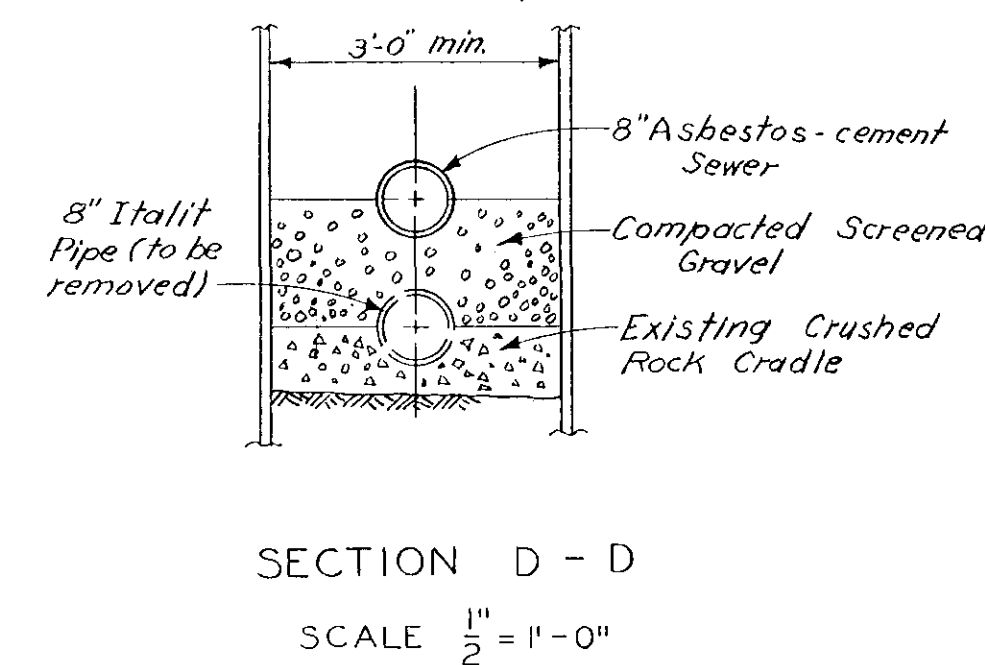


27481
H
68265

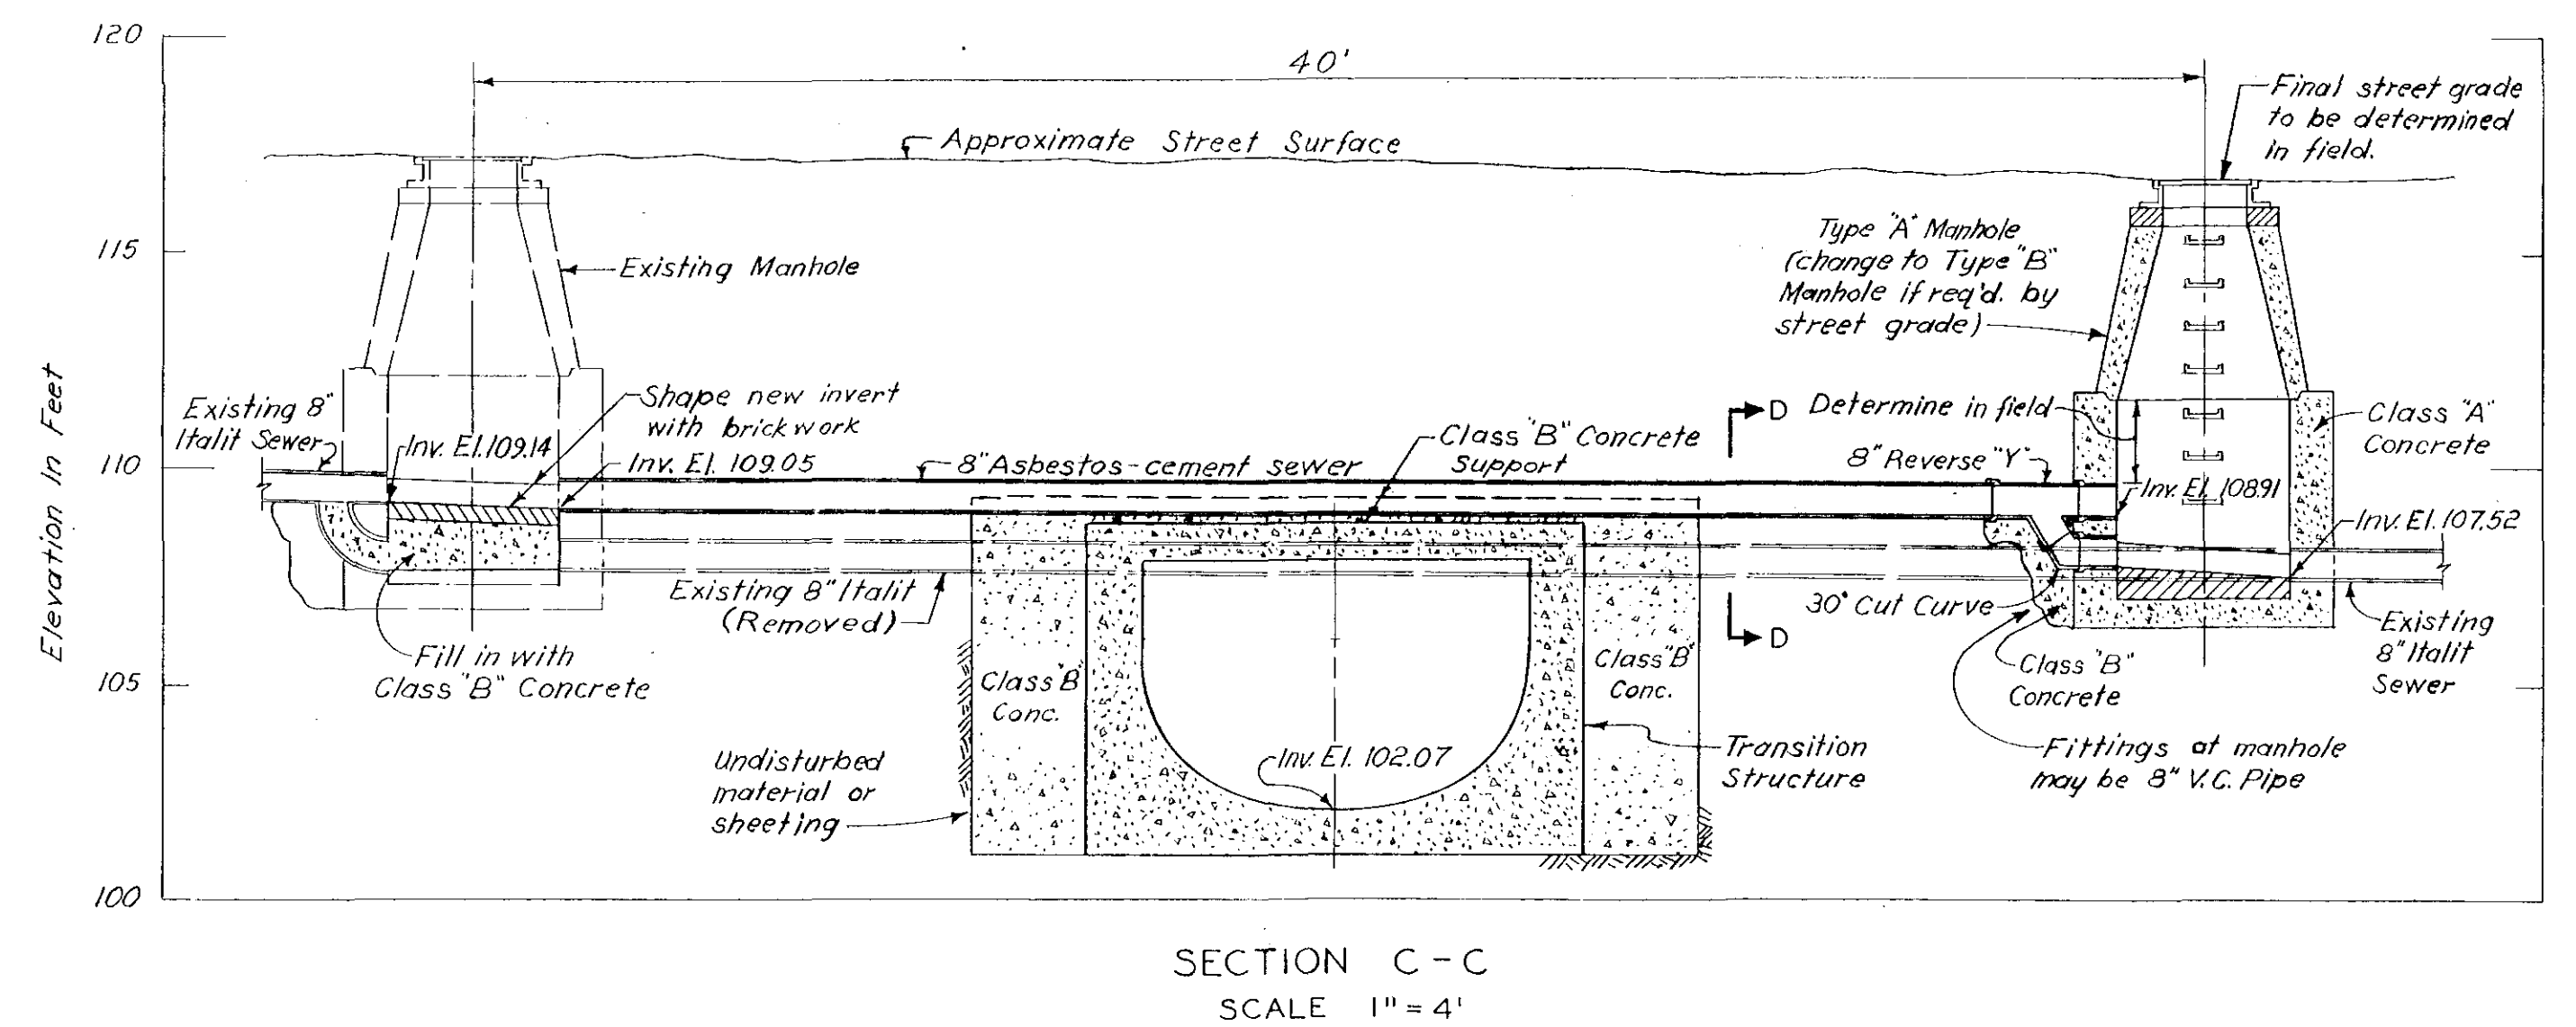

DRAWN BY: S.A.H.
TRACED BY: J.A.L.
CHECKED BY: R.H.L.

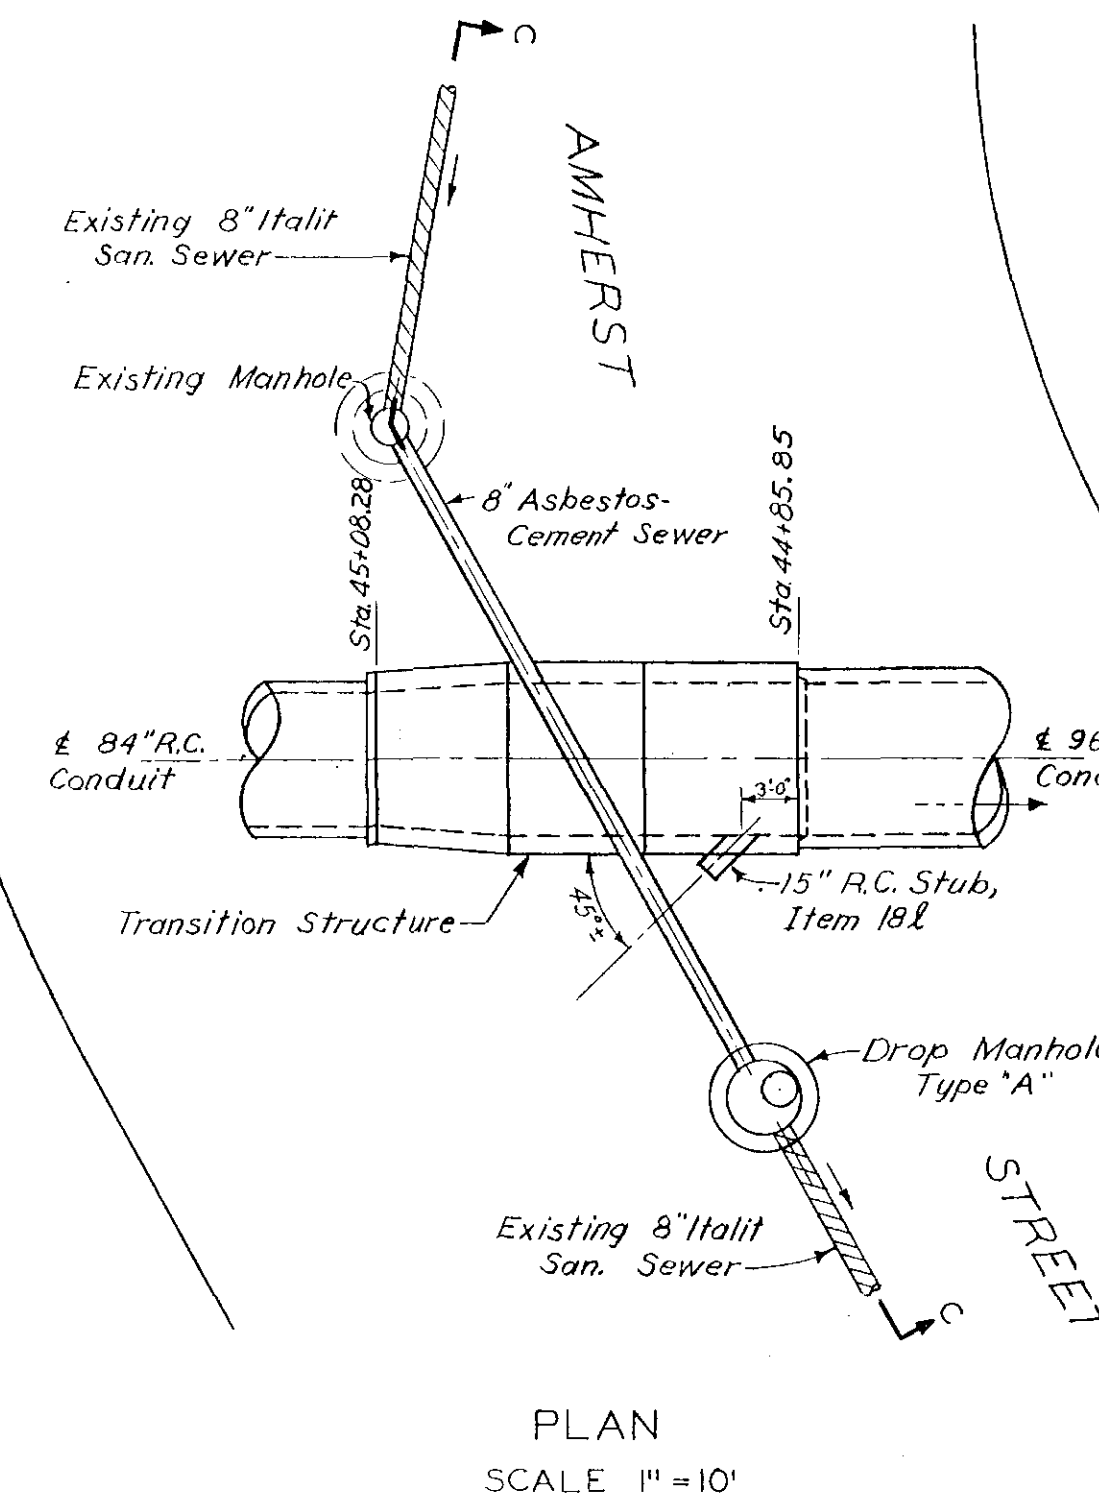

Notes:
1. For details of transition structure
in Amherst St., see sheet 27.
2. For details of Yale St drop structure,
see sheet 26.

RECORD DRAWING

PARK RIVER FLOOD CONTROL COMMISSION
HARTFORD, CONNECTICUT

CEMETERY BROOK CONDUIT
CONNECTIONS AT YALE STREET
8" SANITARY SEWER AT AMHERST STREET

SCALE, AS SHOWN MAY, 1957

METCALF & EDDY
ENGINEERS
BOSTON, MASS.

34289
H
18467

REVISION	MADE BY	CHECKED BY	DESCRIPTION
2	Jan 1961	J.L.K.	S.A.H. Record Revisions
1	JULY 1, 1957	L.S.B.	S.A.H. STATION CHANGED AT YALE ST

APPROVED	
FOR PARK RIVER FLOOD CONTROL COMMISSION	
REG. PROF. ENGR. CT. NO. 290	DATE 5/7/57
FOR METCALF & EDDY, ENGINEERS	
REG. PROF. ENGR. CT. NO. 3422	DATE 5/10/57

G.H.C. Serial No. 000890

CONTRACT 1957-3

SHEET 25 OF 31