
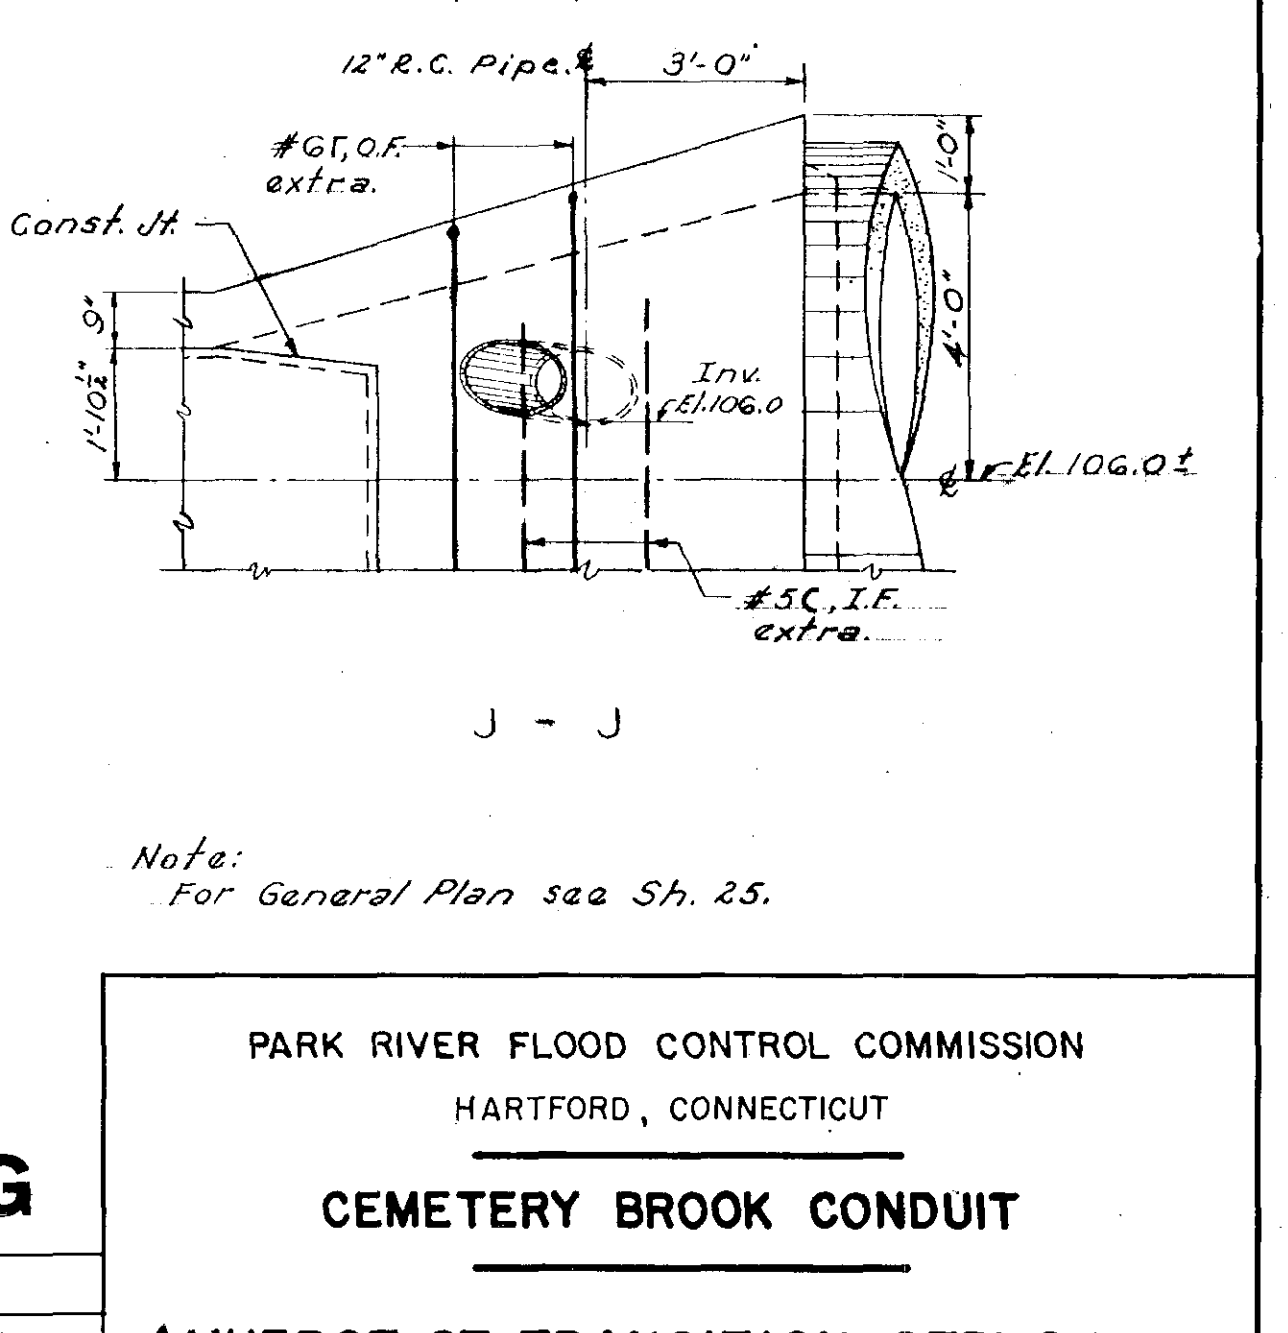
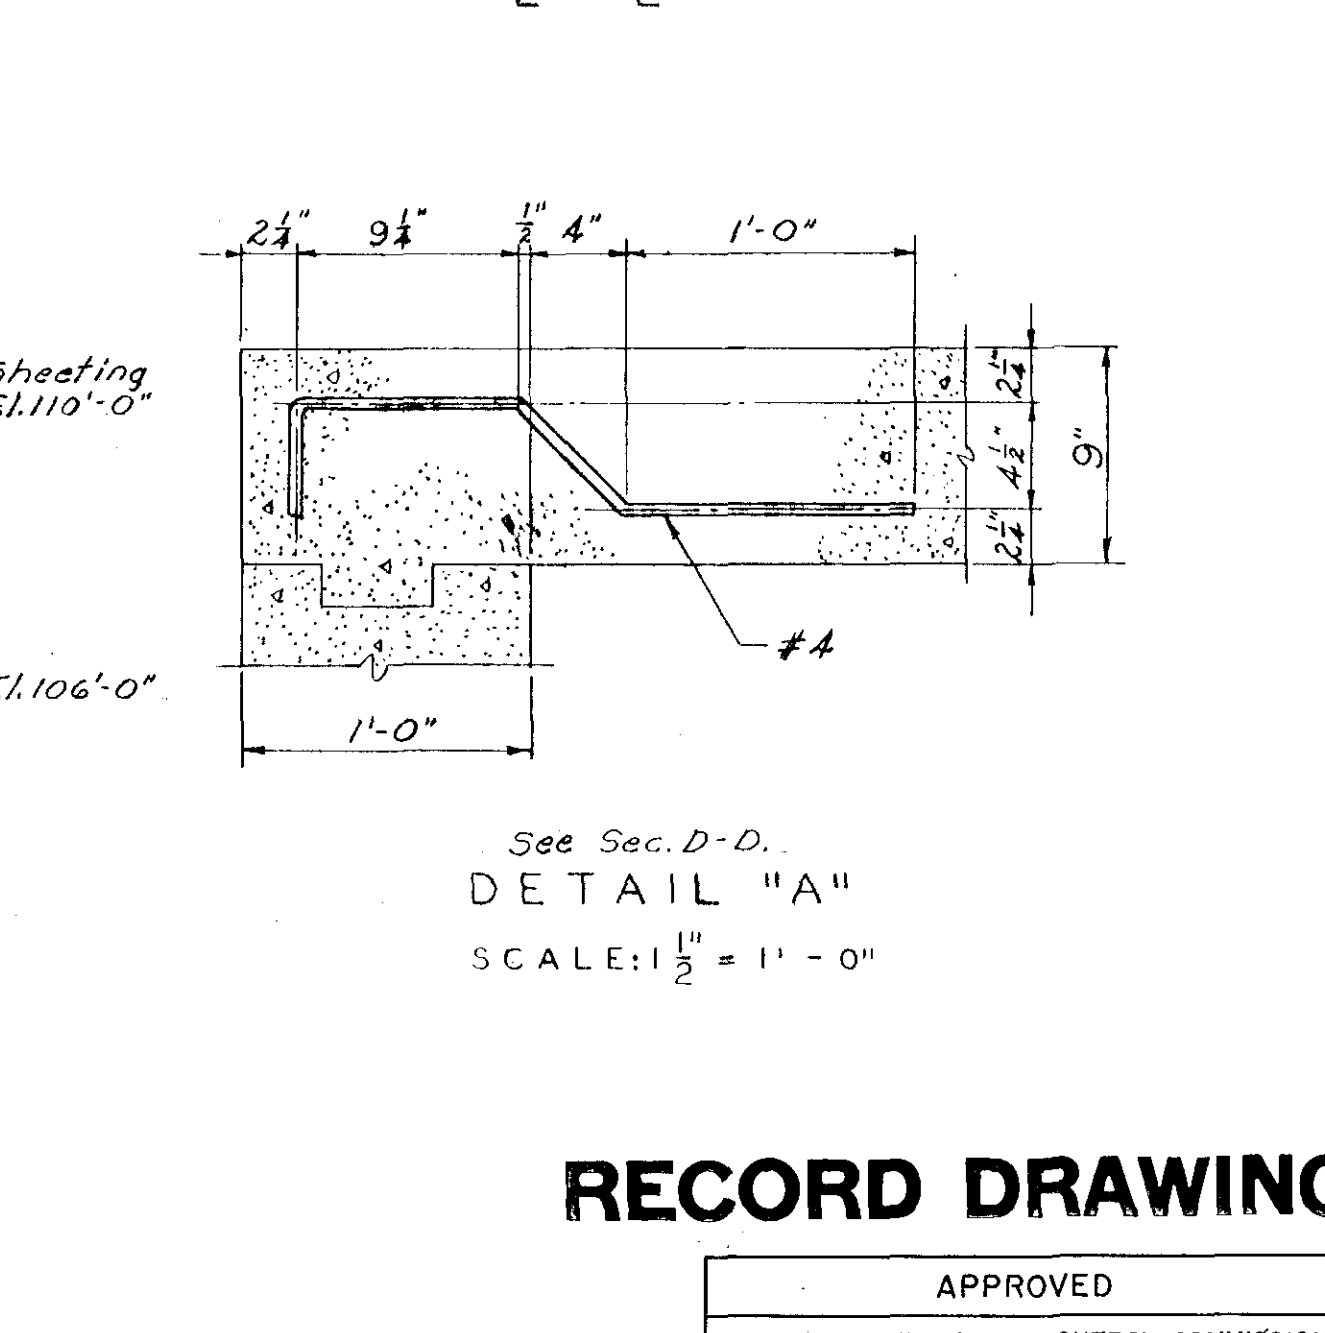
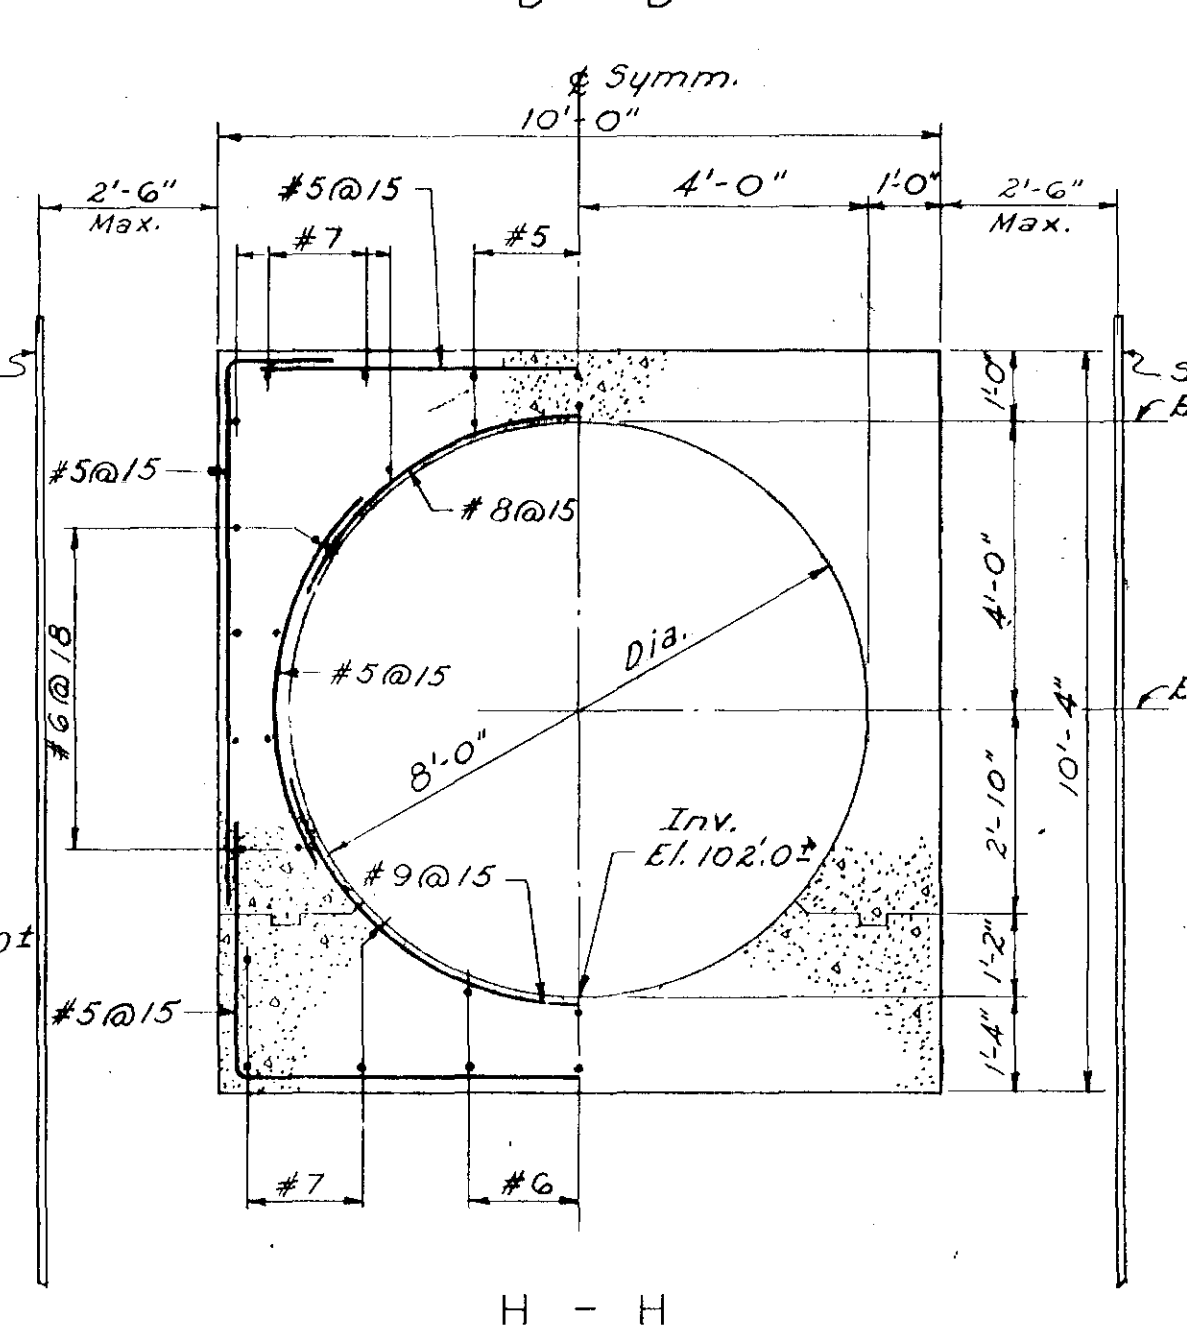
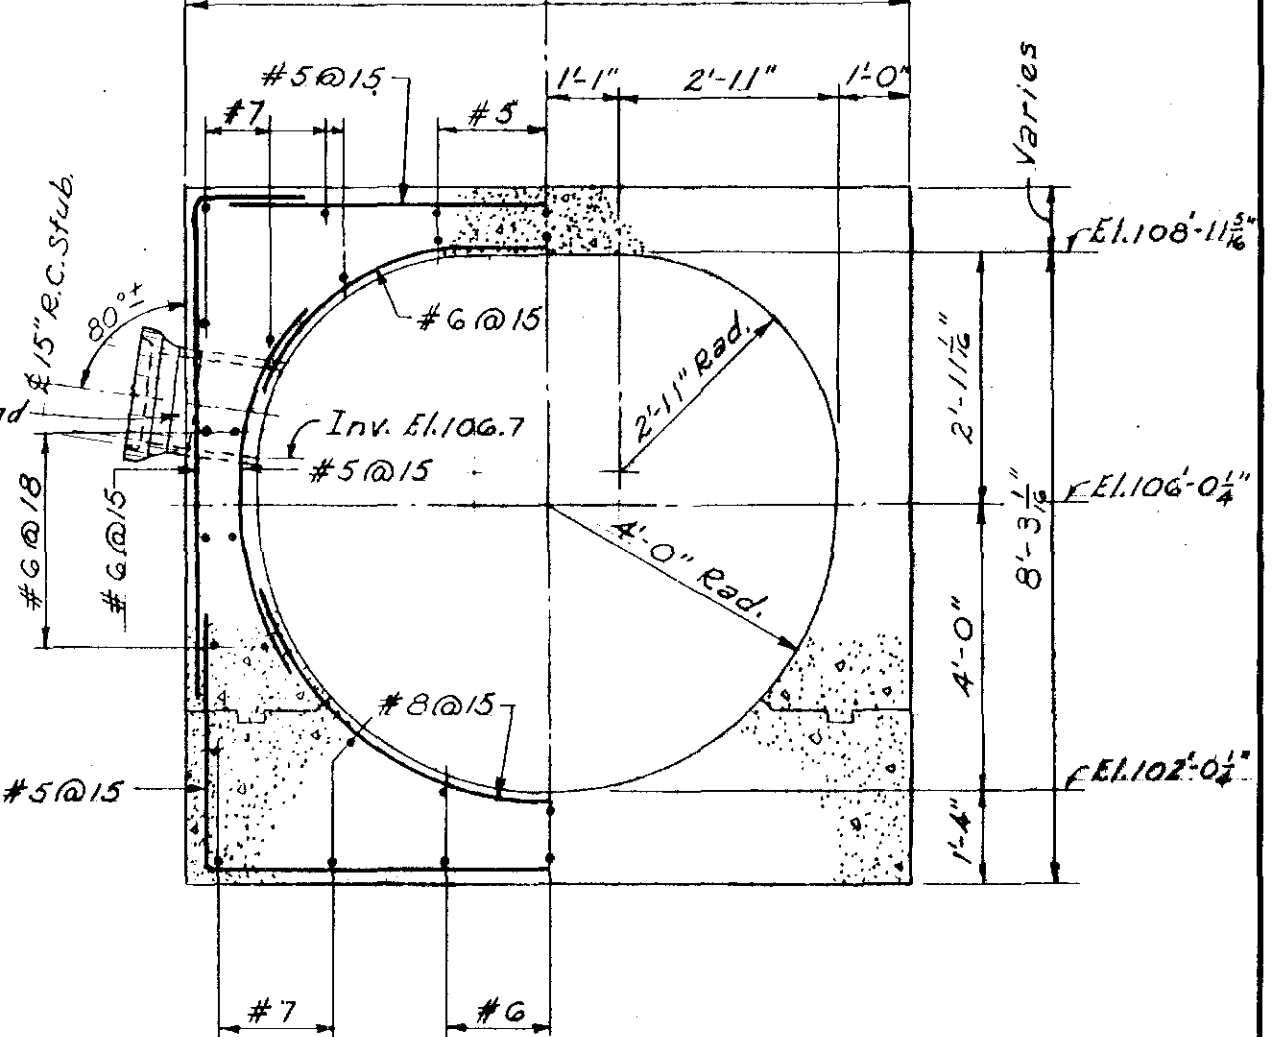
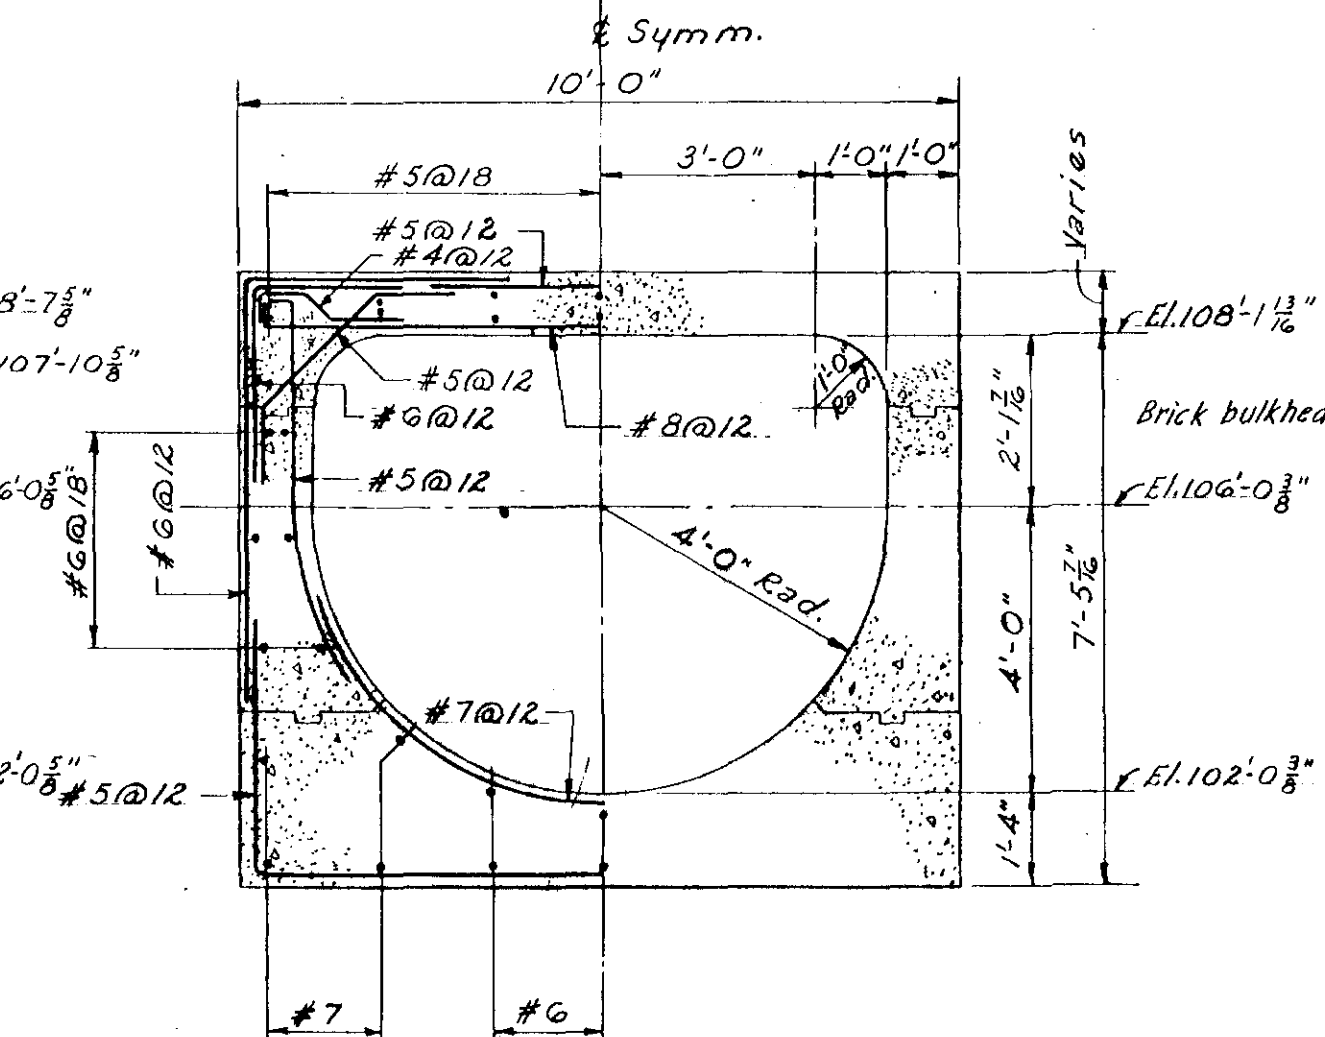
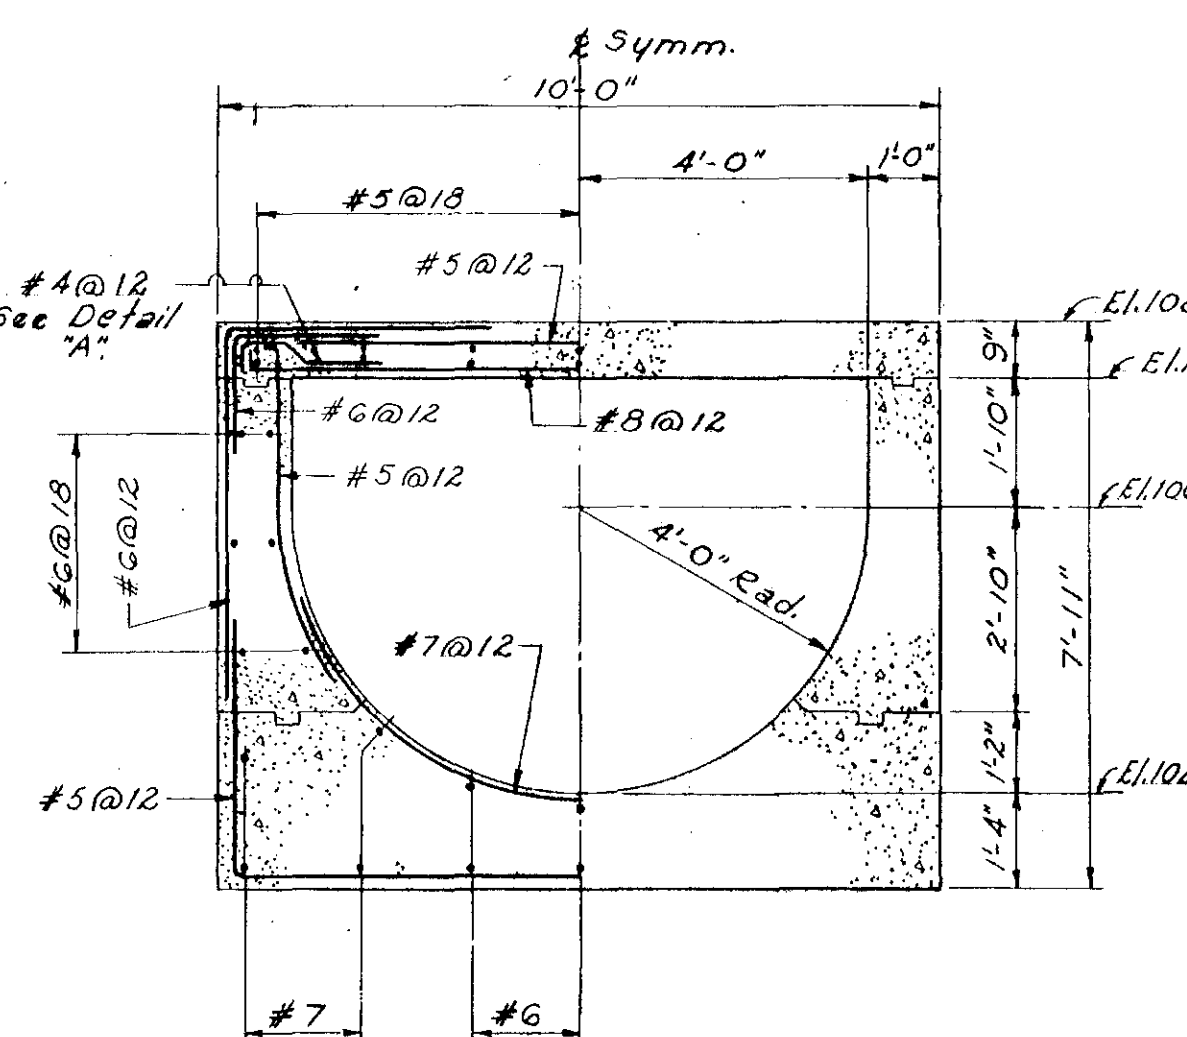
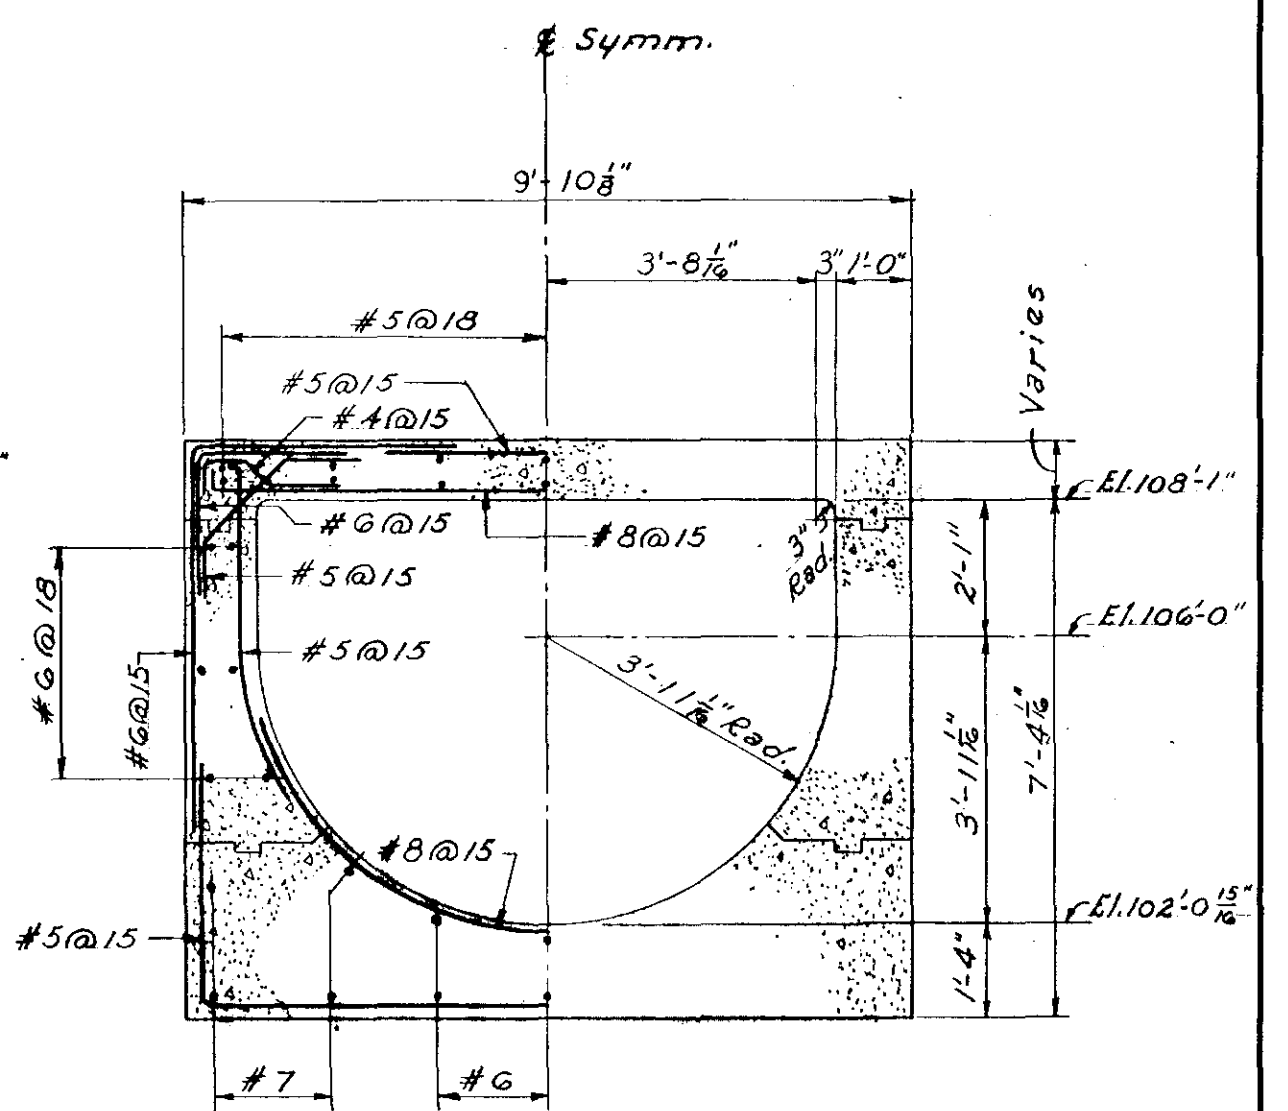
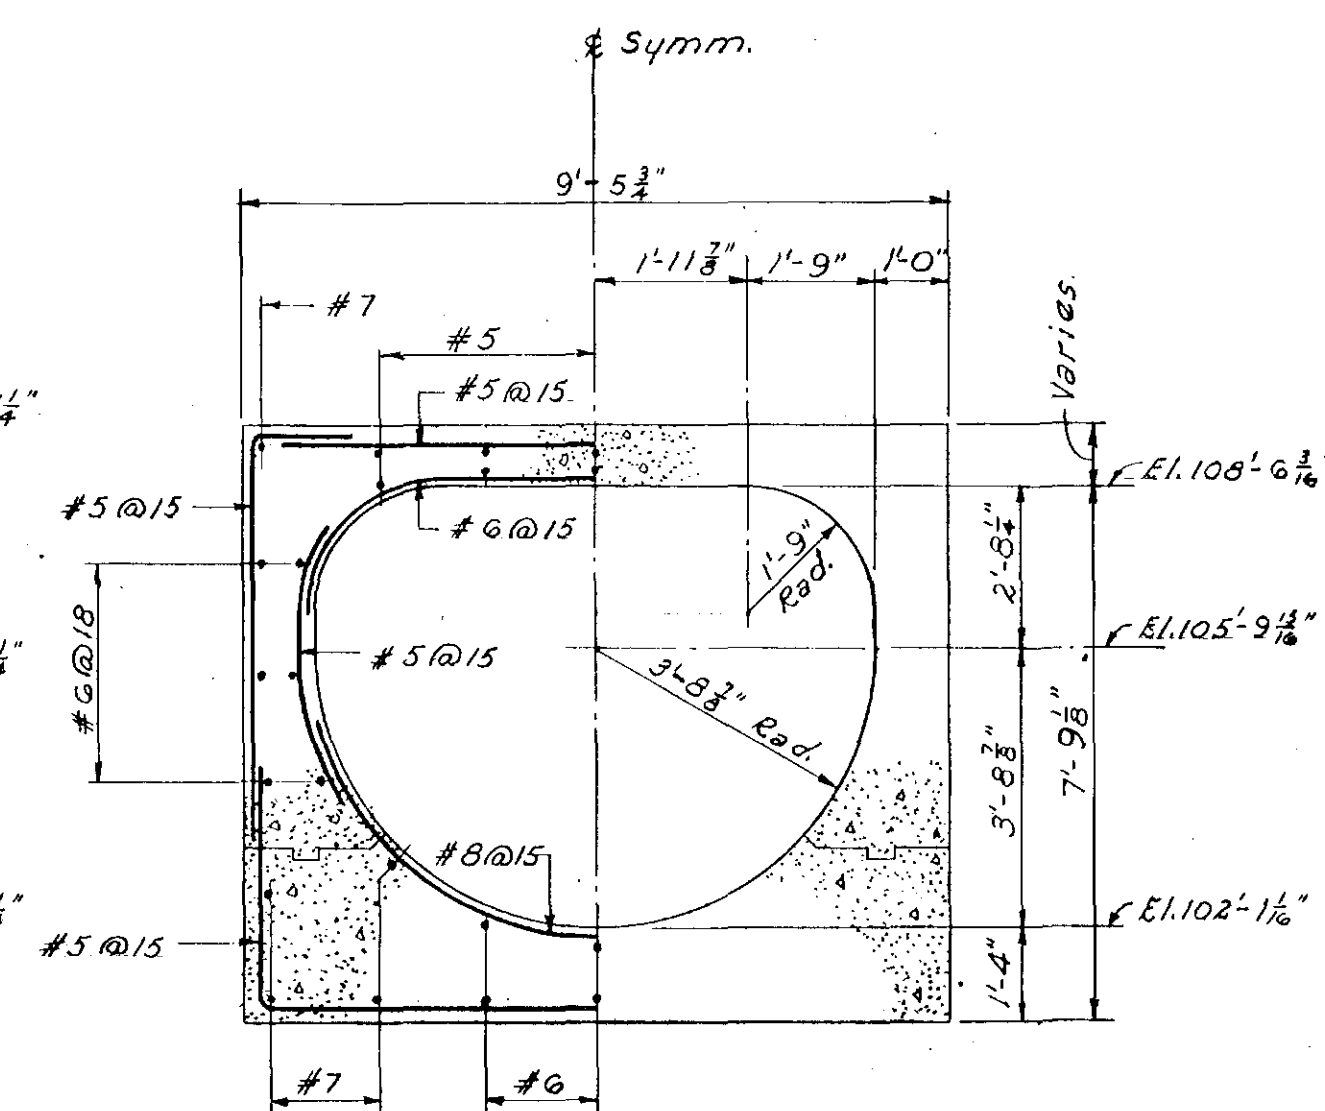
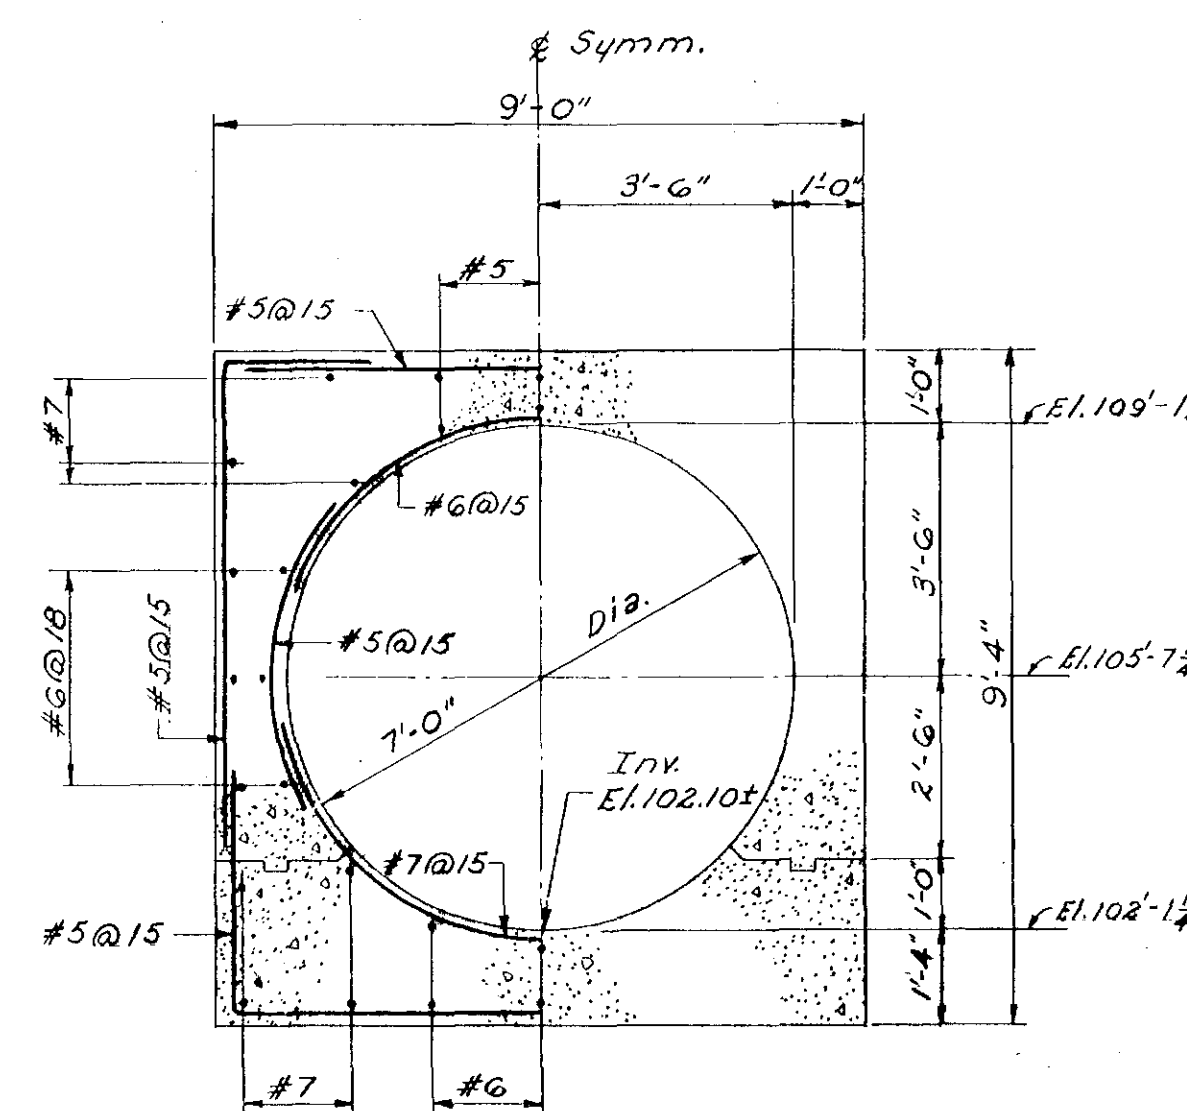
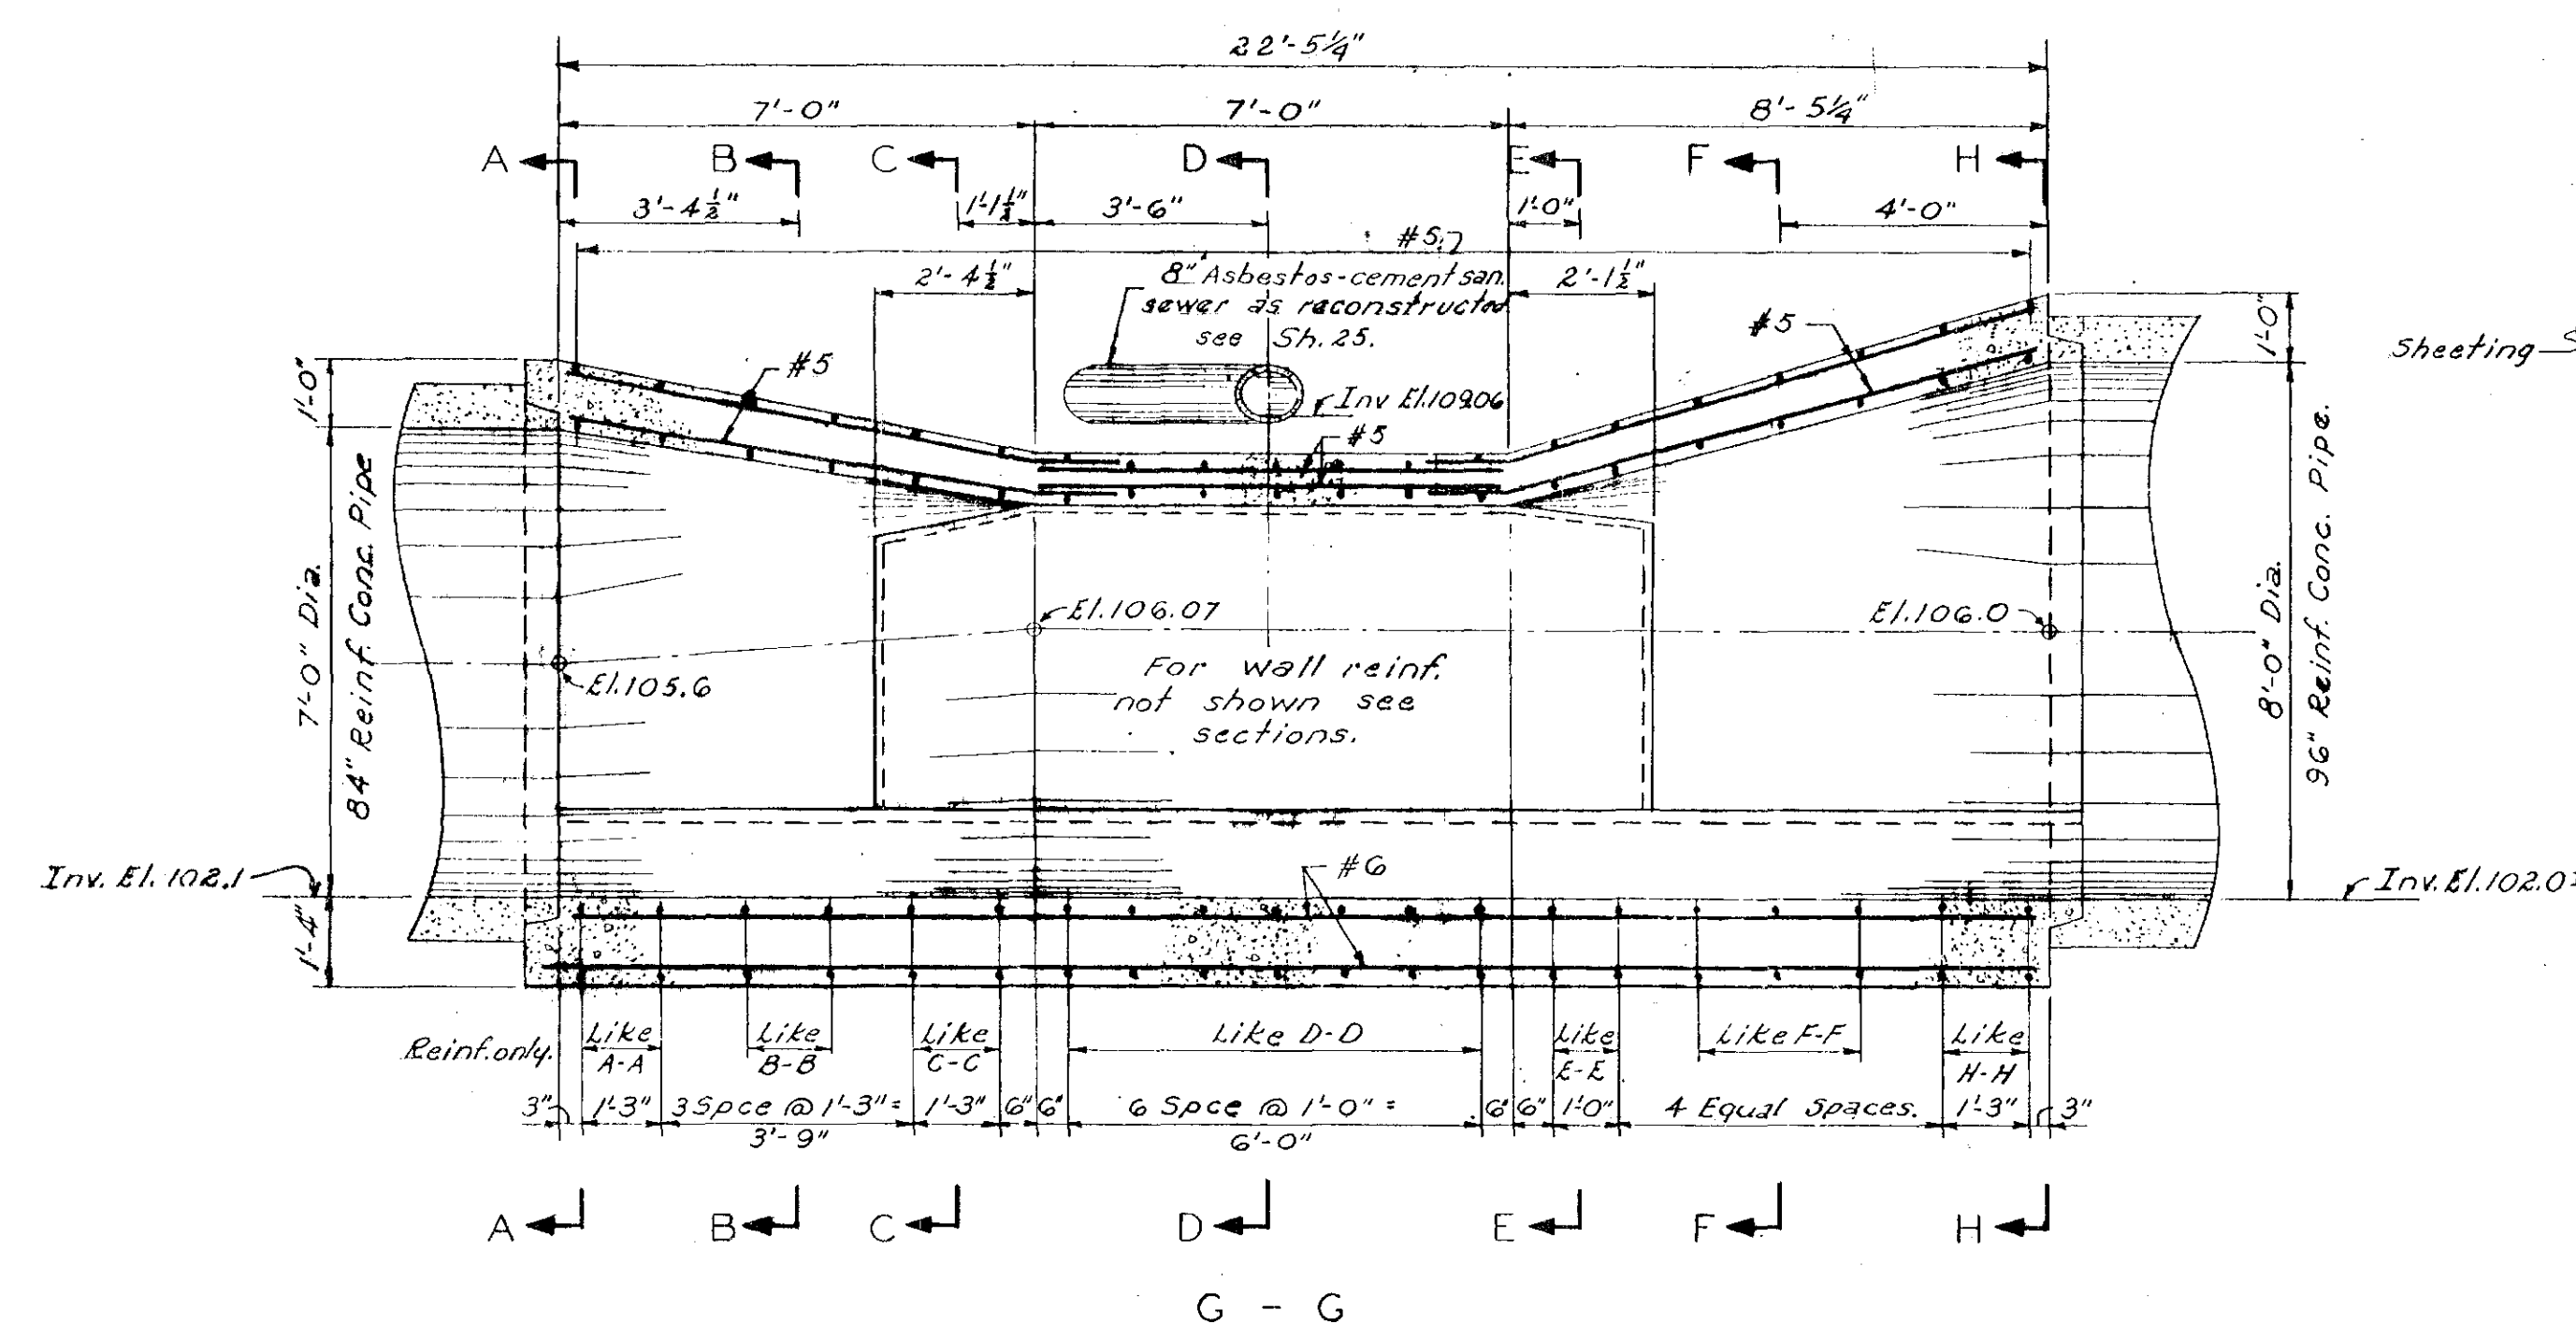
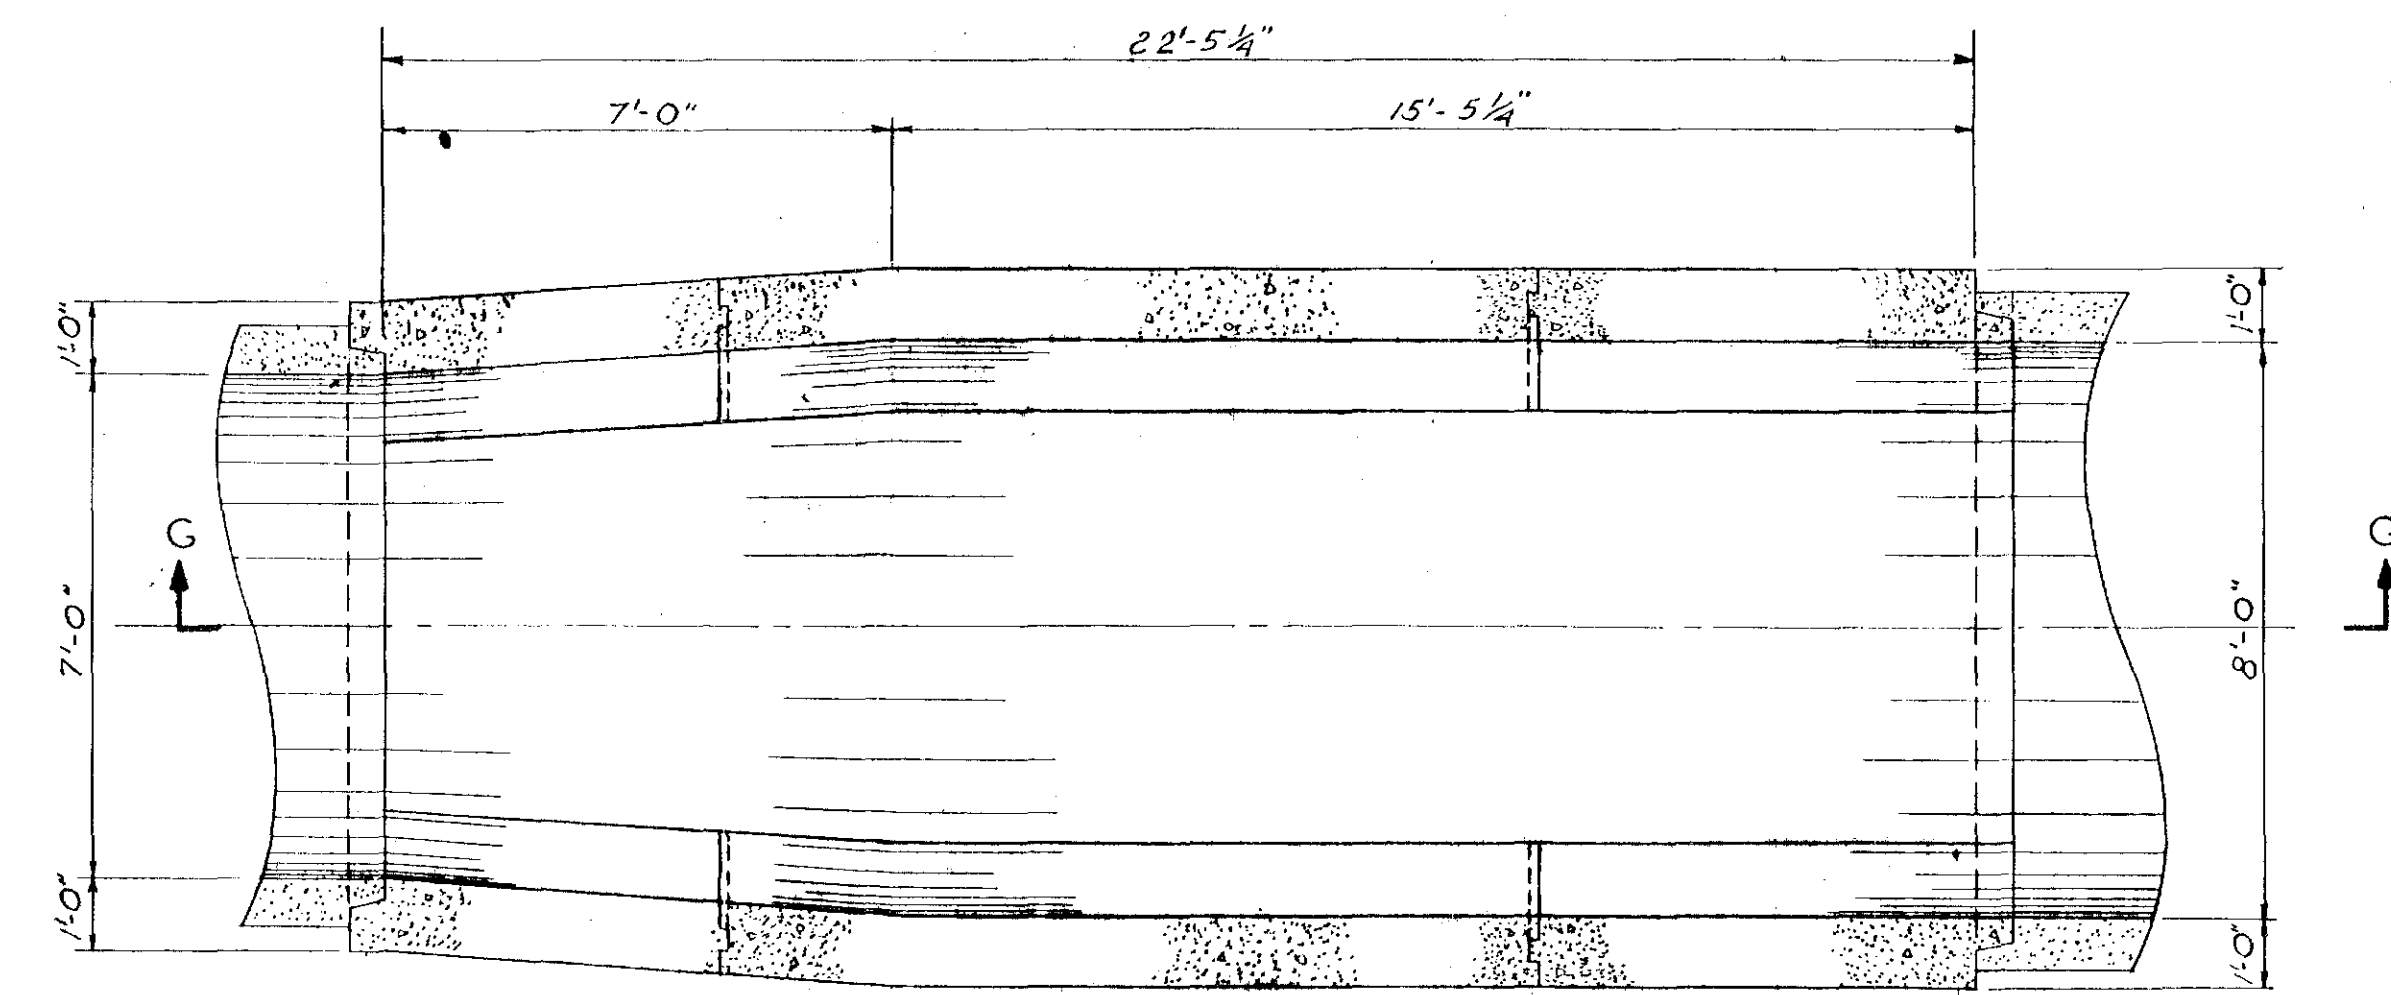


6981
H
18266

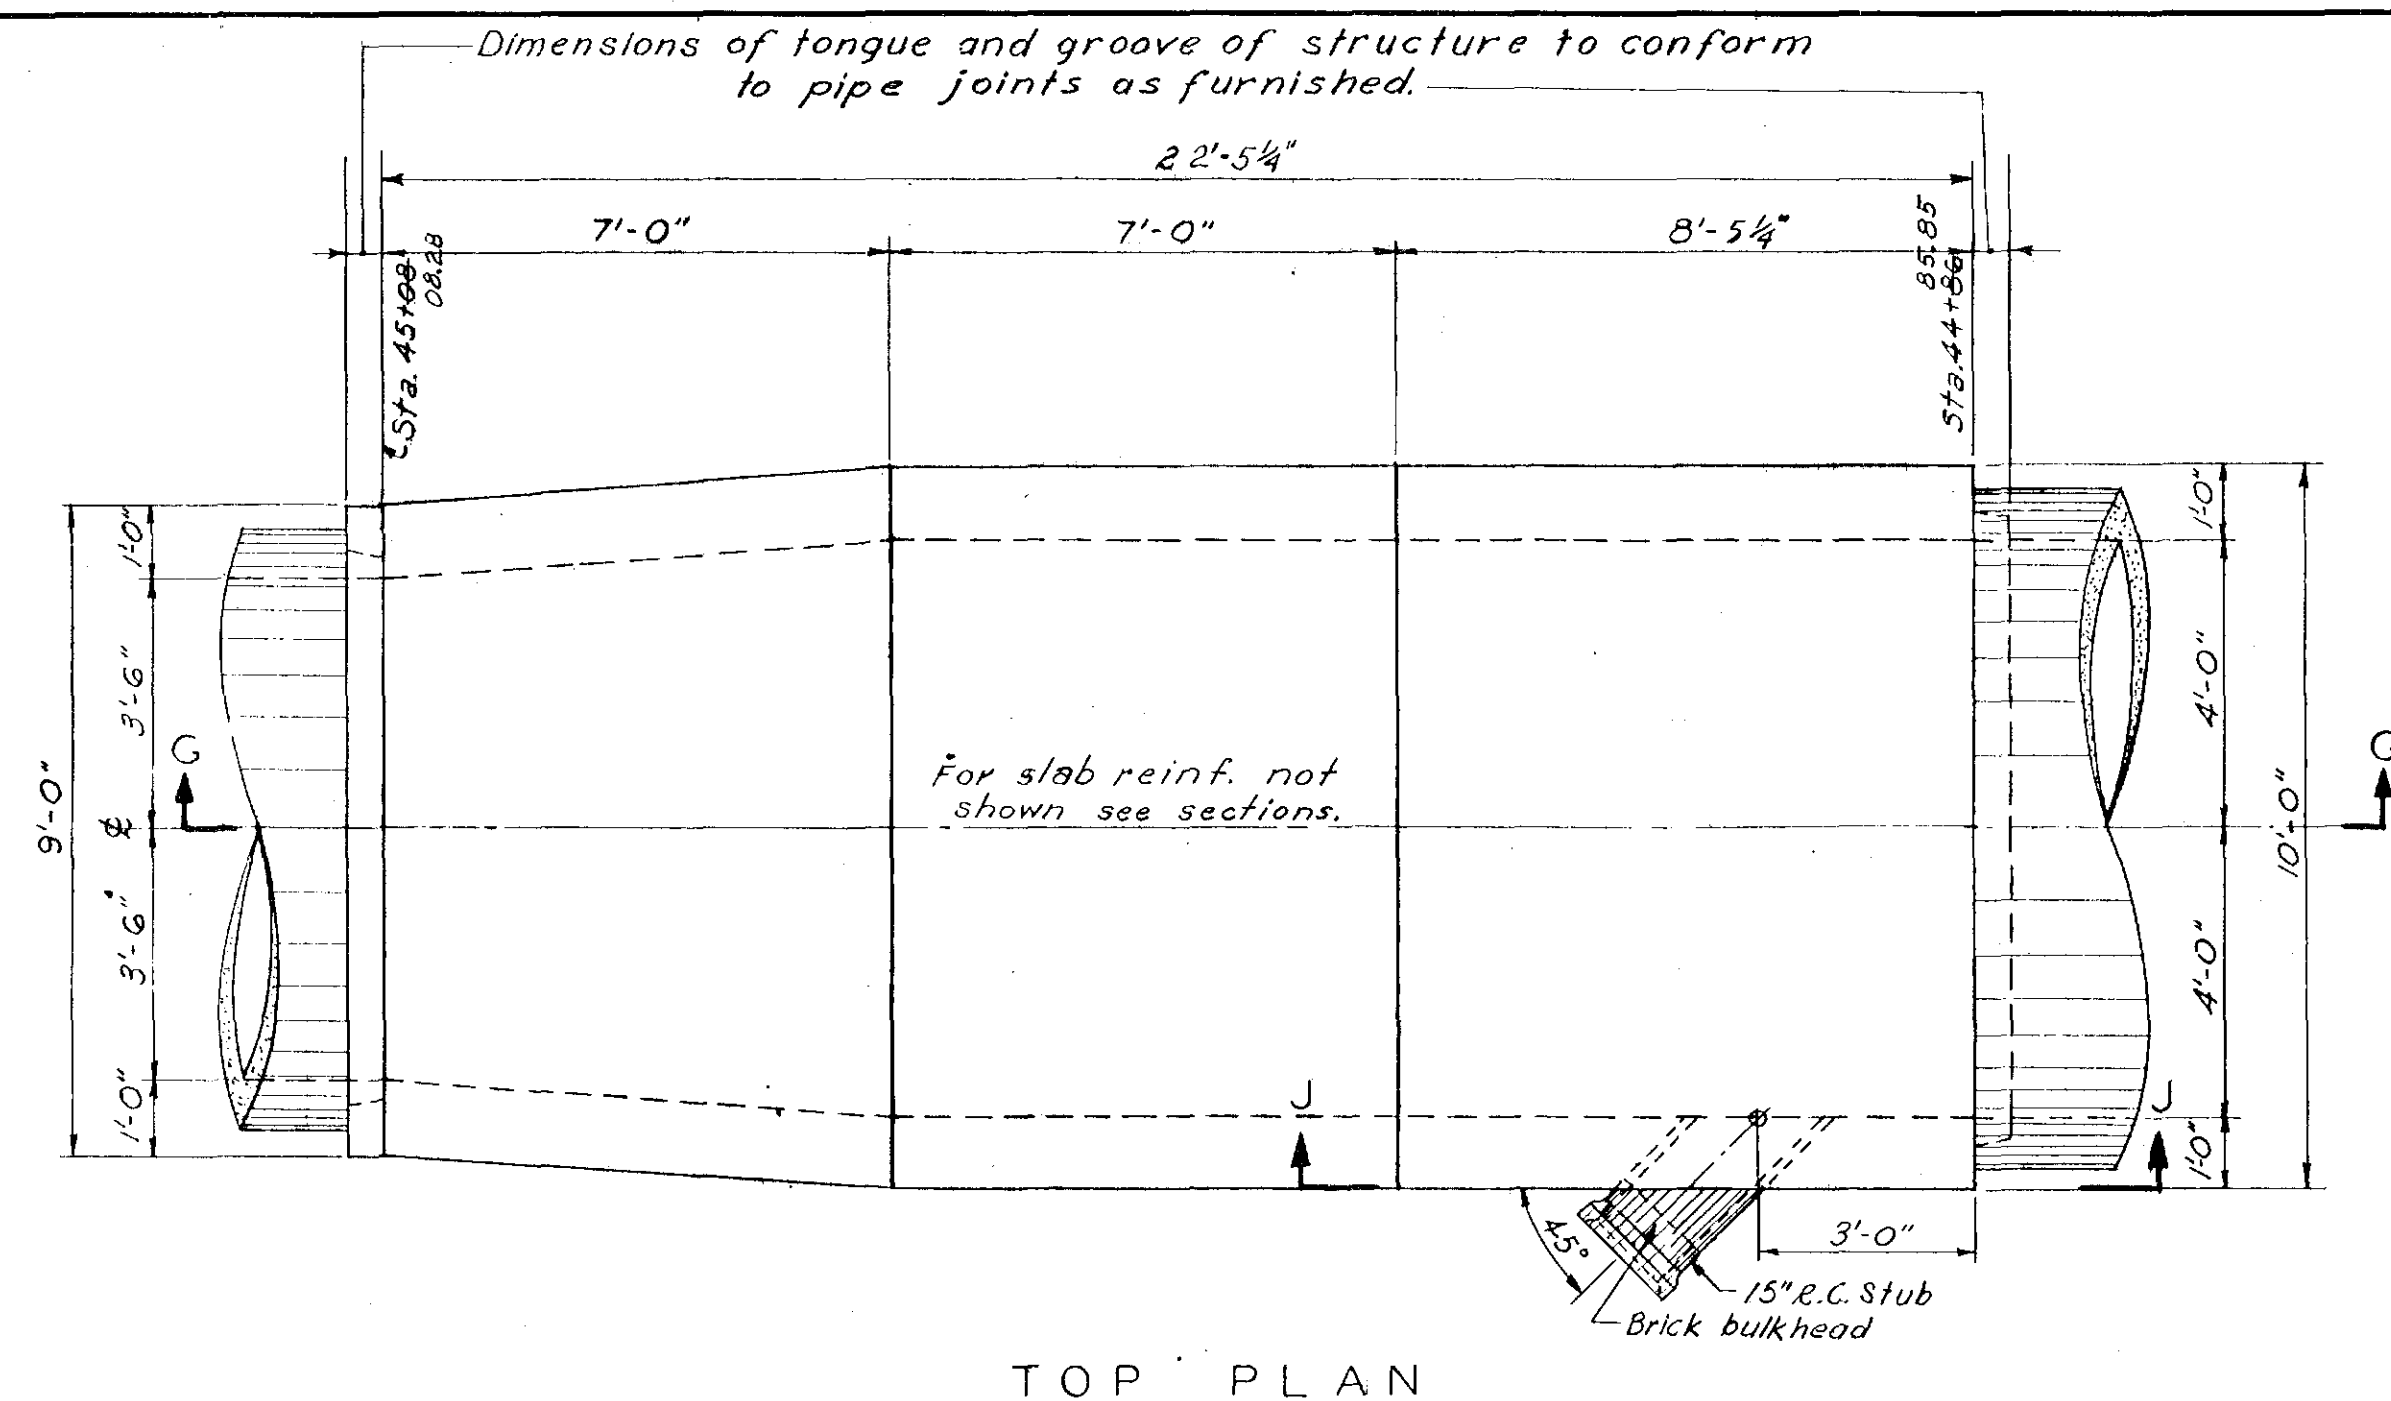

RECORD DRAWING

APPROVED	
FOR PARK RIVER FLOOD CONTROL COMMISSION	
Ch. E. Eddy, Director	5/7/57
REG. PROF. ENGR. CT. NO. 290	DATE
FOR METCALF & EDDY, ENGINEERS	
John W. Raymond, Jr.	5/10/57
REG. PROF. ENGR. CT. NO. 3422	DATE

PARK RIVER FLOOD CONTROL COMMISSION HARTFORD, CONNECTICUT	
CEMETERY BROOK CONDUIT	
AMHERST ST. TRANSITION STRUCTURE	
SCALE: 3/8" = 1'-0"	MAY, 1956
EXCEPT AS SHOWN	
METCALF & EDDY ENGINEERS BOSTON, MASS.	

DRAWN BY: J.F.G. G.B.H.
TRACED BY: J.F.G.
CHECKED BY: C.R.S.

REVISION	DATE	BY	CHECKED BY	DESCRIPTION
1	JUN. 1957	J.F.G.	S.A.H.	RECORD REVISIONS
2	JUN. 1957	L.S.B.	S.A.H.	MINOR CHANGES IN DIMENSIONS