

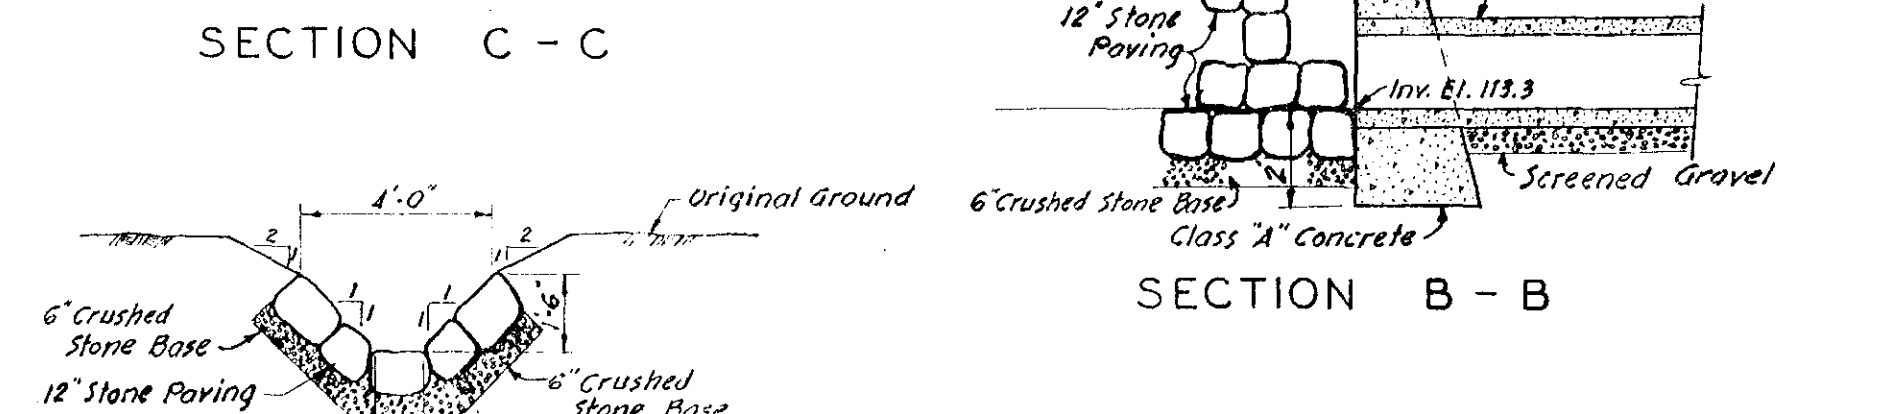
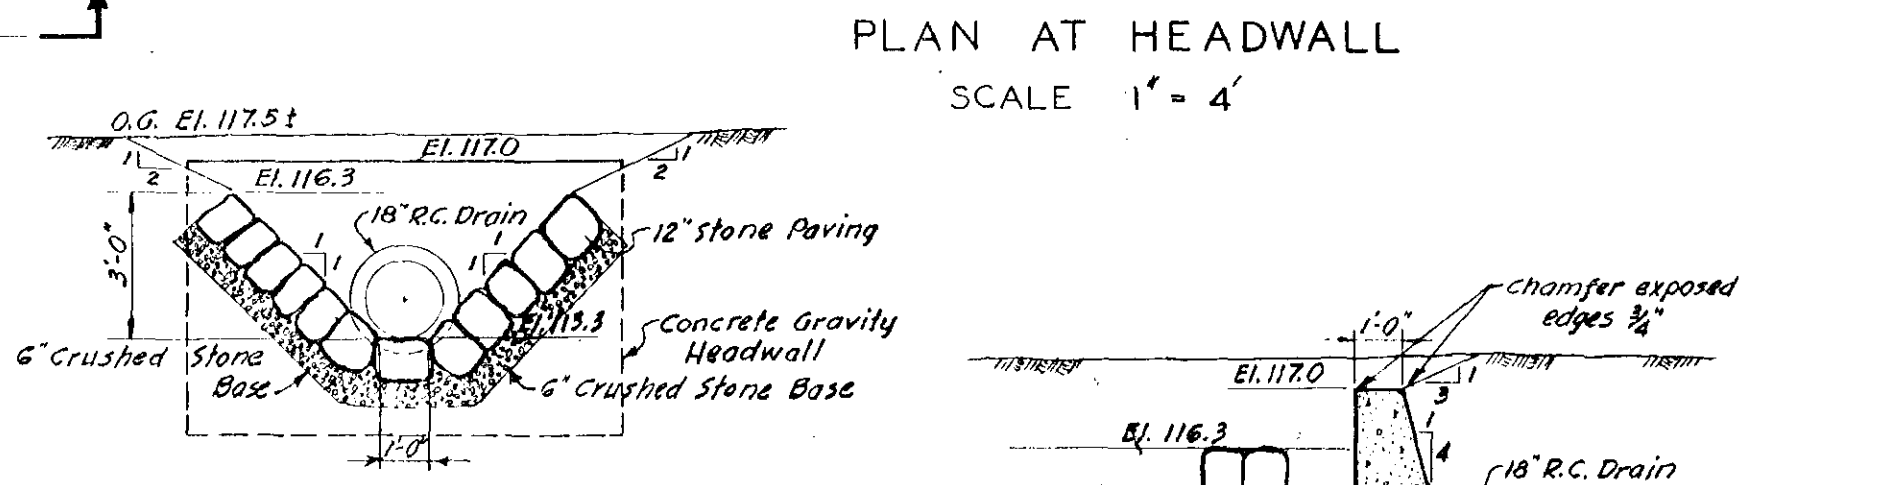
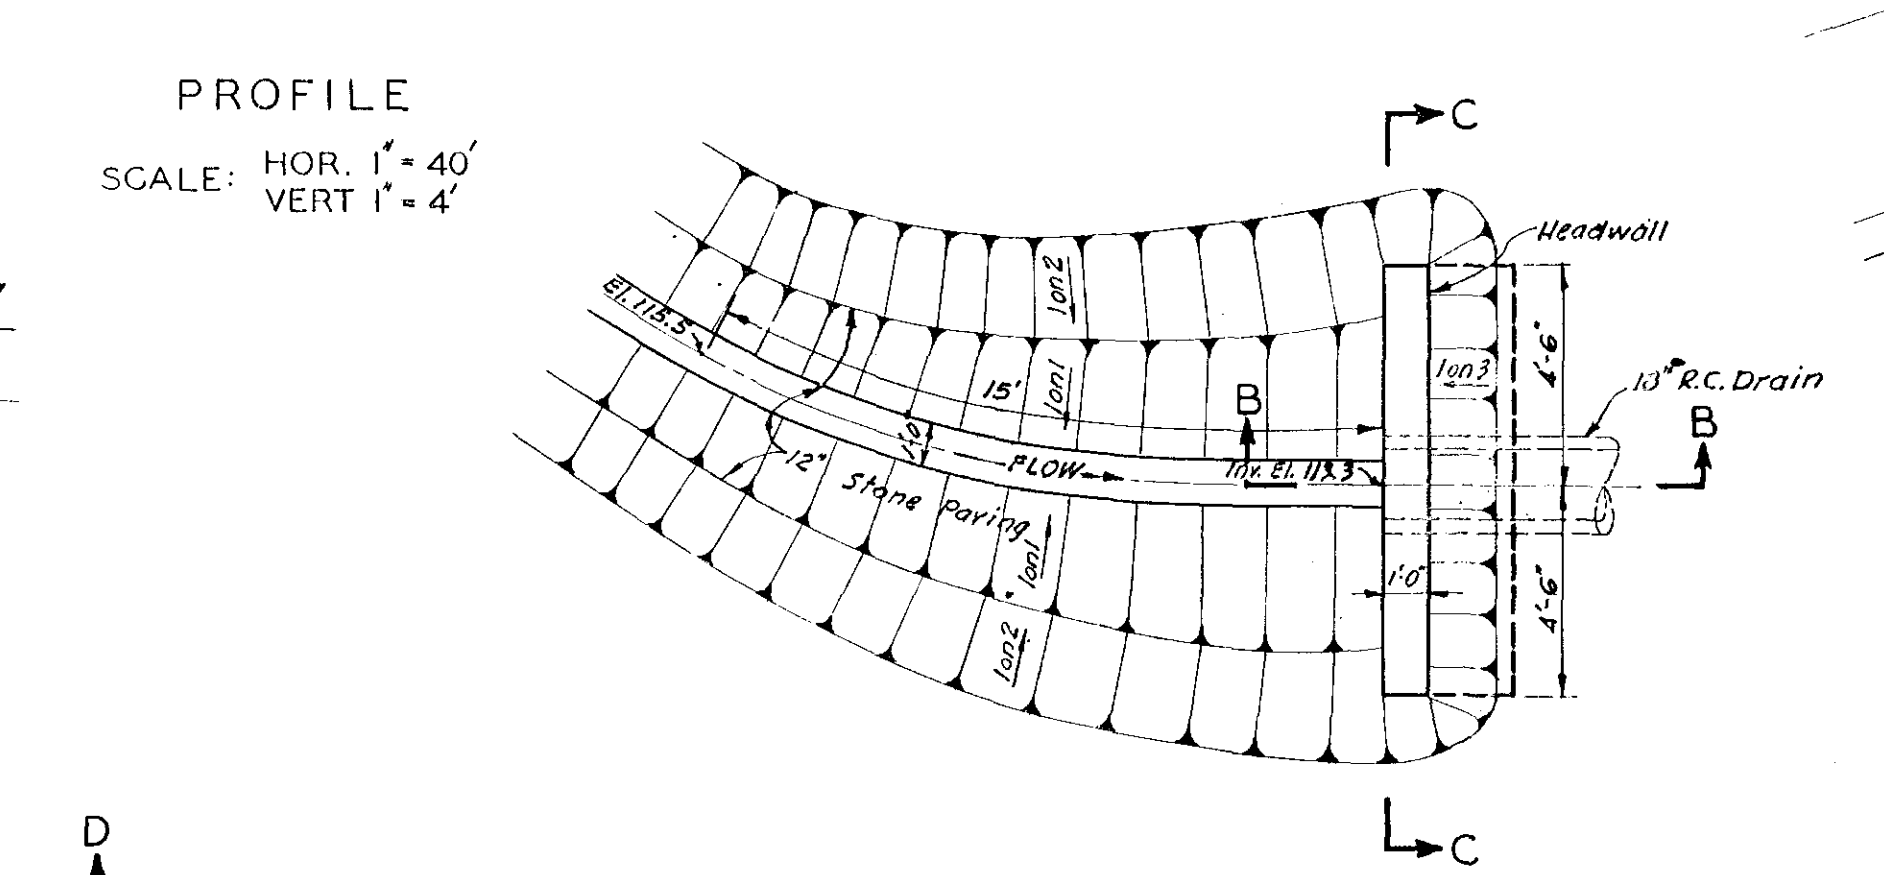
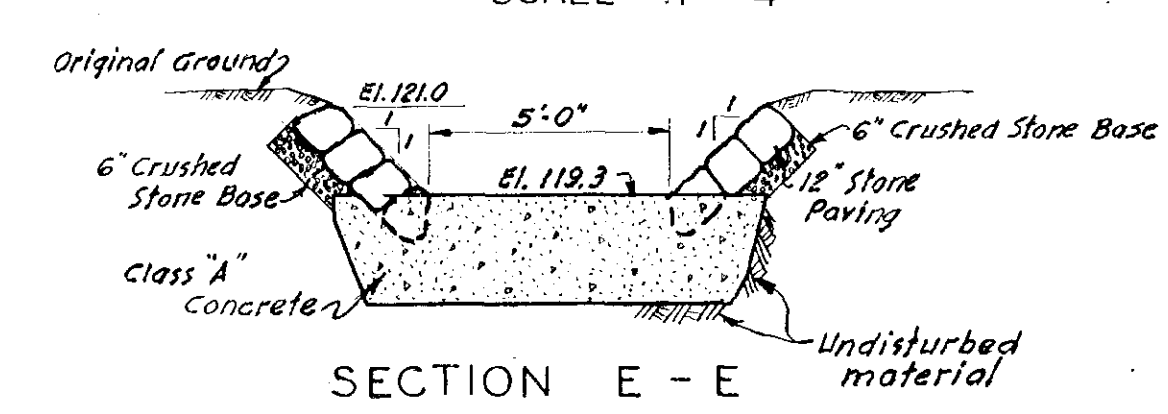
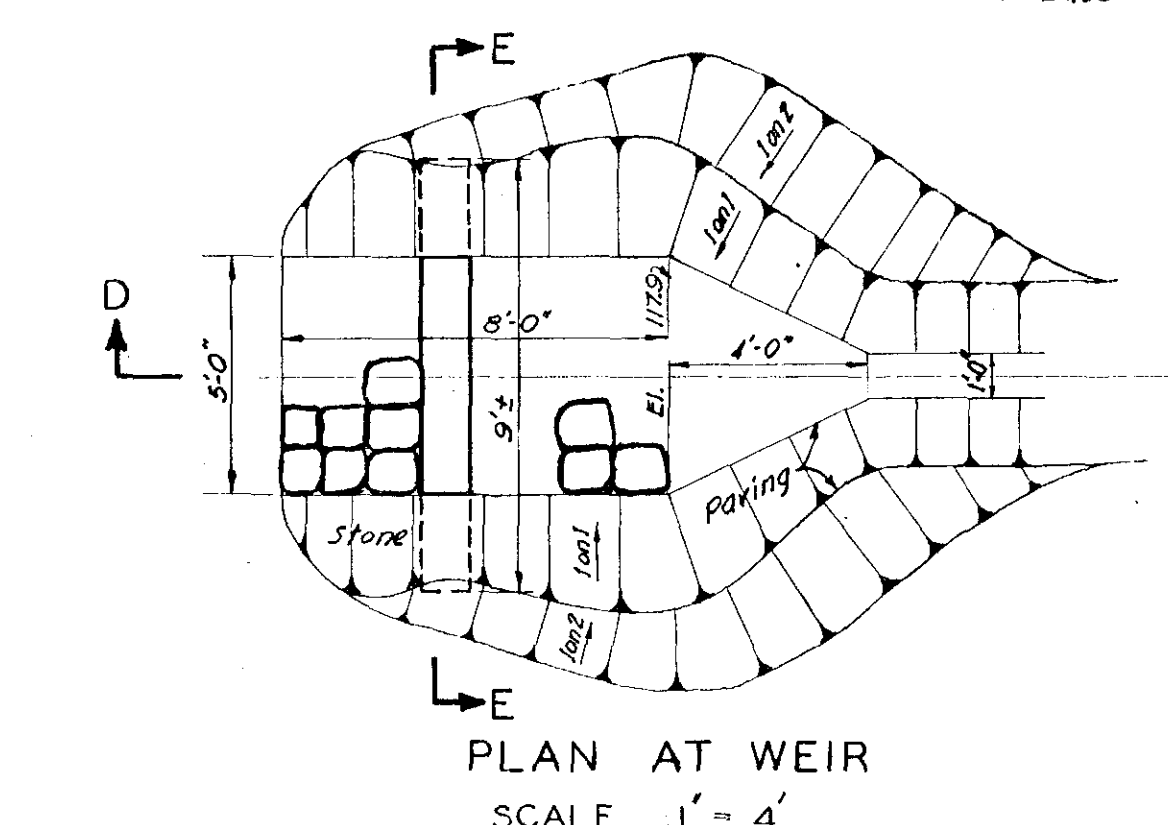
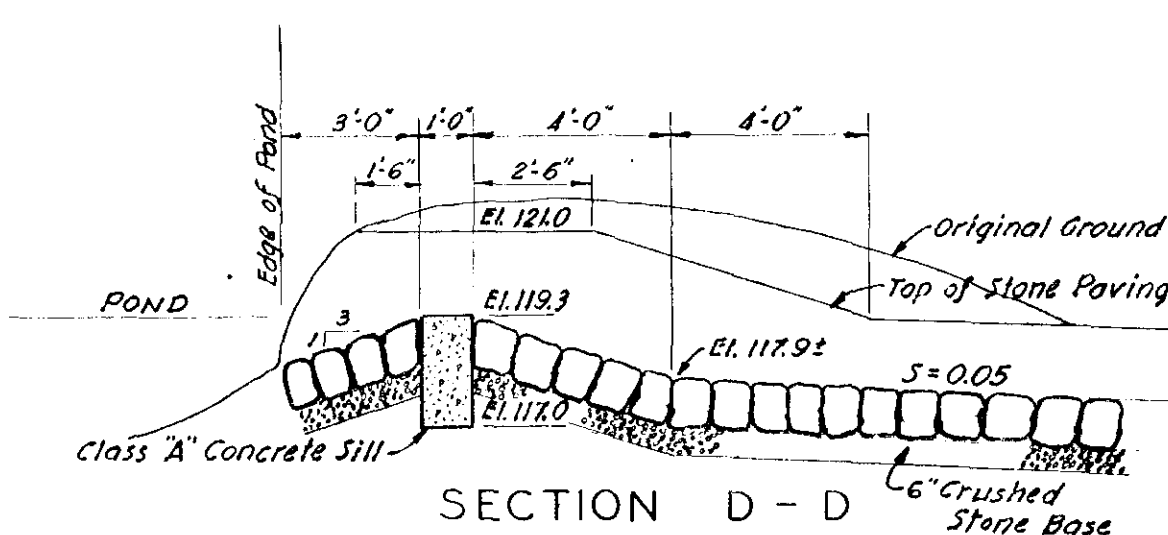
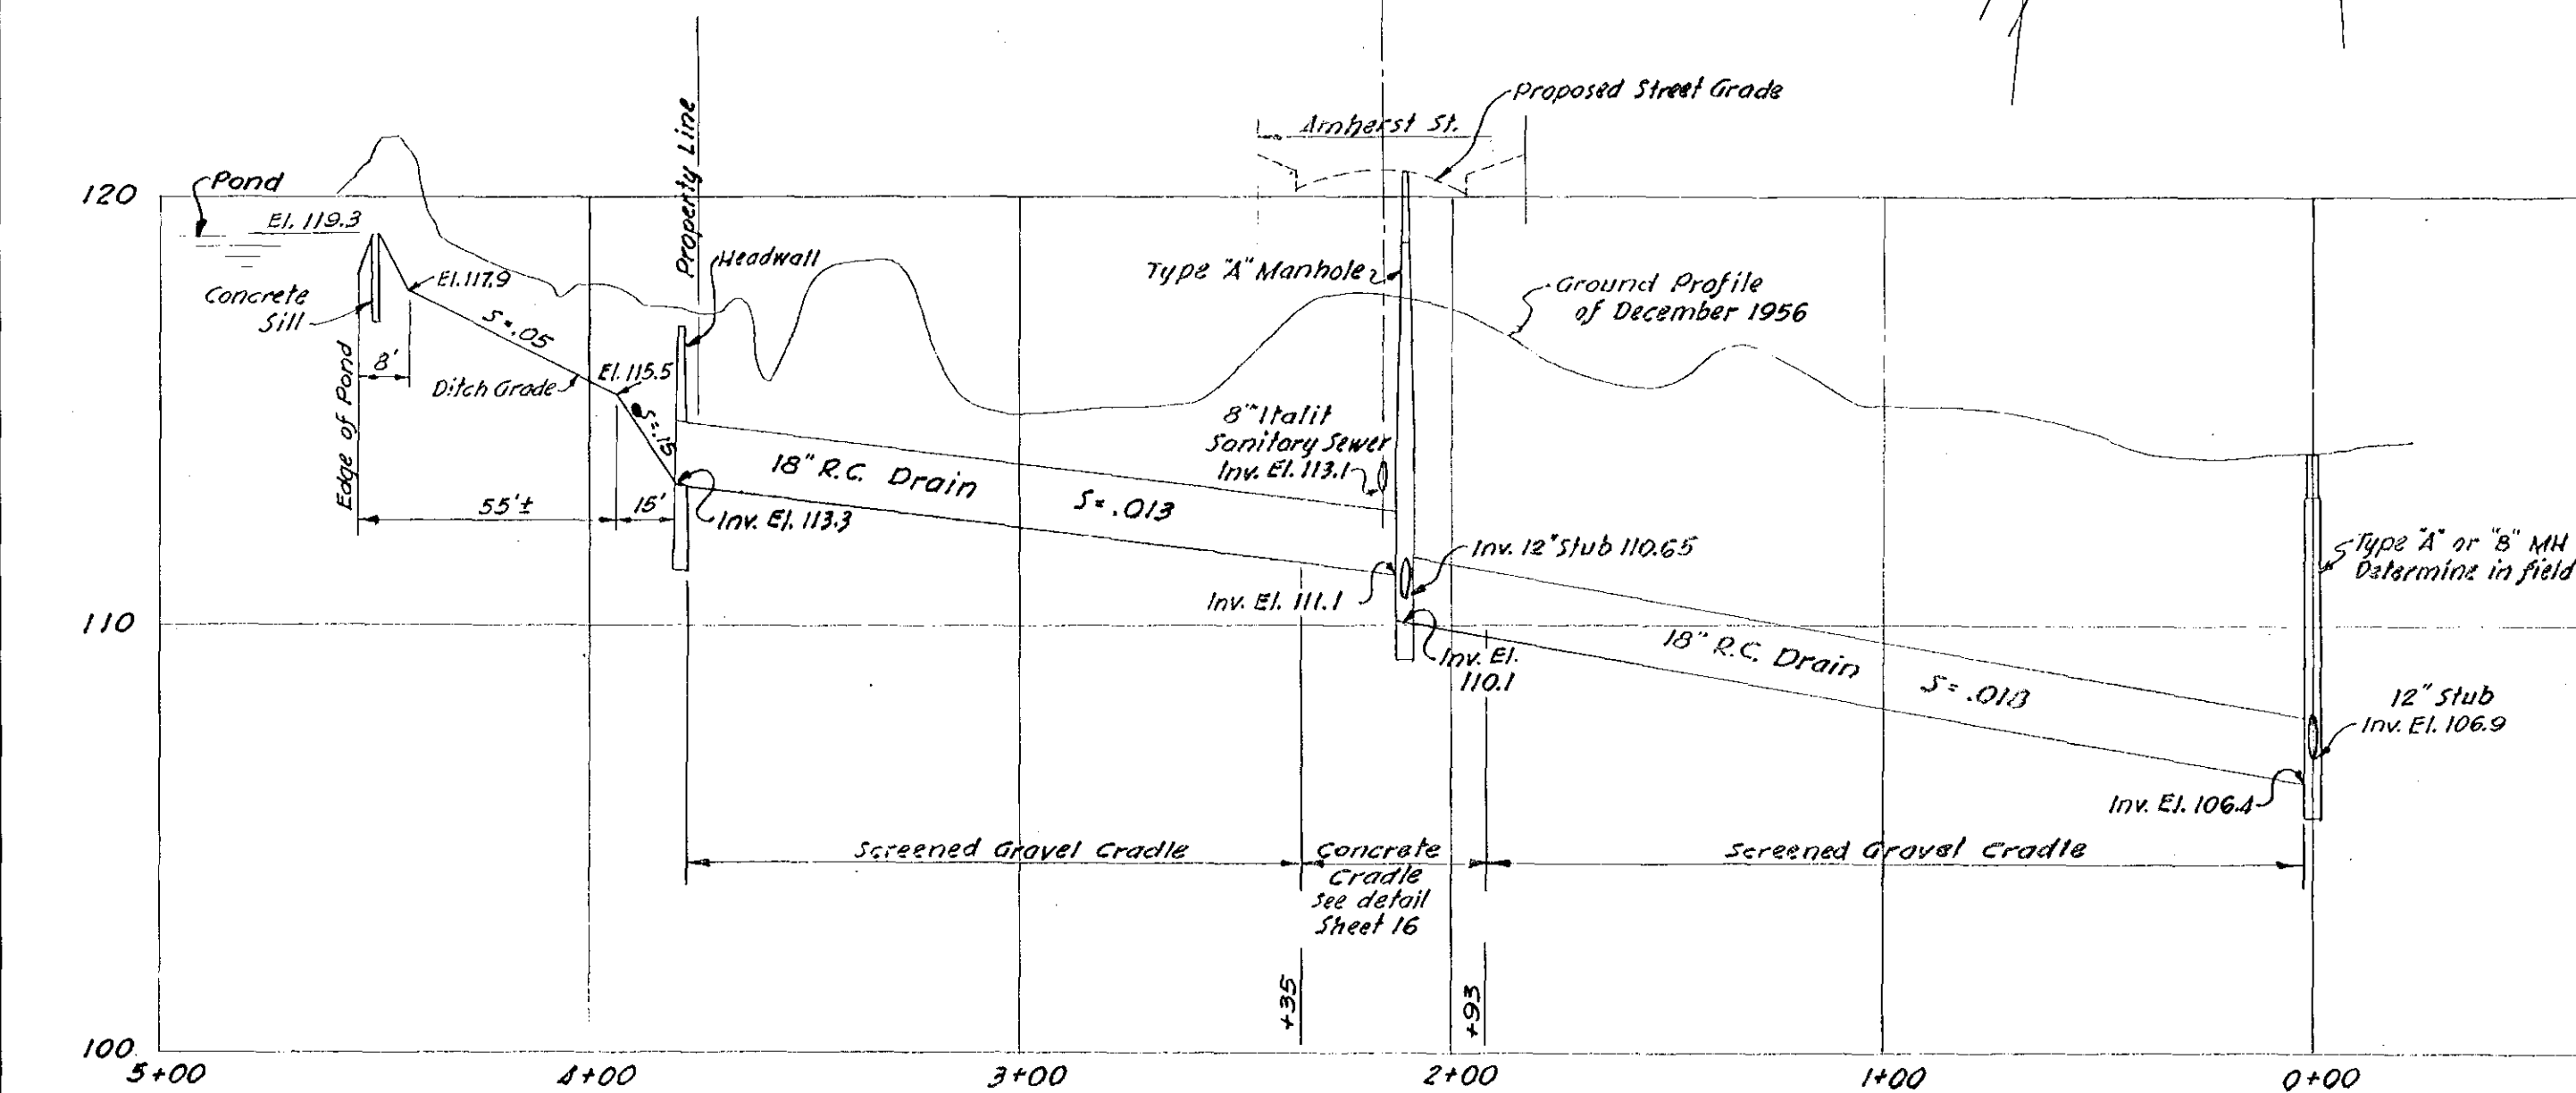
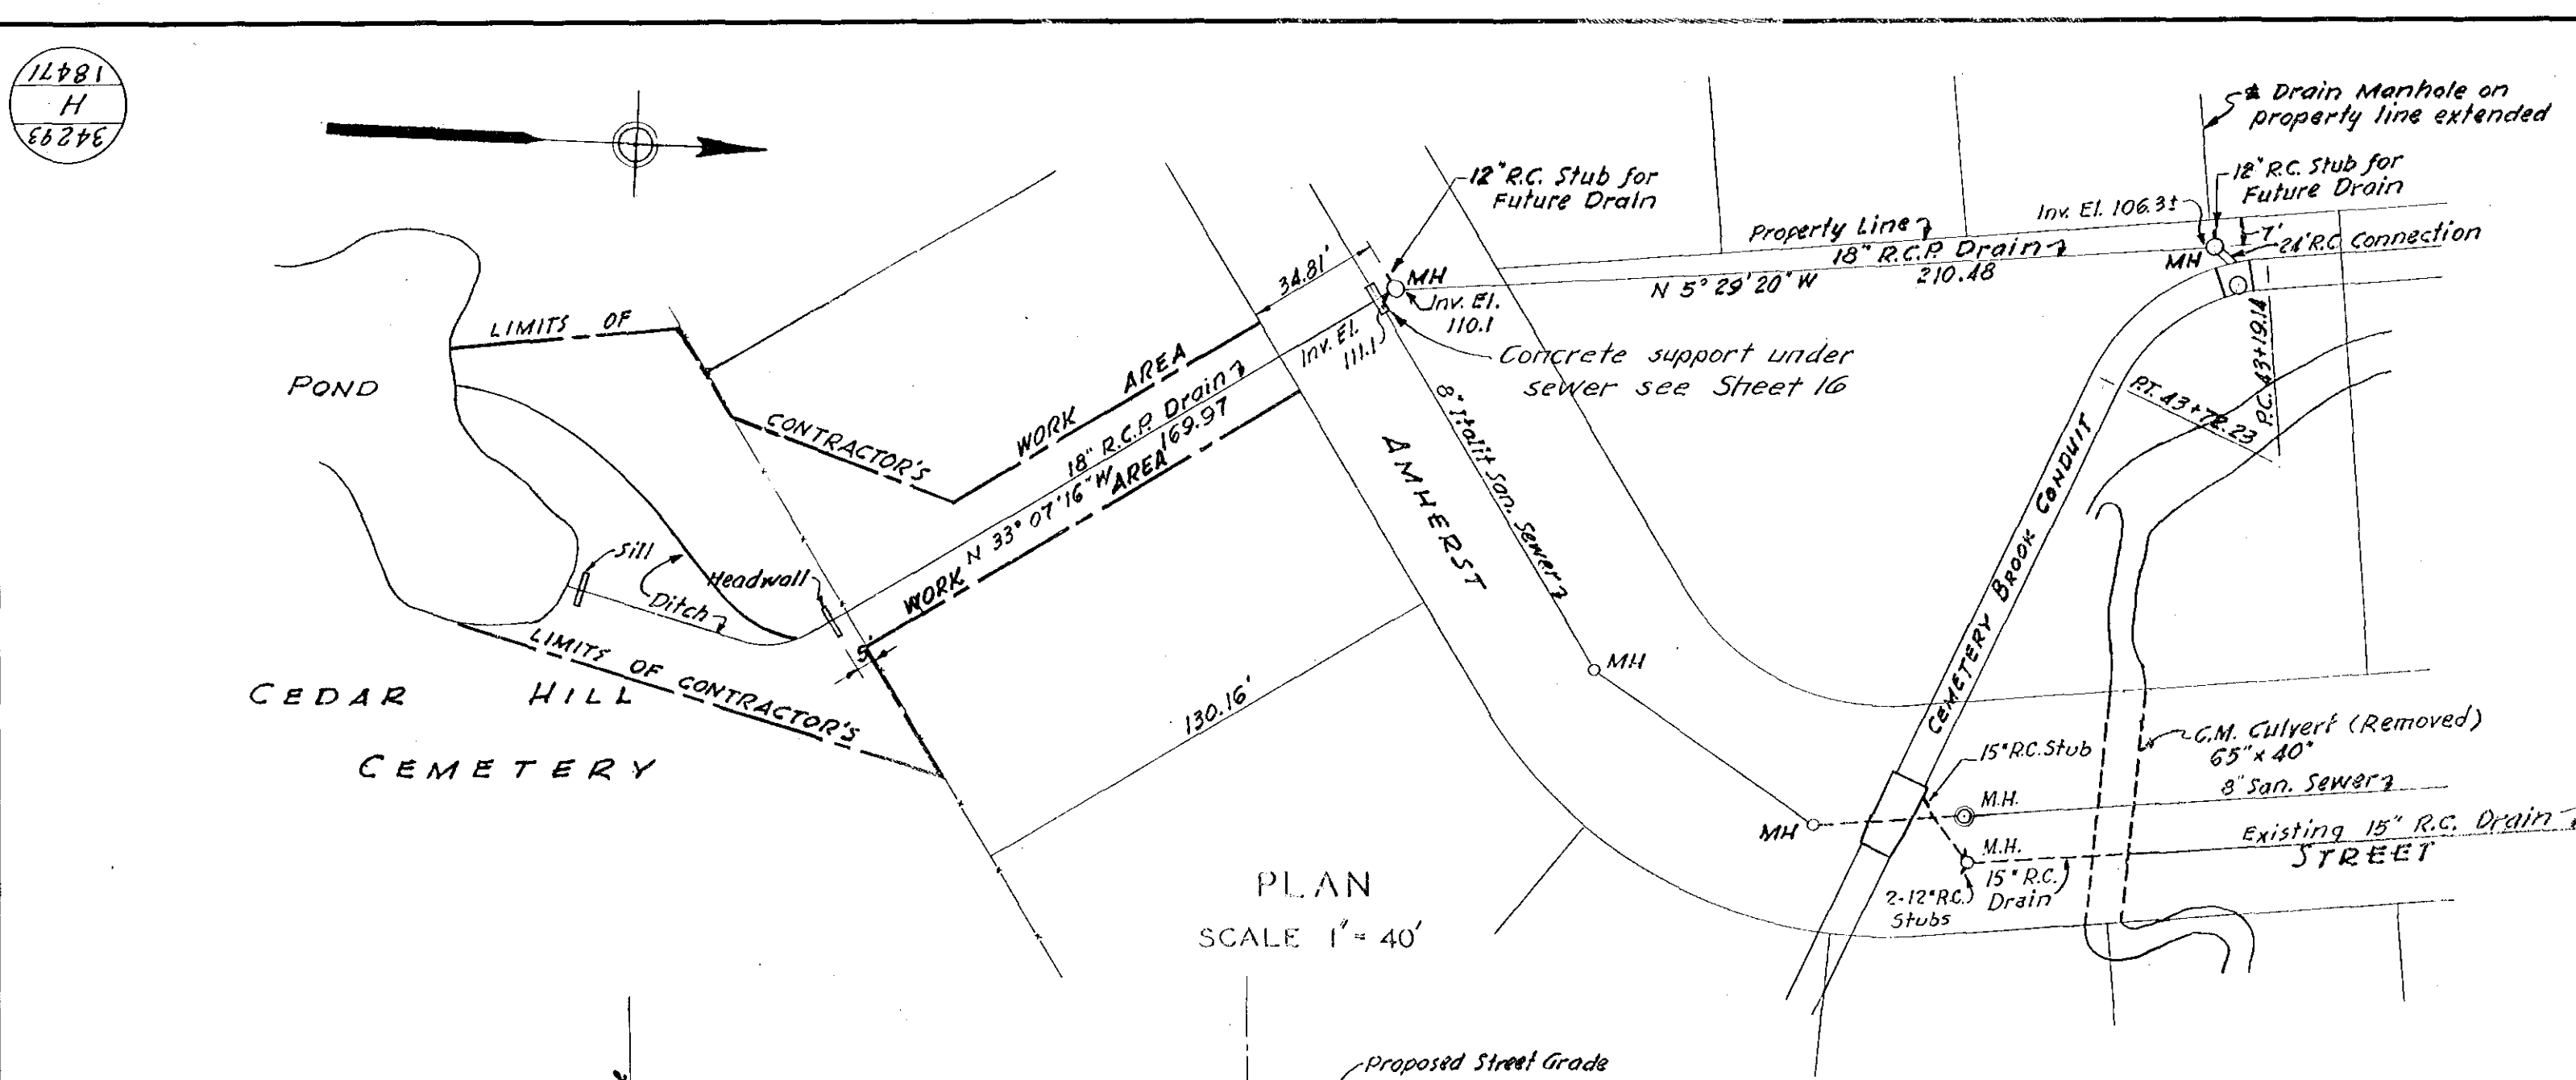
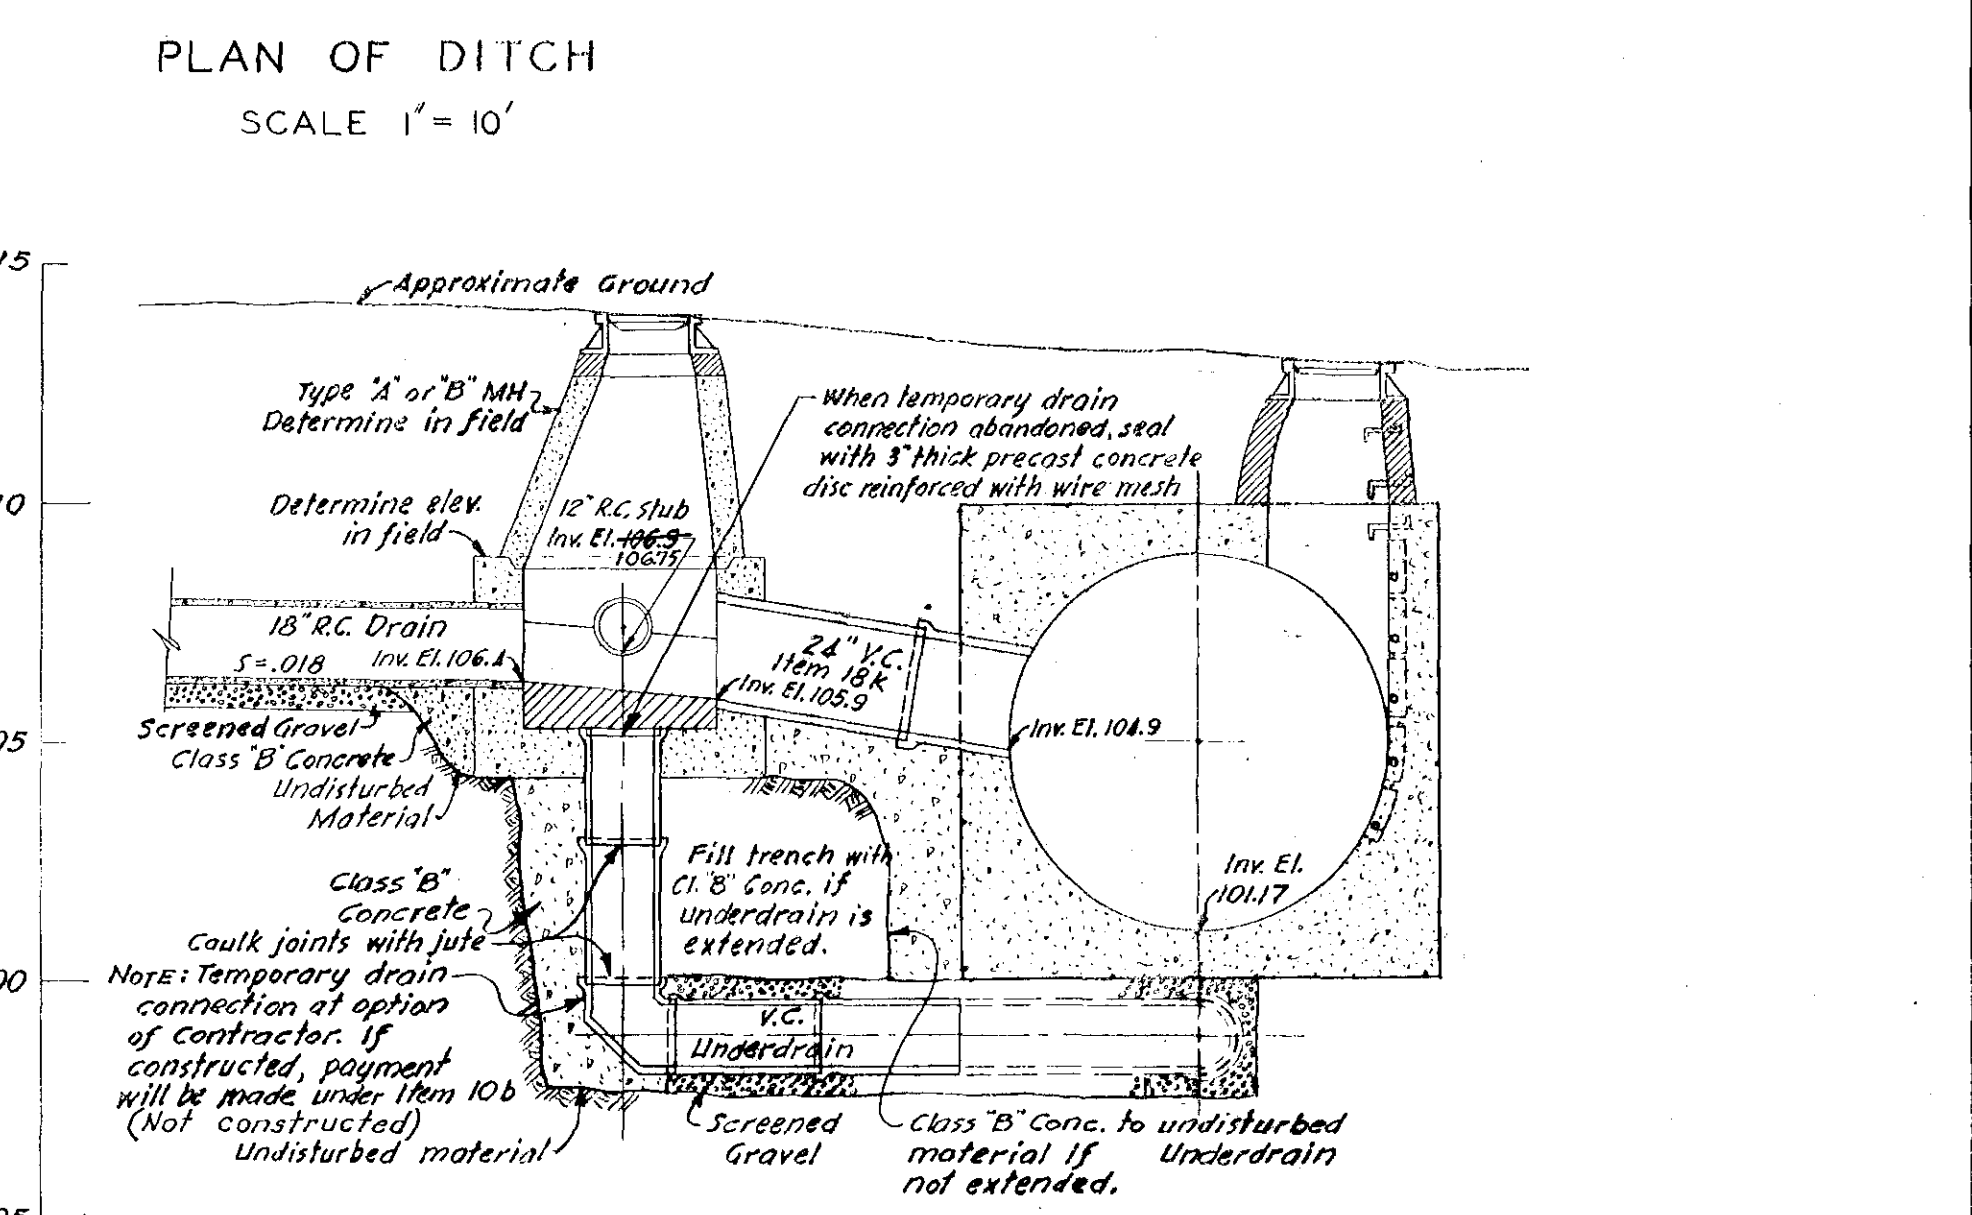


11981
H
53276

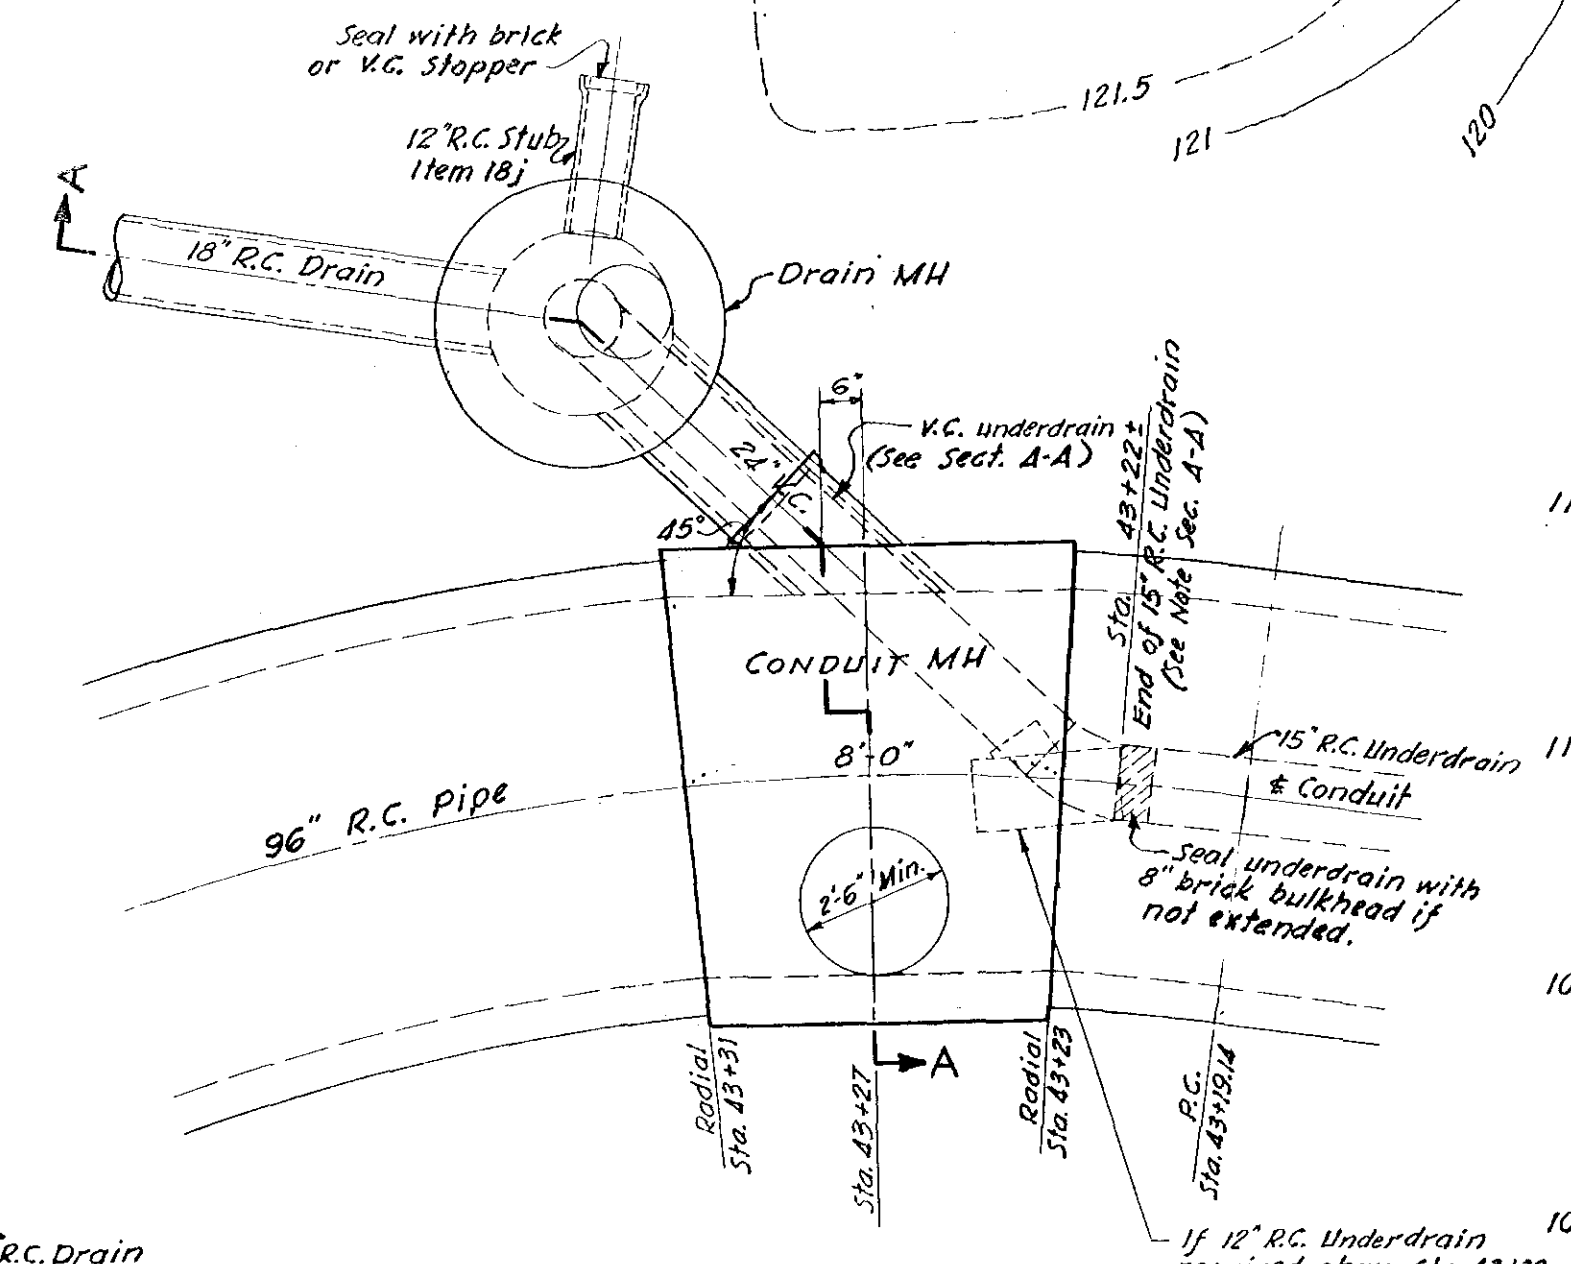

DRAWN BY R.H.L. S.A.H.
TRACED BY A.J.P.
CHECKED BY R.H.L.

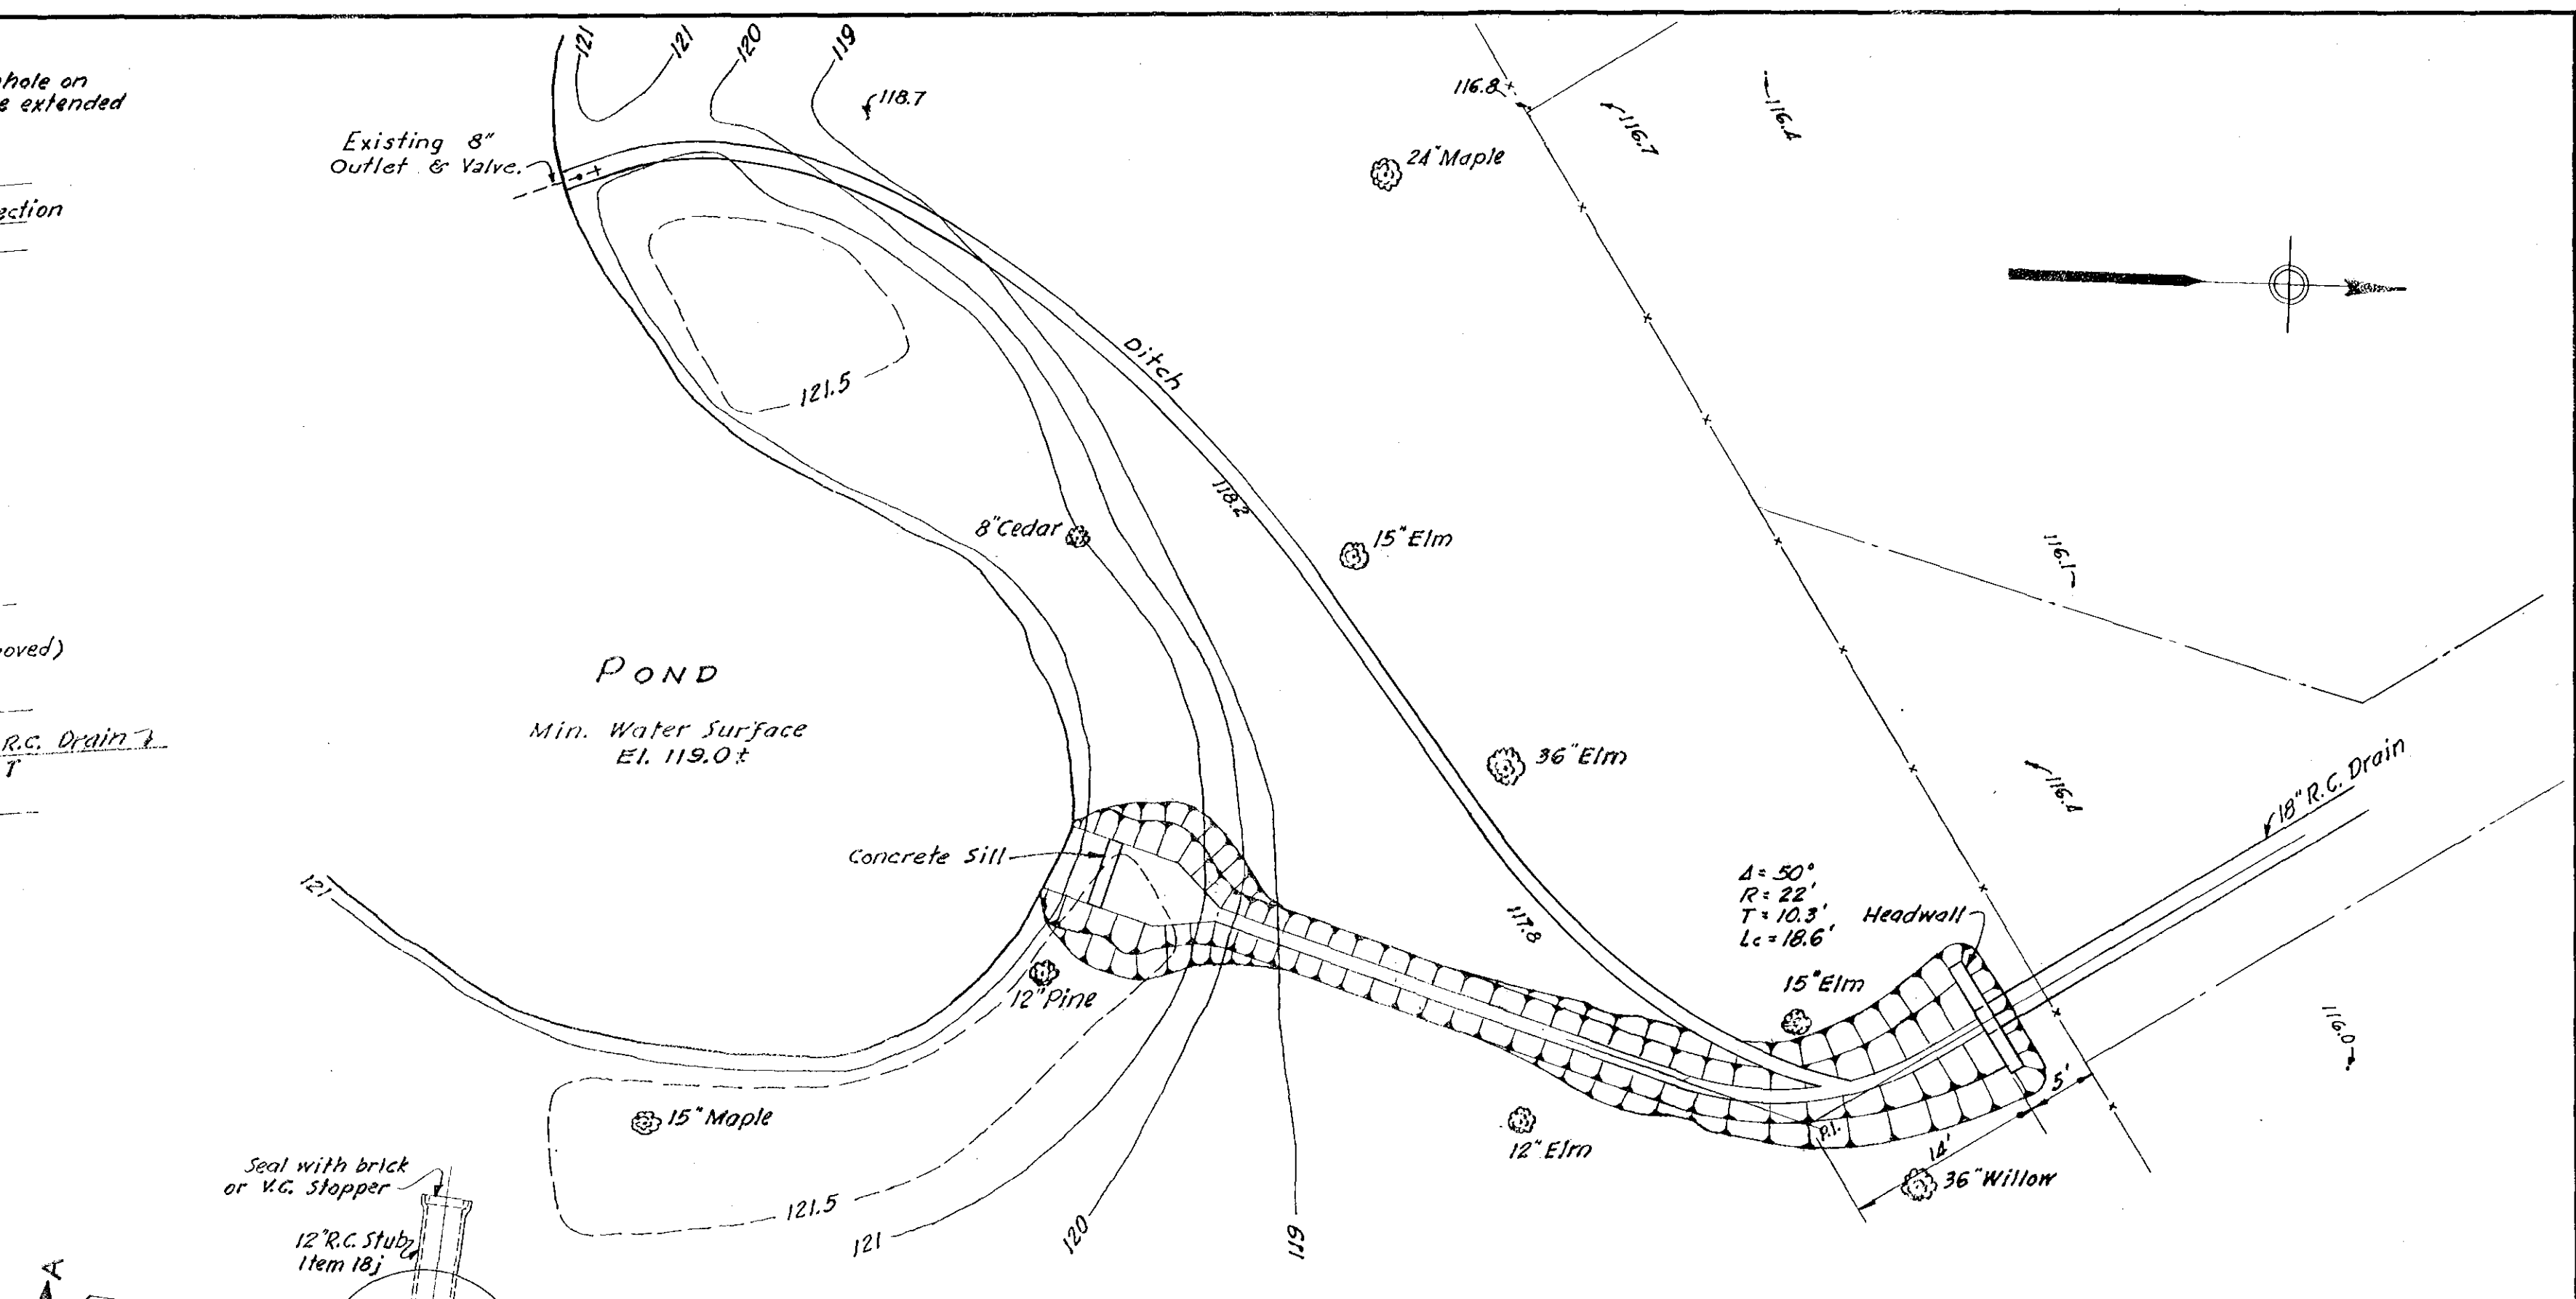

SECTION A-A
SCALE 1" = 4'

NOTE:
For details of manhole structure at Sta. 43+27, see Sheet 15.
V.C. underdrain pipe, if used, shall conform to A.S.T.M. Specifications for Extra Strength Clay Pipe, Designation C200-55T.

RECORD DRAWING

PARK RIVER FLOOD CONTROL COMMISSION
HARTFORD, CONNECTICUT
CEMETERY BROOK CONDUIT
18" DRAIN CROSSING AMHERST ST.
CONNECTION AT STA. 43+27
SCALE, AS SHOWN MAY, 1957

APPROVED	
FOR PARK RIVER FLOOD CONTROL COMMISSION	
Chas. W. G. B. Director	5/7/57
REG. PROF. ENGR. CT. NO. 290	DATE
FOR METCALF & EDDY, ENGINEERS	
John W. Raymond	5/10/57
REG. PROF. ENGR. CT. NO. 3422	DATE

REVISION	MADE BY	CHECKED BY	DESCRIPTION
1. Jan. 1960	J.F.G.	S.A.H.	Record Revisions.

G.H.C. Serial No. 000894

CONTRACT 1957-3 SHEET 29 OF 31