
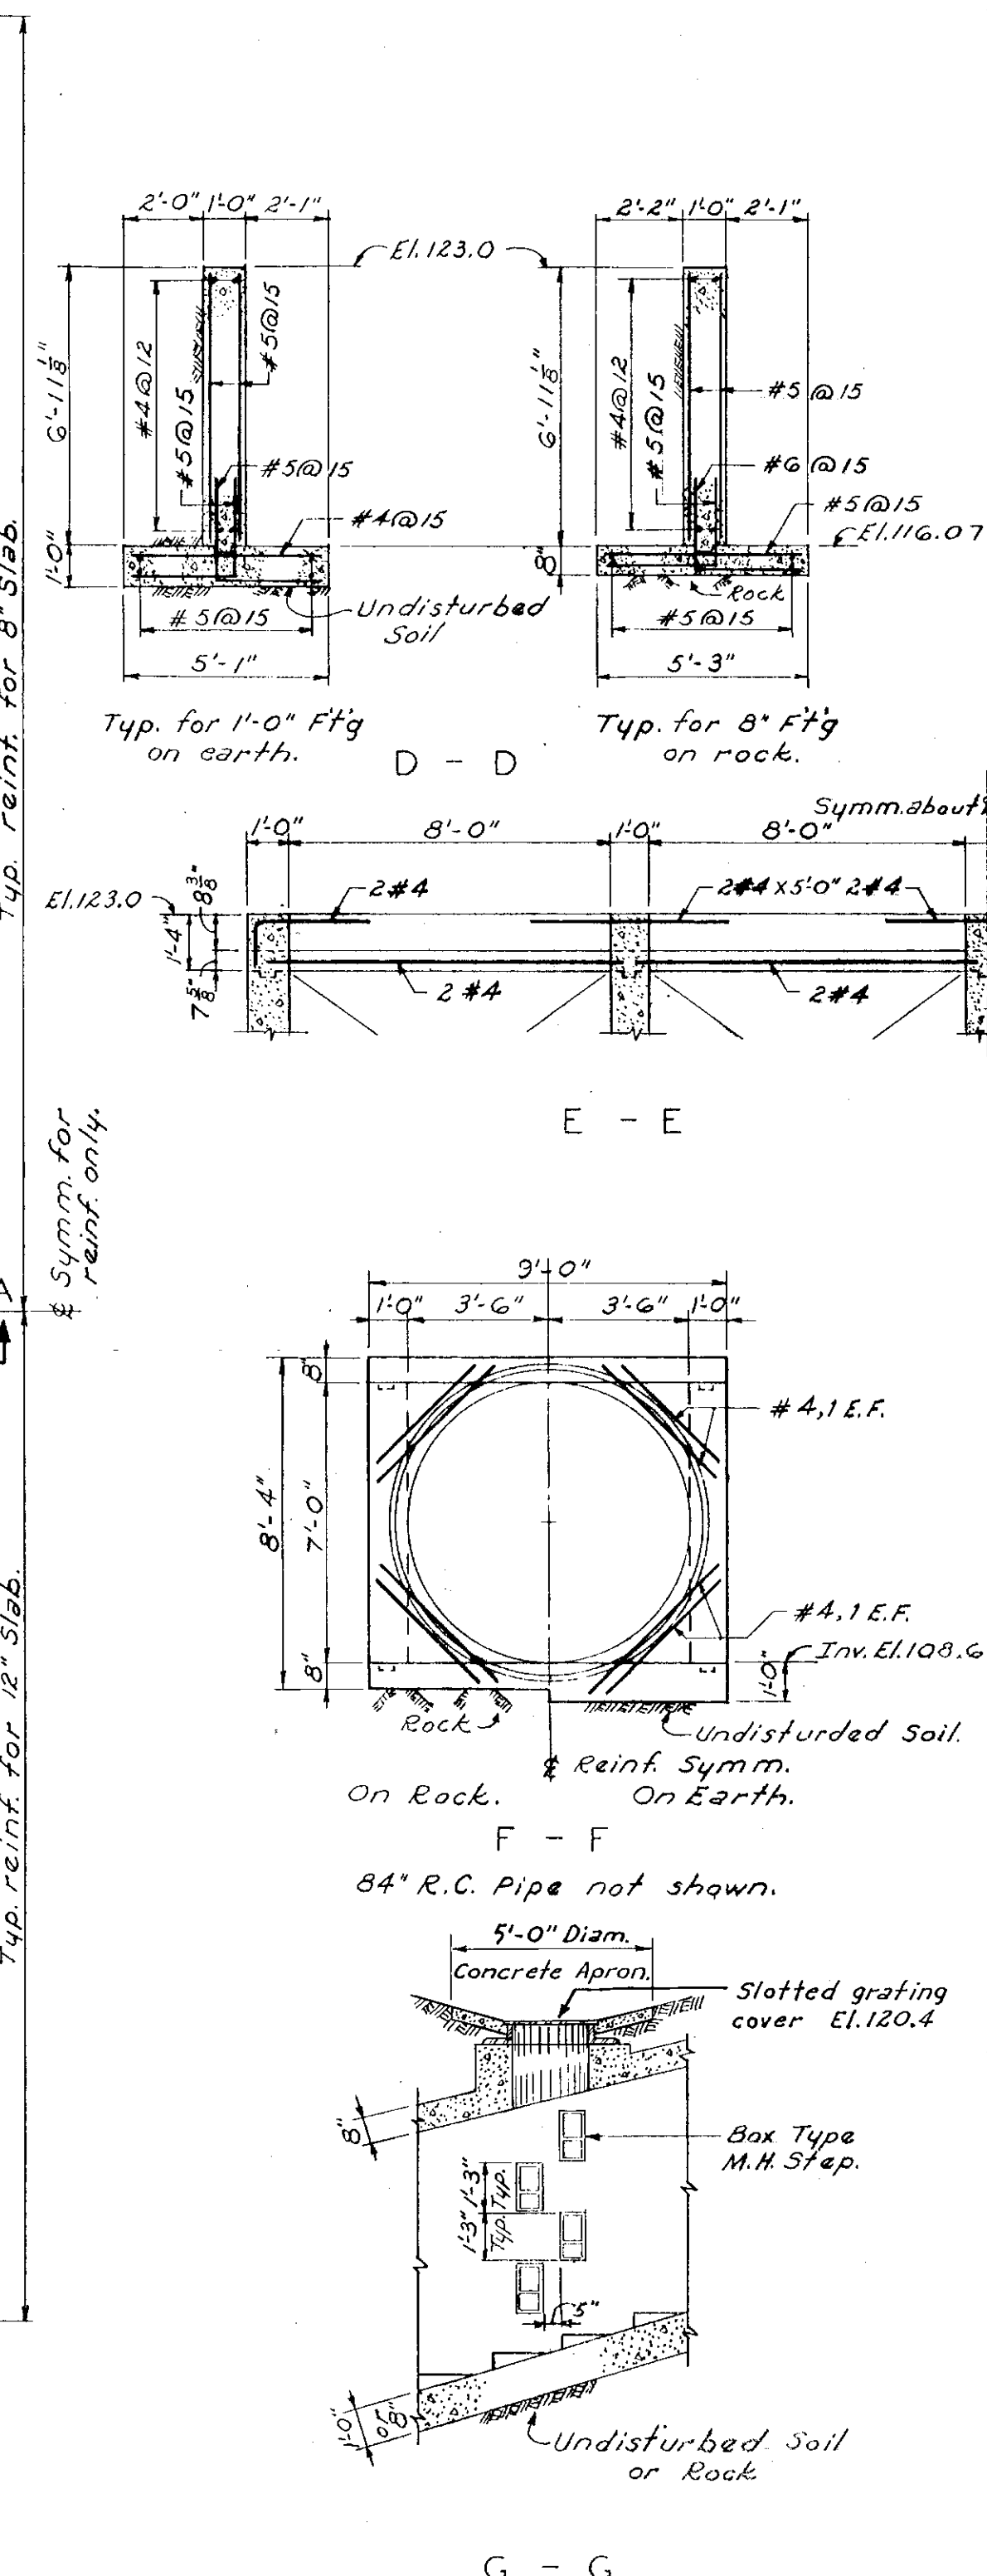
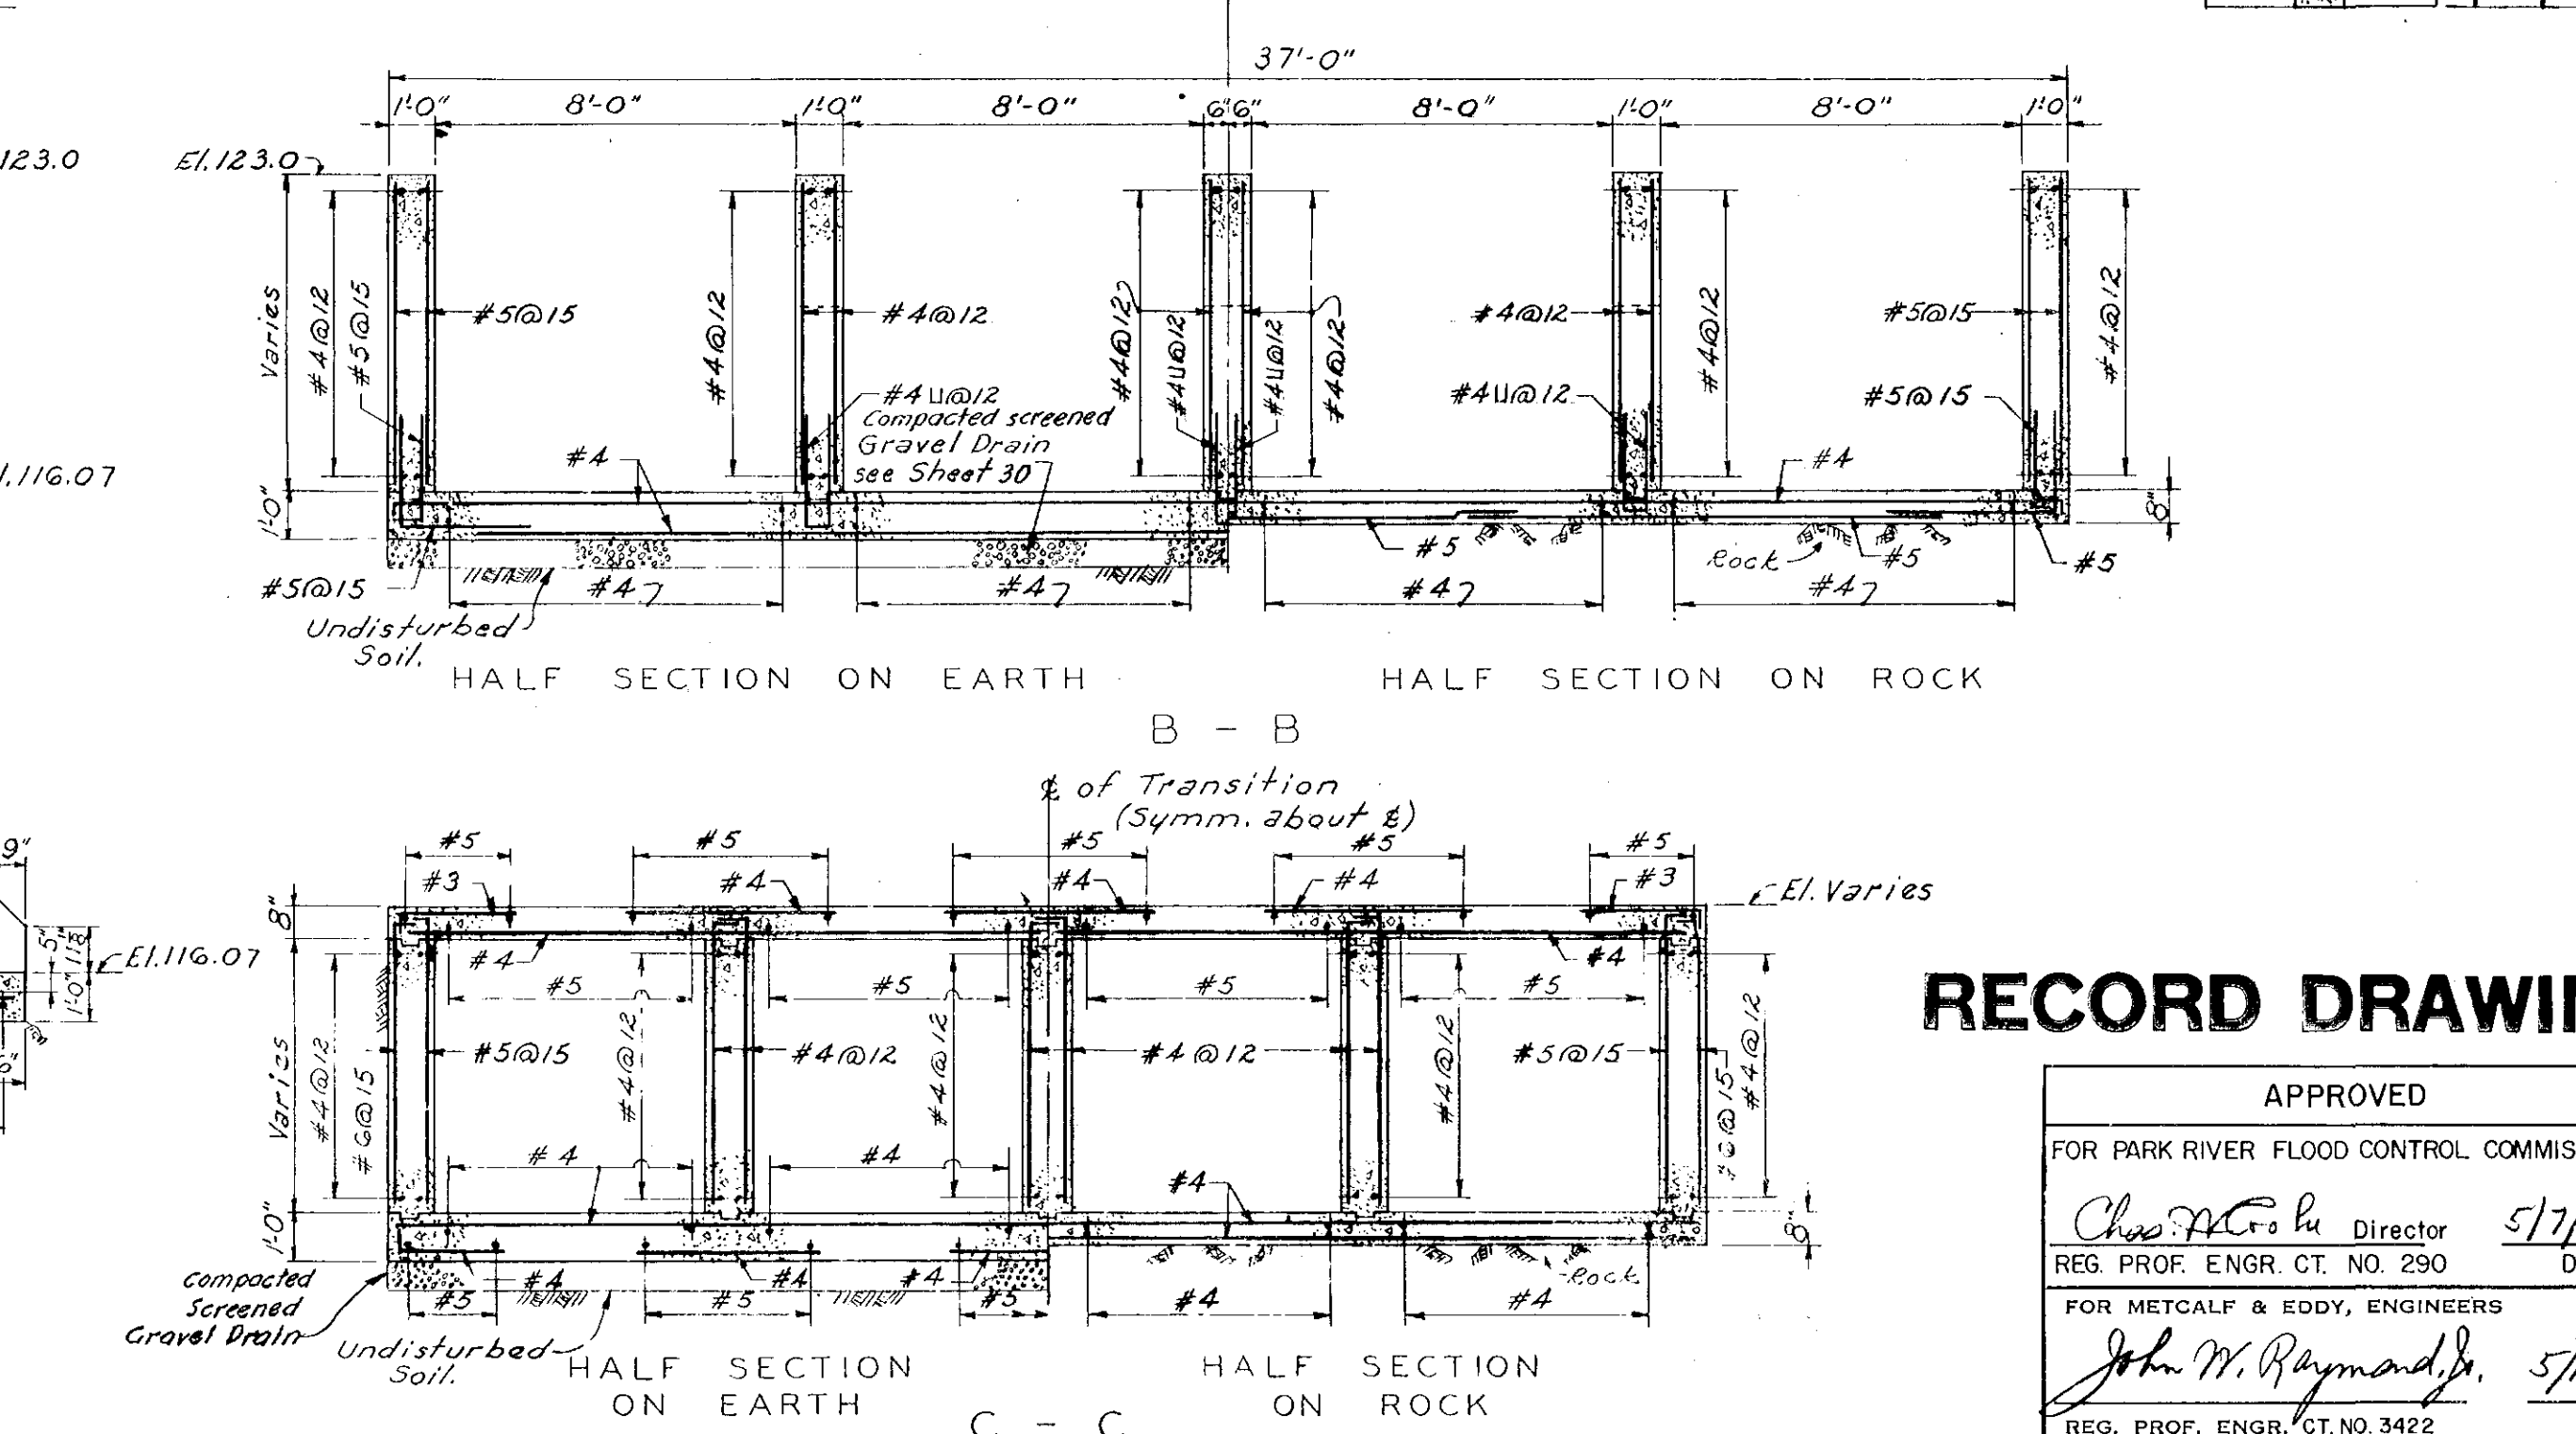
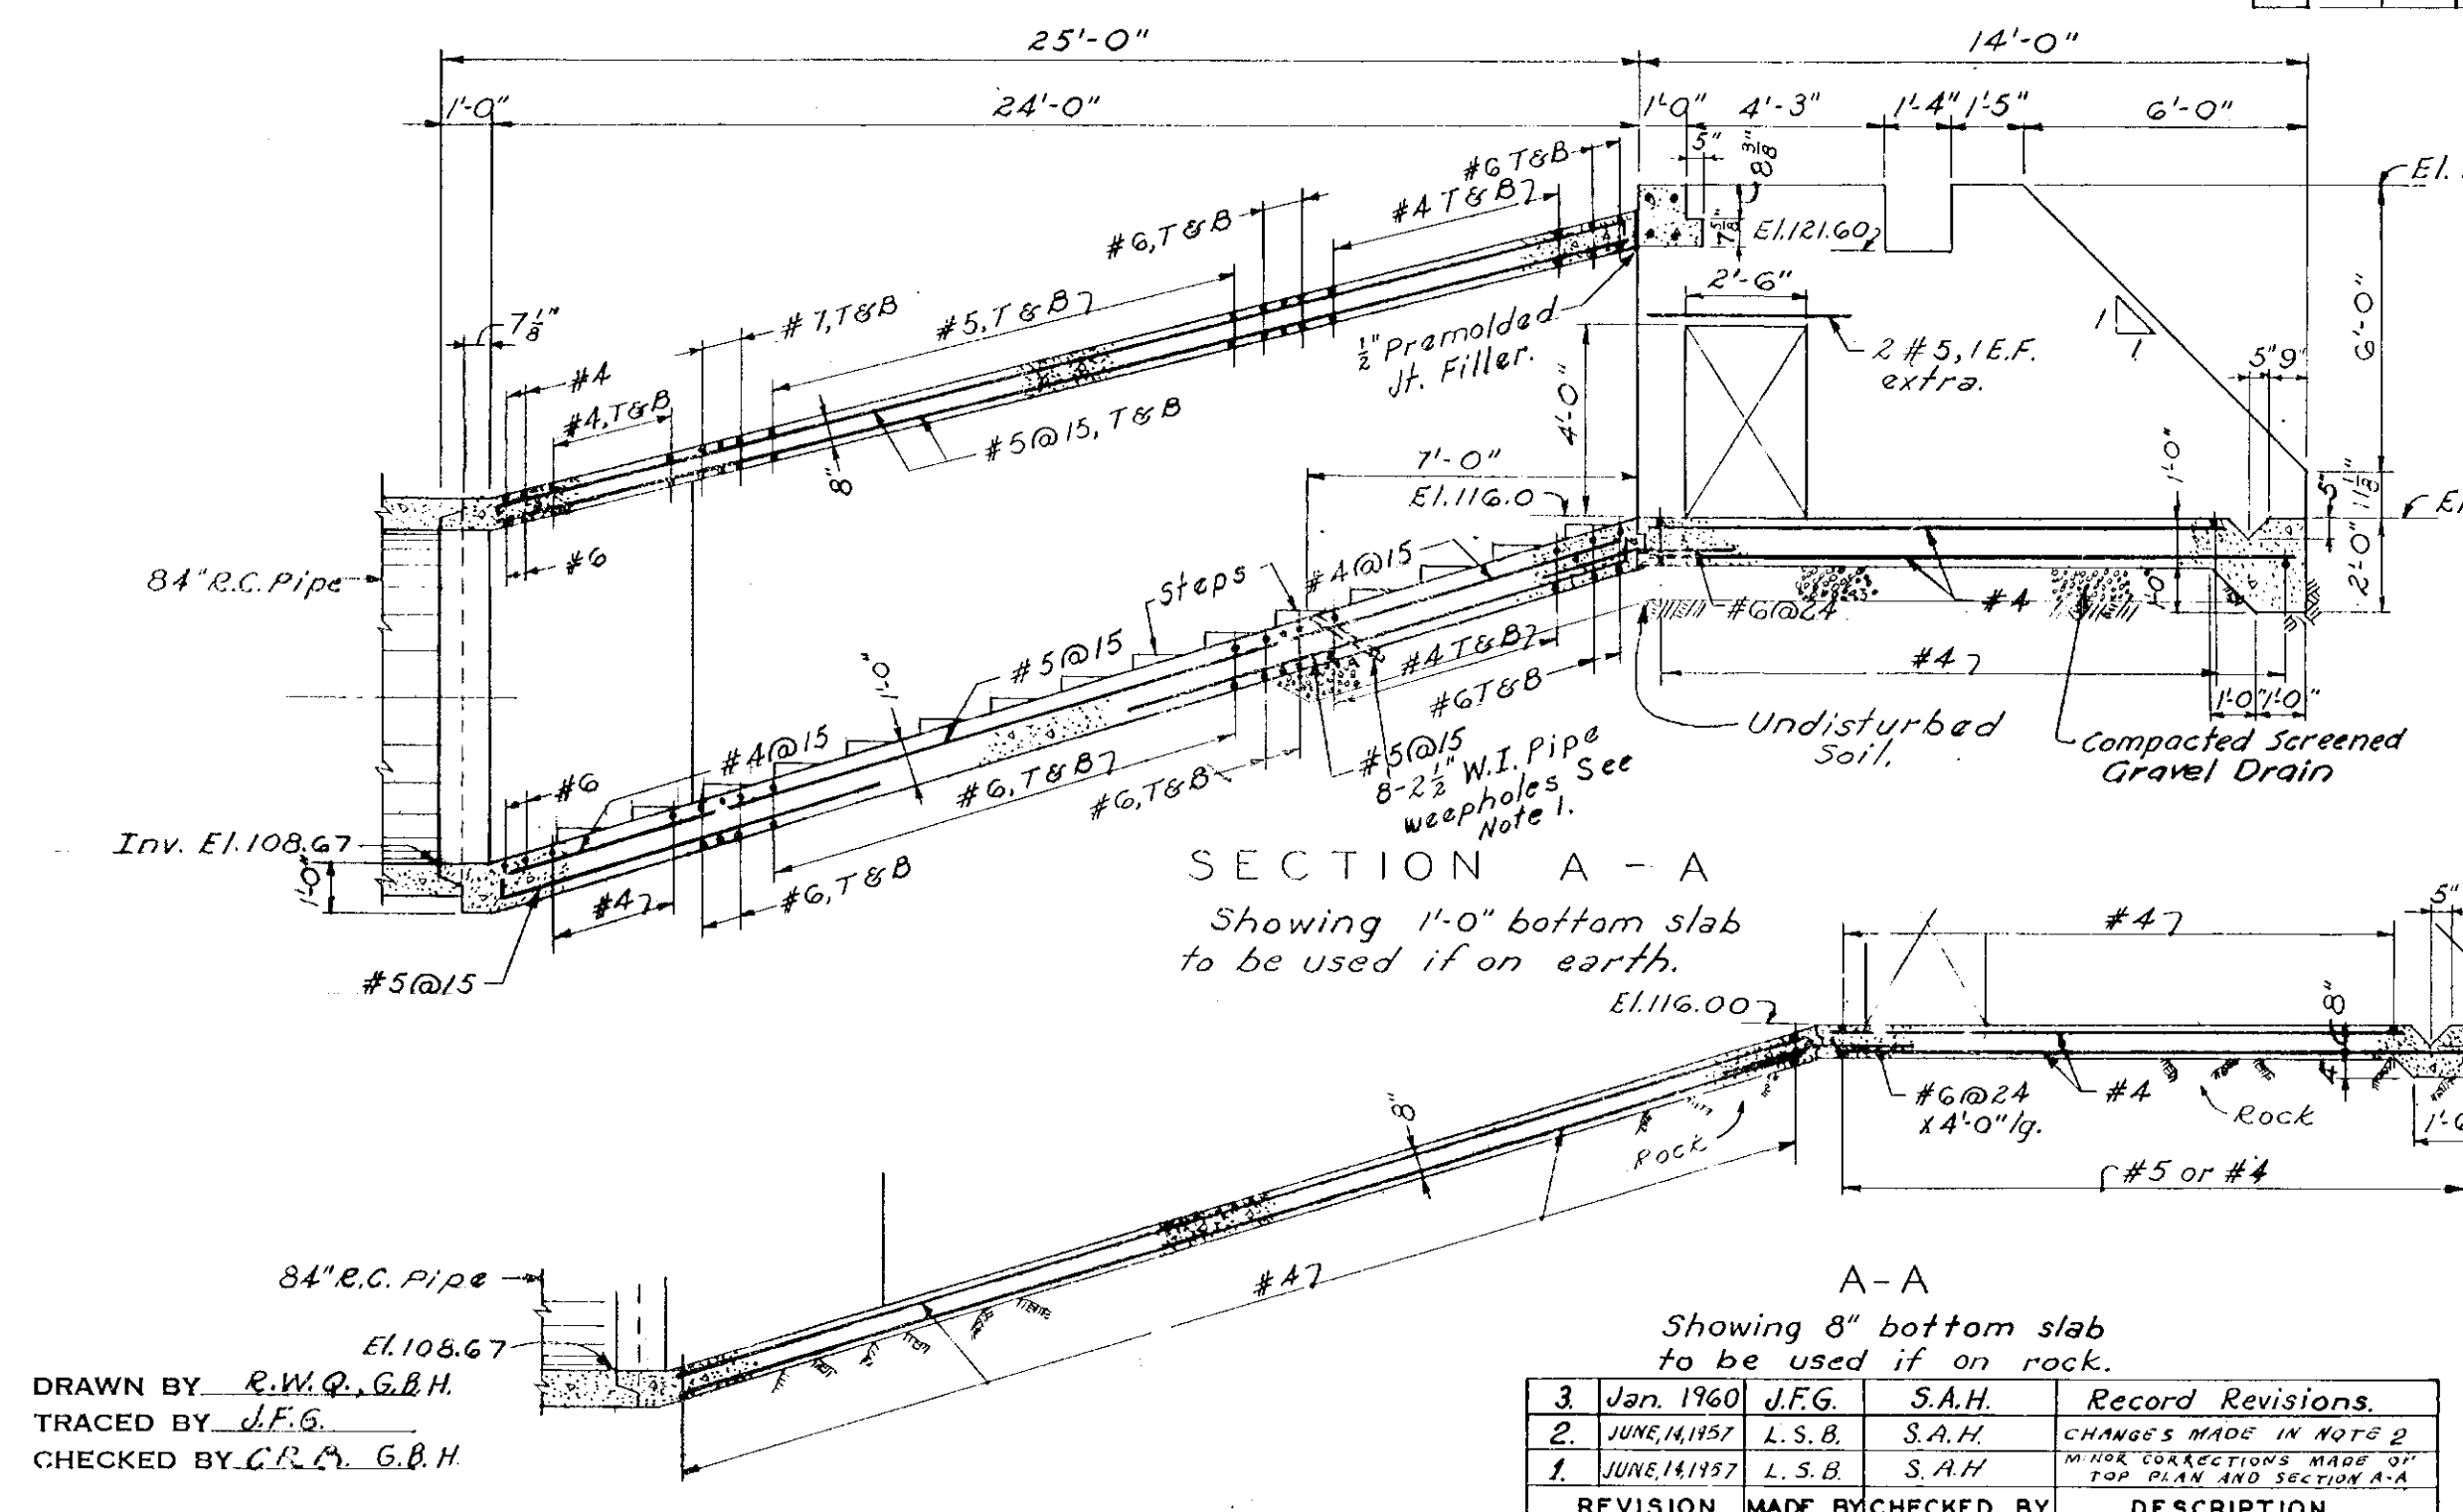
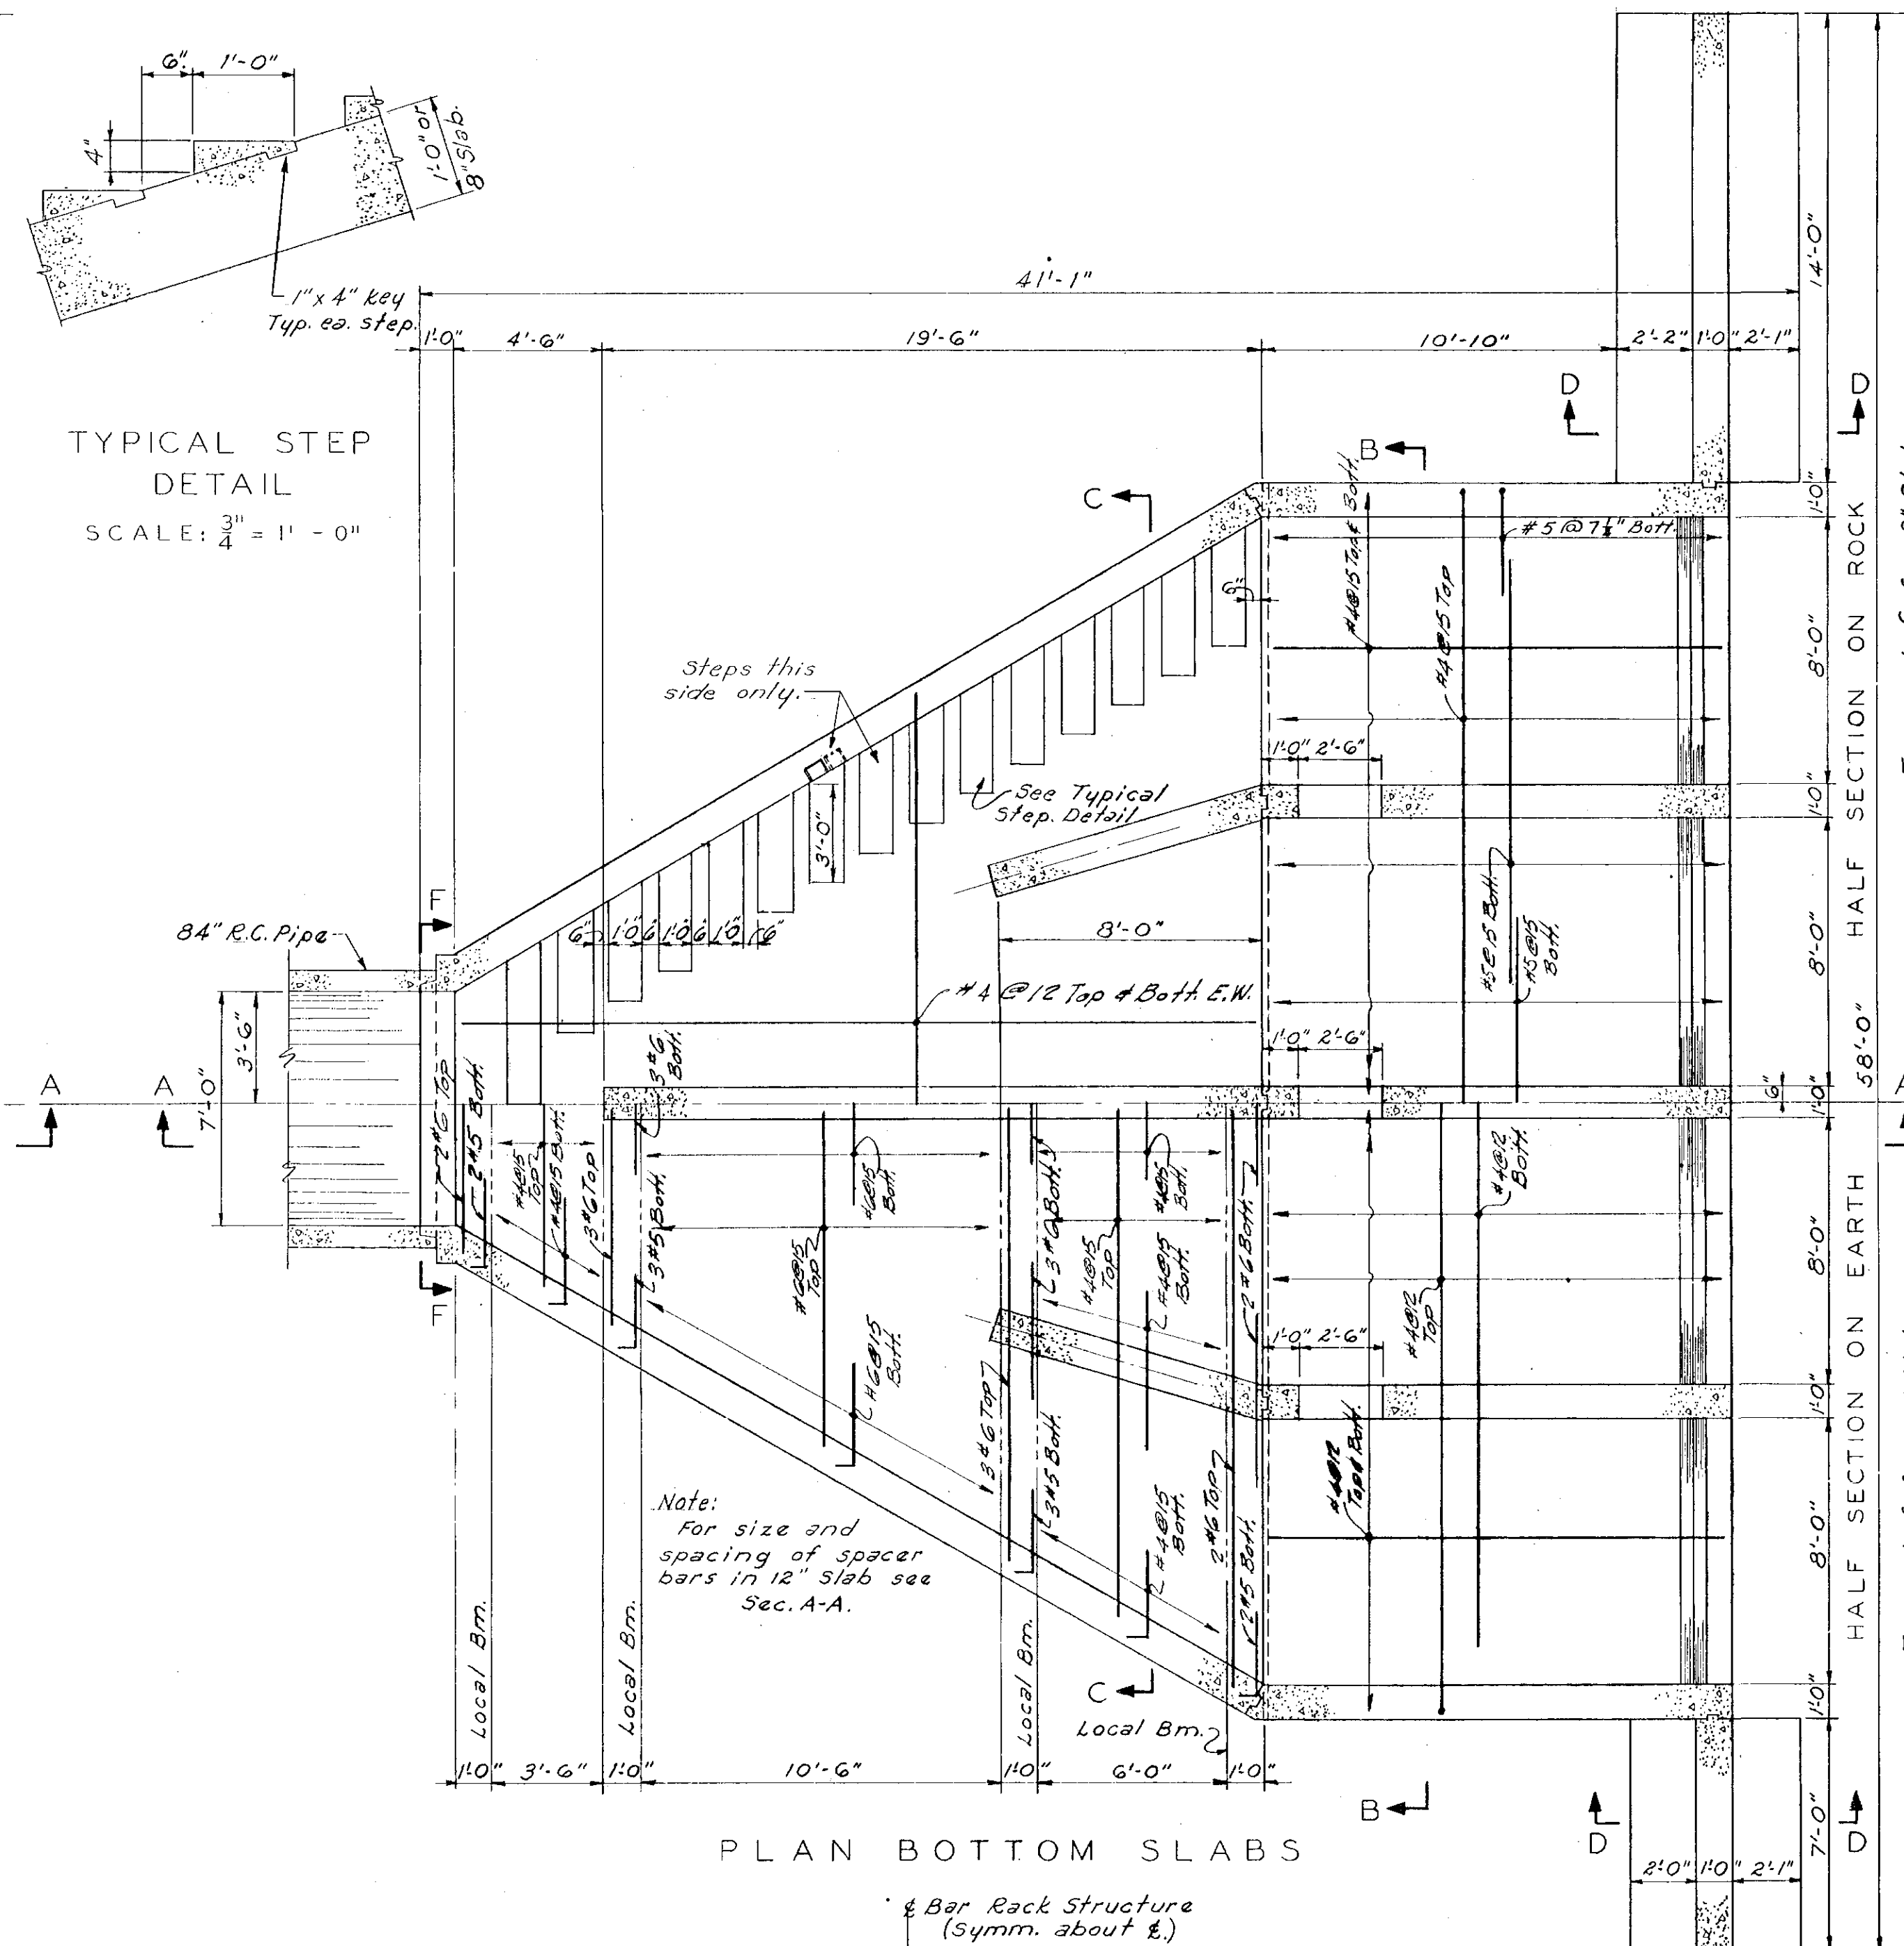


E2281
H
62206

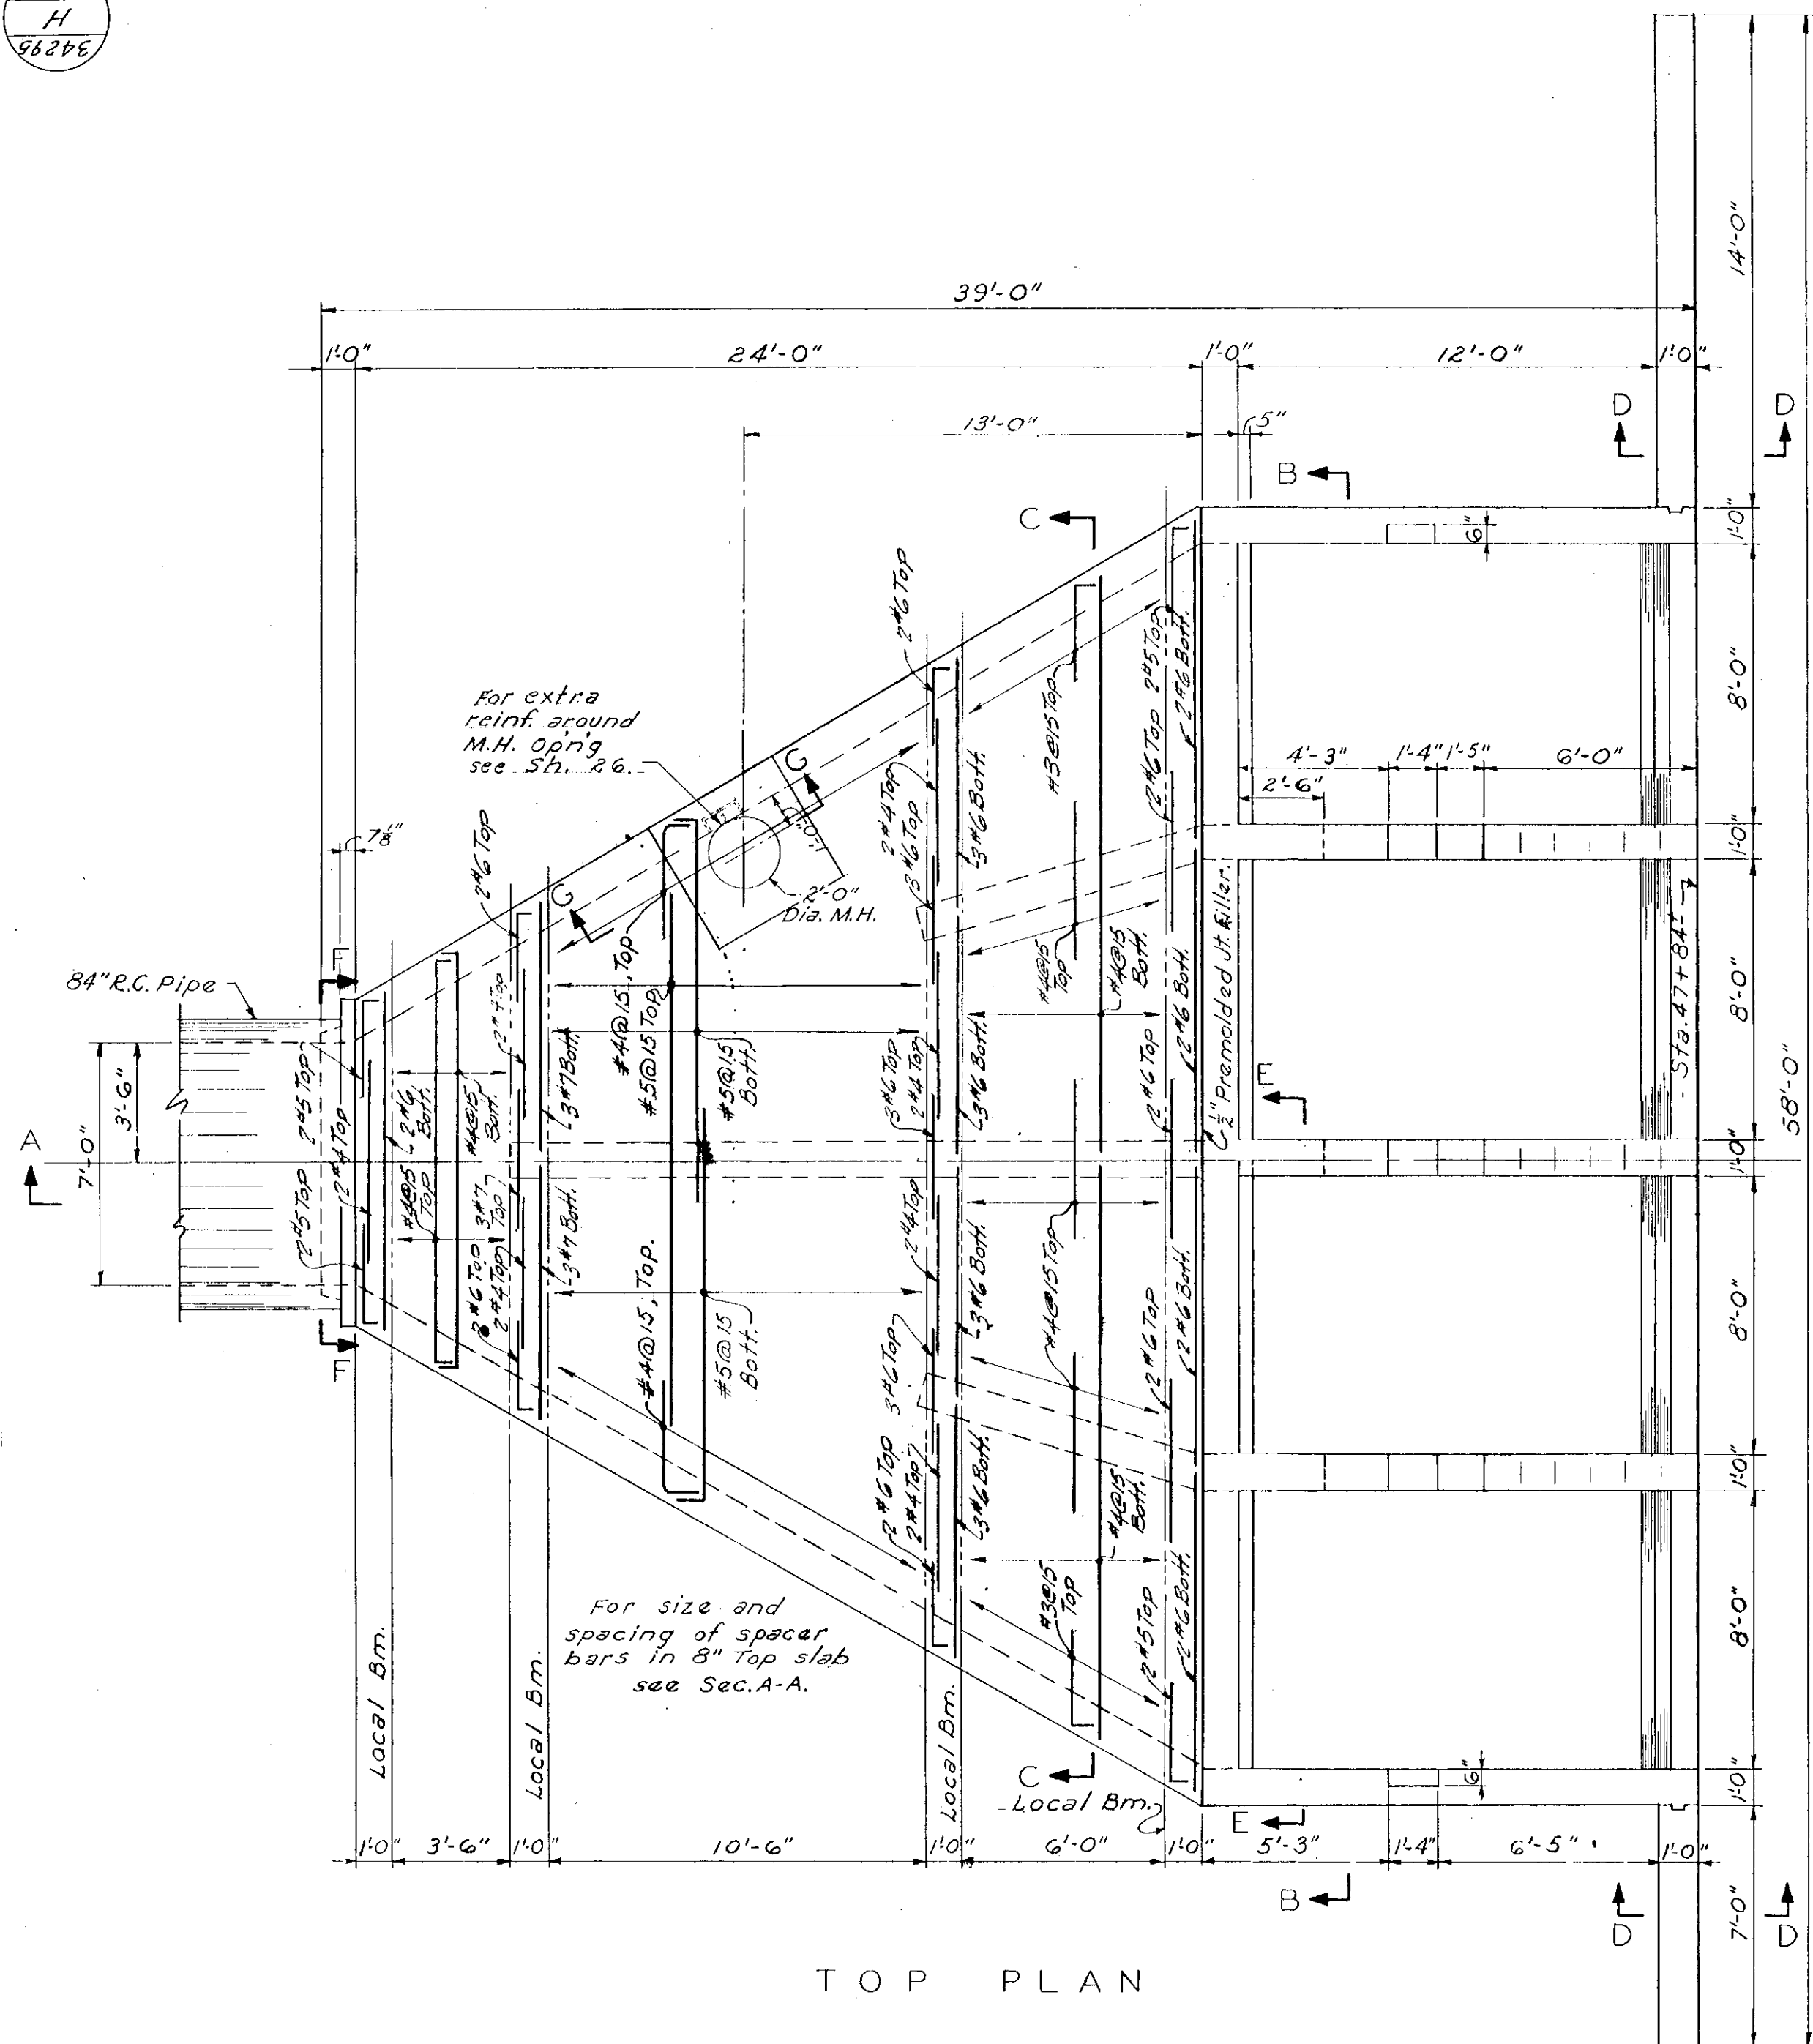

DRAWN BY R.W.G.G.B.H.
TRACED BY J.F.G.
CHECKED BY G.R.C.G.B.H.

REVISION	MADE BY	CHECKED BY	DESCRIPTION
3	Jan. 1960	J.F.G.	S.A.H.
2	JUNE 1957	L.S.B.	S.A.H.
1	JUNE 1957	L.S.B.	S.A.H.

RECORD DRAWING

APPROVED
FOR PARK RIVER FLOOD CONTROL COMMISSION
Director
REG. PROF. ENGR. CT. NO. 290
DATE 5/7/57
FOR METCALF & EDDY, ENGINEERS
John W. Raymond Jr.
REG. PROF. ENGR. CT. NO. 3422
DATE 5/10/57

PARK RIVER FLOOD CONTROL COMMISSION HARTFORD, CONNECTICUT CEMETERY BROOK CONDUIT INTAKE STRUCTURE

SCALE, 1/4" = 1'-0" MAY, 1957

METCALF & EDDY
ENGINEERS
BOSTON, MASS.

34225
H
18473