




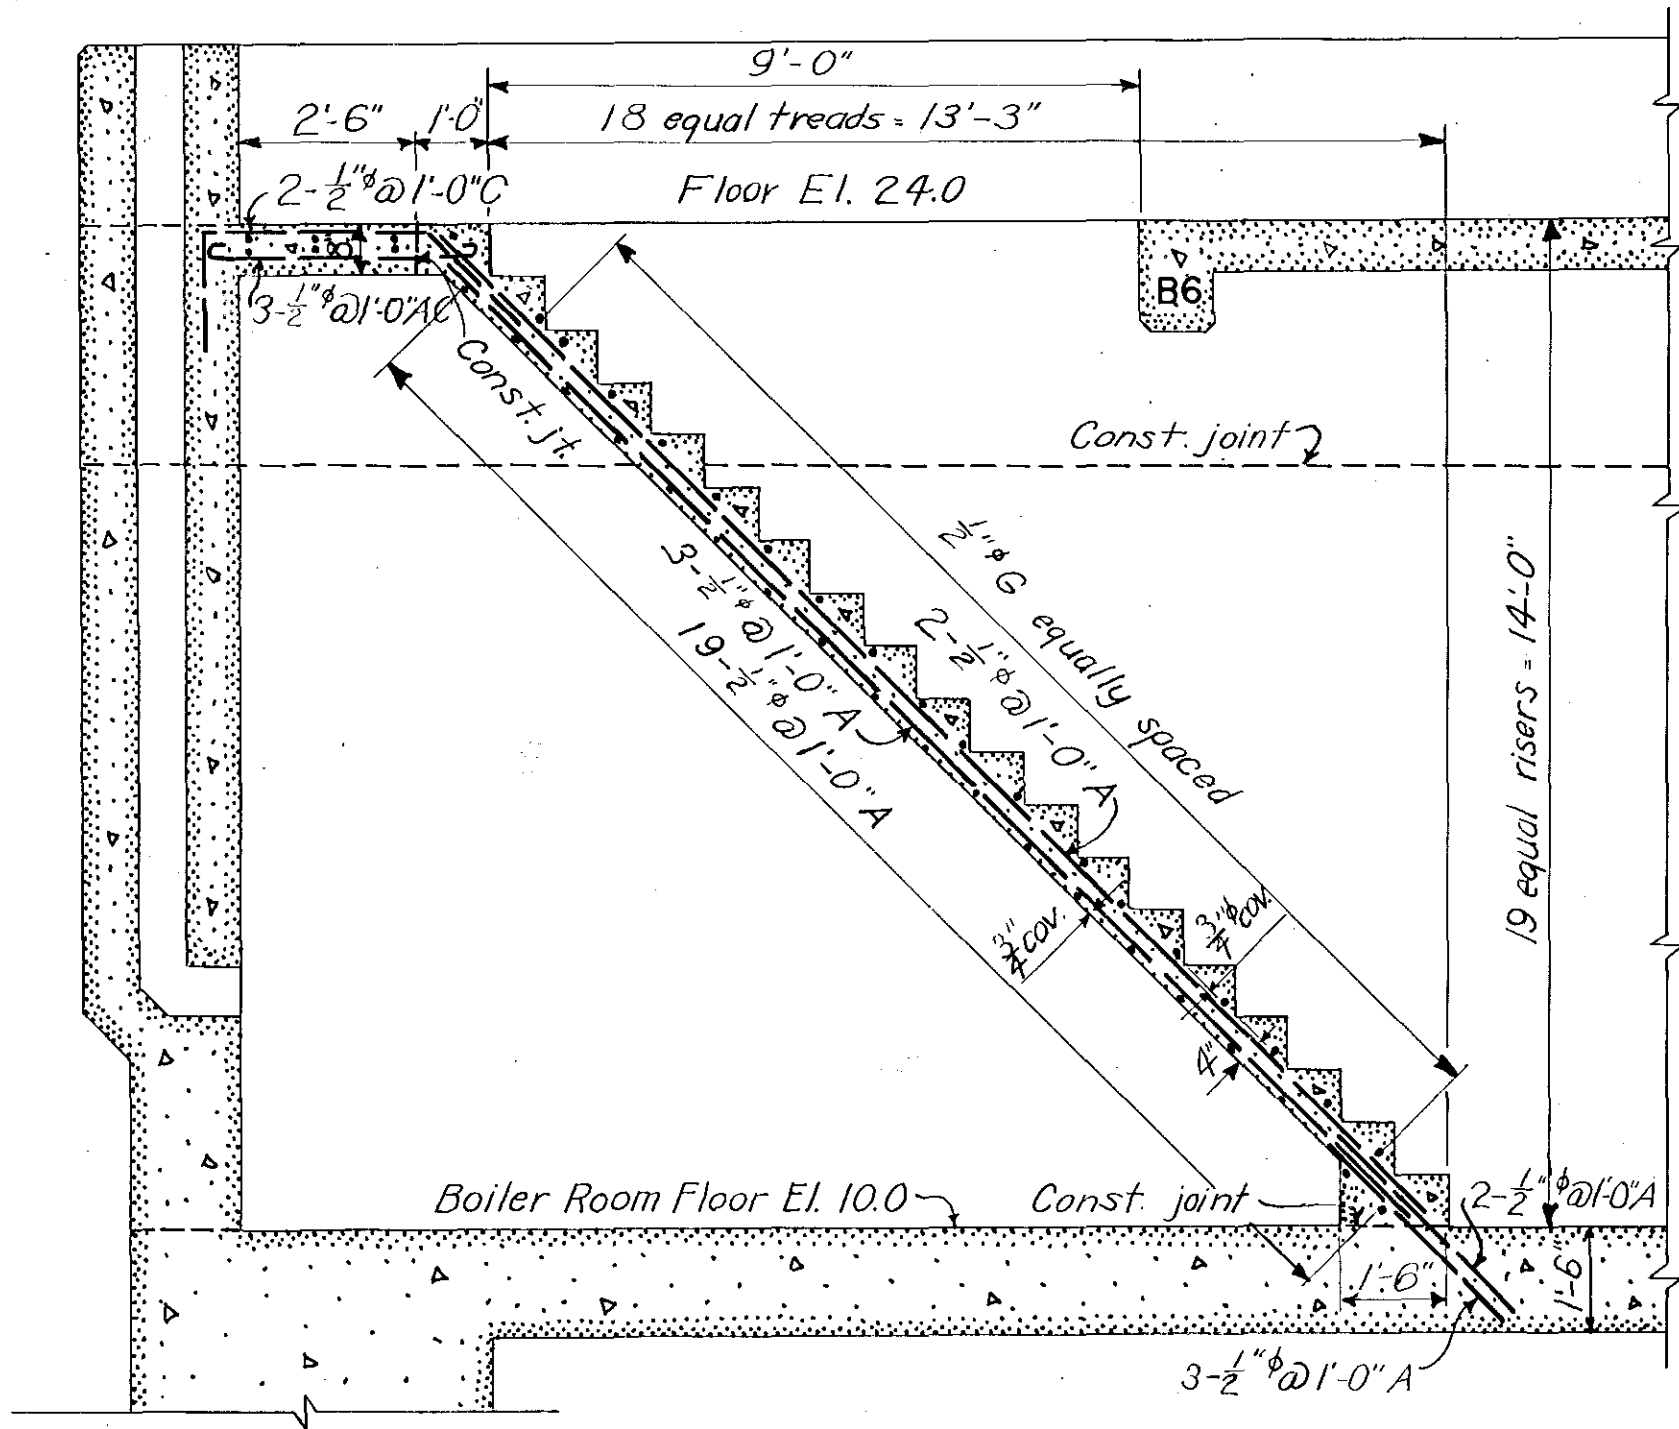


SECTION C 33
SCALE: 3/8" = 1'-0"

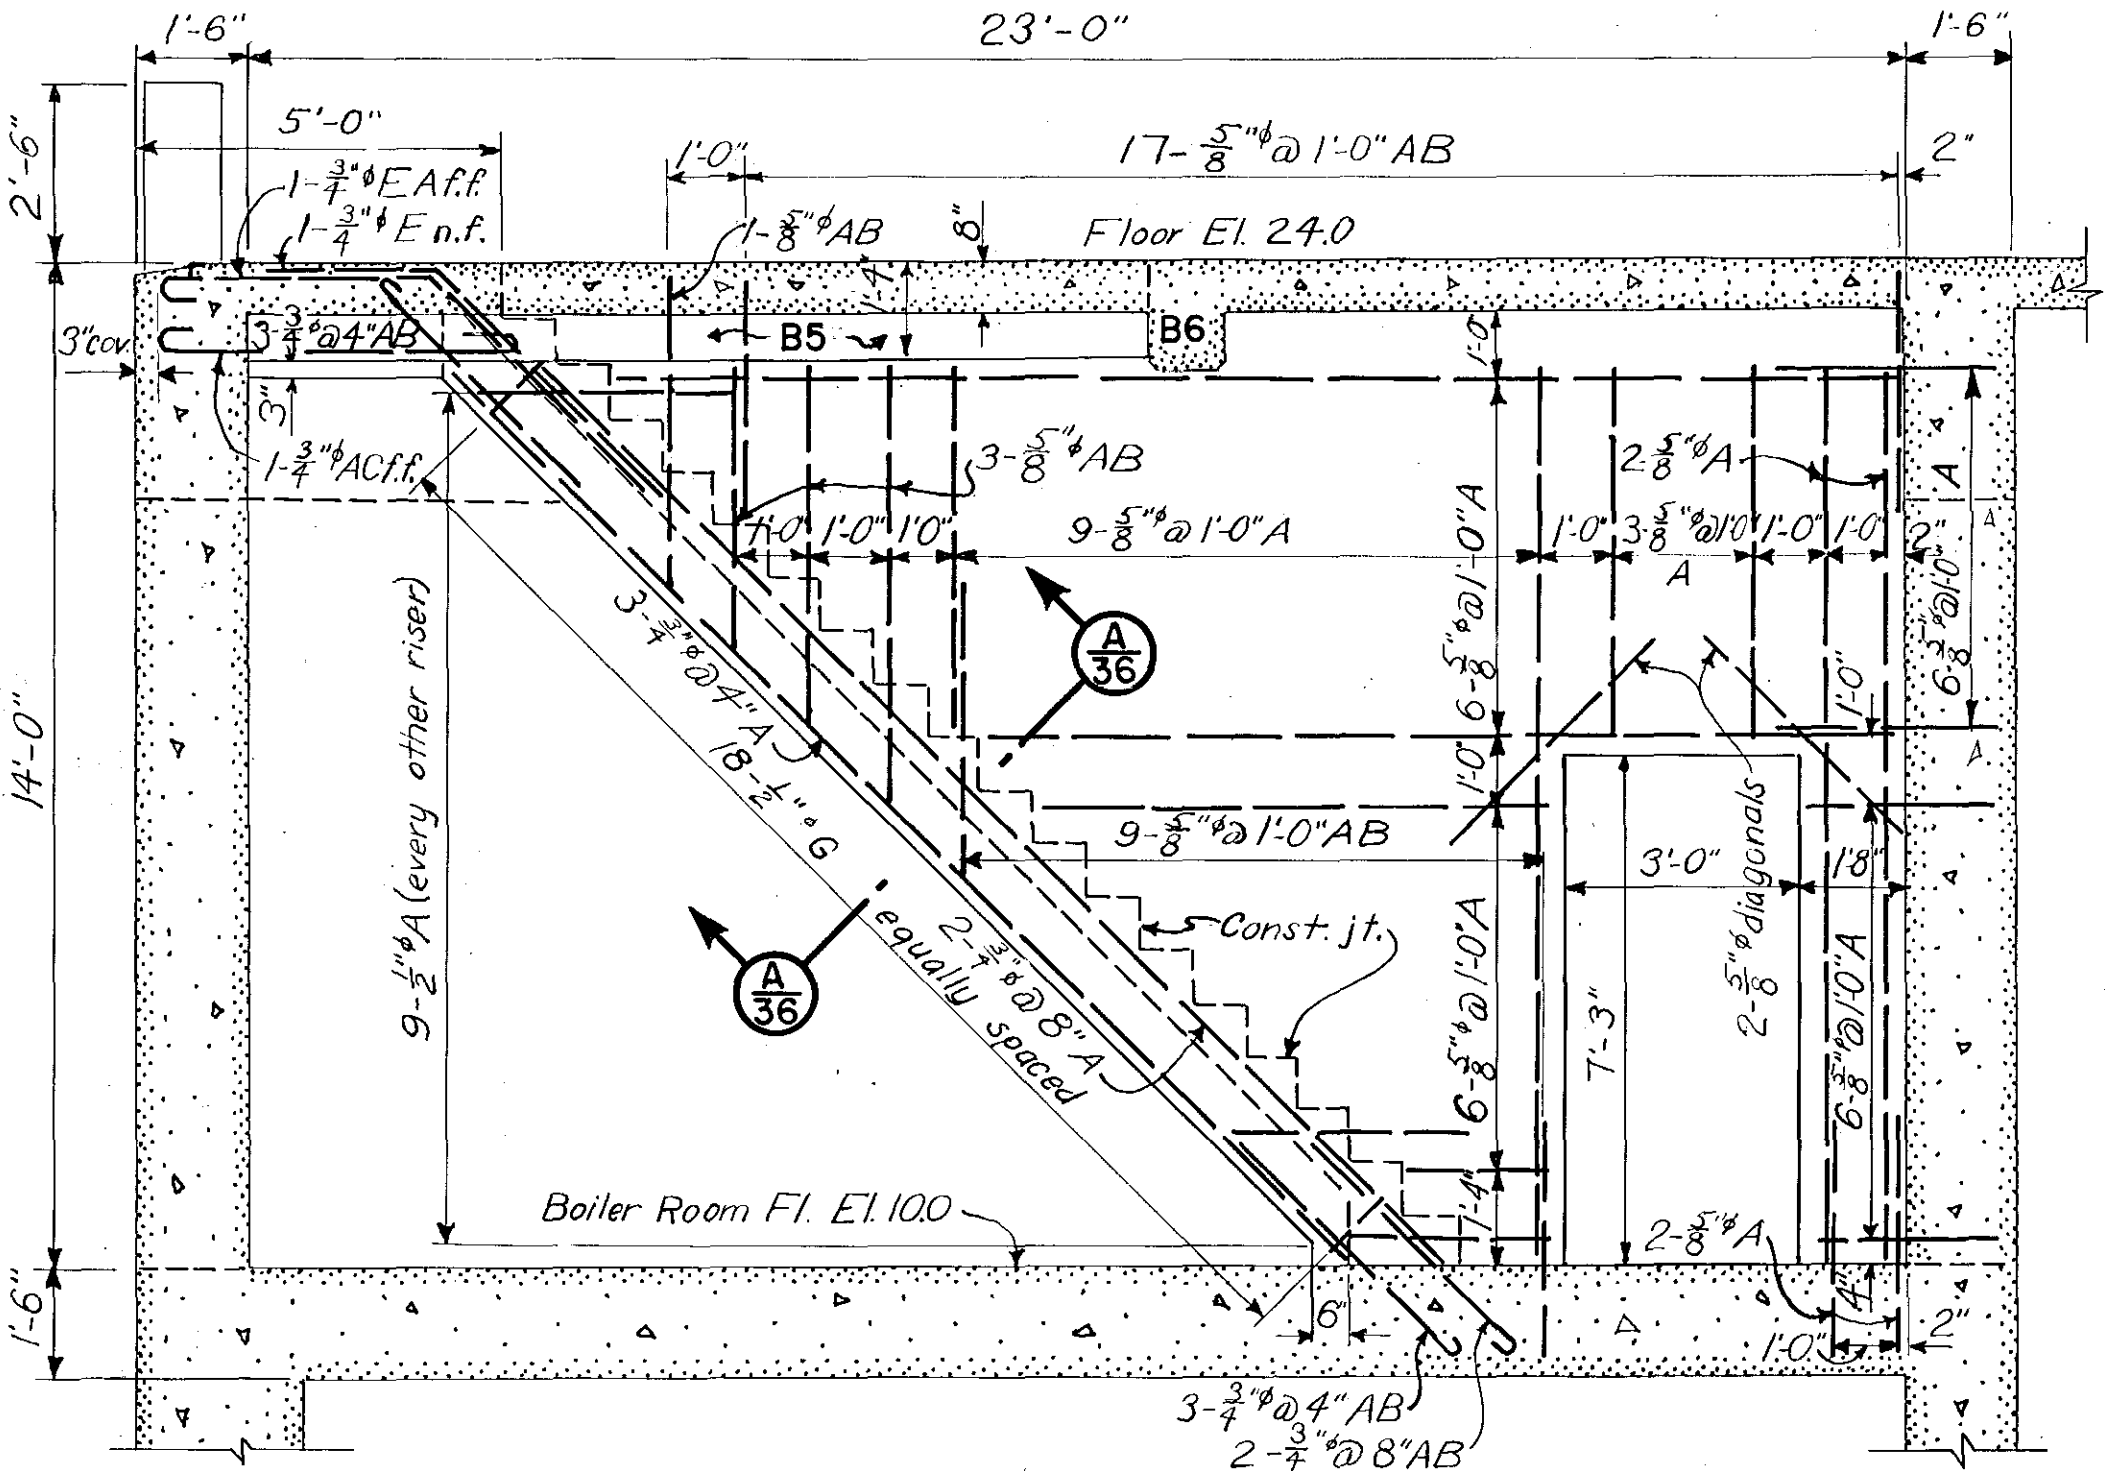


SECTION D 33
SCALE: 3/8" = 1'-0"

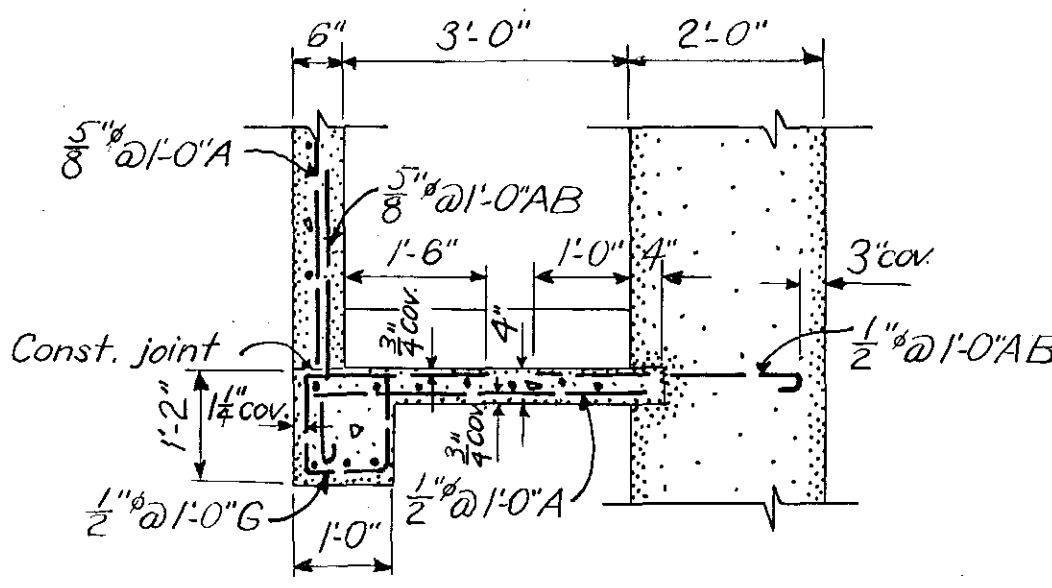


SECTION A 36
SCALE: 1/2" = 1'-0"

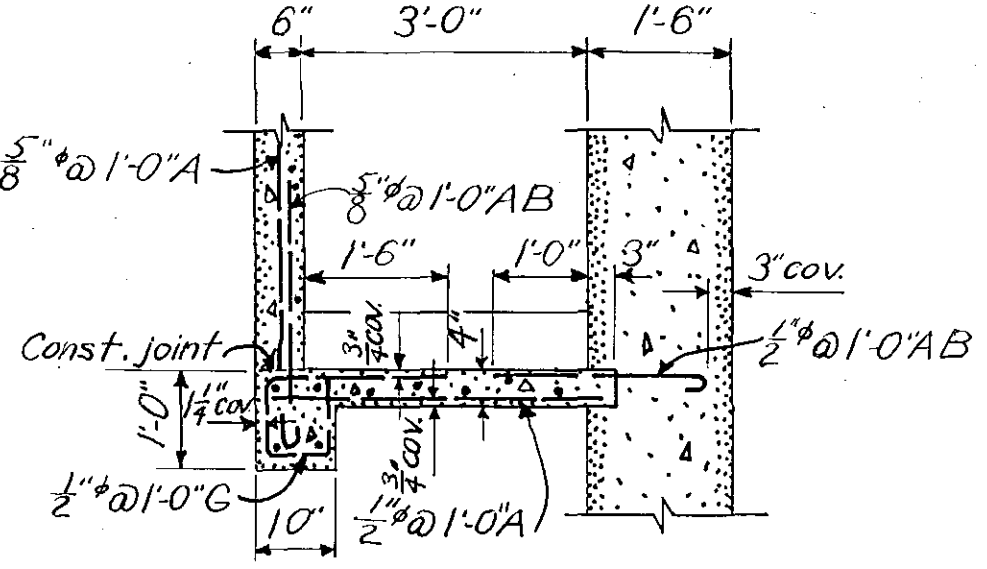

SECTION B 36
SCALE: 1/2" = 1'-0"

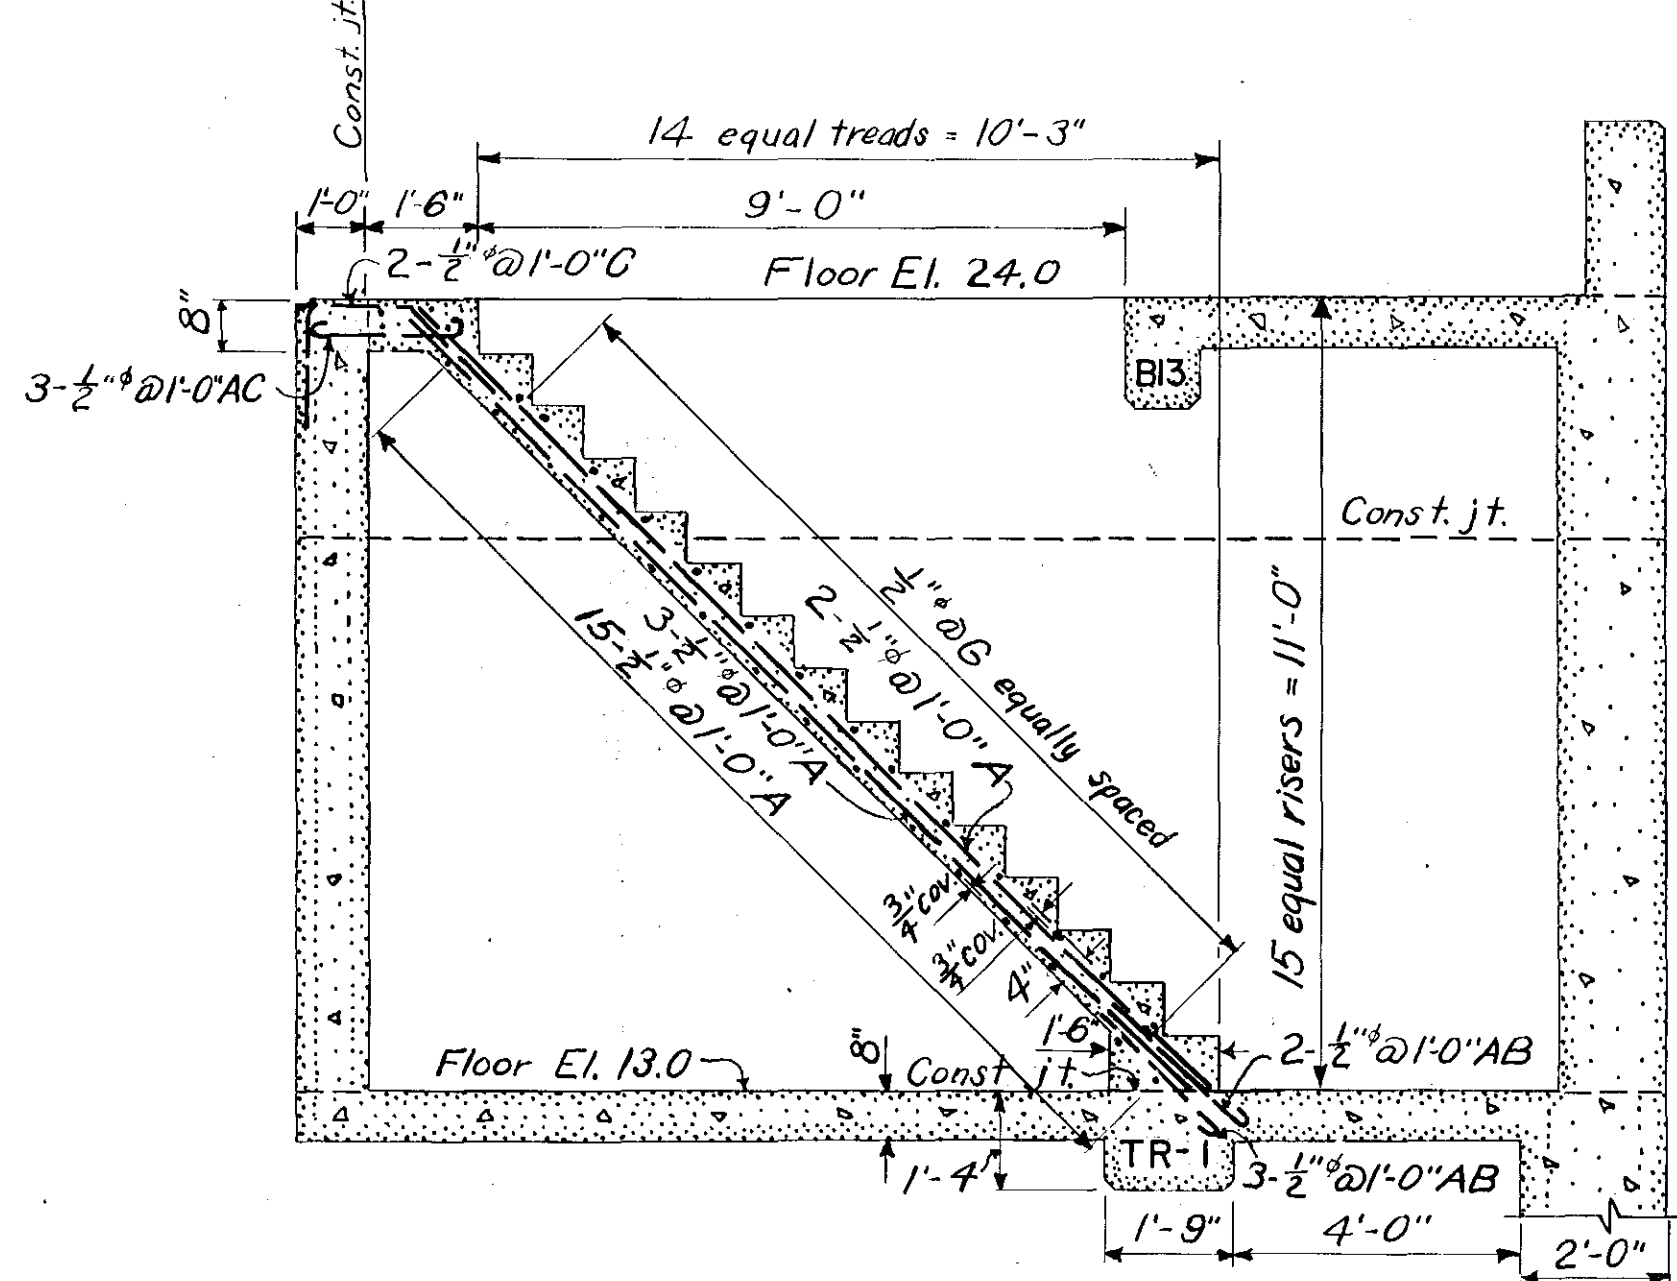

SECTION E 33
SCALE: 3/8" = 1'-0"

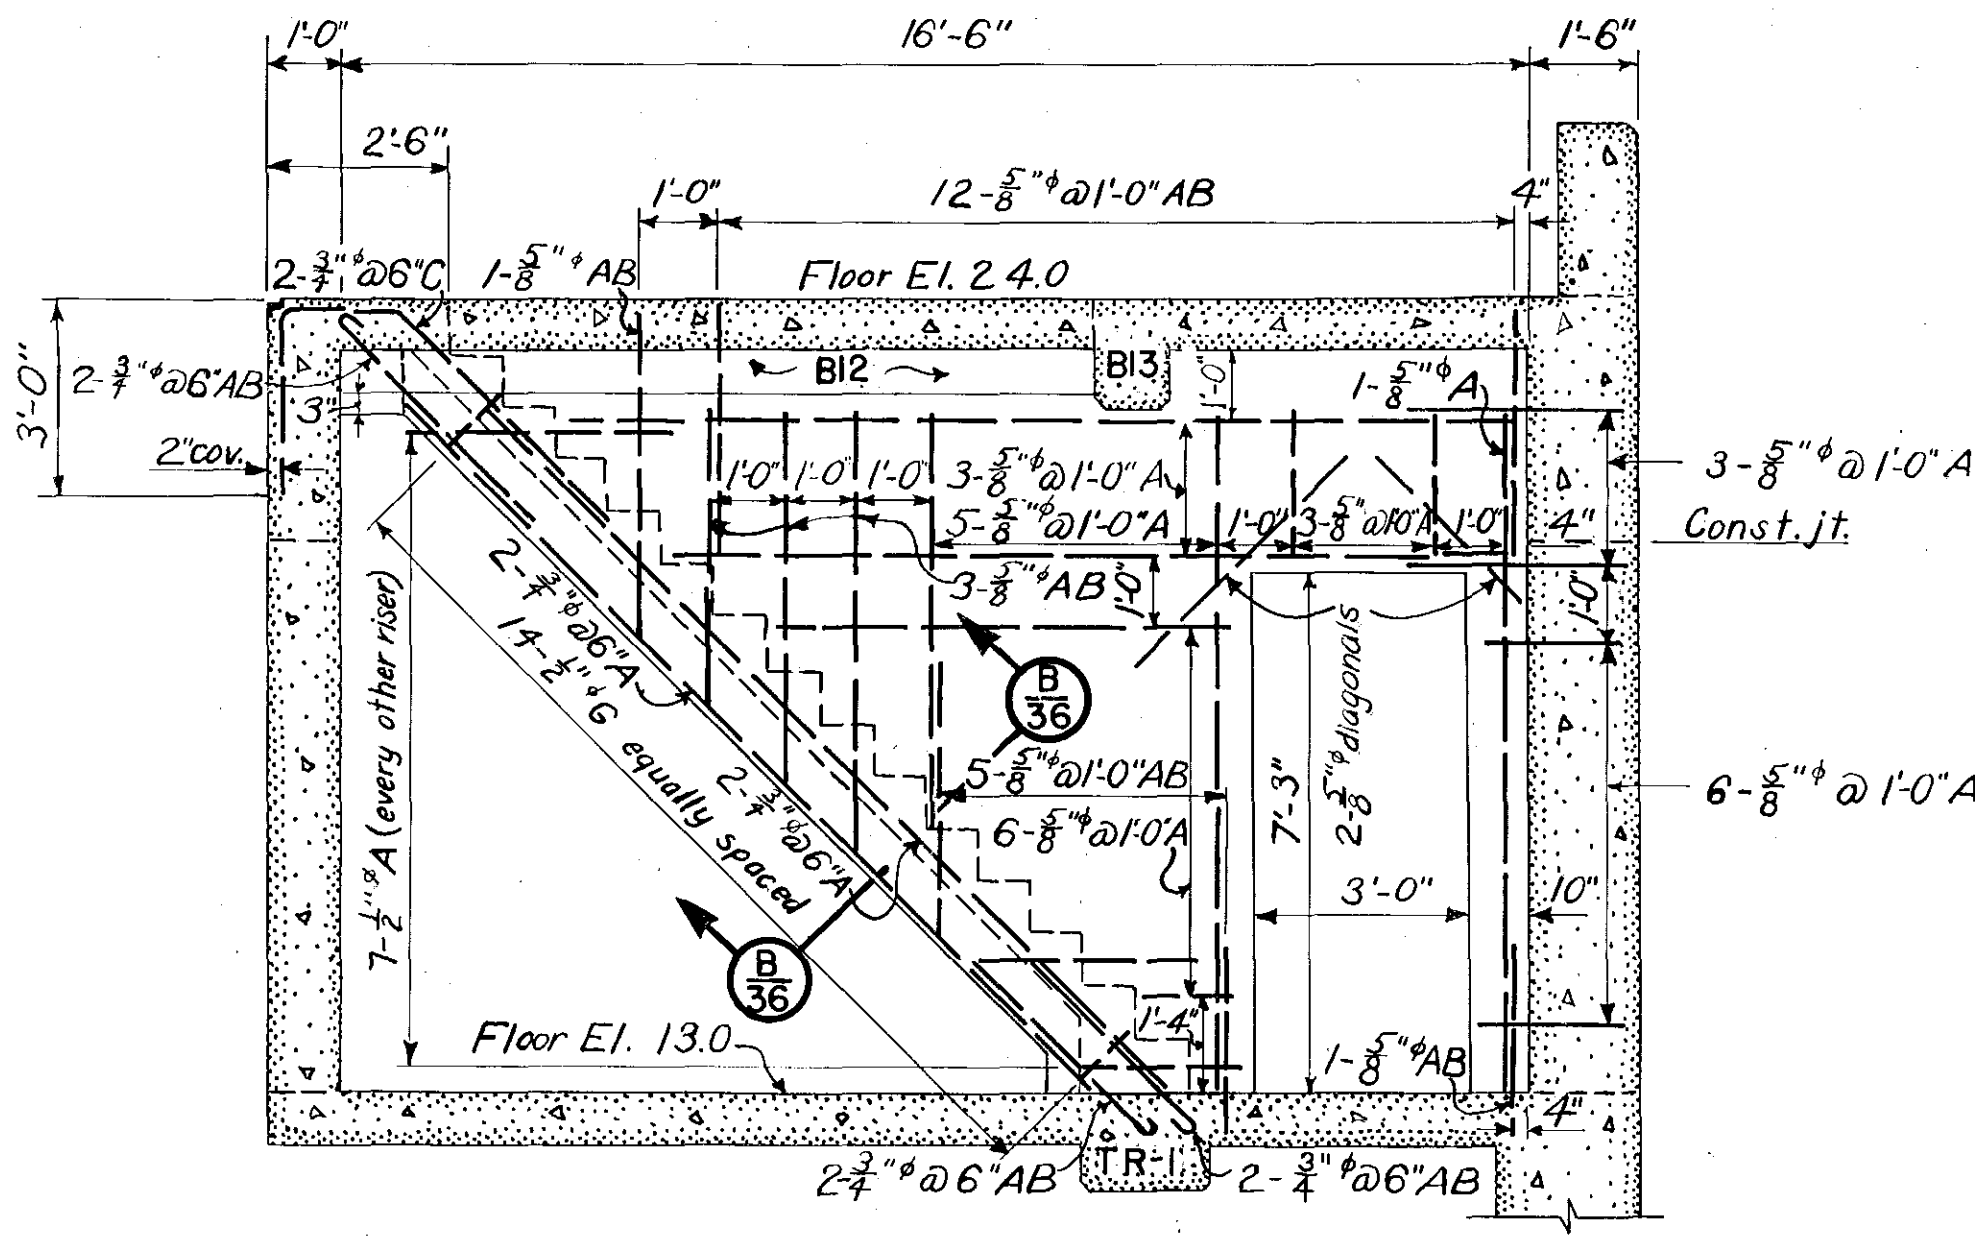

SECTION F 33
SCALE: 3/8" = 1'-0"

NOTES:
For general notes applying to this sheet, see Sheet No. 22
For steel reinforcement bending key, see Sheet No. 27

RECORD DRAWINGS

CONNECTICUT RIVER FLOOD CONTROL			
KEENEY LANE PUMPING STATION			
HARTFORD, CONNECTICUT			
CONCRETE STAIRWAY DETAILS			
CONNECTICUT RIVER	CONNECTICUT		
IN 60 SHEETS	SCALE: 3/8 IN. = 1 FT.	SHEET NO. 36	
U.S. ENGINEER OFFICE, PROVIDENCE, R.I., JUNE 1944			
SUBMITTED: E. M. Viner HEAD, STRUCTURAL SECTION	APPROVAL RECOMMENDED: H. J. Burns HEAD ENGINEER CHIEF, ENGINEERING DIVISION	APPROVED: H. J. Burns CHIEF, CORPS OF ENGINEERS DISTRICT ENGINEER	
PREPARED: J. C. Whittemore STRUCTURAL SUBSECTION	DRAWN: N. I. CHECKED: G. L. K.	FILE NO. CT-4-3250	

KEY	DATE	REVISION	(Indicated by Δ)	REV. BY	CK. BY	AP. BY