



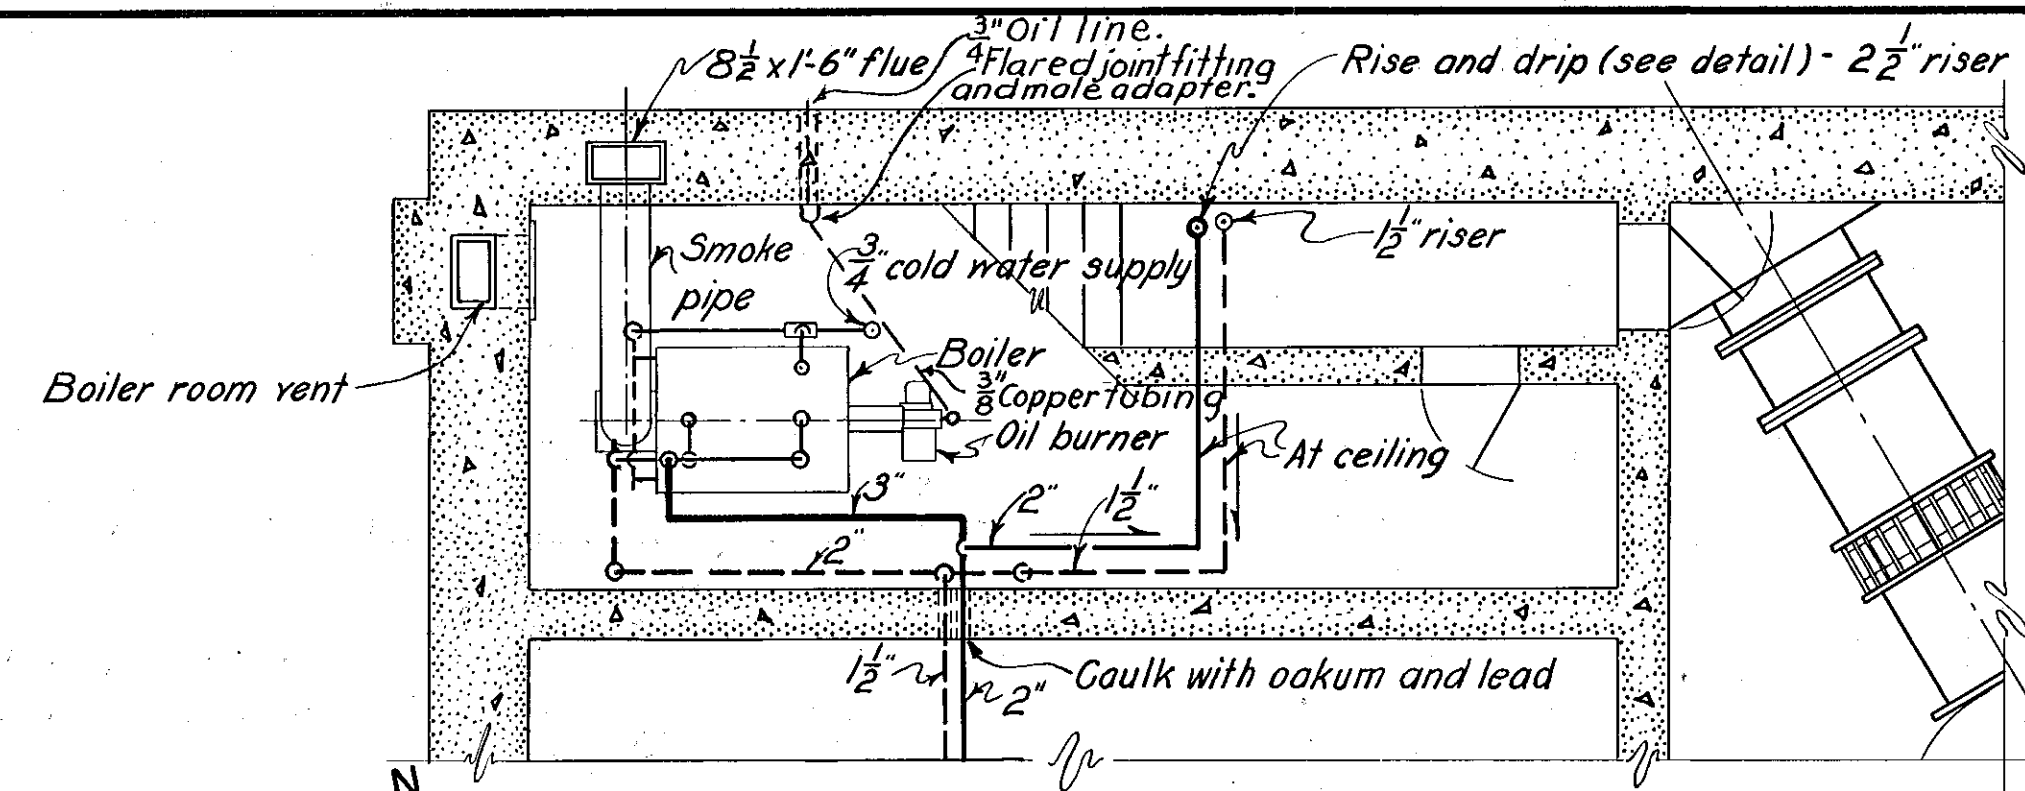


BOILER ROOM PLAN

SCALE 1/4" = 1'-0"

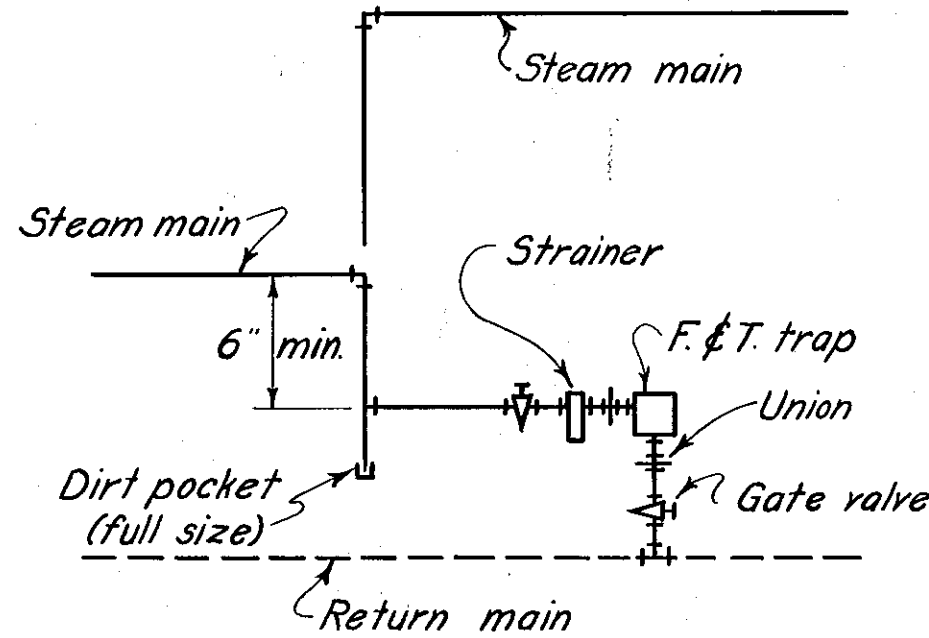


TYPICAL RISE AND DRIP OR DRIP ON ENDS OF STEAM MAIN

NOT TO SCALE

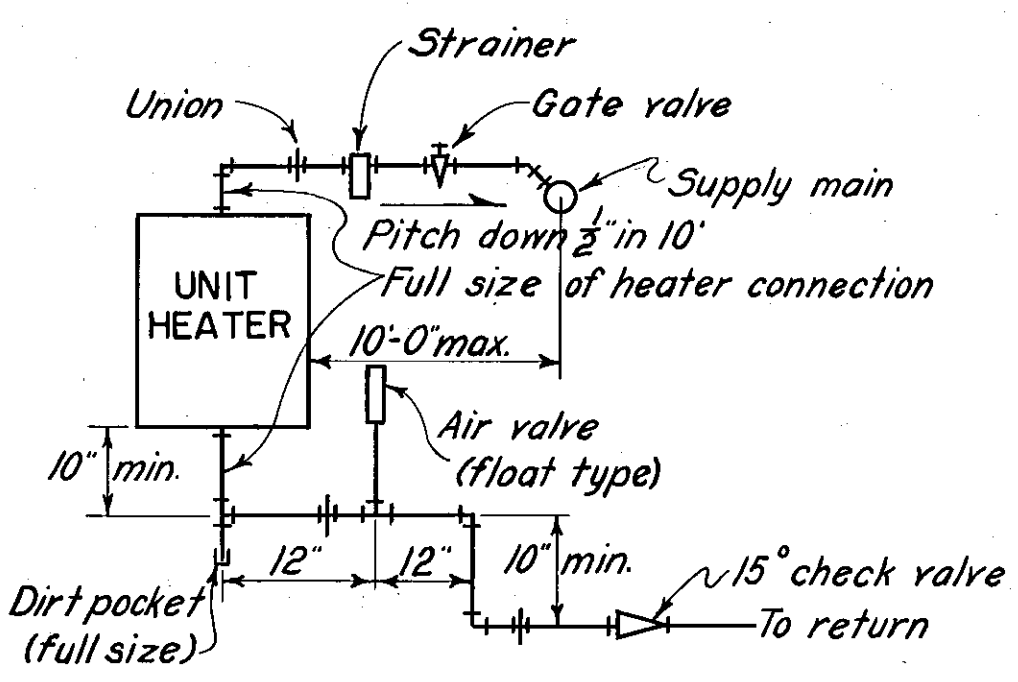

TYPICAL UNIT HEATER CONNECTION

NOT TO SCALE

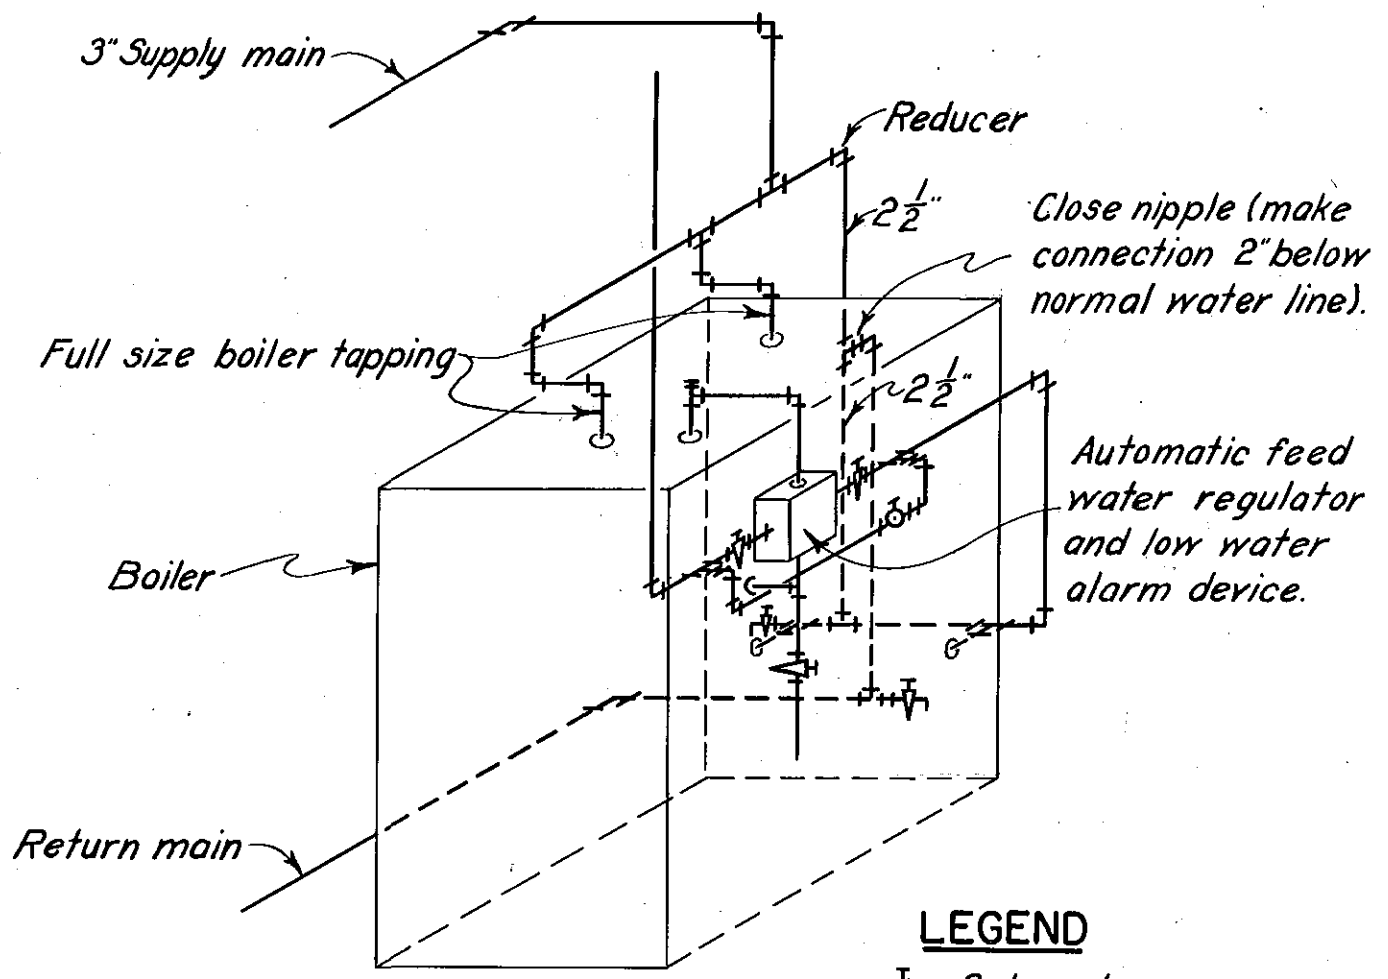


DETAIL OF BOILER CONNECTIONS

NOT TO SCALE

UNIT HEATER SCHEDULE				
NO	REG'D	TYPE	CAPACITY B.T.U. / HR.	PRESSURE ENTERING AIR
6		Horizontal	51,000	2" 60°F.

NOTES:
Piping is shown diagrammatically; the exact location was determined in the field.
All piping through floors and walls is set in sleeves.
Piping has continuous pitch down in direction indicated by arrows.
All supply and return piping was insulated as specified.
Piping is arranged to permit draining the entire system.
Piping is supported by hangers spaced at approximately 8 foot intervals.
Heating boiler is of the cast iron, sectional, oil fired type having a minimum net load capacity of 1250 square foot.
Furnishing and installing heating system were paid for under Item No. 16.

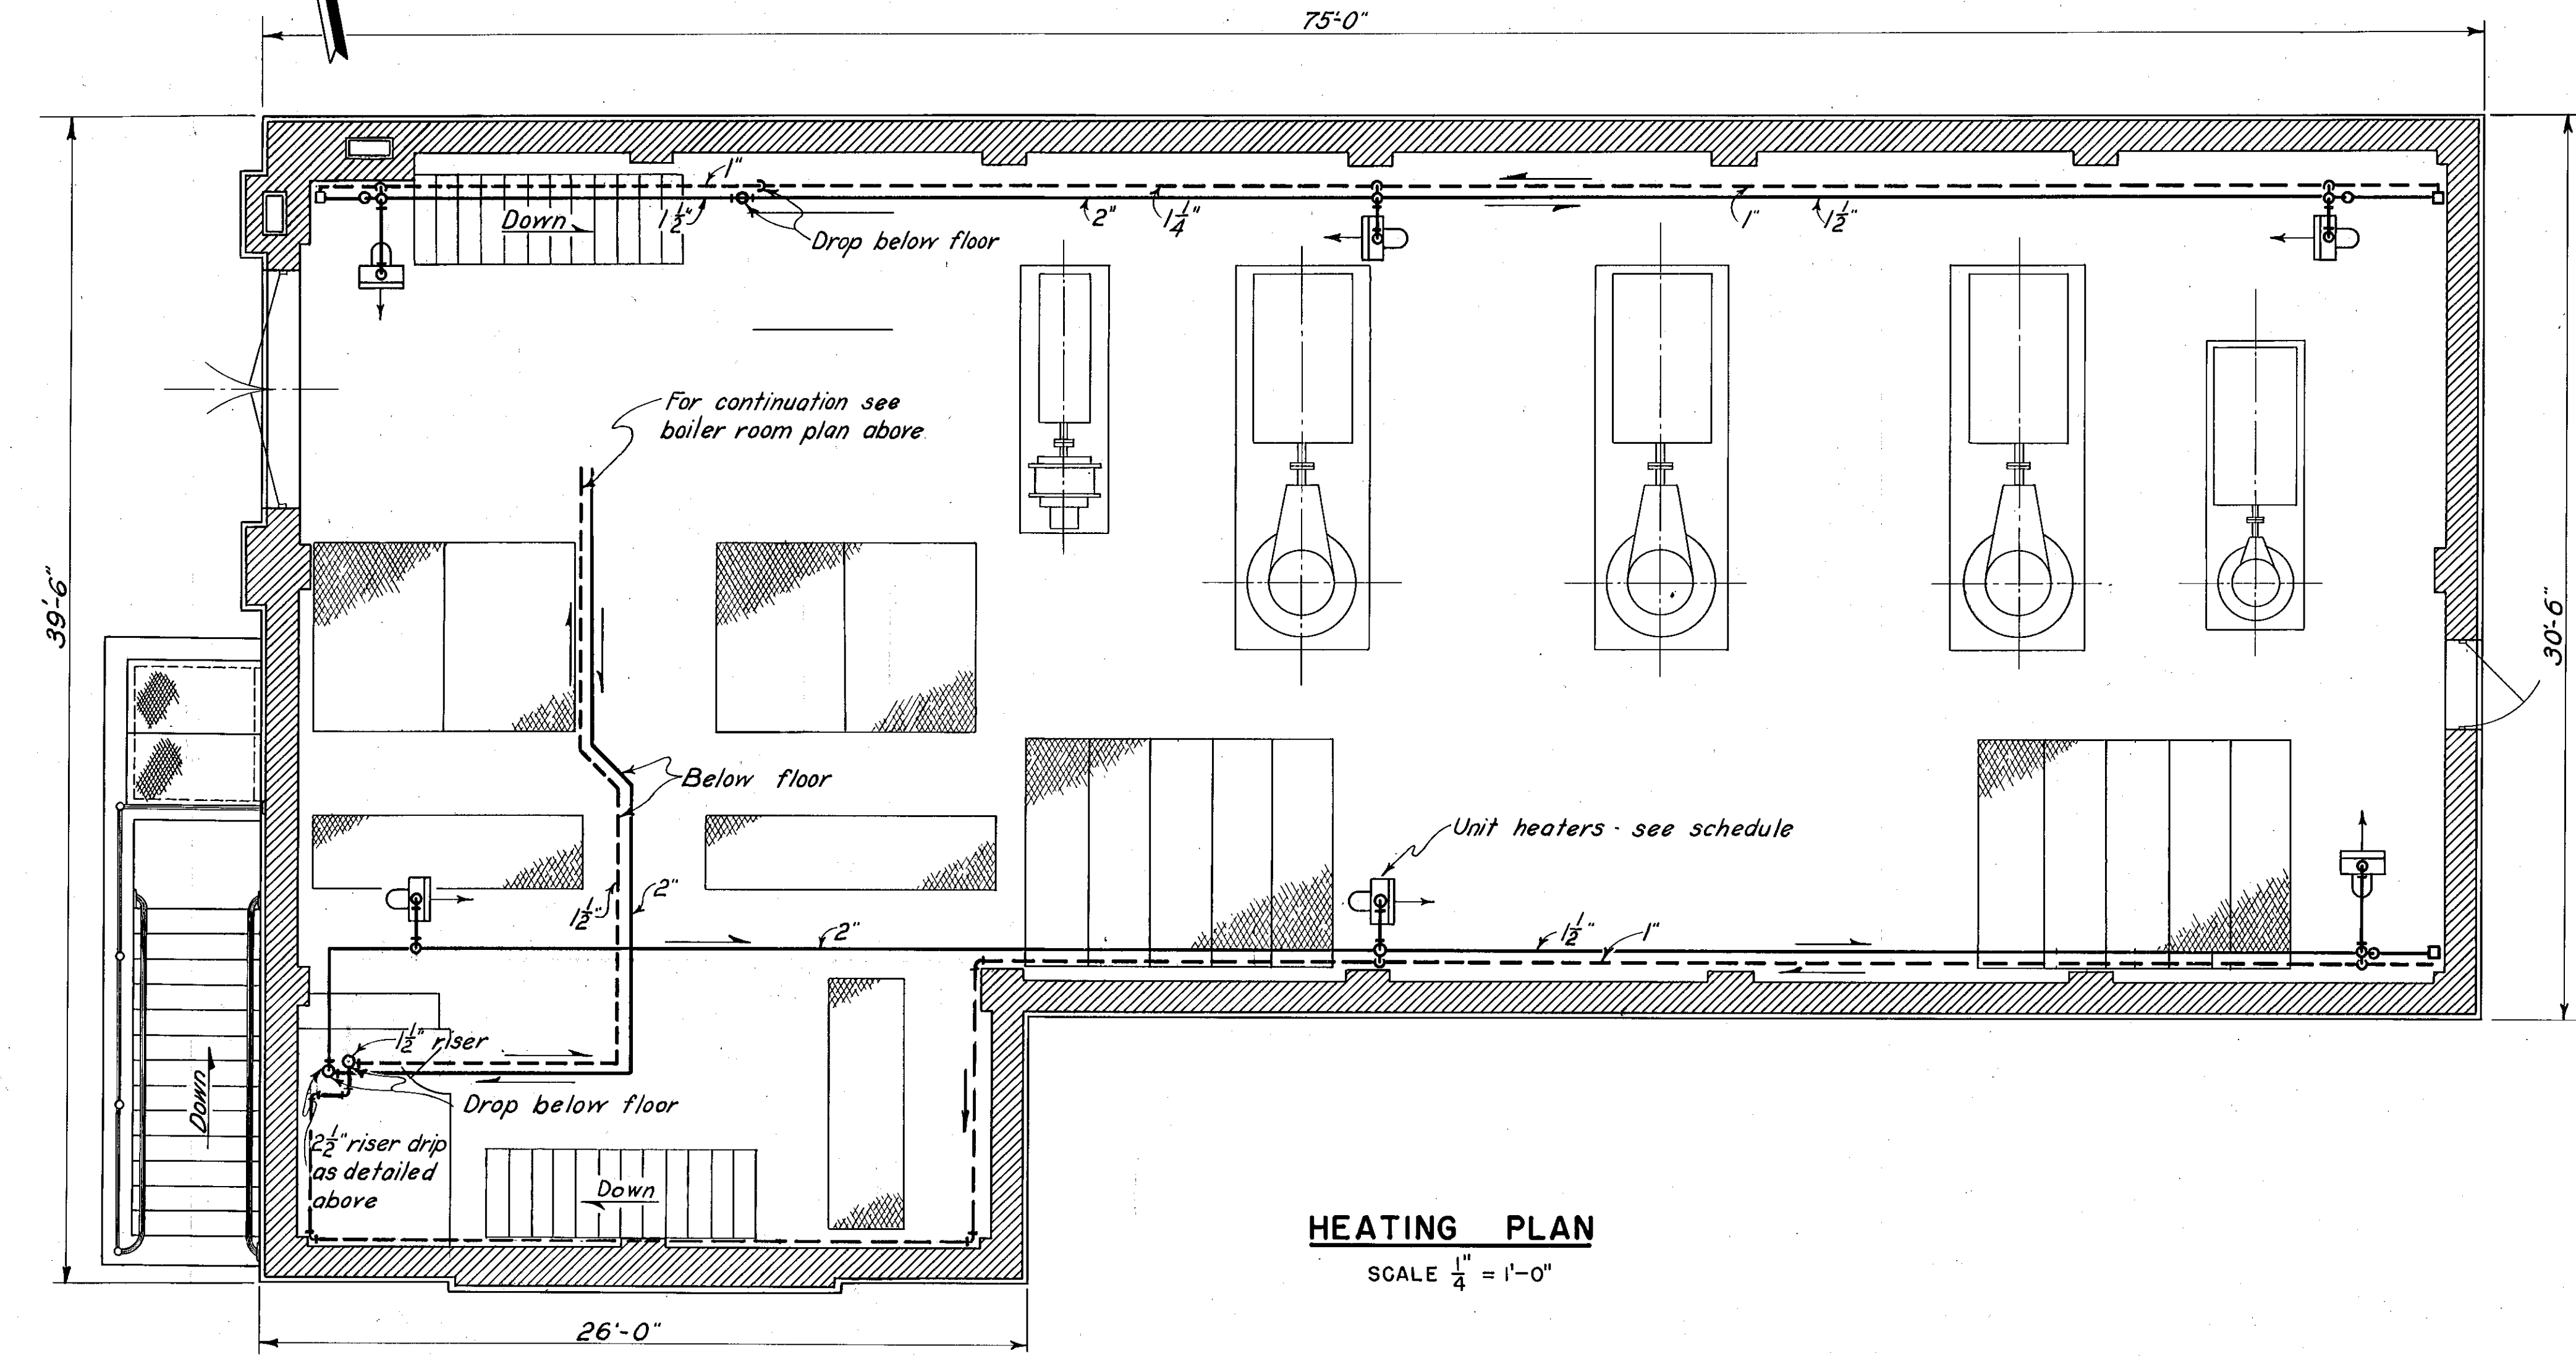

HEATING PLAN

SCALE 1/4" = 1'-0"

RECORD DRAWINGS

CONNECTICUT RIVER FLOOD CONTROL	
KEENEY LANE PUMPING STATION	
HARTFORD, CONN.	
HEATING	
CONNECTICUT RIVER	CONNECTICUT
IN 60 SHEETS	SHEET NO. 52
SCALE 1/4" = 1' FT.	
U.S. ENGINEER OFFICE, PROVIDENCE, R.I., JUNE 1944	
SUBMITTED: H. J. Kupper	APPROVED: H. J. Kupper
HEAD, MECHANICAL SECTION	HEAD, ENGINEERING DIV.
MECHANICAL SUBSECTION	CHEF, ENGINEERING DIV.
DRAWN: R. M. W.	CHECKED: R. M. W.
FILE NO. CT-4-3265	

KEY	DATE	REVISION (Indicated by Δ)	REV. BY	CK. BY	AP. BY
	March 1940	Final field corrections.			