




02951
H
15862

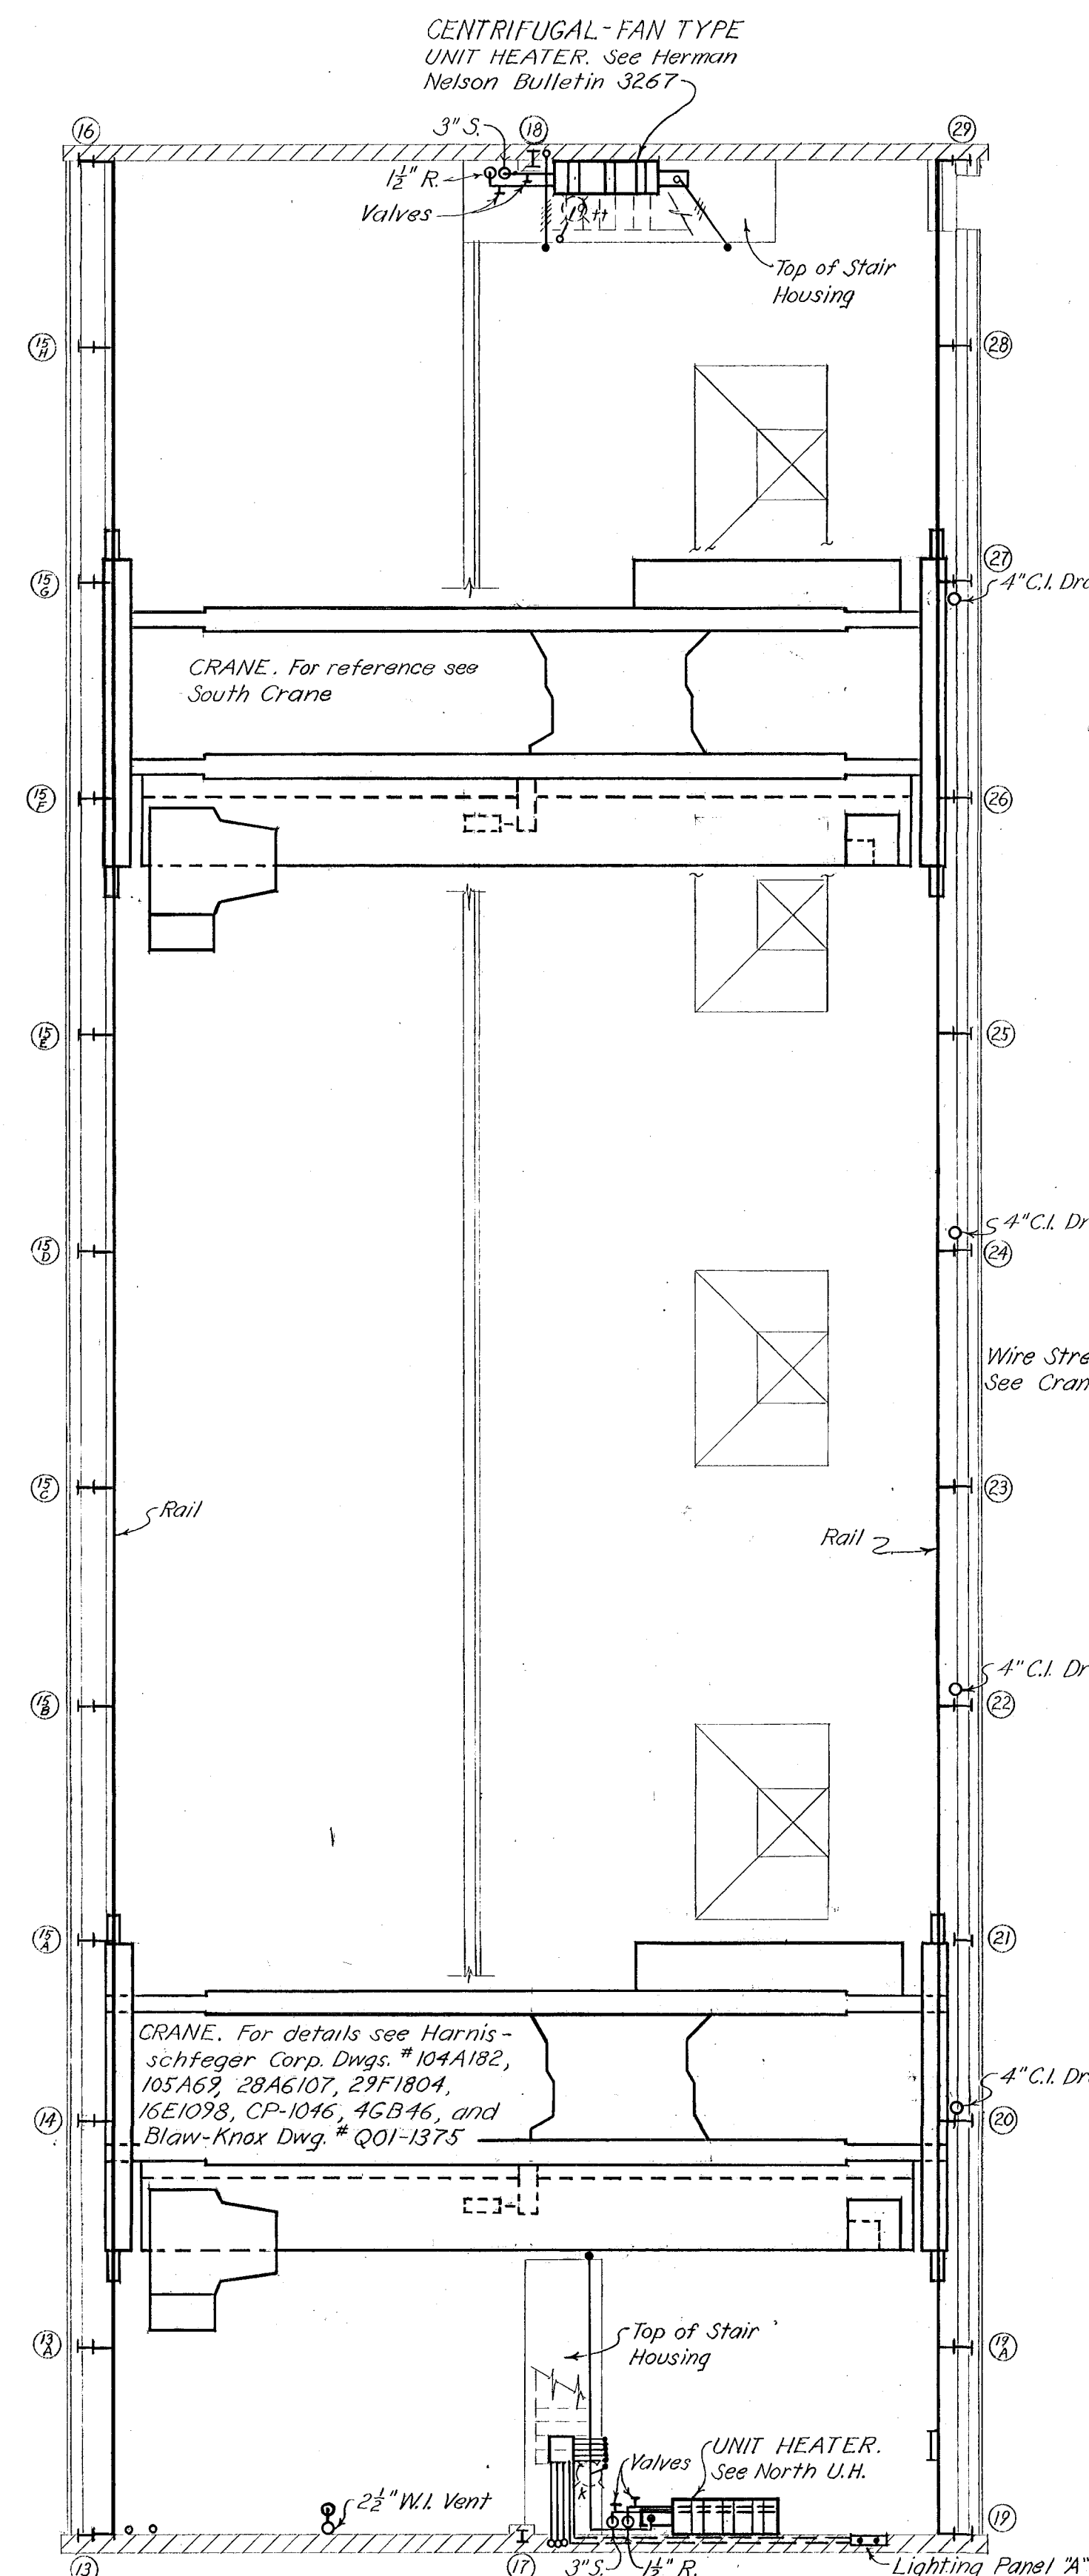

PLAN OF CRANE BAY
AT LEVEL OF CRANES

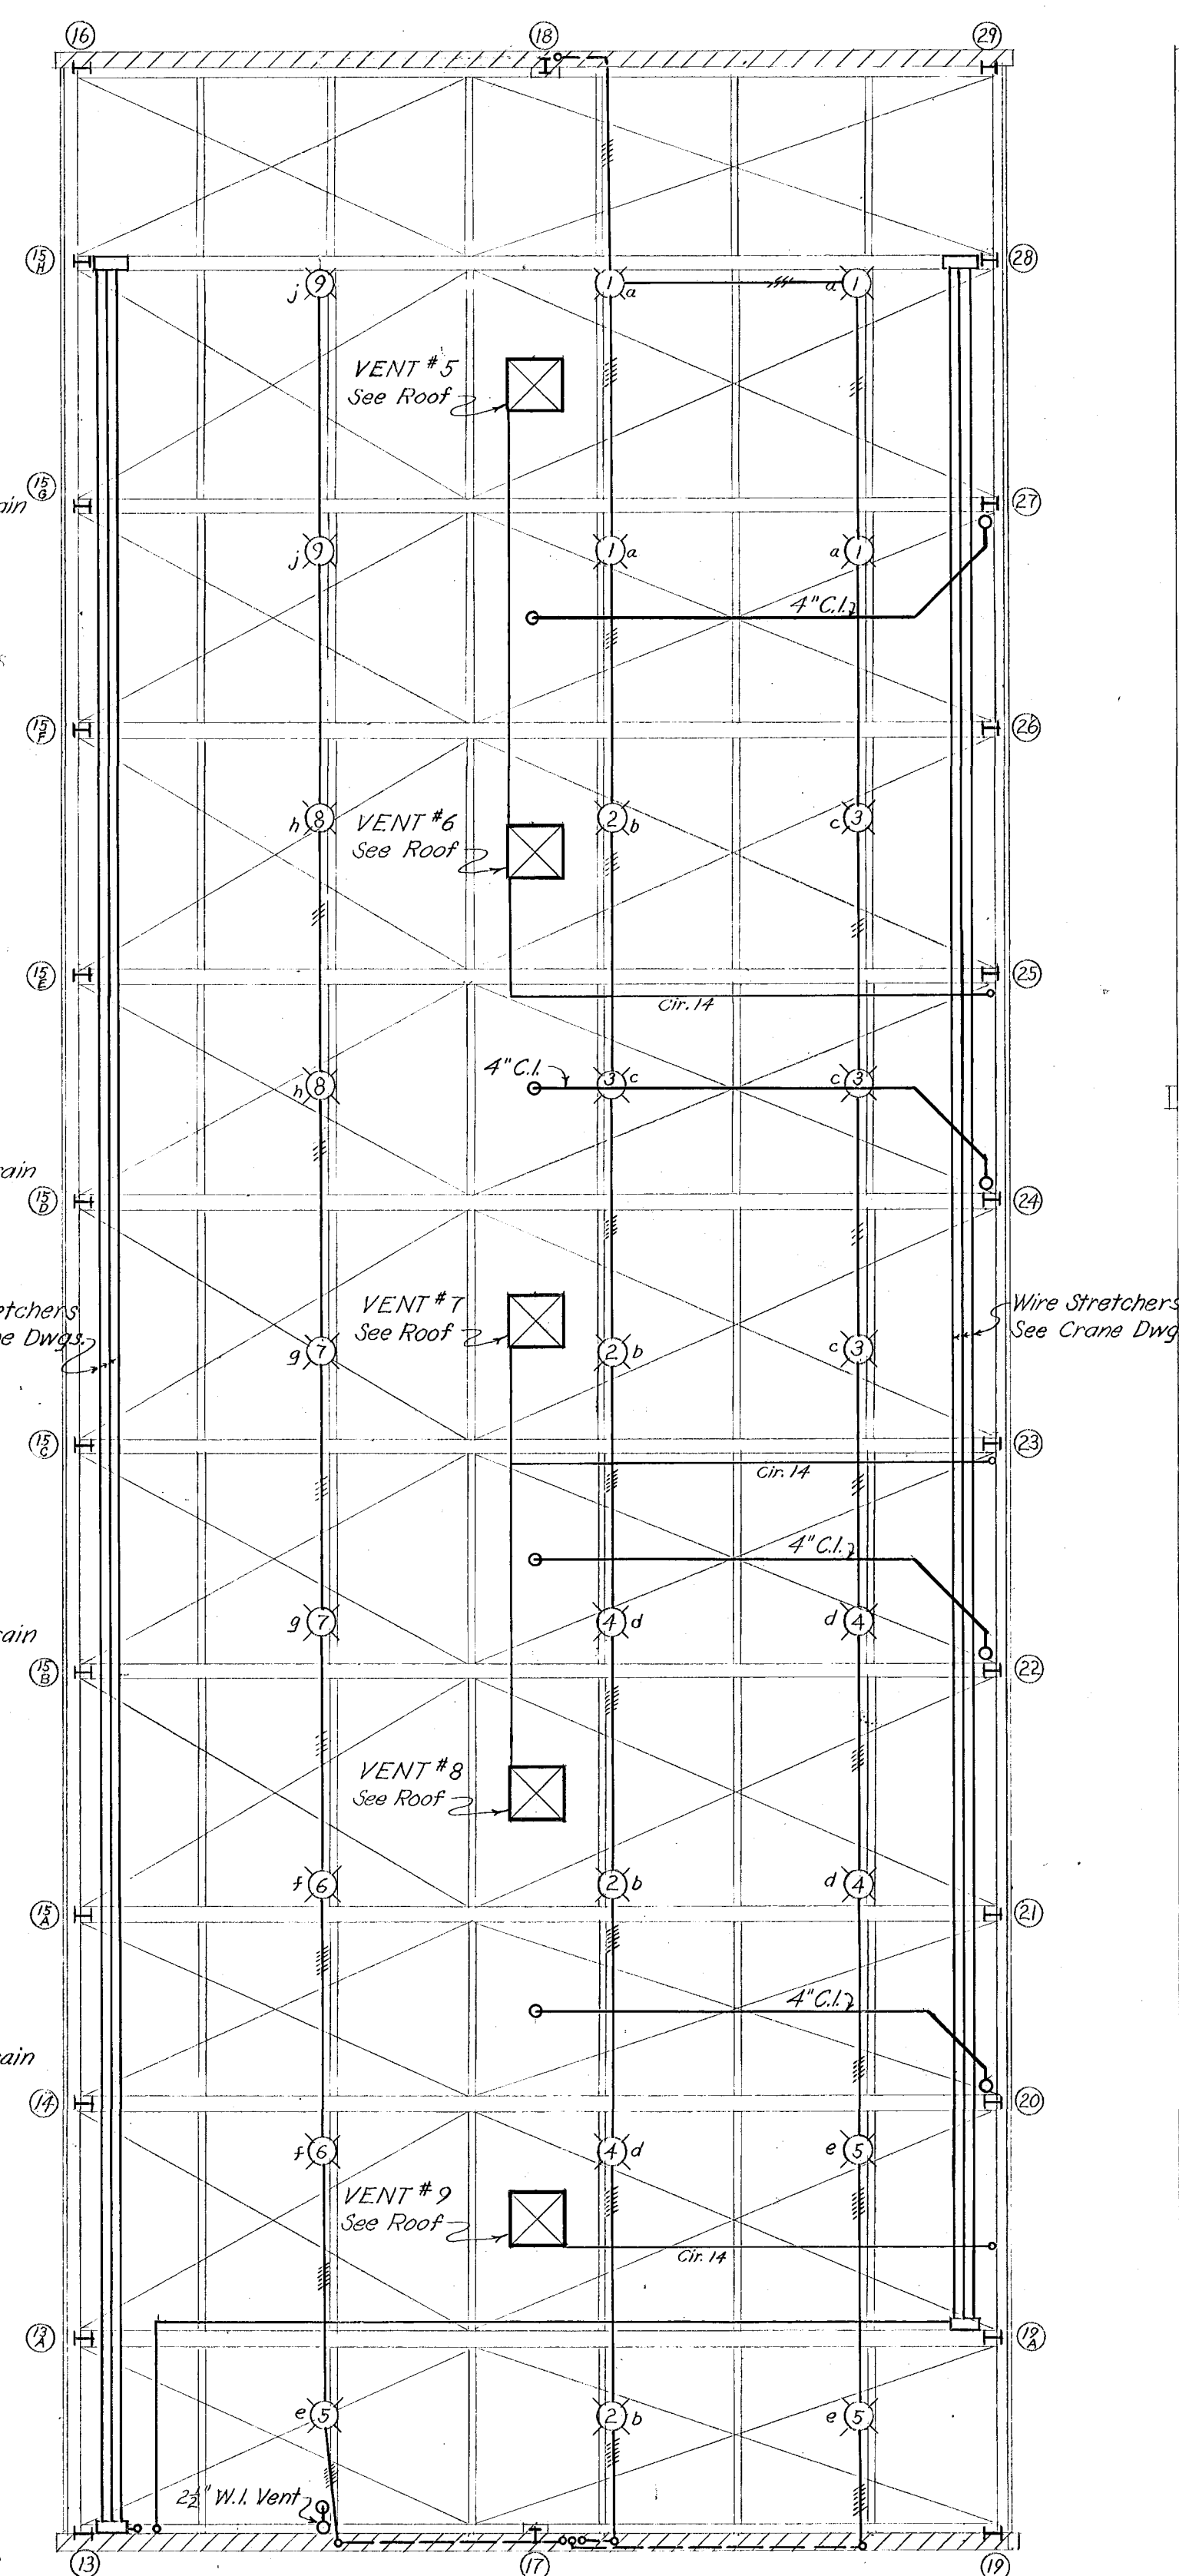

CRANE BAY CEILING PLAN

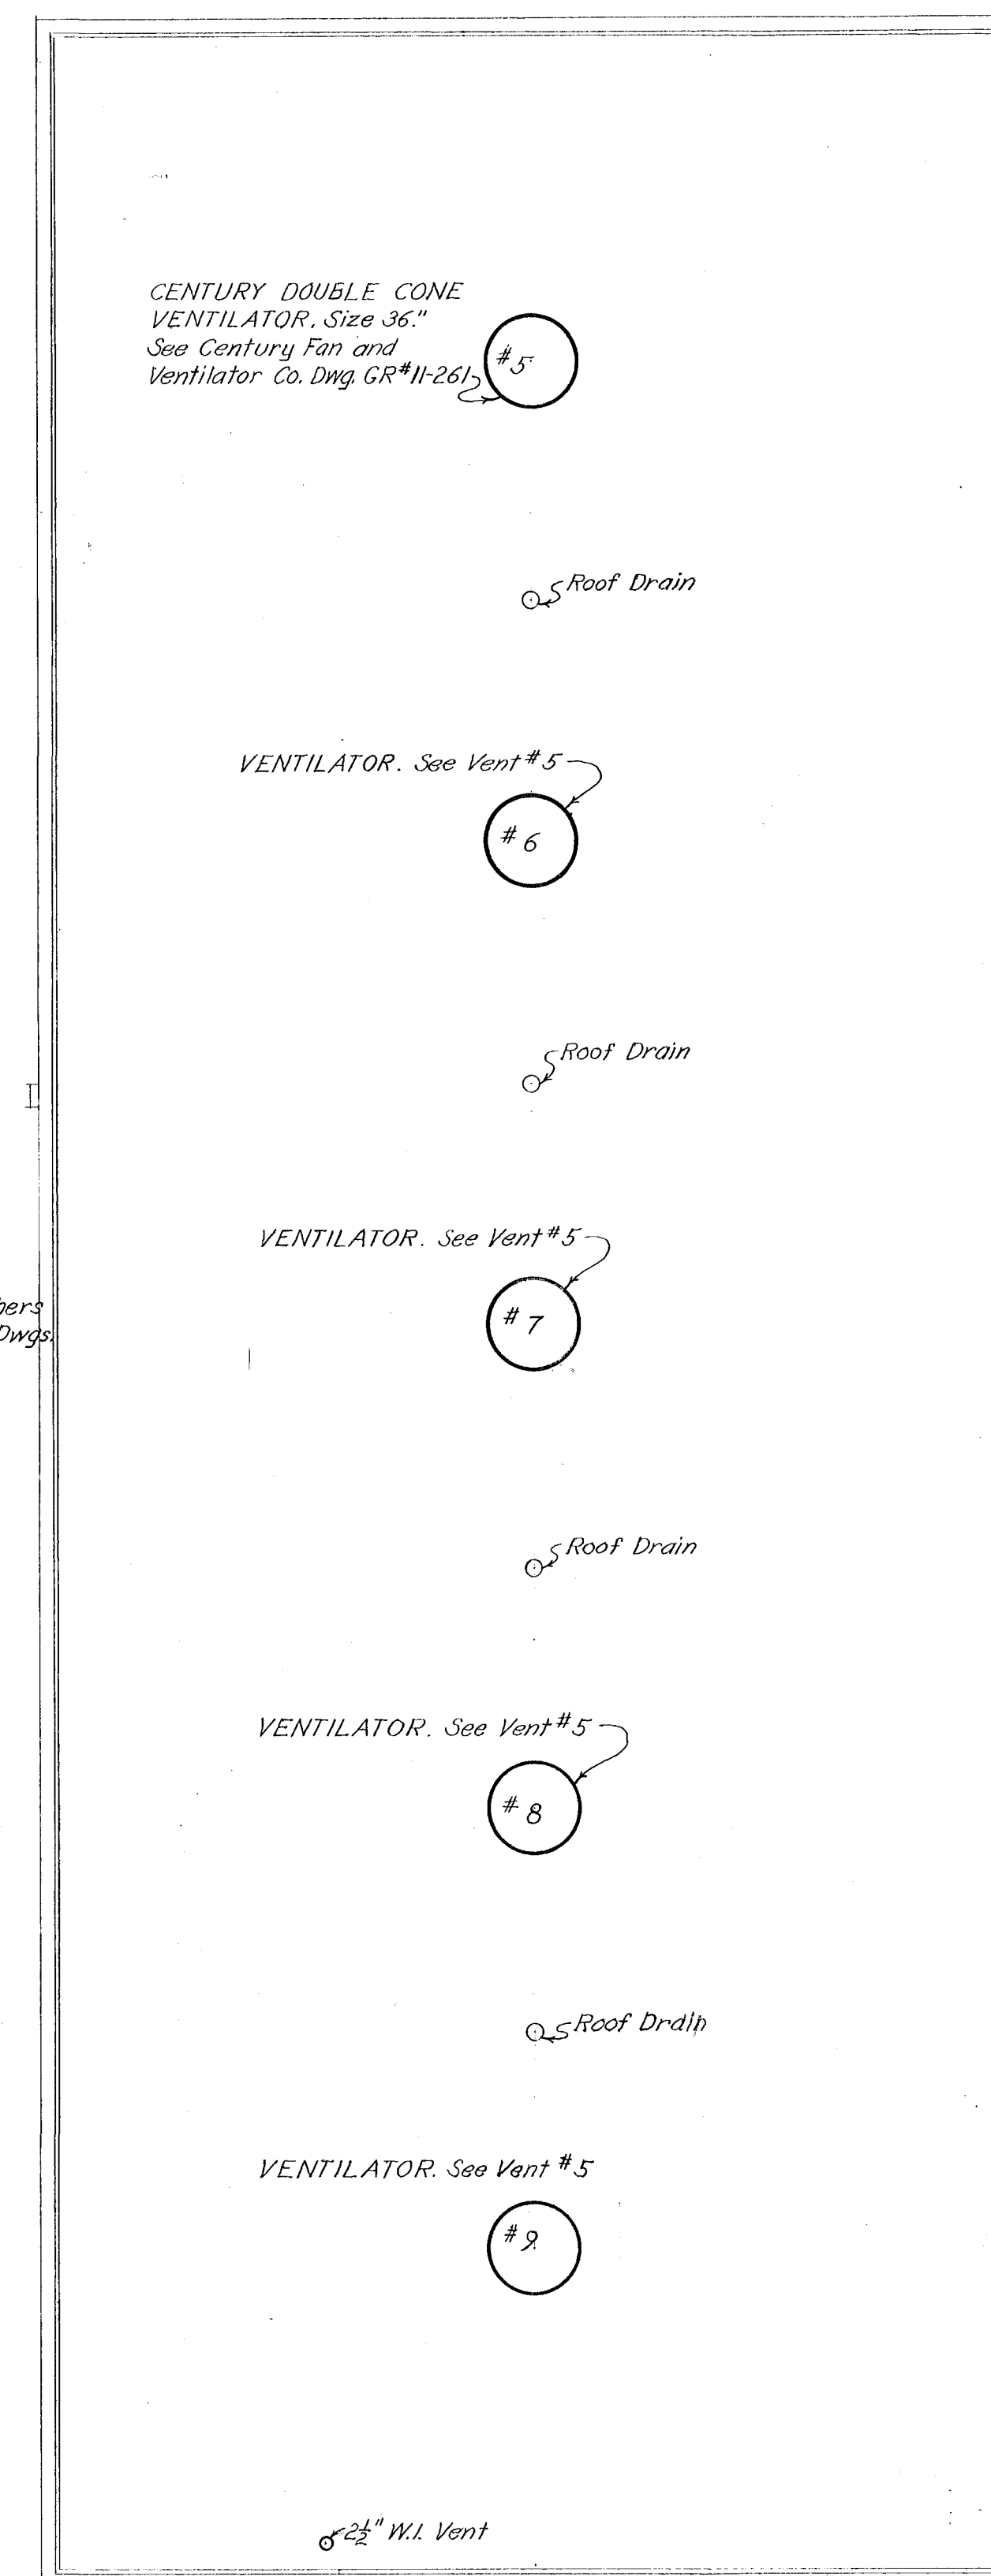

ROOF OVER CRANE BAY

LEGEND

- Exposed Drain
- Exposed Conduit carrying 3 wires
- Buried Conduit carrying 4 wires
- ⑦ Light on circuit 7 operated by Switch "g"
- ⑩ Column No. 27

DRAWN BY D.W.R.
TRACED BY D.W.R.
CHECKED BY J.L.

APPROVED
FOR METCALF & EDDY, ENGINEERS
DATE

CITY OF HARTFORD, CONN.
CARLETON F. SHARPE - CITY MANAGER
H. IRVING SKILTON - CITY ENGINEER
CHARLES W. COOKE - DIRECTOR, PUBLIC WORKS
NORTH MEADOWS INCINERATOR
RECORD DRAWINGS
CRANE AREA
CRANE PLAN - CEILING & ROOF
SCALE: 1/8" = 1'-0"
DEC. 1954
METCALF & EDDY
ENGINEERS
BOSTON, MASS.