
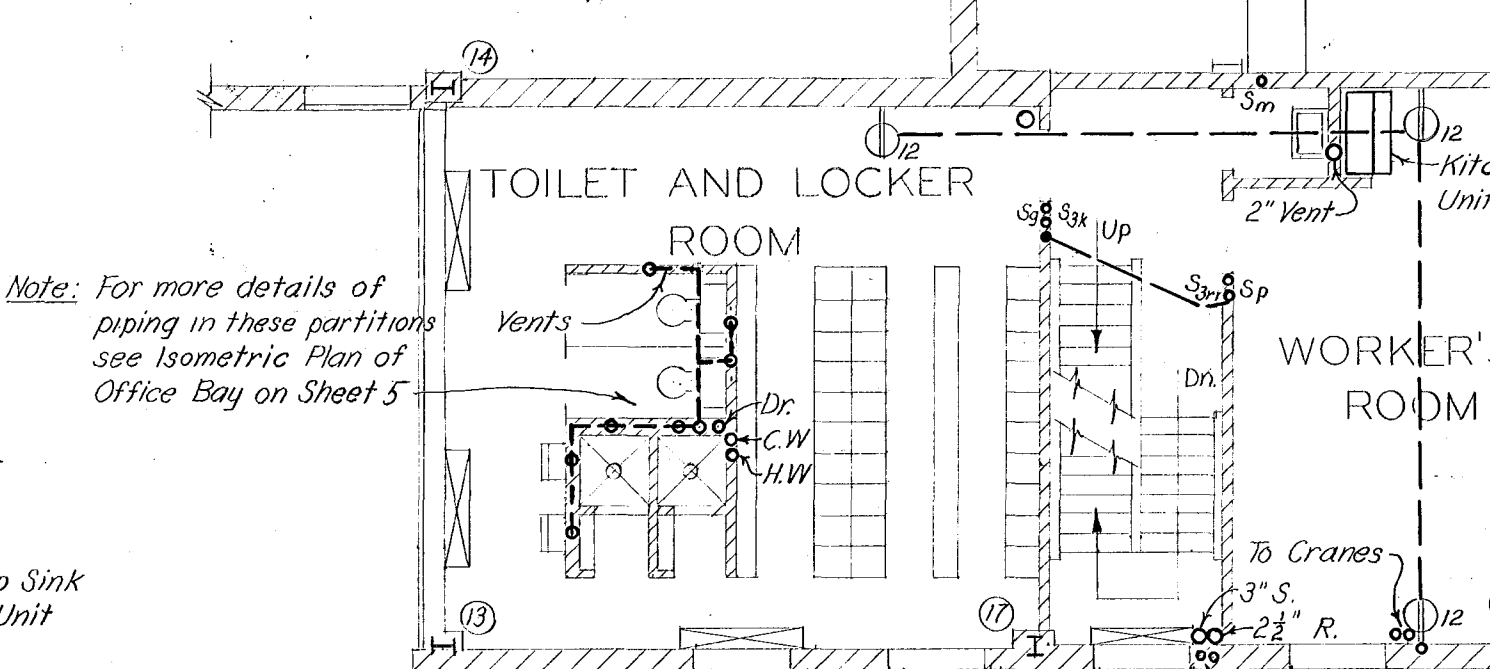
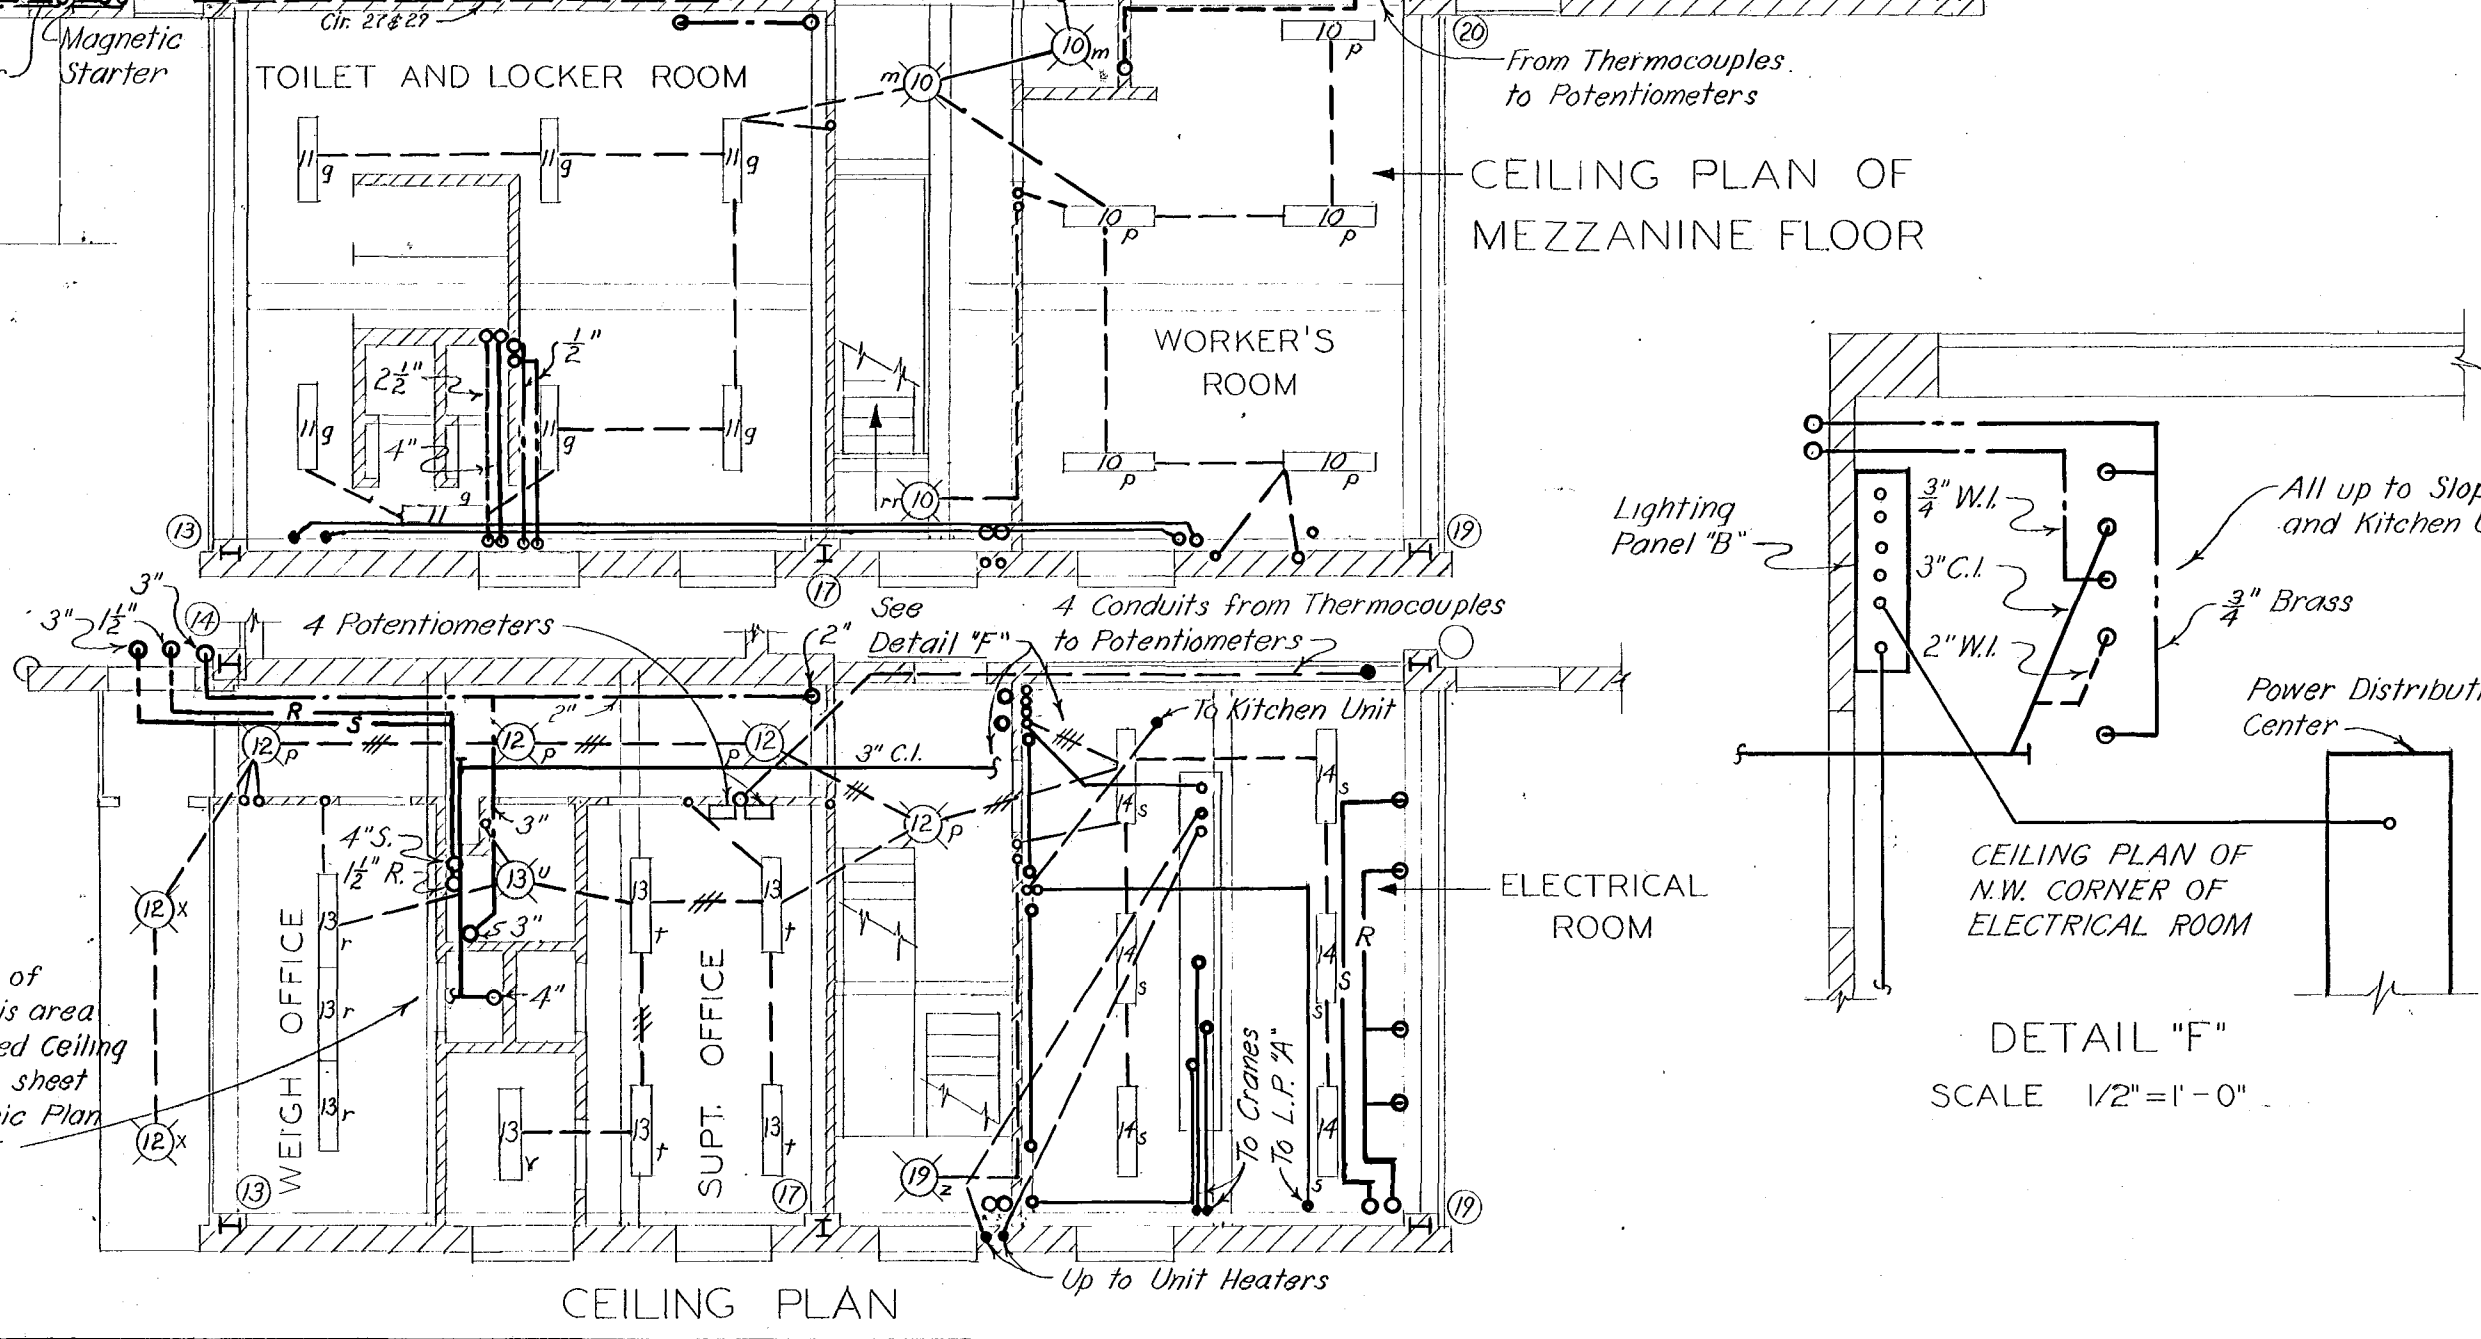
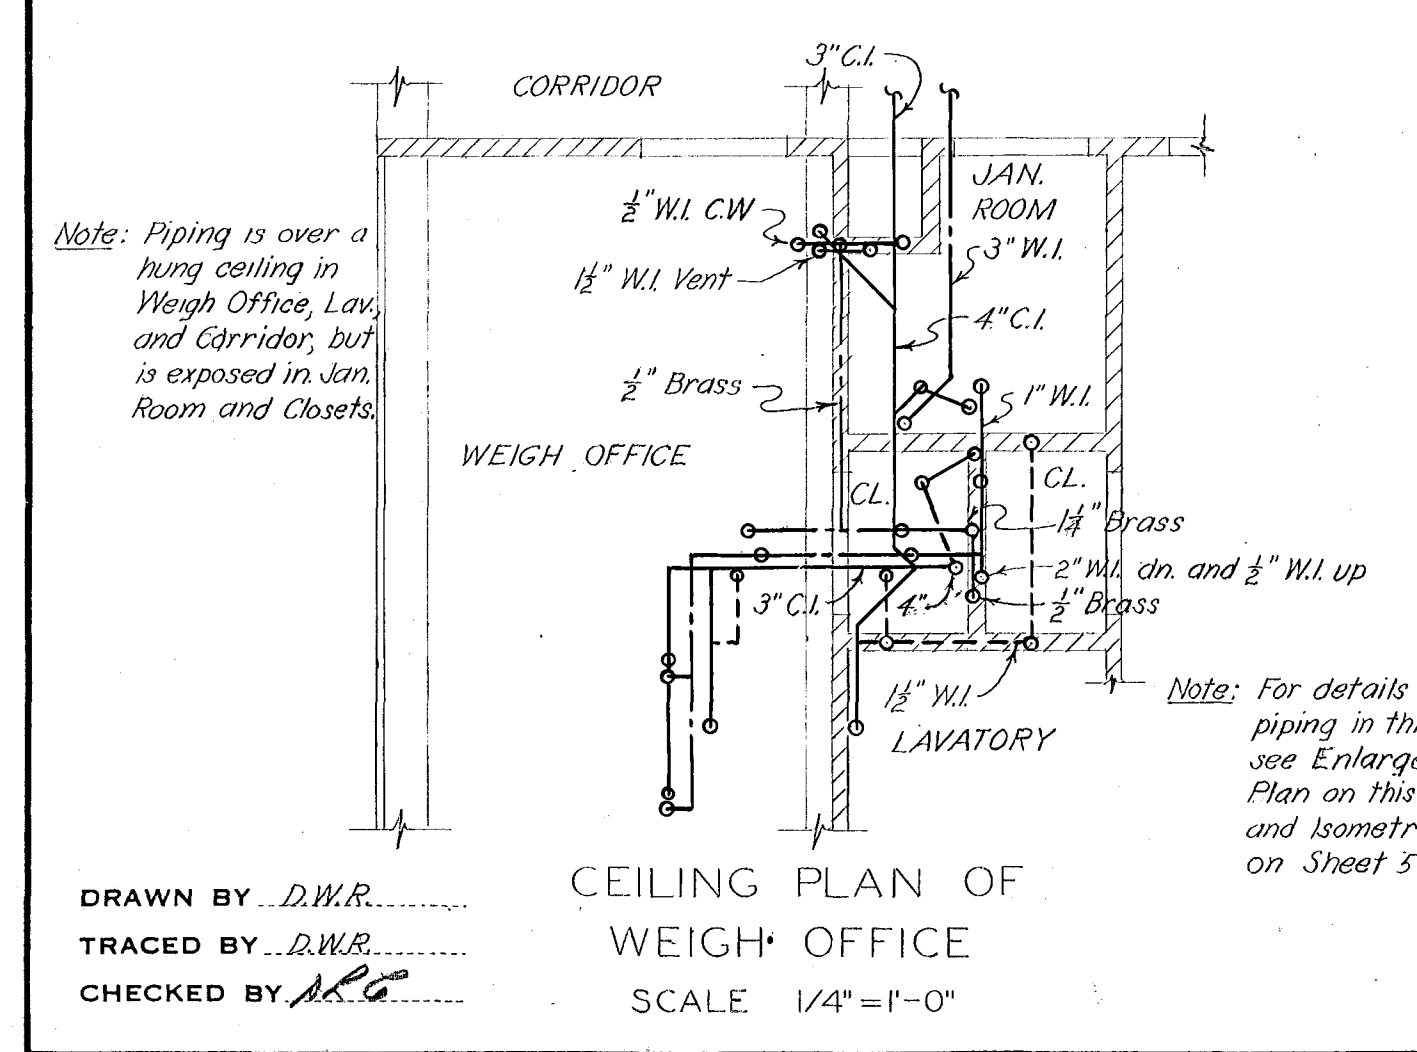
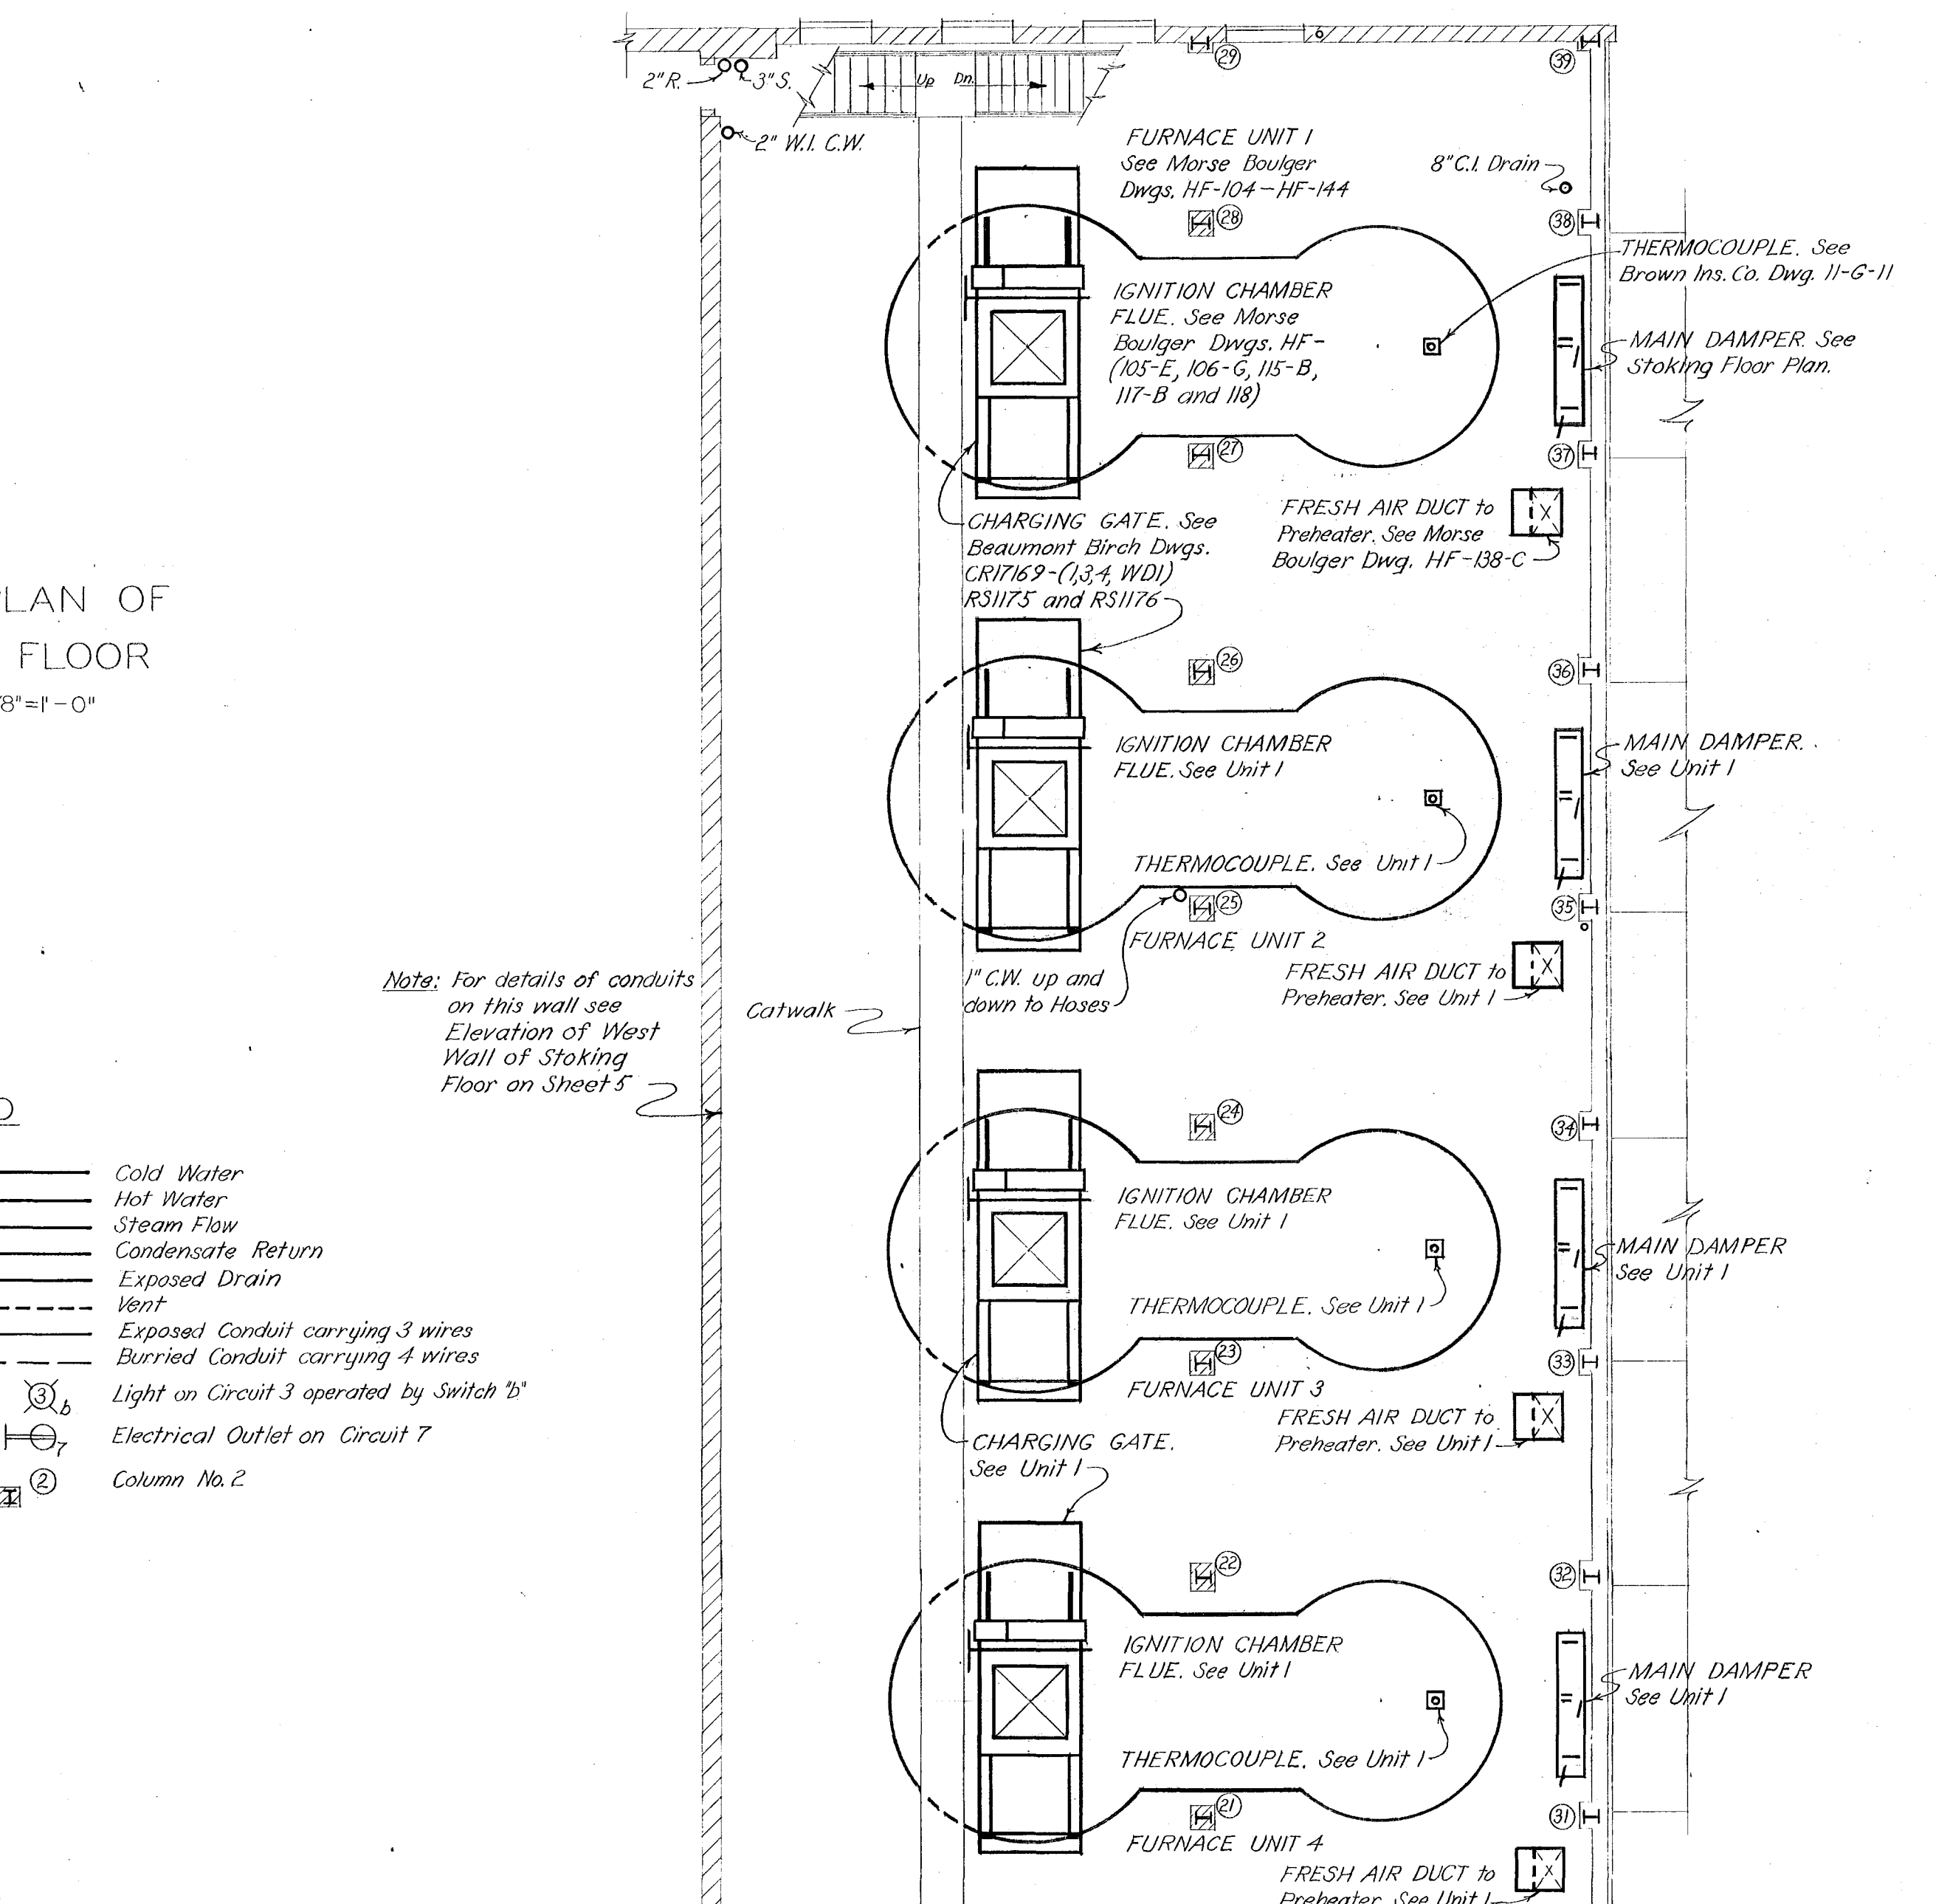


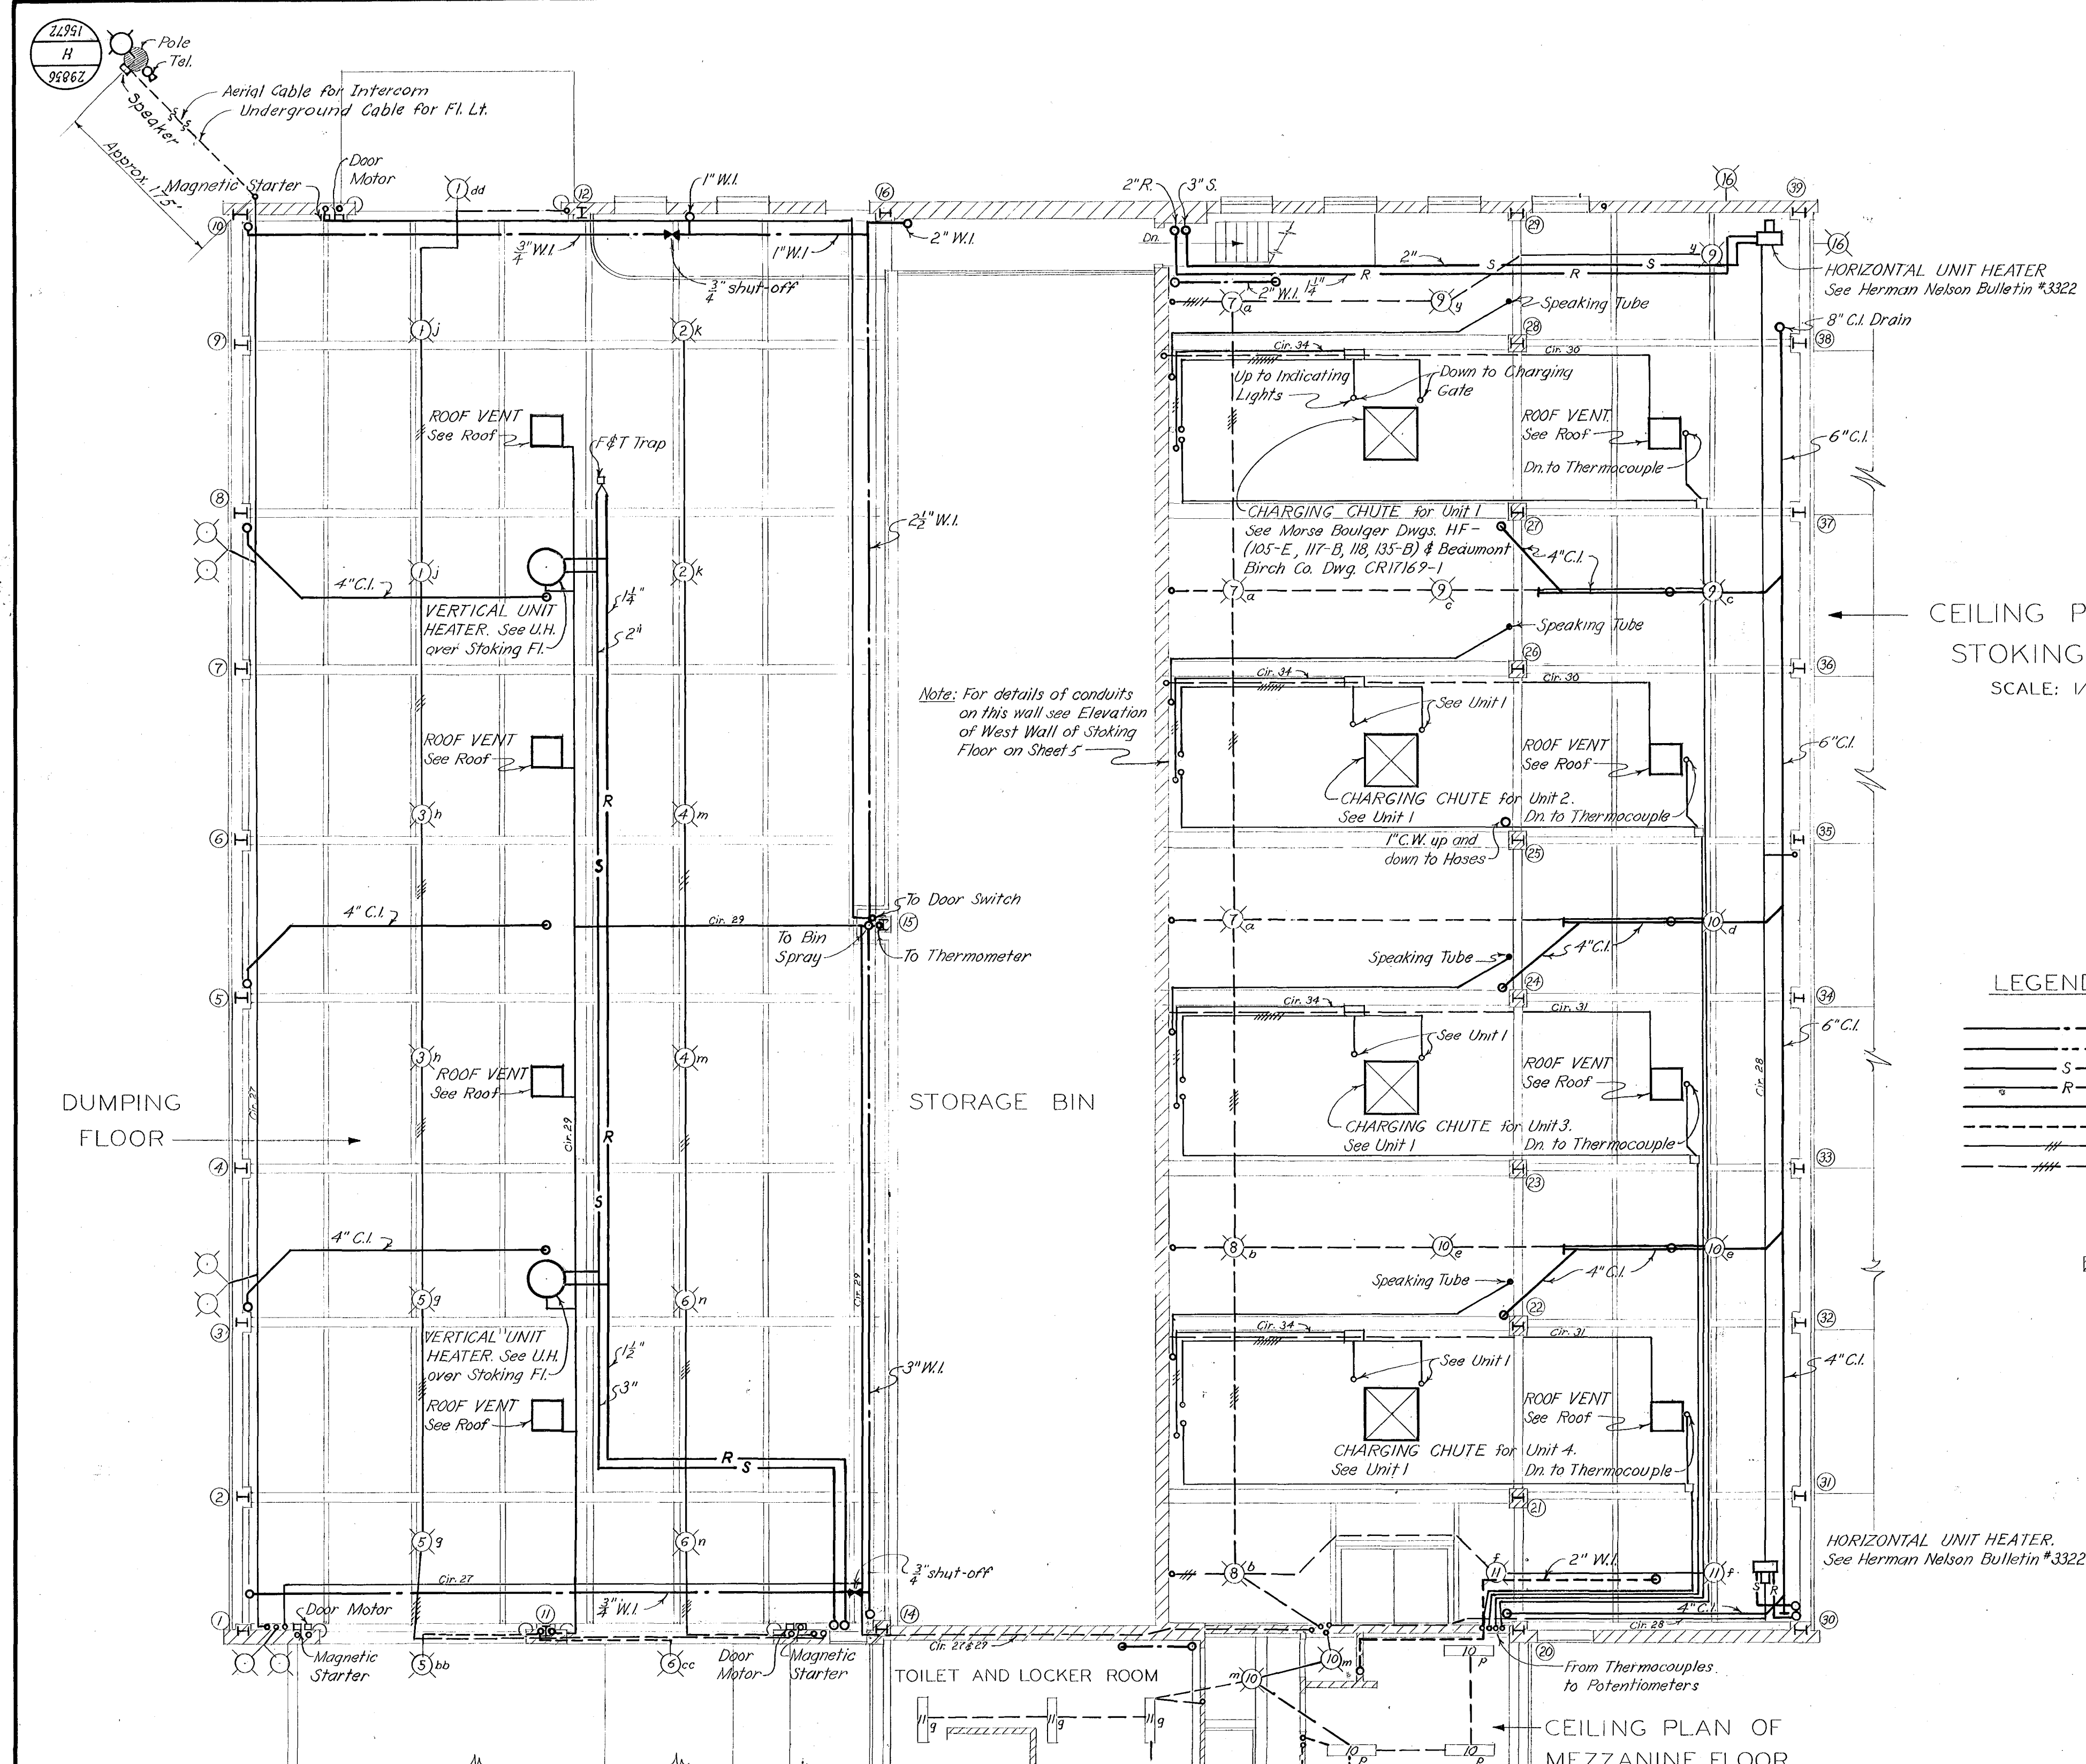

CITY OF HARTFORD, CONN

CARLETON F. SHARPE - CITY MANAGER  
H. IRVING SKILTON - CITY ENGINEER  
CHARLES W. COOKE - DIRECTOR, PUBLIC WORKS

NORTH MEADOWS INCINERATOR  
RECORD DRAWINGS

STOKING FLOOR AREA  
CEILING & FLOOR PLANS  
MEZZANINE LEVEL

SCALE AS SHOWN DEC. 1954

APPROVED  
FOR METCALF & EDDY, ENGINEERS

DATE

METCALF & EDDY  
ENGINEERS  
BOSTON, MASS.

29856  
H  
15672