


LEGEND


- Cold Water
- Hot Water
- S — Steam Supply
- R — Condensate Return
- O.S. — Oil Supply
- O.R. — Oil Return
- Exposed Drain
- Buried Drain
- Exposed Conduit carrying 3 wires
- Buried Conduit carrying 4 wires

- ① Light on Circuit 7 operated by Switch "c" (S_c)
- ② Column No. 21 (For Col. Nos. see Struc. or Arch. Dwg.)

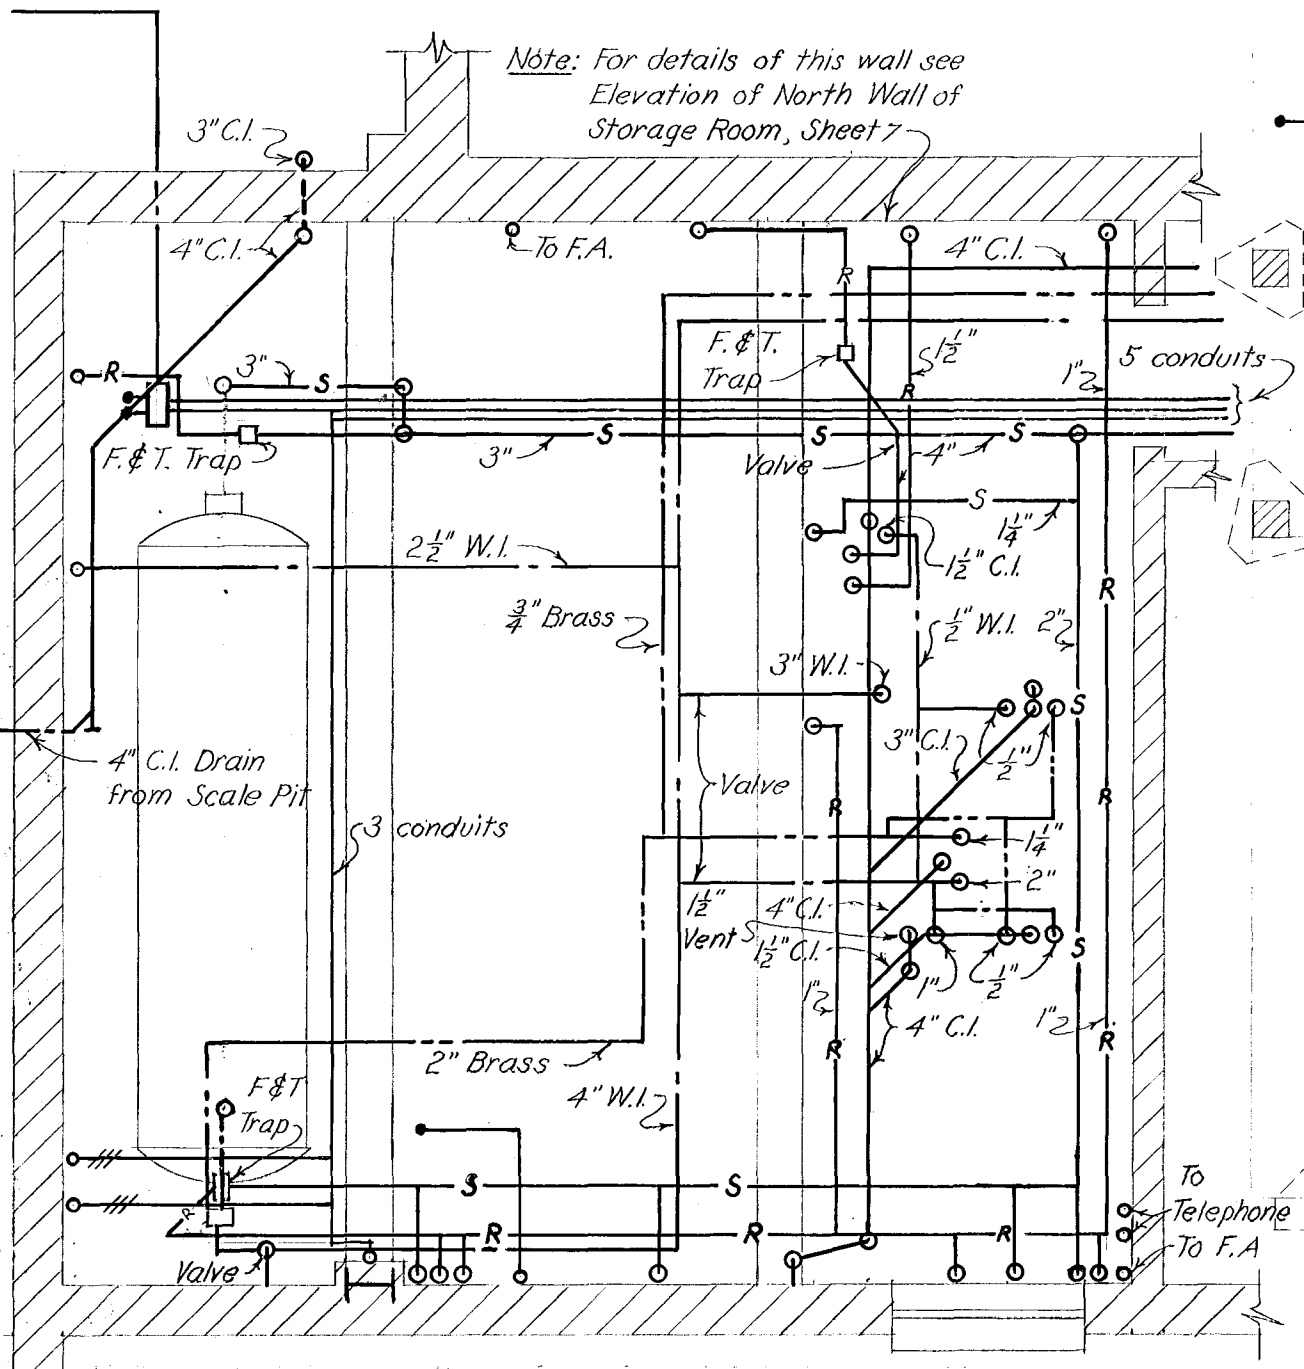

MACHINE SHOP CEILING PLAN
SCALE: 1/4" = 1'-0"


DRAWN BY D.W.R.
TRACED BY D.W.R.
CHECKED BY M.B.

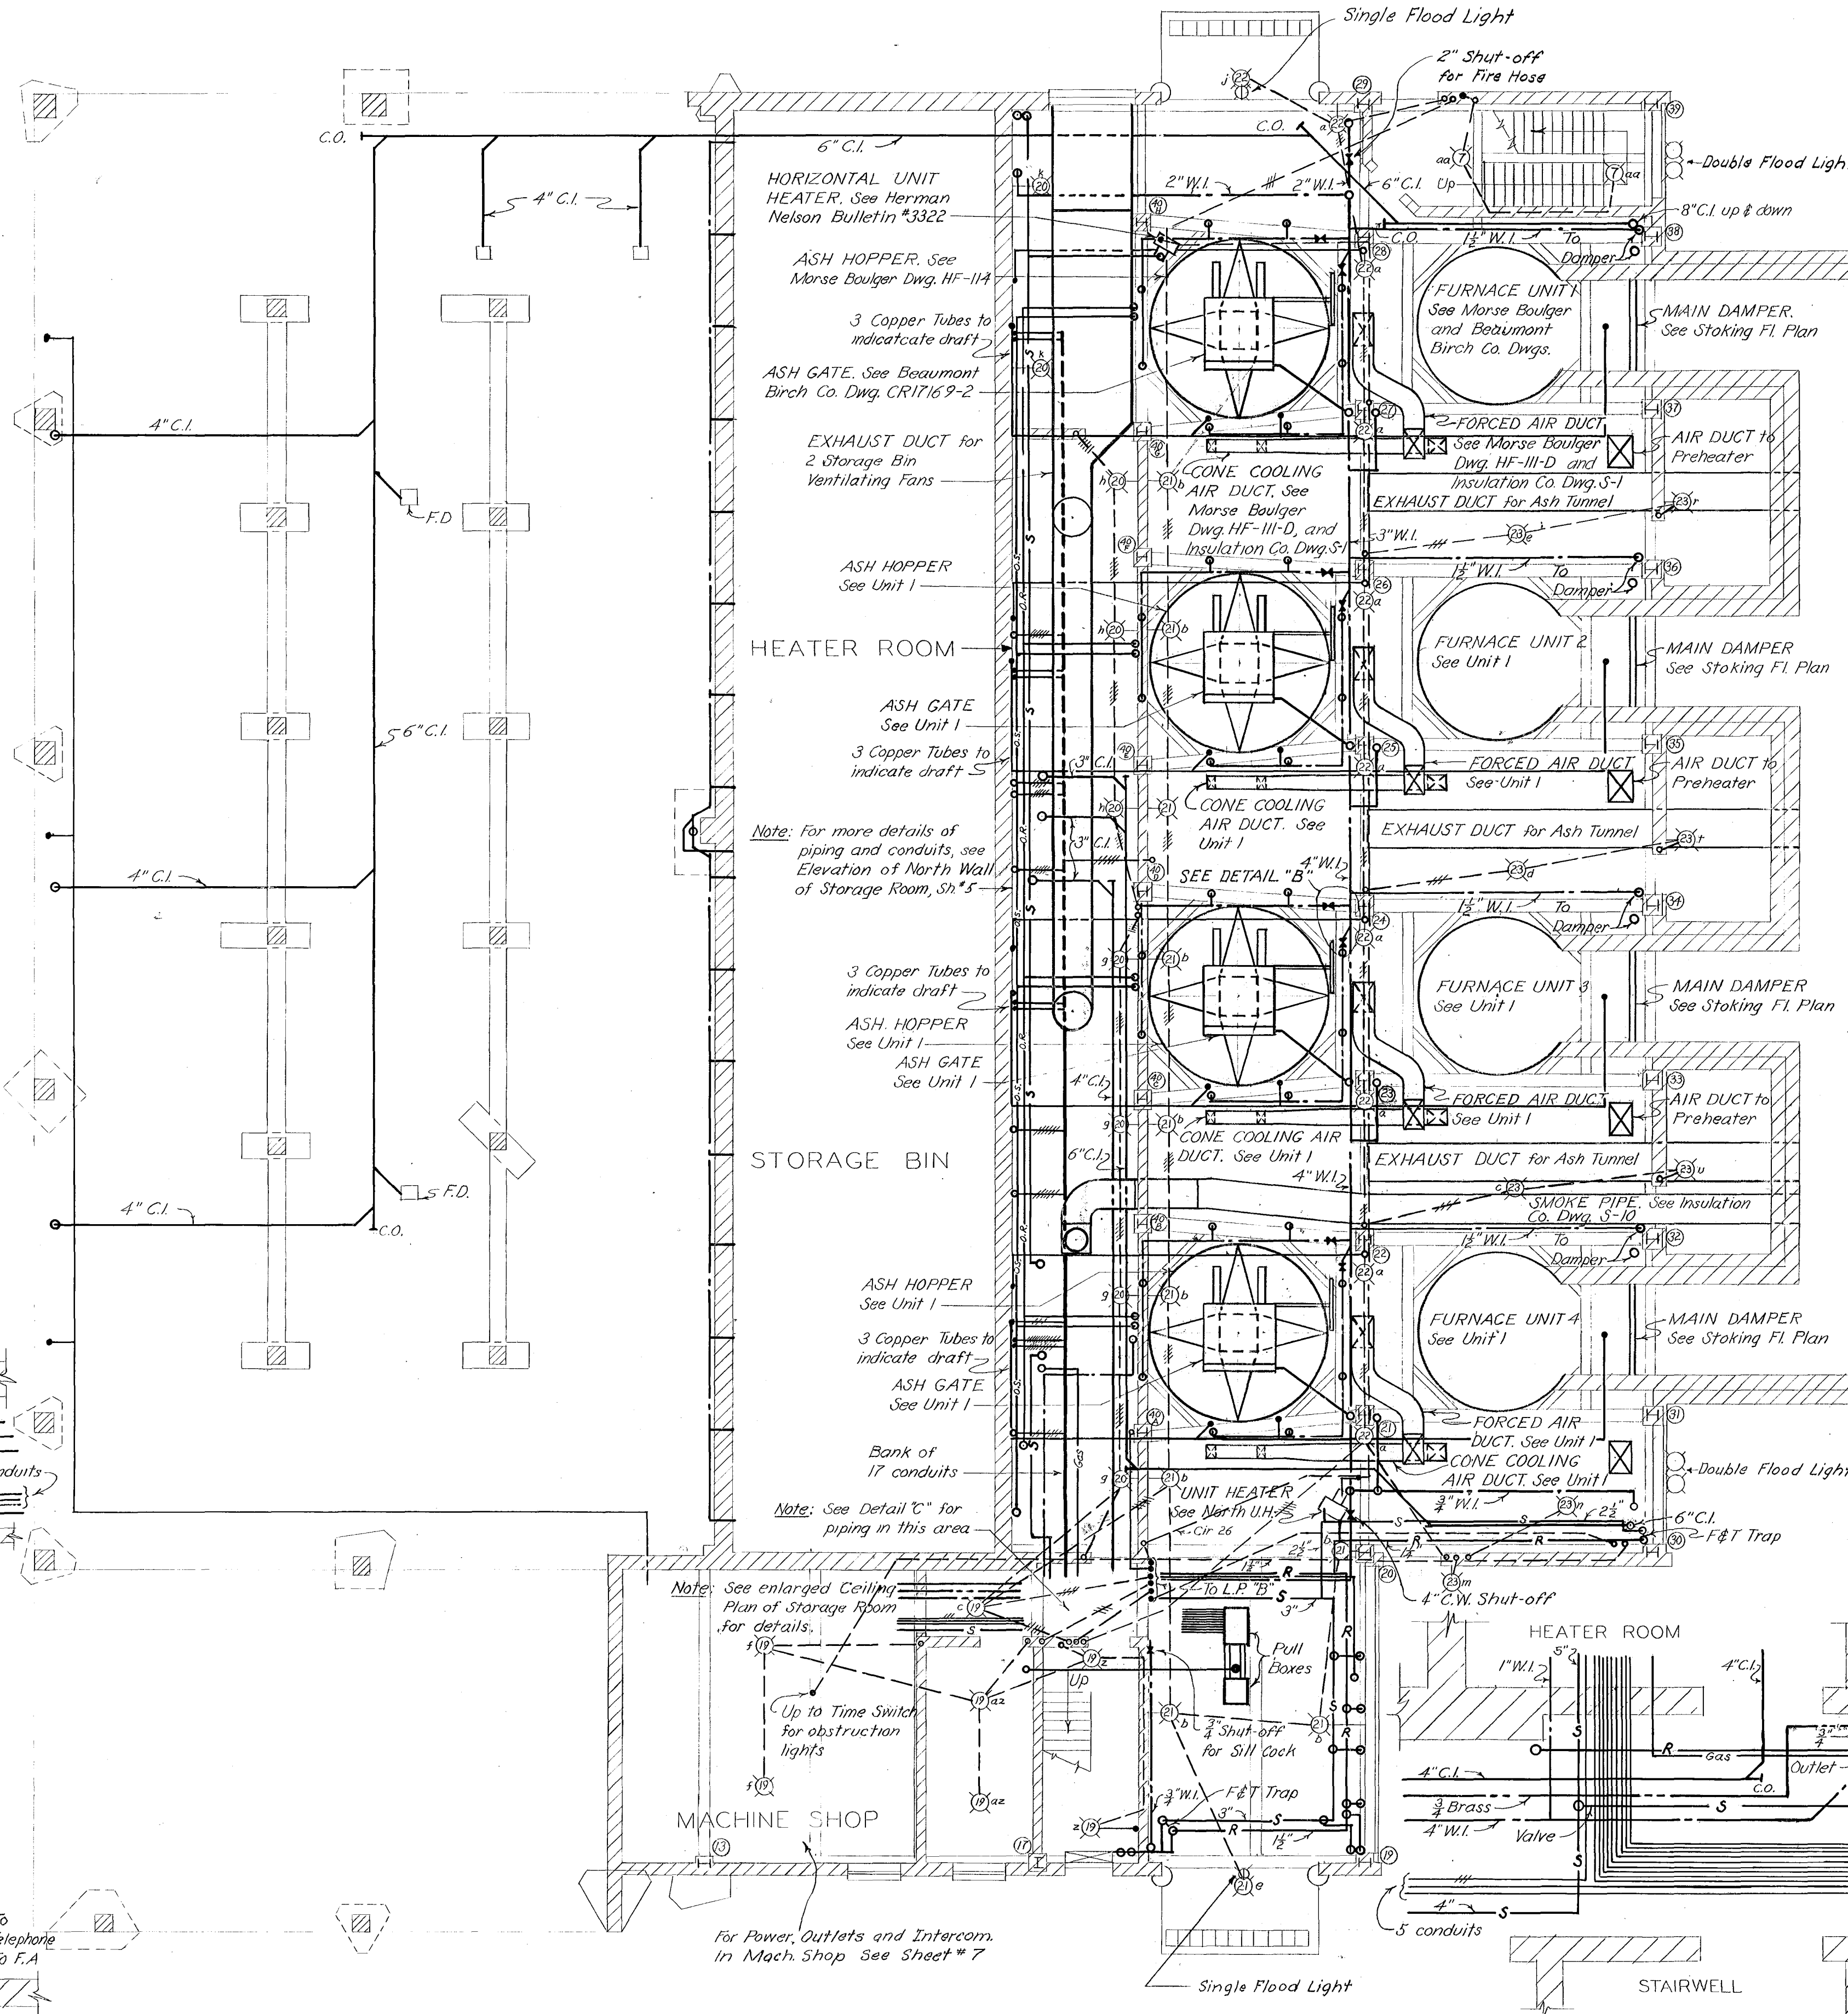

ASH TUNNEL CEILING PLAN
SCALE: 1/8" = 1'-0"

DETAIL "C"
CEILING PLAN
SCALE: 3/8" = 1'-0"

- Notes:
- For details of Columns 22, 24, 26 and 28 see Detail "B" on this sheet
 - For details of Columns 21, 23, 25 and 27 see Detail "A" on Sheet 7

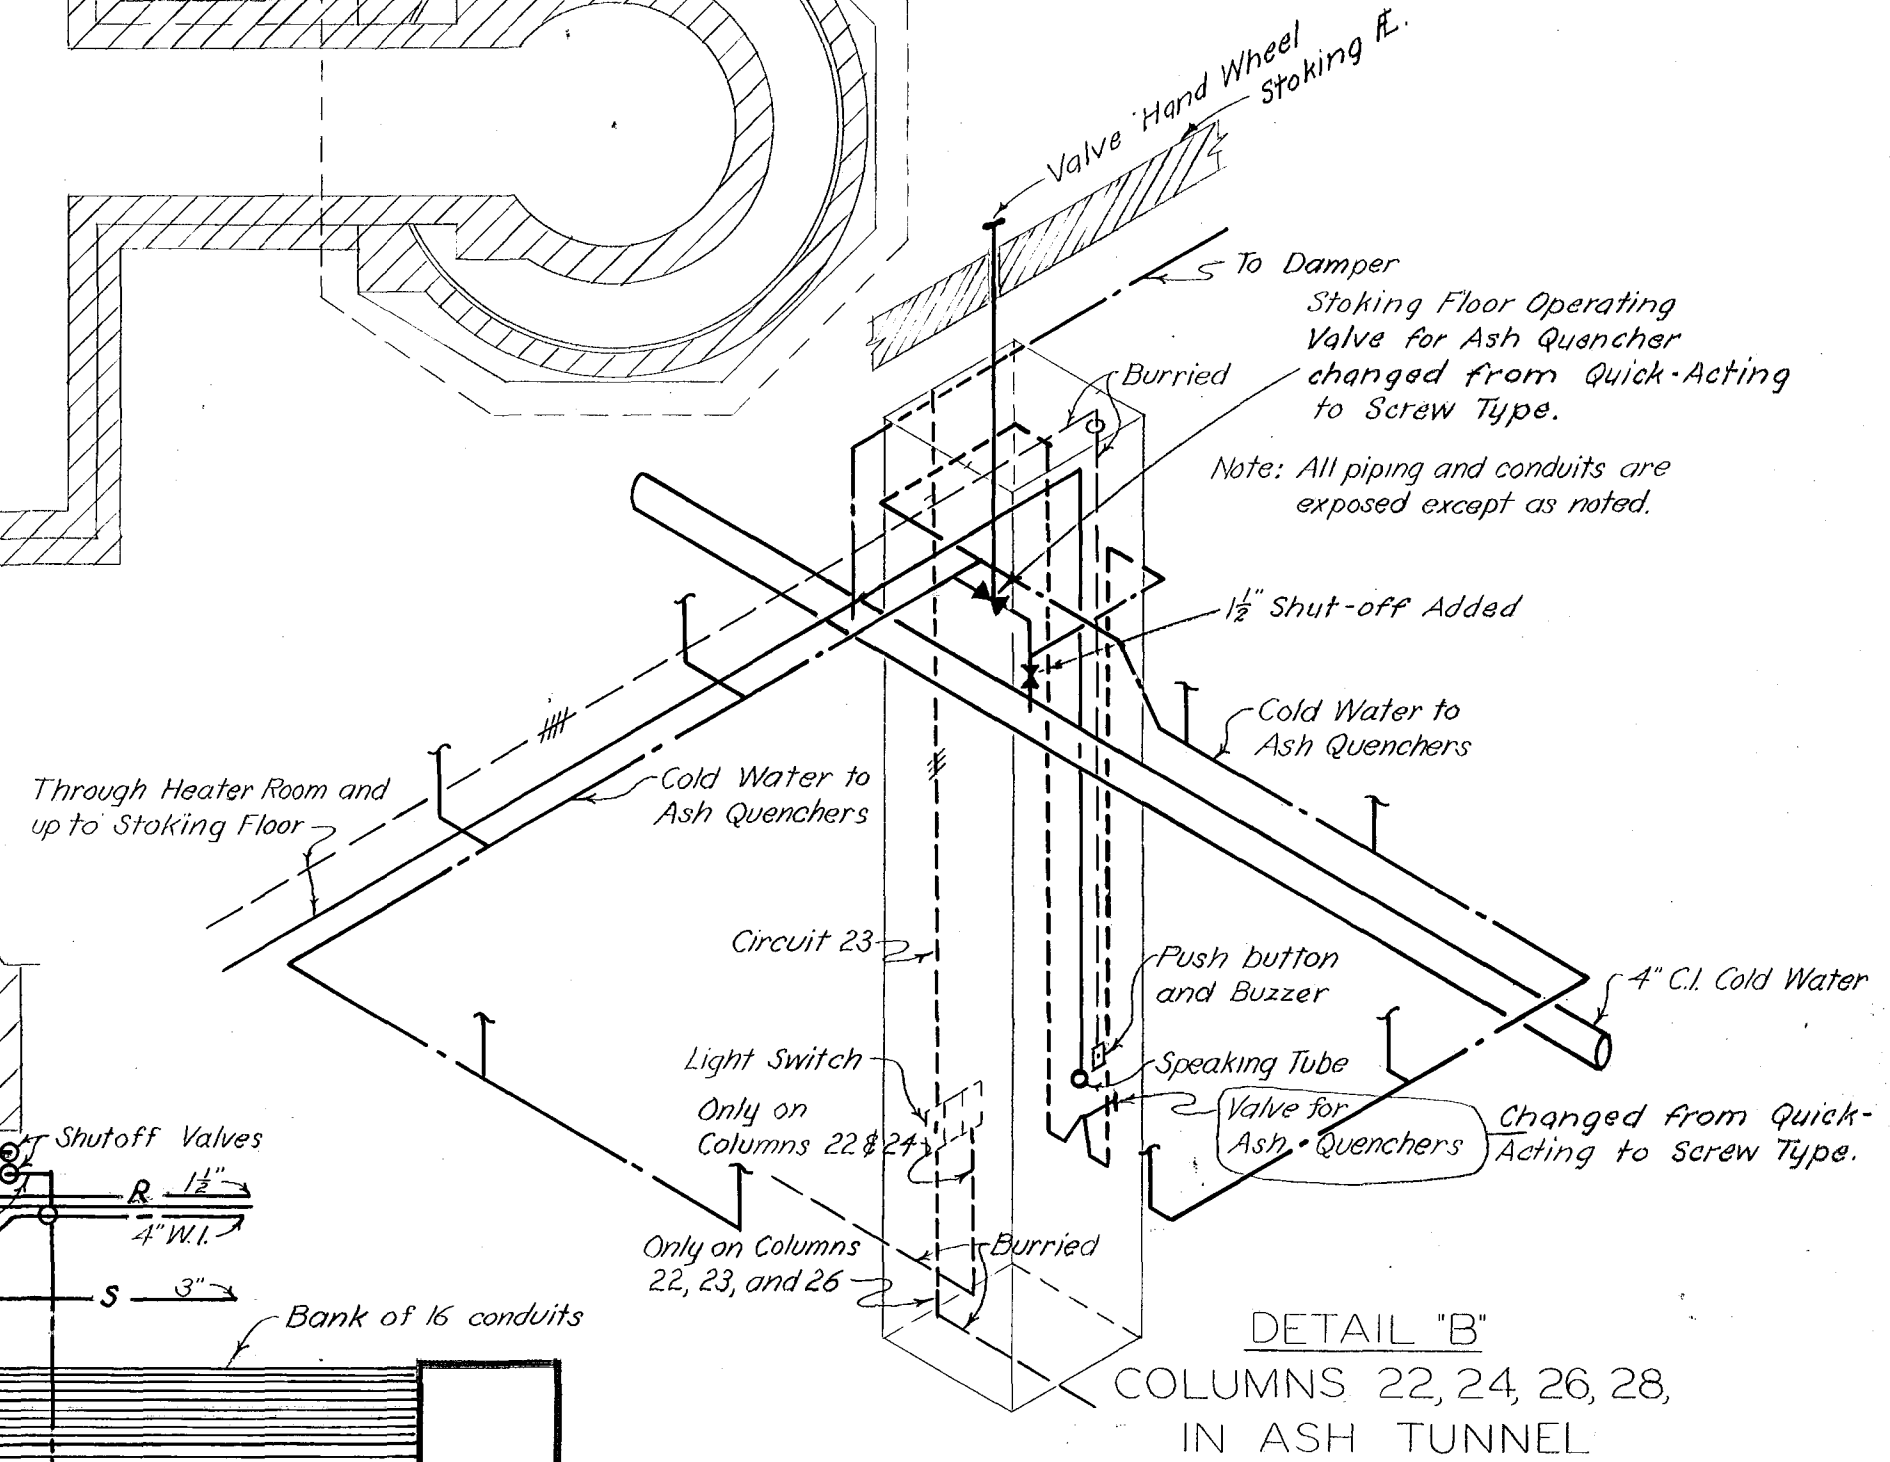

DETAIL "B"
COLUMNS 22, 24, 26, 28,
IN ASH TUNNEL

CITY OF HARTFORD, CONN.

CARLETON F. SHARPE - CITY MANAGER
H. IRVING SKILTON - CITY ENGINEER
CHARLES W. COOKE - DIRECTOR, PUBLIC WORKS

NORTH MEADOWS INCINERATOR
RECORD DRAWINGS
ASH TUNNEL AREA
CEILING PLAN

SCALE, AS SHOWN DEC, 1954

METCALF & EDDY
ENGINEERS
BOSTON, MASS.

29859
H
15675