

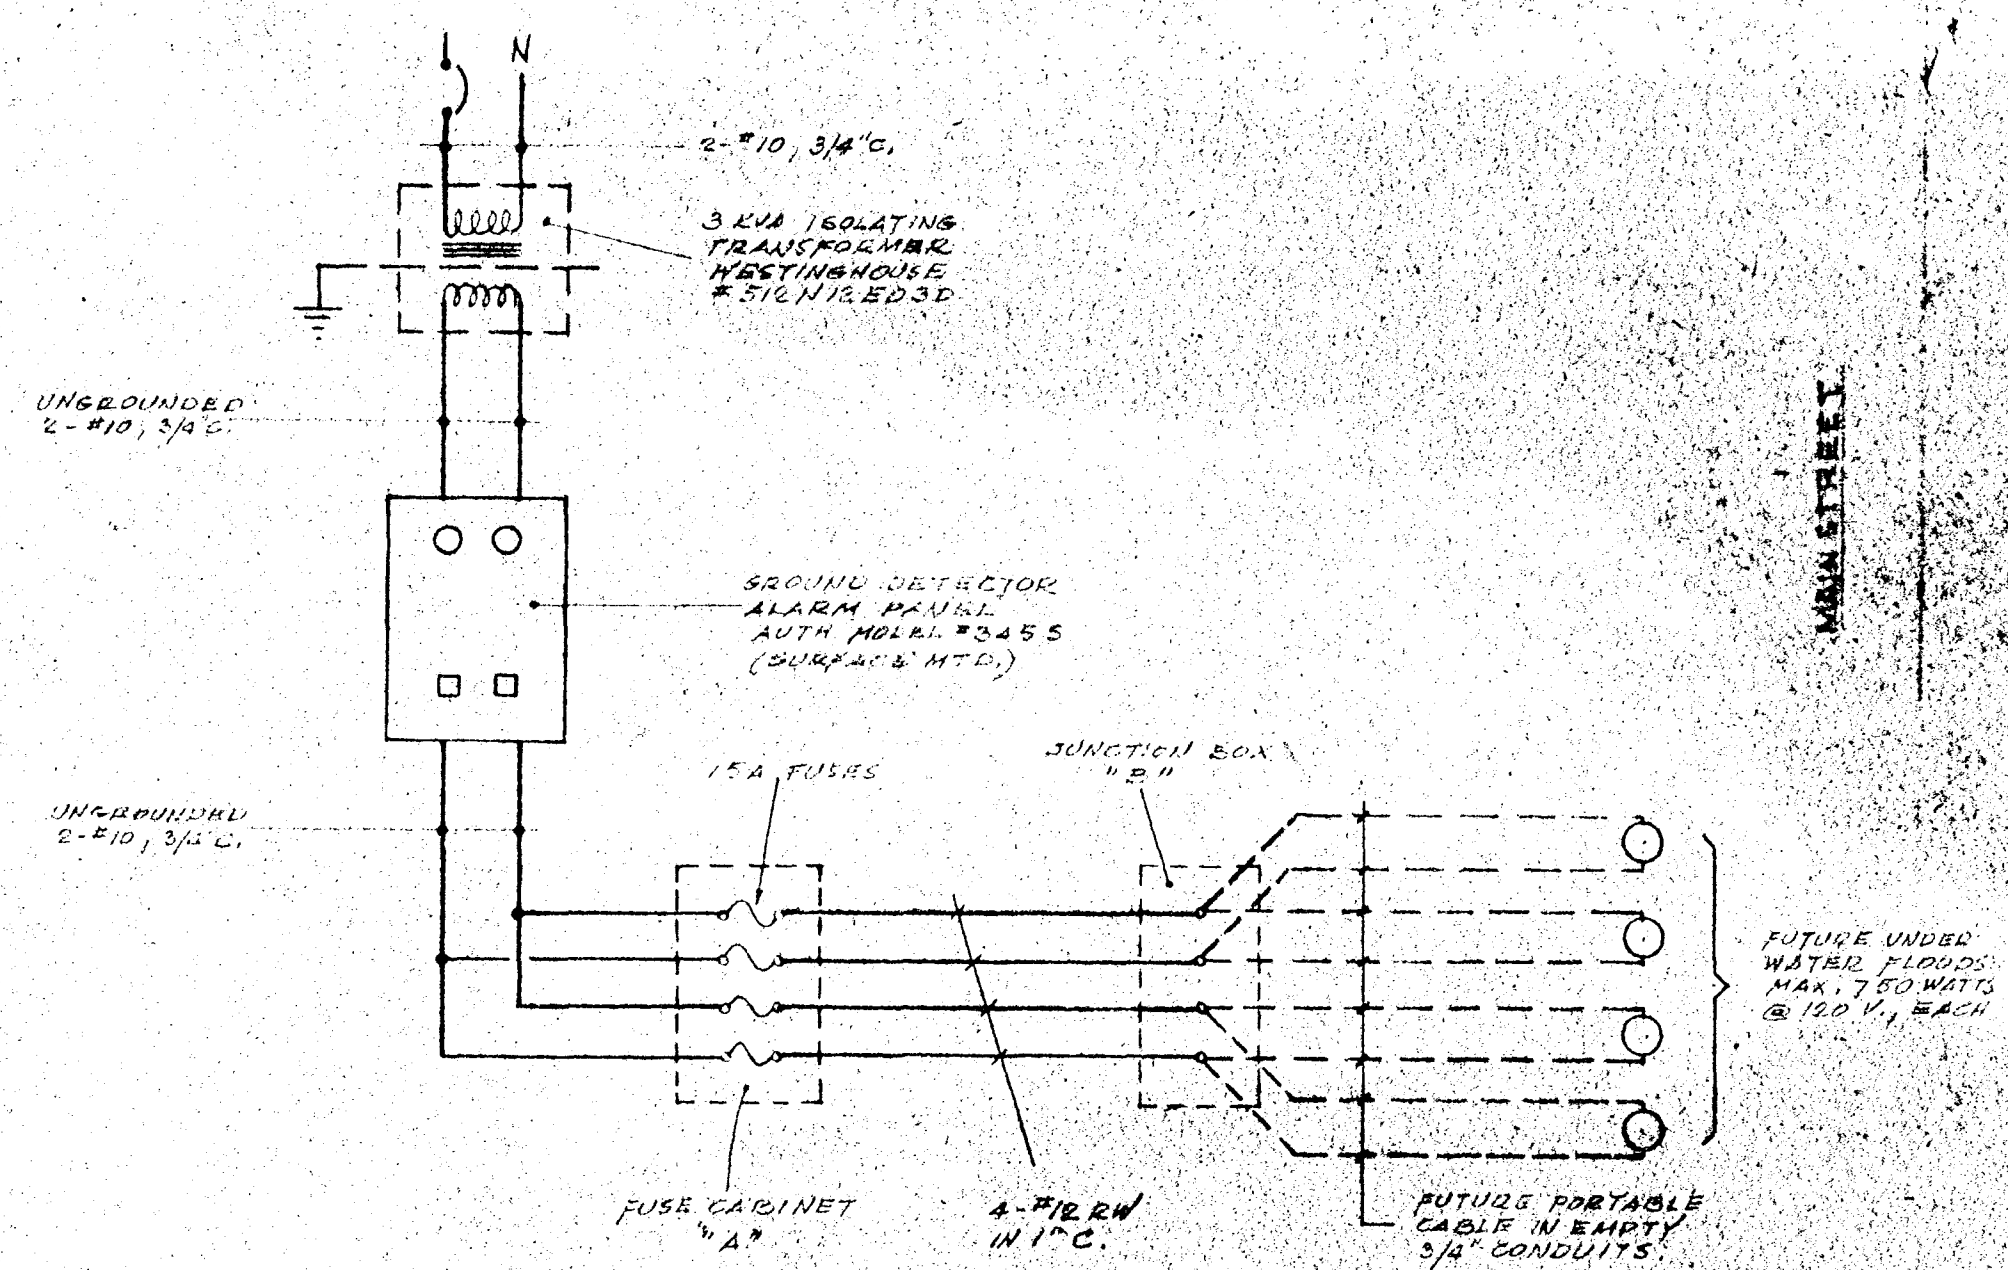


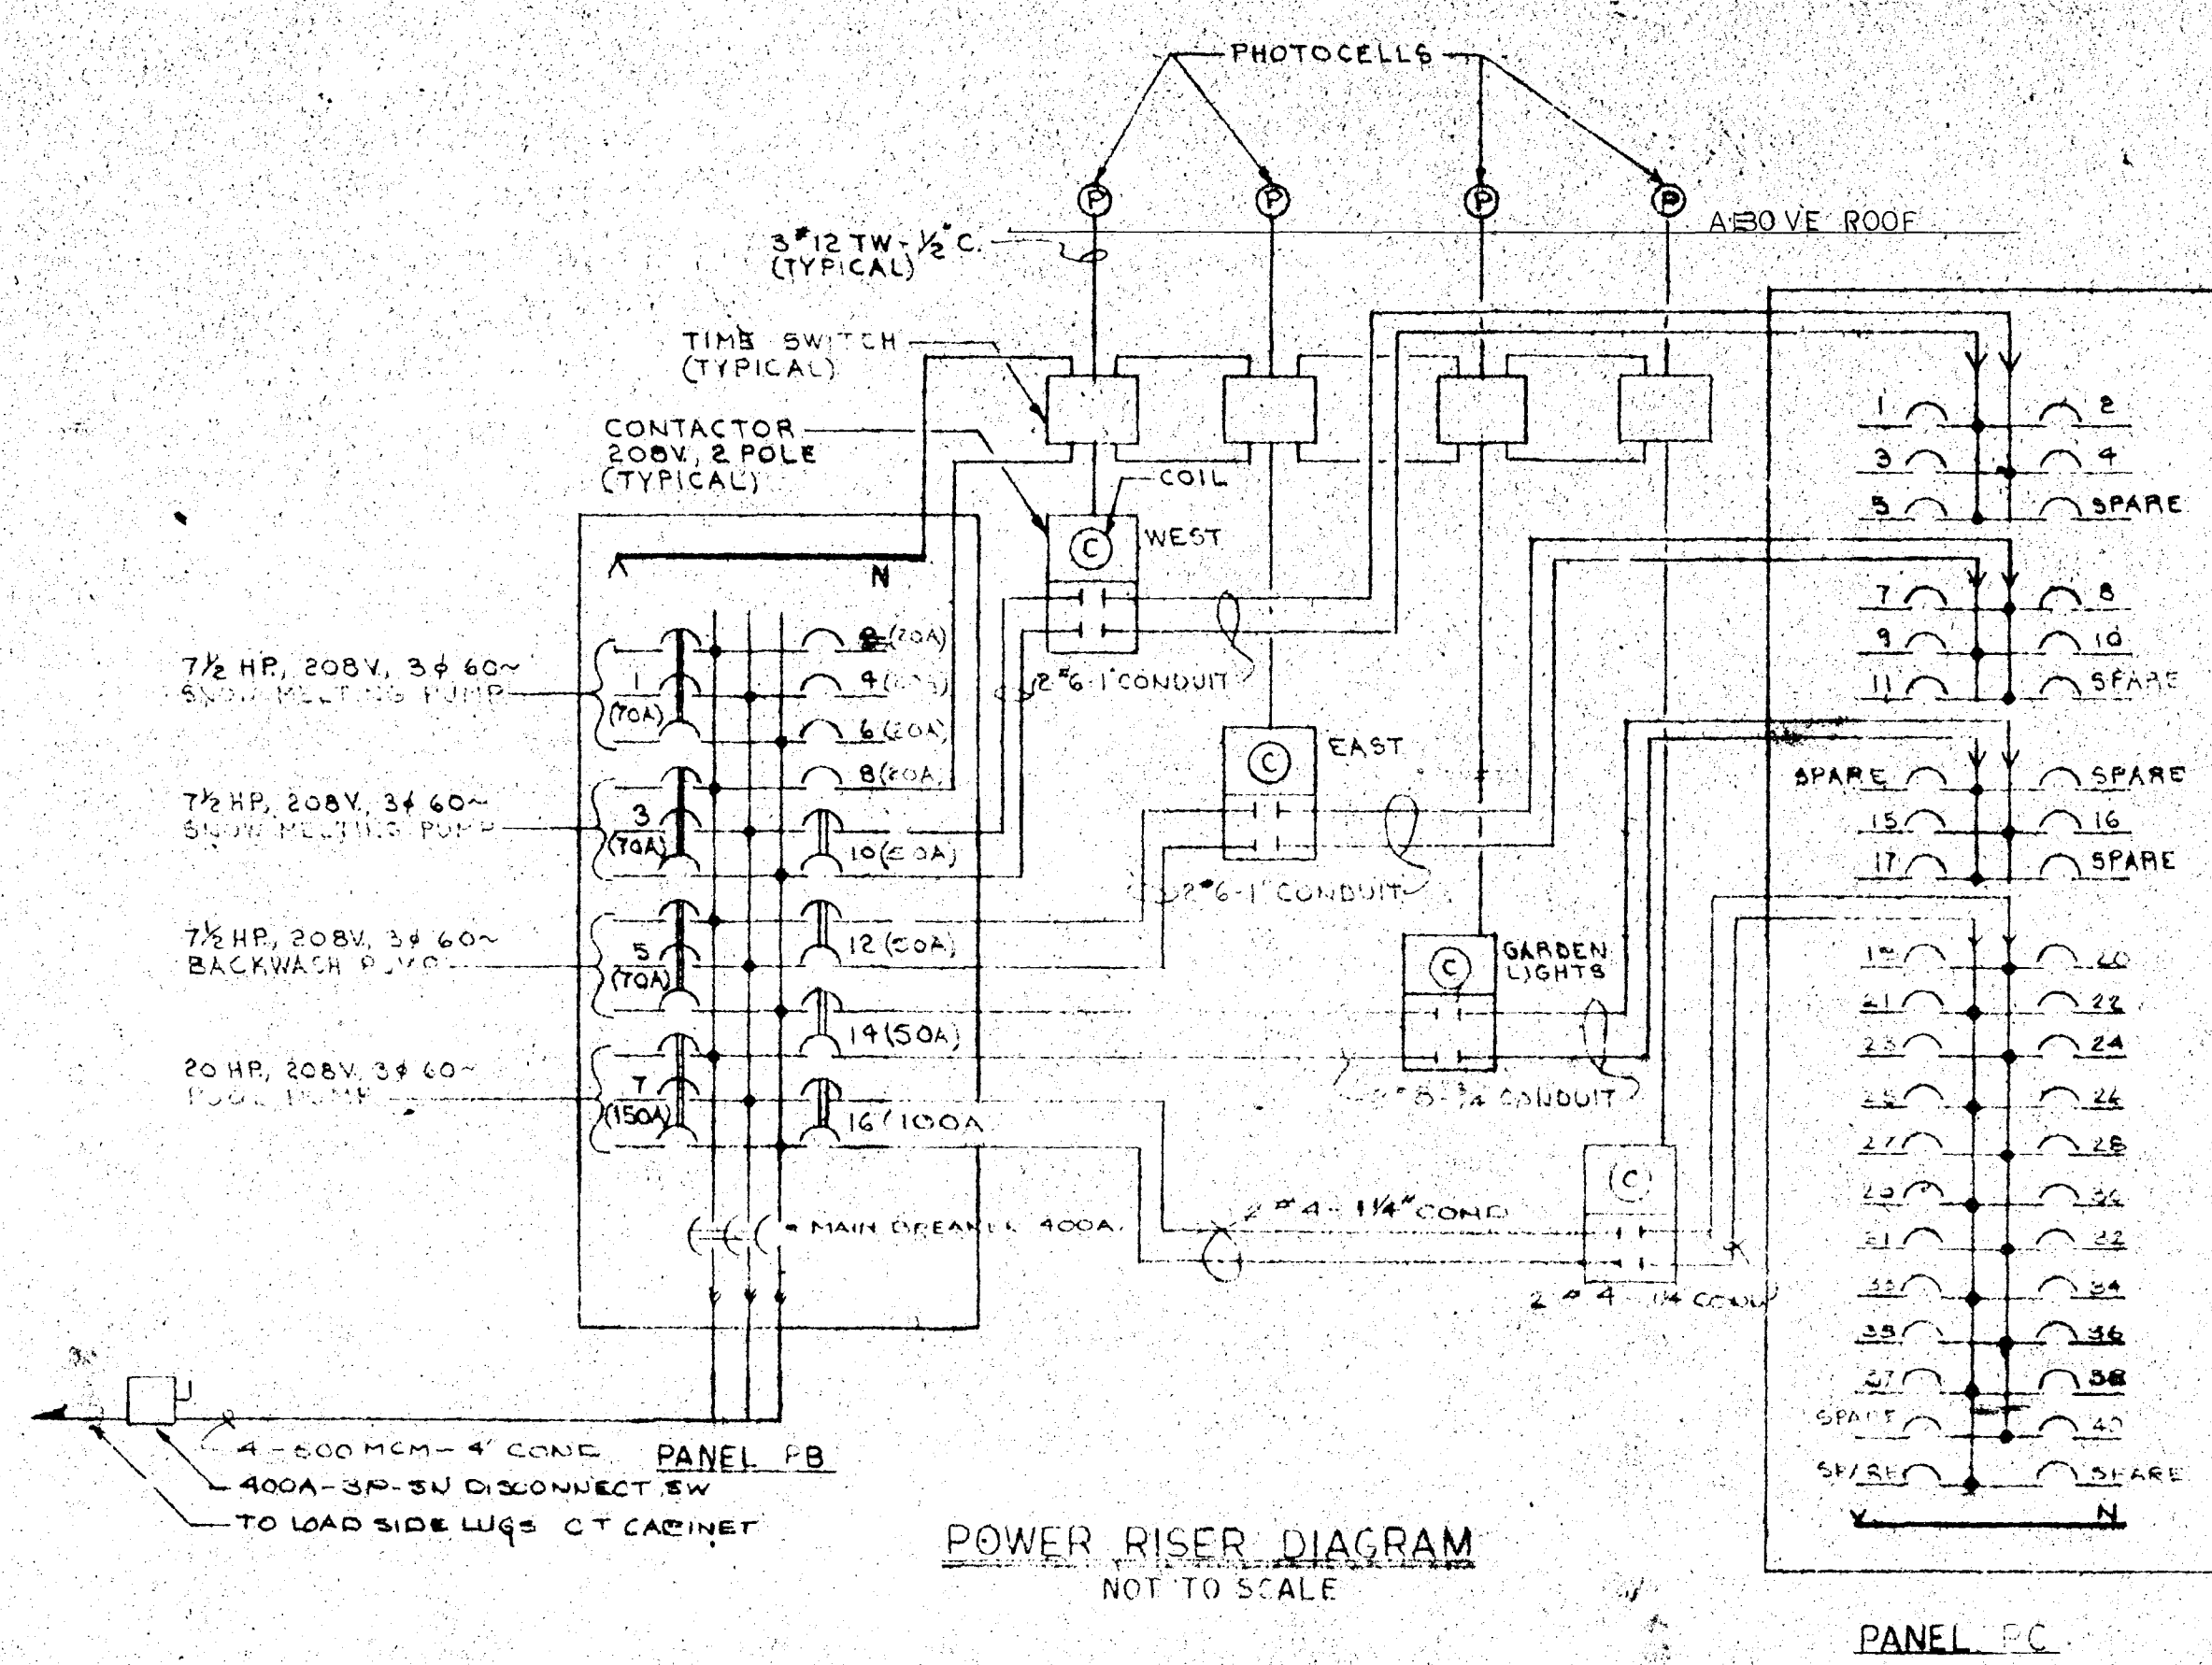

SCHEMATIC - UNDERWATER FLOODLIGHT WIRING
NOT TO SCALE

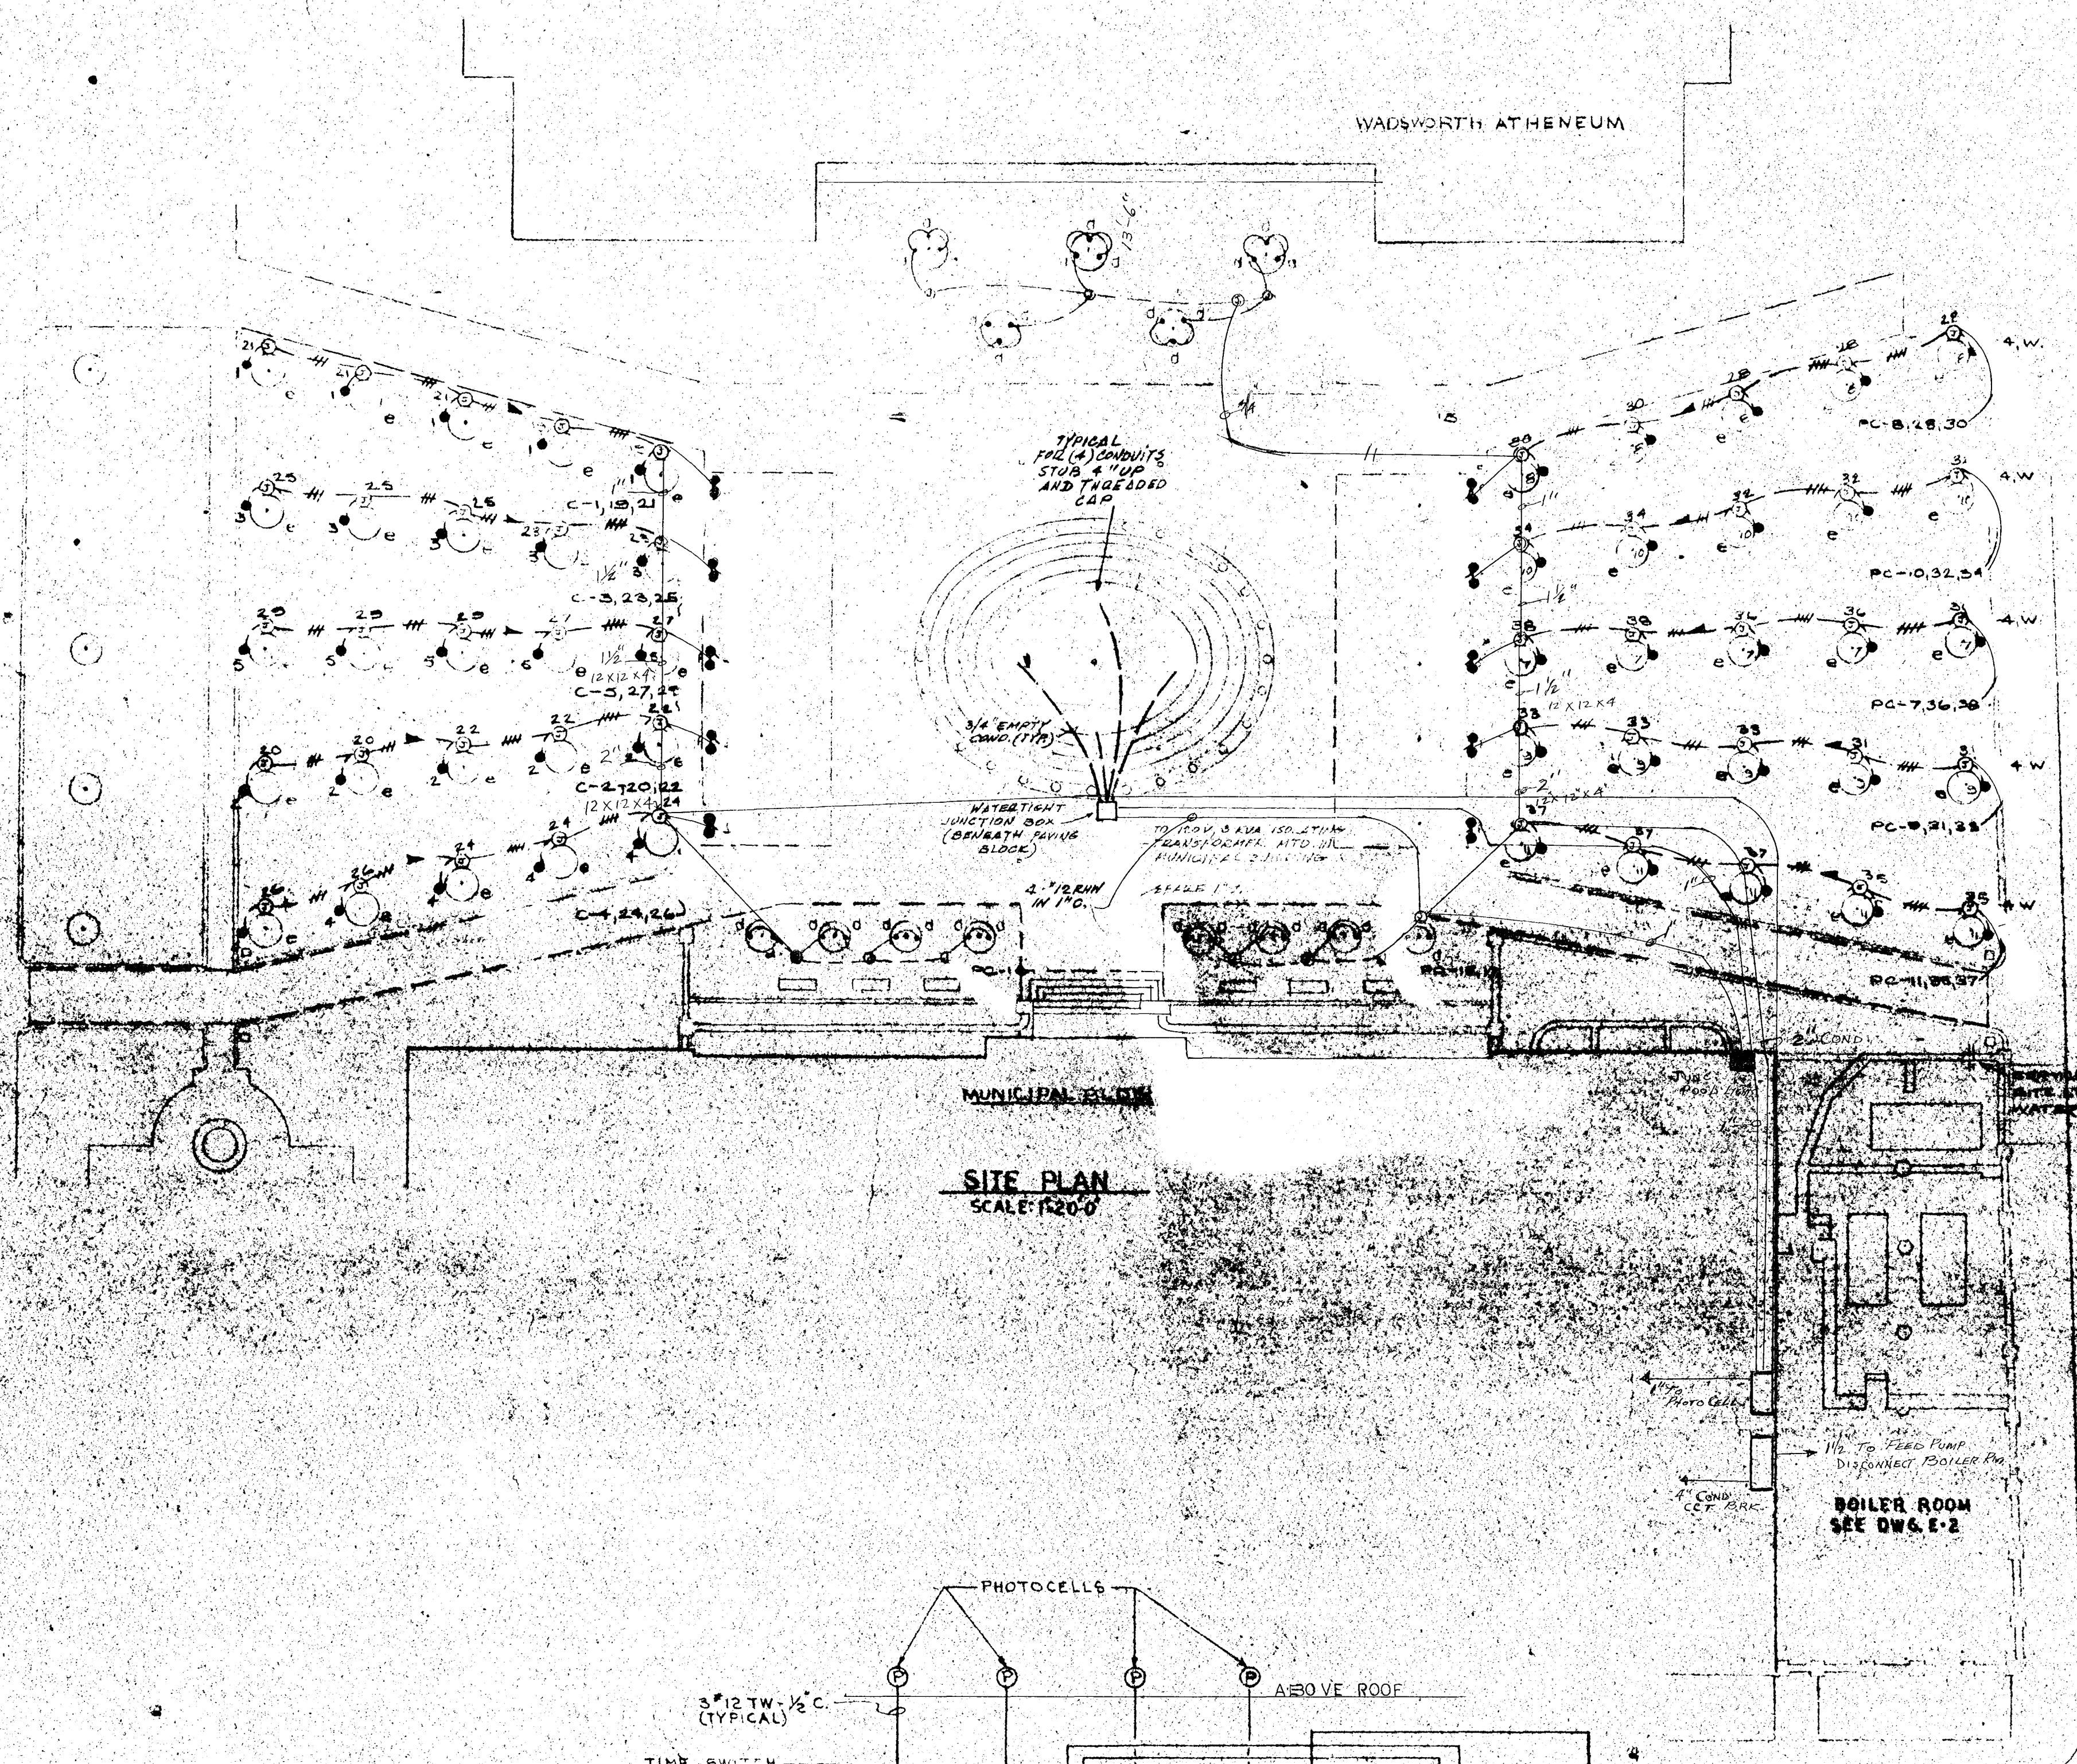

- NOTES
1. BRANCH CIRCUITS FOR 'E' FIXT & JUNCTION BOX OUTLETS WIRED WITH 4 #6-1' CONG.
 2. TIME SWITCHES SHALL NOT BE PROGRAMMED TO TURN OFF ALL LIGHTING OF THE MEMORIAL DURING THE NIGHT CYCLE.
 3. ALL JUNCTION BOXES TO BE LOCATED IN PLANTING OR GRAVEL AREAS.

RECEIVED
 MAY 16 1969
 BALDWIN-STEWART
 ELECTRIC COMPANY

Record Drawing
 REVISED OCT. 1, 1968
 REVISED JUNE 5, 1968

