


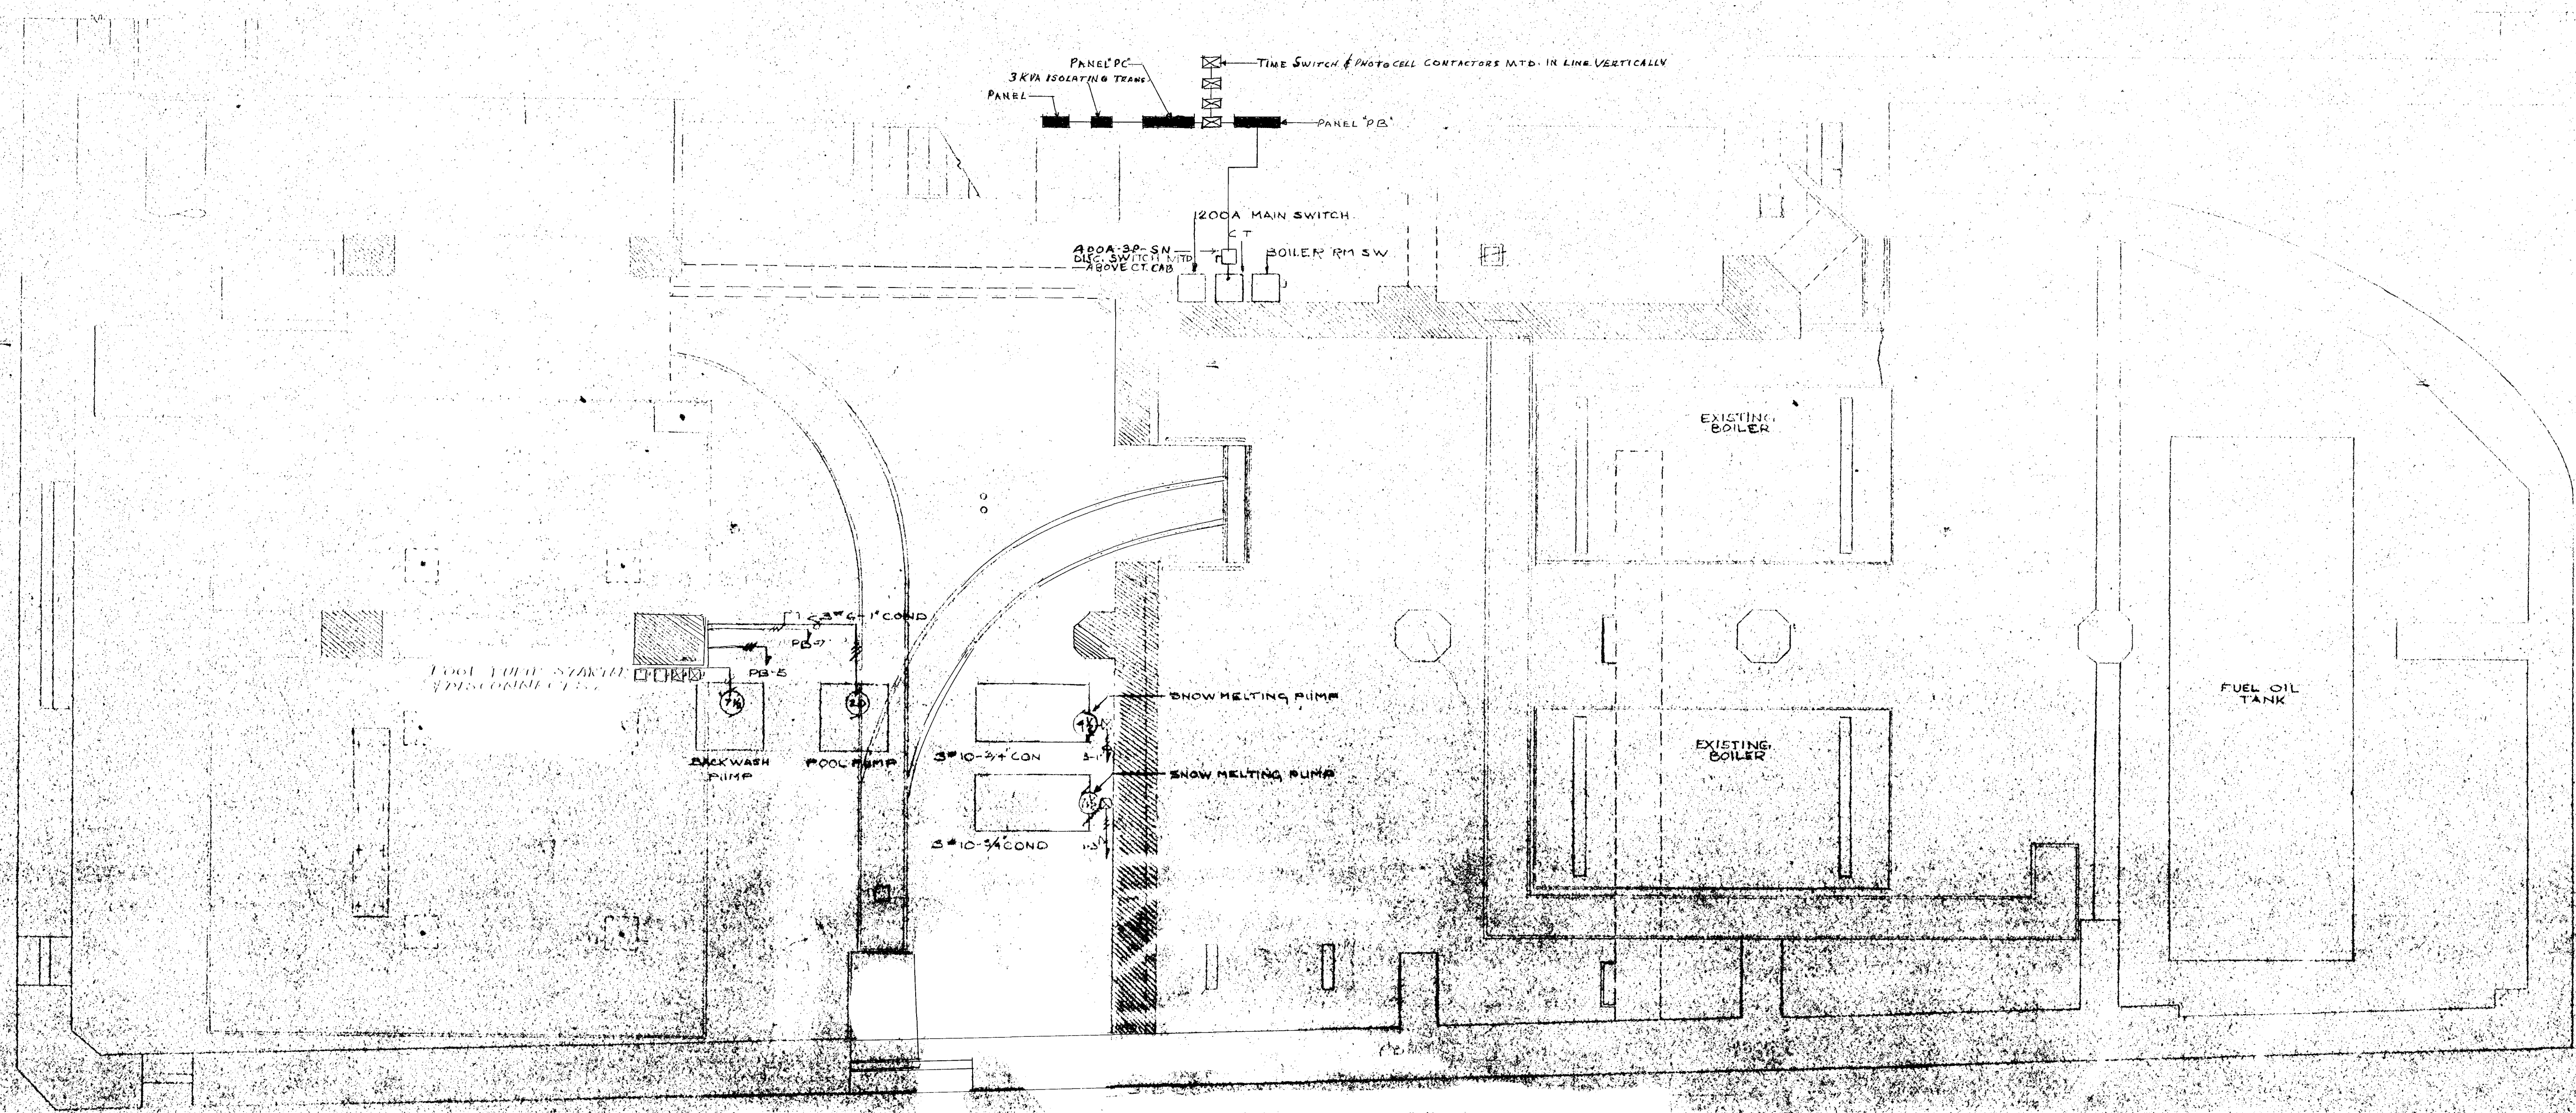

BOILER ROOM PLAN
SCALE 1/4" = 1'-0"

RECEIVED
MAY 10 1963
BALDWIN-STEWART
ELECTRIC COMPANY

RECEIVED
OCT 3 1963
GEORGE A. FULLER CO.

Record Drawing

