

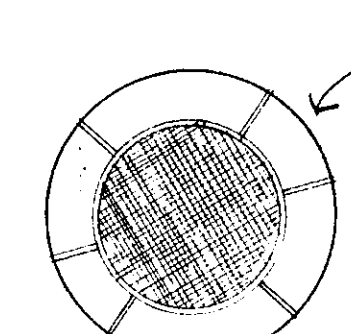
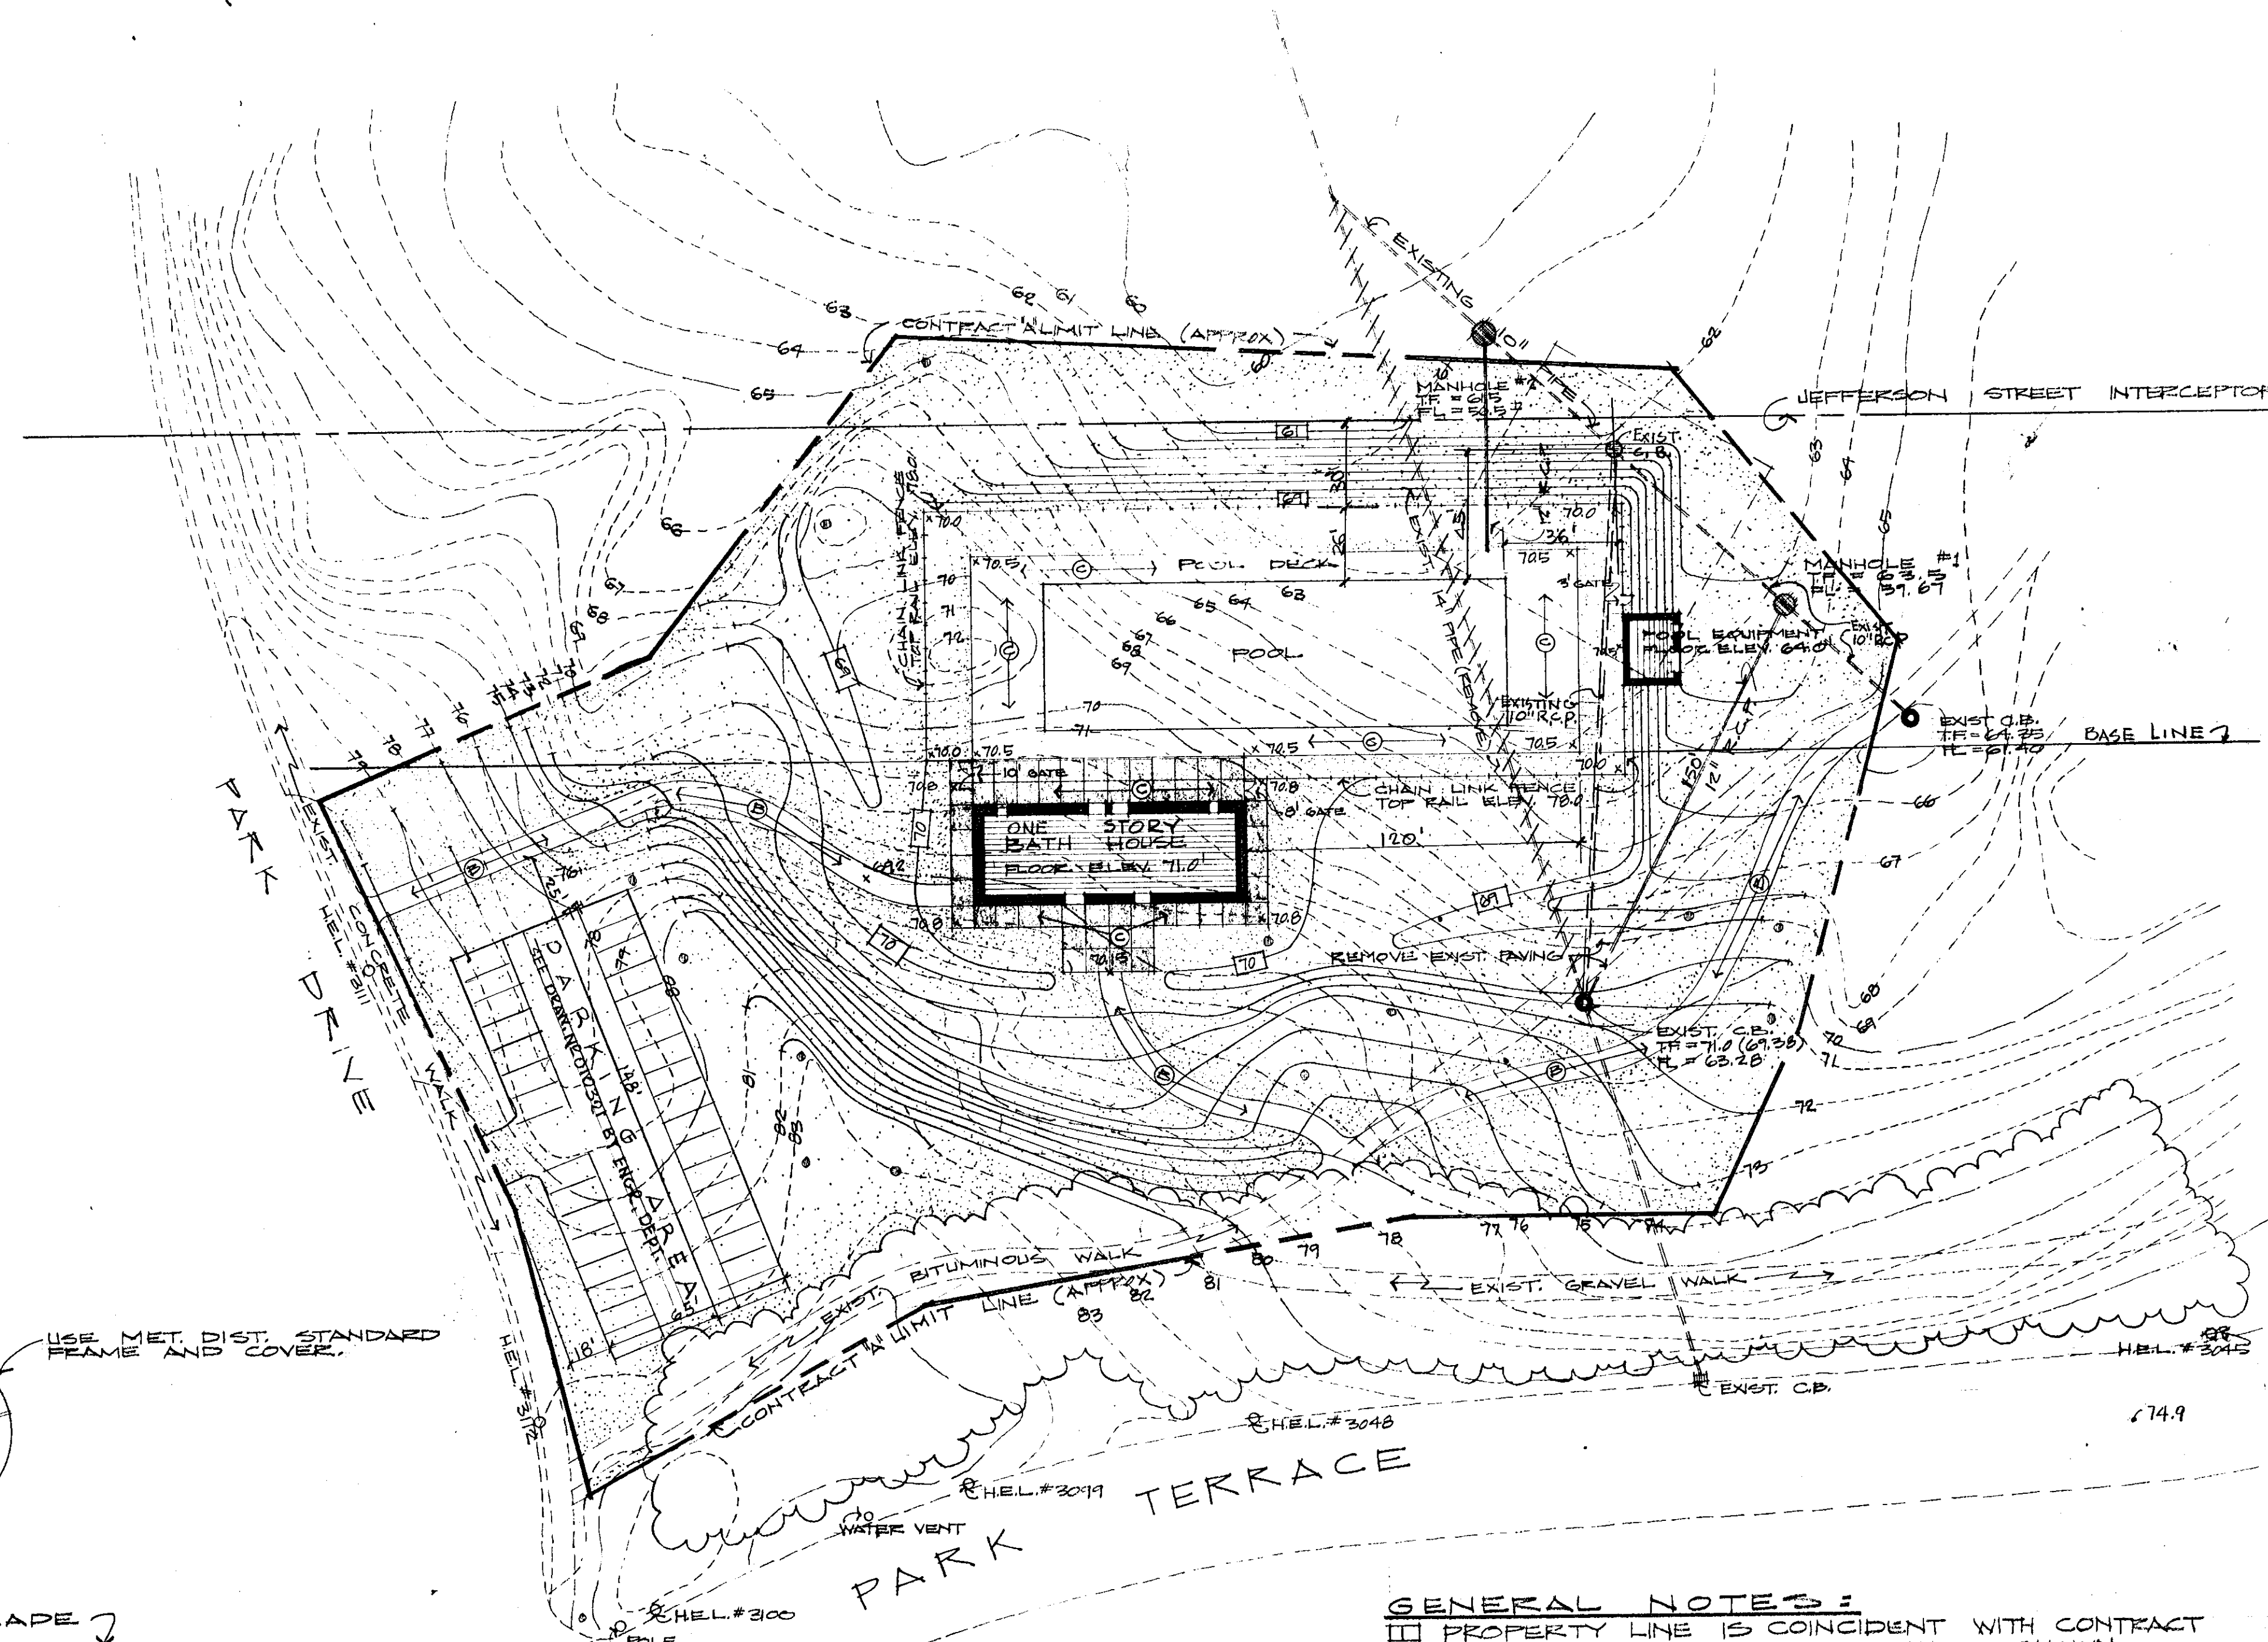


SITE PAVING SCHEDULE			
NOTE: ALL COURSE DEPTHS SHOWN AFTER FINAL COMPACTION			
SYMBOL	TYPE	SECTION	USE
(B)	BIT. CONC.	CLASS 2 BANK RUN GRAVEL	WALKS
(C)	REINFT. CONC.	8" x 8" STEEL BANK RUN GRAVEL CONCRETE COMPACTED SUB GRADE	WALKS & DECKS

NOTE: POWELT FOR CONCRETE WALK SHALL BE 3/8" x 24" LONG, 2" O.C. AND 12" FROM EDGE. WALK SHALL BE 2" O.C. PENETRATION FROM EDGE. WALK SHALL BE 2" O.C. PENETRATION FROM EDGE. WALK SHALL BE 2" O.C. PENETRATION FROM EDGE.

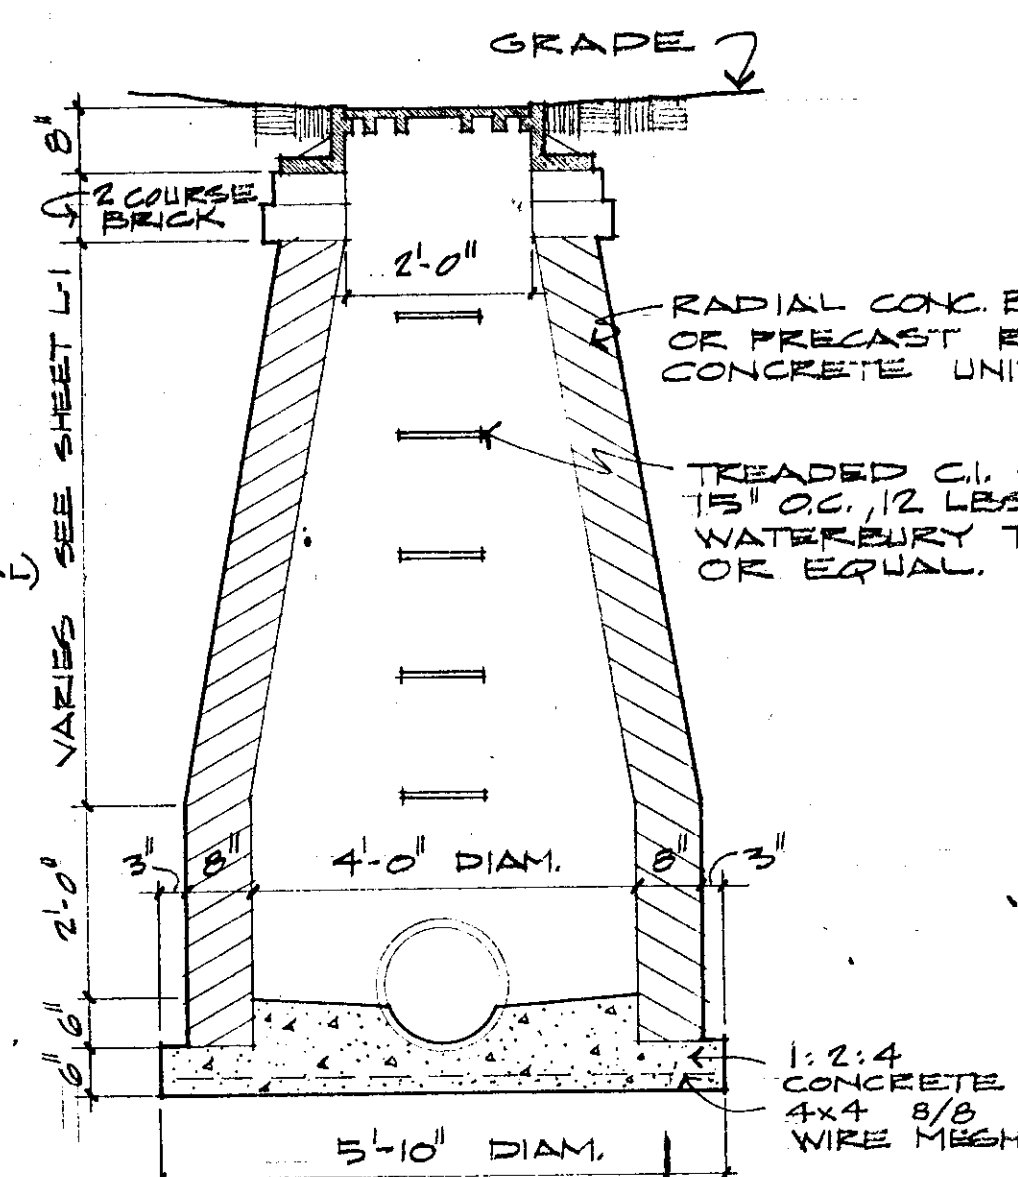

PLAN

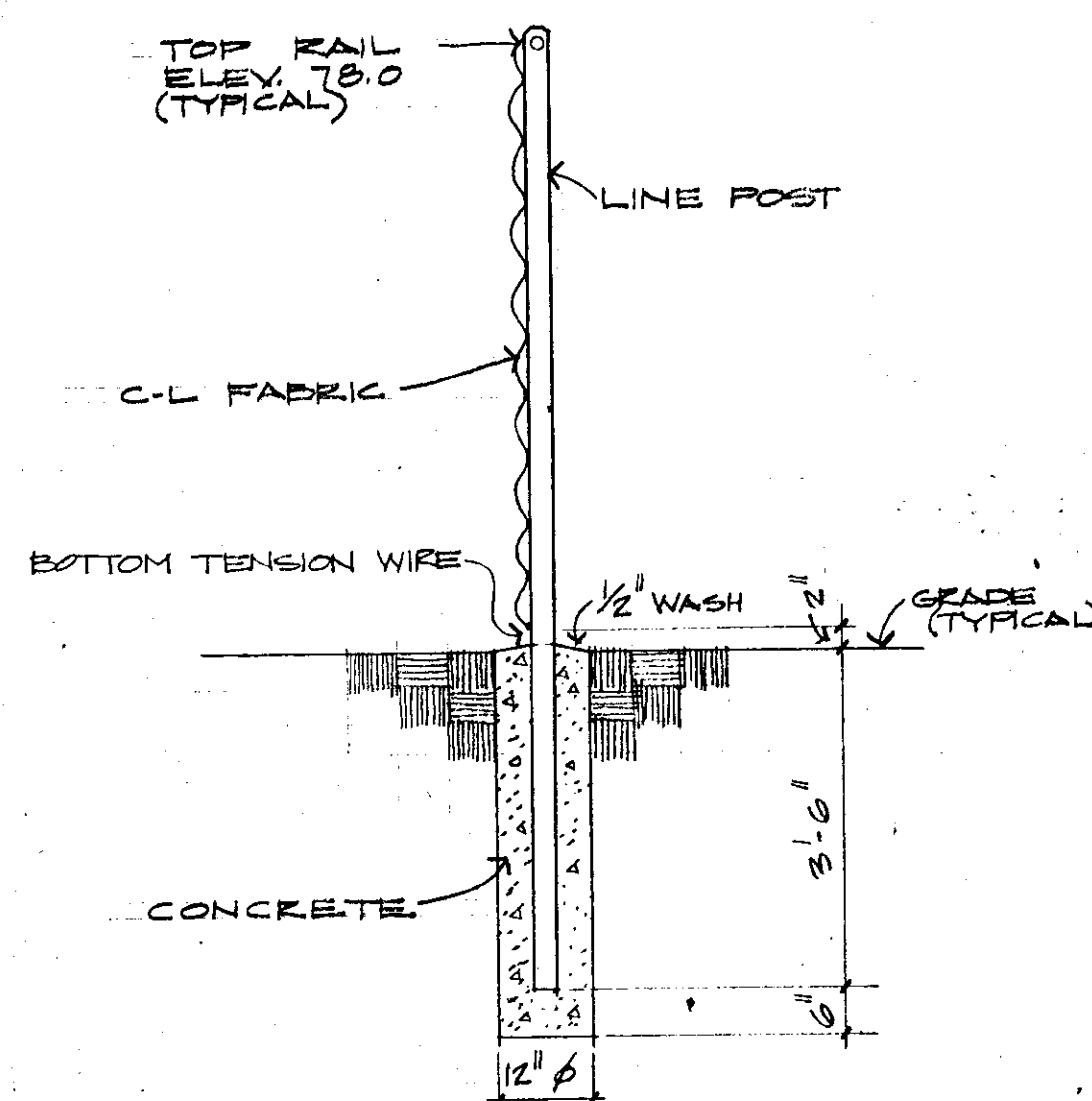

SECTION
MAN HOLE
NOT TO SCALE

SITE PLAN
SCALE: 1" = 40'

- LEGEND:**
- 75 --- EXISTING CONTOUR
 - 75.5 --- PROPOSED CONTOUR
 - x 75.5 PROPOSED SPOT ELEVATION
 - CONTRACT LIMIT LINE
 - C.B. CATCH BASIN
 - MANHOLE
 - TOP OF FRAME
 - FLOW LINE
 - EXPANSION JOINT
 - DUMMY JOINT (SCORE LINE)
 - PROPOSED FENCE
 - EXISTING TREE
 - REINFORCED CONCRETE PIPE
 - UTILITY POLE
 - CONCRETE PAVEMENT
 - BITUMINOUS PAVEMENT

GENERAL NOTES:

1. PROPERTY LINE IS COINCIDENT WITH CONTRACT LIMIT LINE UNLESS OTHERWISE SHOWN.
2. CONTRACTOR SHALL BE RESPONSIBLE FOR ANY DAMAGE INSIDE AND OUTSIDE CONTRACT LIMIT LINE DUE TO CONSTRUCTION OPERATIONS.
3. CONTRACTOR SHALL BLEND NEW WORK SMOOTHLY WITH EXISTING GRADES AND IMPROVEMENTS AT CONTRACT LIMIT LINE.
4. ALL AREAS UPON WHICH CONSTRUCTION DOES NOT OCCUR WITHIN CONTRACT LIMIT LINE SHALL BE TOP SOILED (MINIMUM 6") AND SEEDED UNLESS OTHERWISE SHOWN.
5. ALL WALKS SHALL HAVE 1/4" PER FOOT CROSS PITCH UNLESS OTHERWISE SHOWN.
6. WOOD SCREED STRIPS SHALL BE PROVIDED FOR ALL BITUMINOUS PAVING WHERE BORDERING AREAS TO BE SEEDED UNLESS OTHERWISE SHOWN.
7. BOUNDARY DATA AND TOPOGRAPHIC INFORMATION SUPPLIED BY THE CITY OF HARTFORD, DEPT. OF ENGINEERING.

DRAINAGE NOTES:

1. ALL GRATES AND/OR COVERS OF DRAINAGE STRUCTURES SHALL HAVE APPROVED LOOKING DEVICES.

REVISIONS		
NO.	DATE	REMARKS

PROJECT TITLE
POPE PARK POOL & BATHHOUSE


ASSOCIATED ARCHITECTS
FARMINGTON • CONNECTICUT • 06032

LAND PLANNER
MAINE & TILLAPPAUGH
WEST HARTFORD CONNECTICUT

MECHANICAL ENGINEER
BURTON & VAN HOUTEN
WEST HARTFORD CONNECTICUT

STRUCTURAL ENGINEER
BURTON & VAN HOUTEN
WEST HARTFORD CONNECTICUT

CORRECT AS BUILT DEC. 20-79

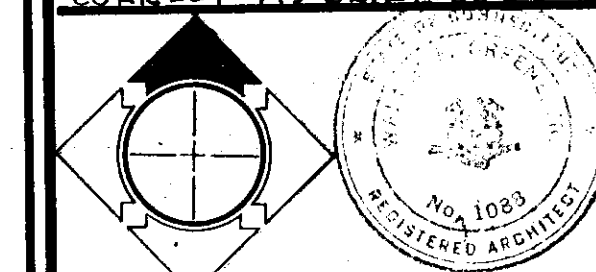

SHEET TITLE
**SITE GRADING & DRAINAGE PLAN
SITE DETAILS**

PROJECT NO. 6040
DRAWN BY: G.F.N.
CHECKED BY:
APPROVED BY:
DATE: 11 SEP 1970
SHEET 1 OF 2

L1