


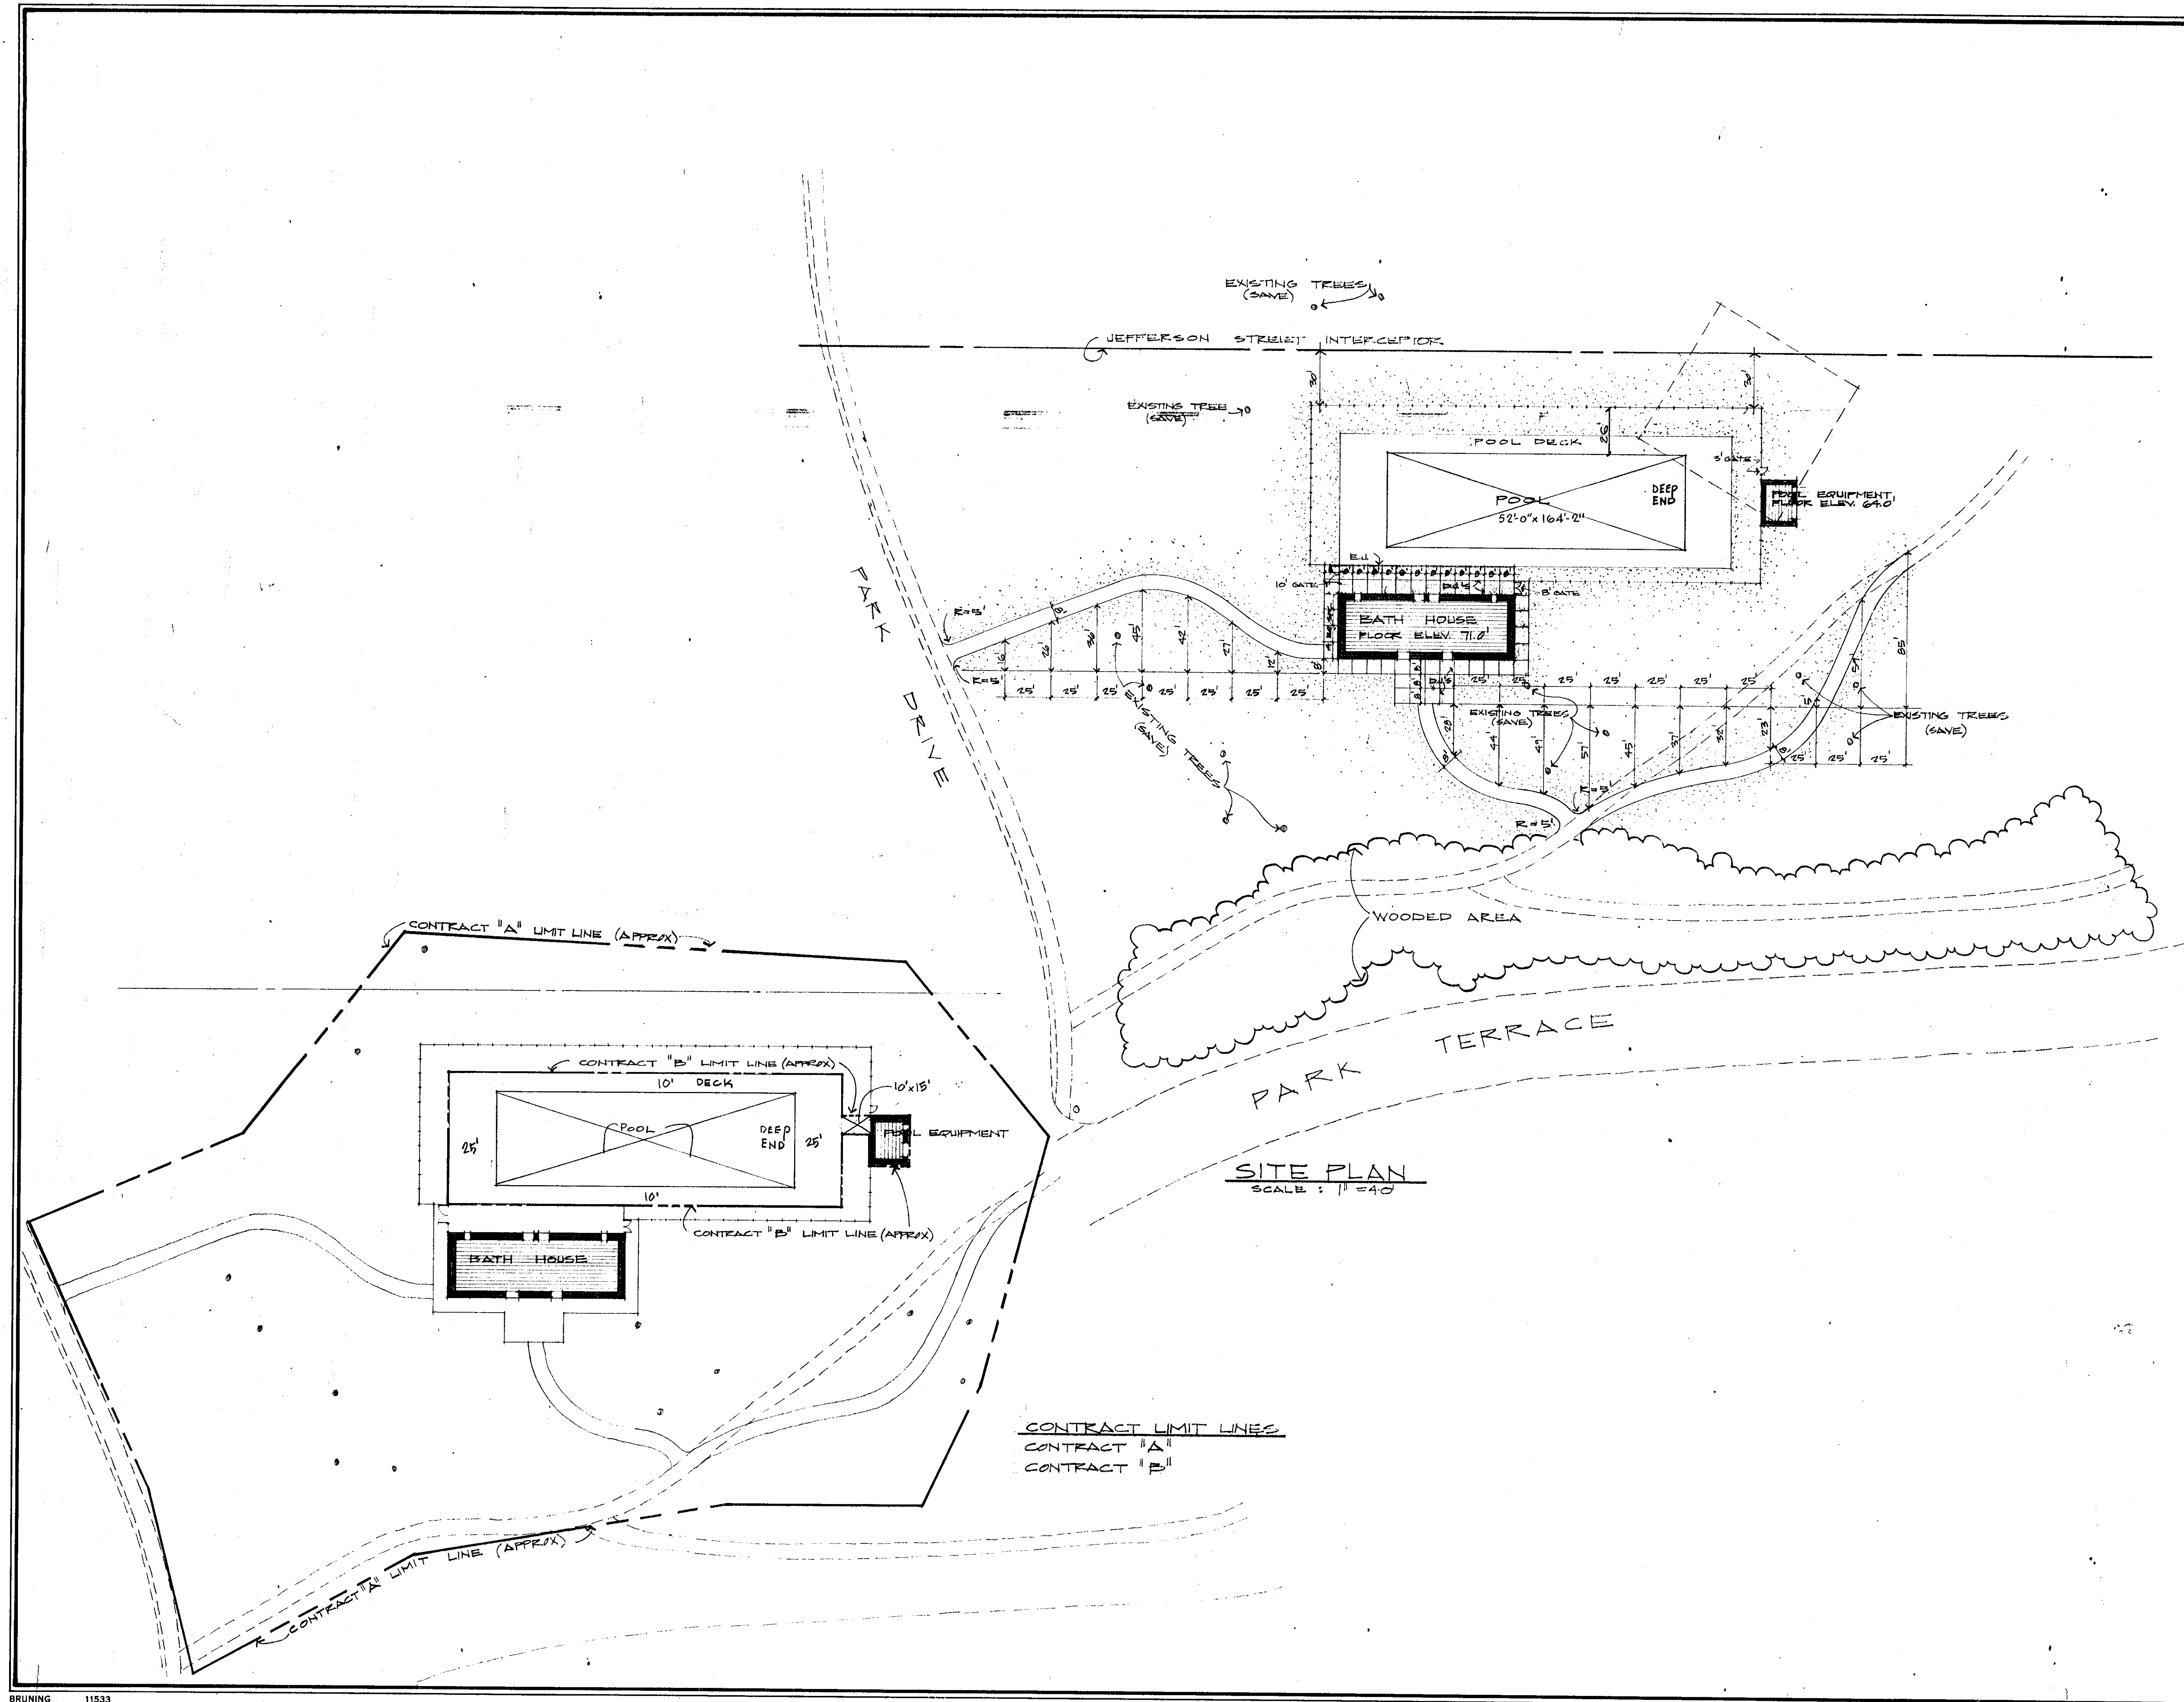

REVISIONS		
NO.	DATE	REMARKS

PROJECT TITLE
POPE PARK POOL & BATHHOUSE

ASSOCIATED ARCHITECTS
 FARMINGTON - CONNECTICUT - 06032

LAND PLANNER
MAINE & TILLAPPAUGH
 WEST HARTFORD CONNECTICUT

STRUCTURAL ENGINEER
BURTON & VAN HOUTEN
 WEST HARTFORD CONNECTICUT

MECHANICAL ENGINEER
BURTON & VAN HOUTEN
 WEST HARTFORD CONNECTICUT

CORRECT AS BUILT DEC. 20-72

STATE OF CONNECTICUT
 REGISTERED ARCHITECT
 No. 1098

SHEET TITLE
**SITE LAYOUT
 CONTRACT LIMIT LINES**

PROJECT NO. 60410 SHEET NO.
 DRAWN BY: **GEN**
 CHECKED BY: **L2**
 APPROVED BY: **L2**
 DATE: **SEP 17 1972** SHEET **2** OF **2**