




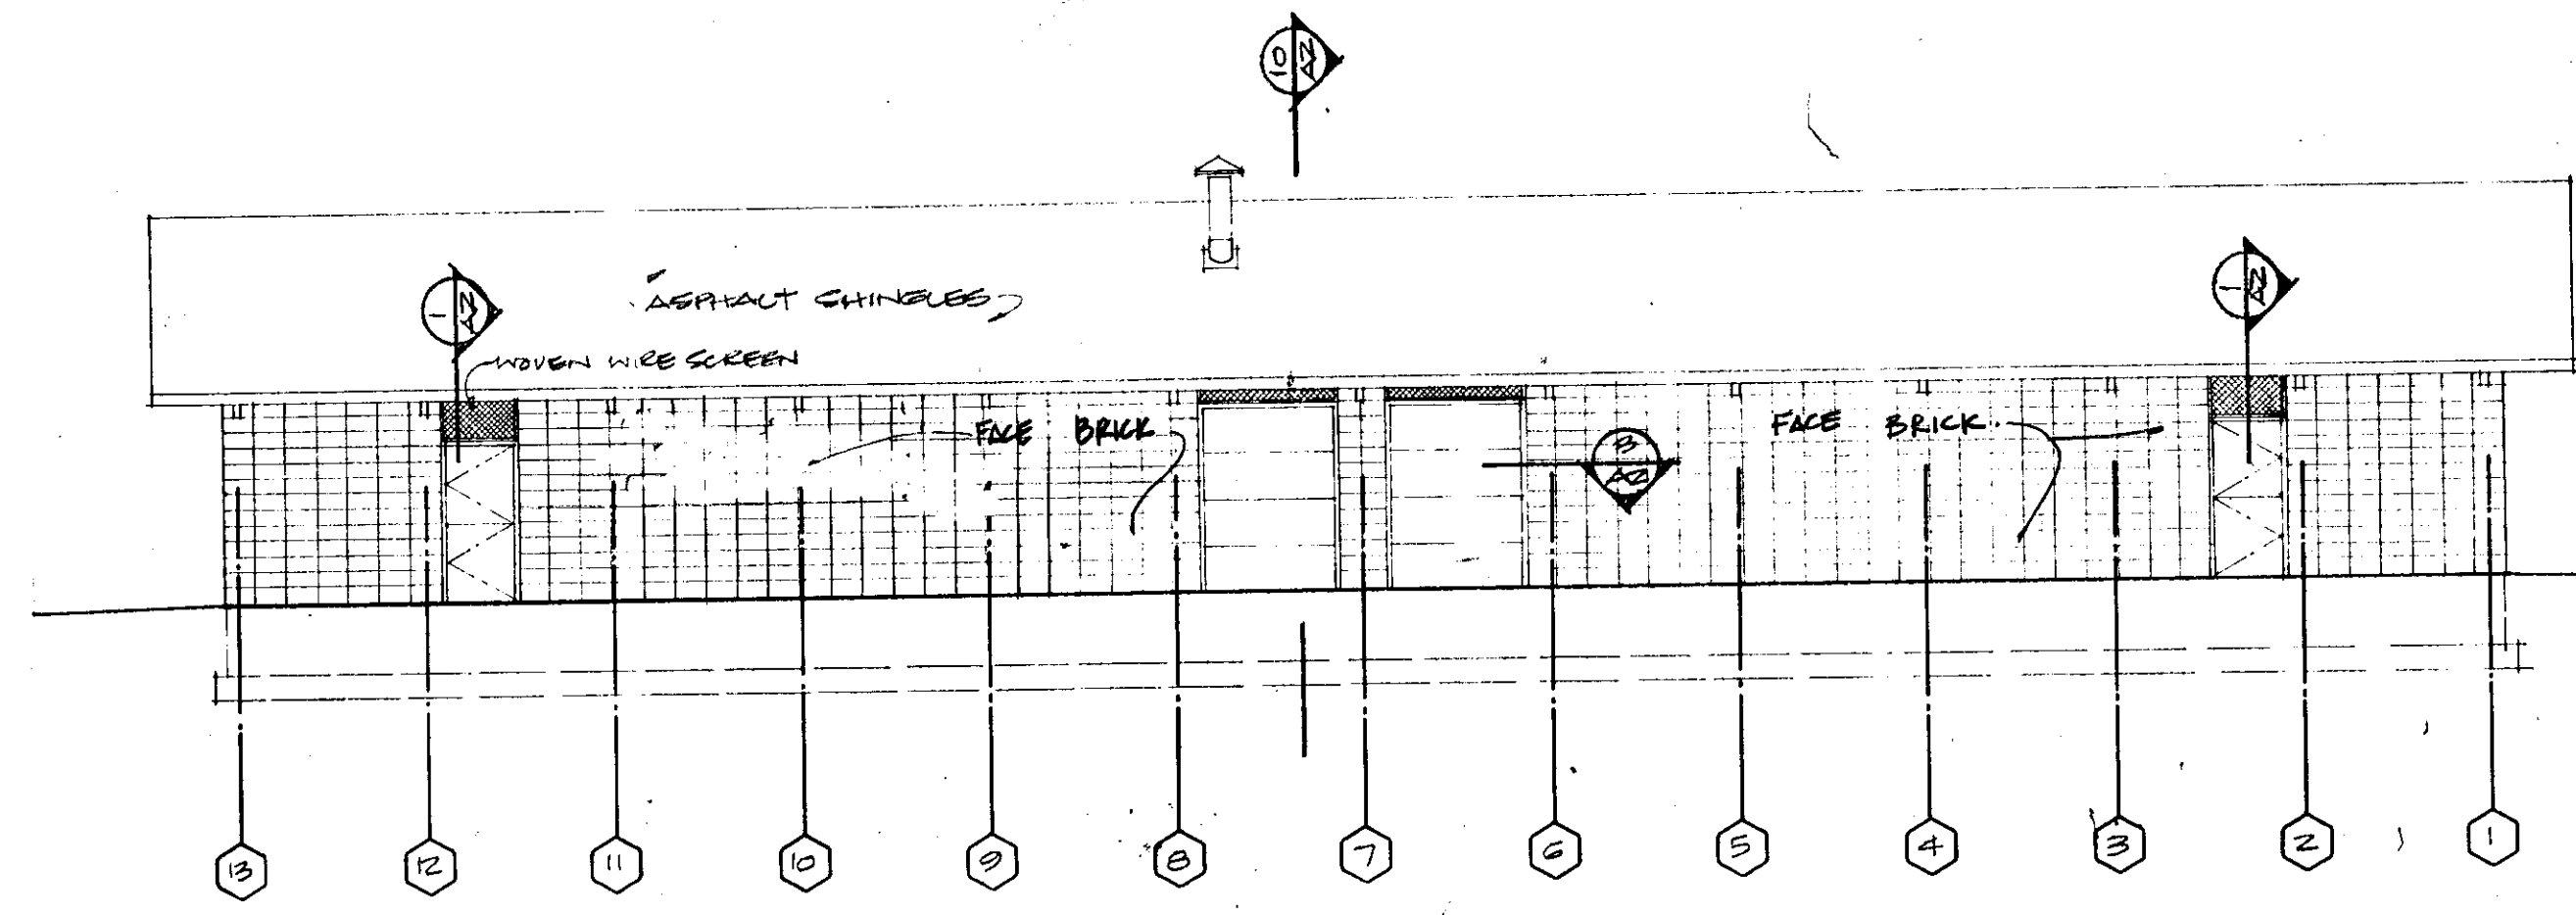


NORTH ELEVATION

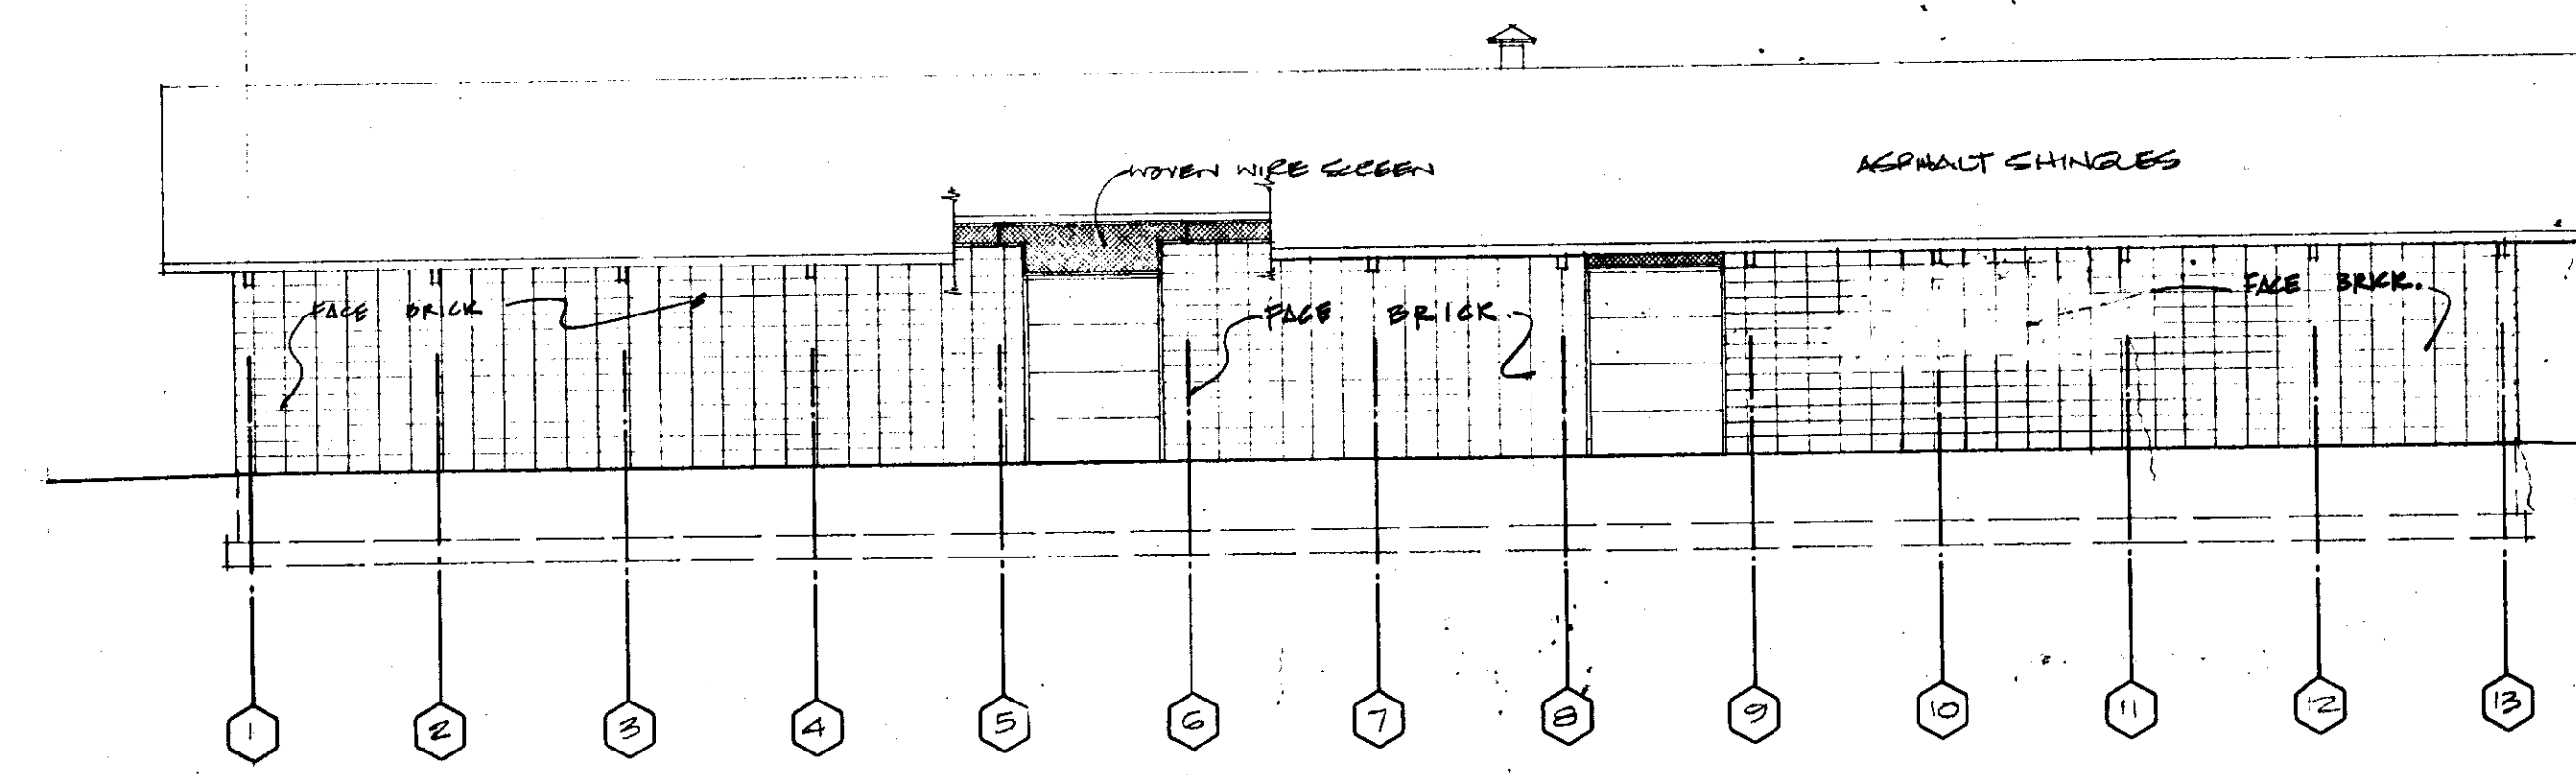

SOUTH ELEVATION

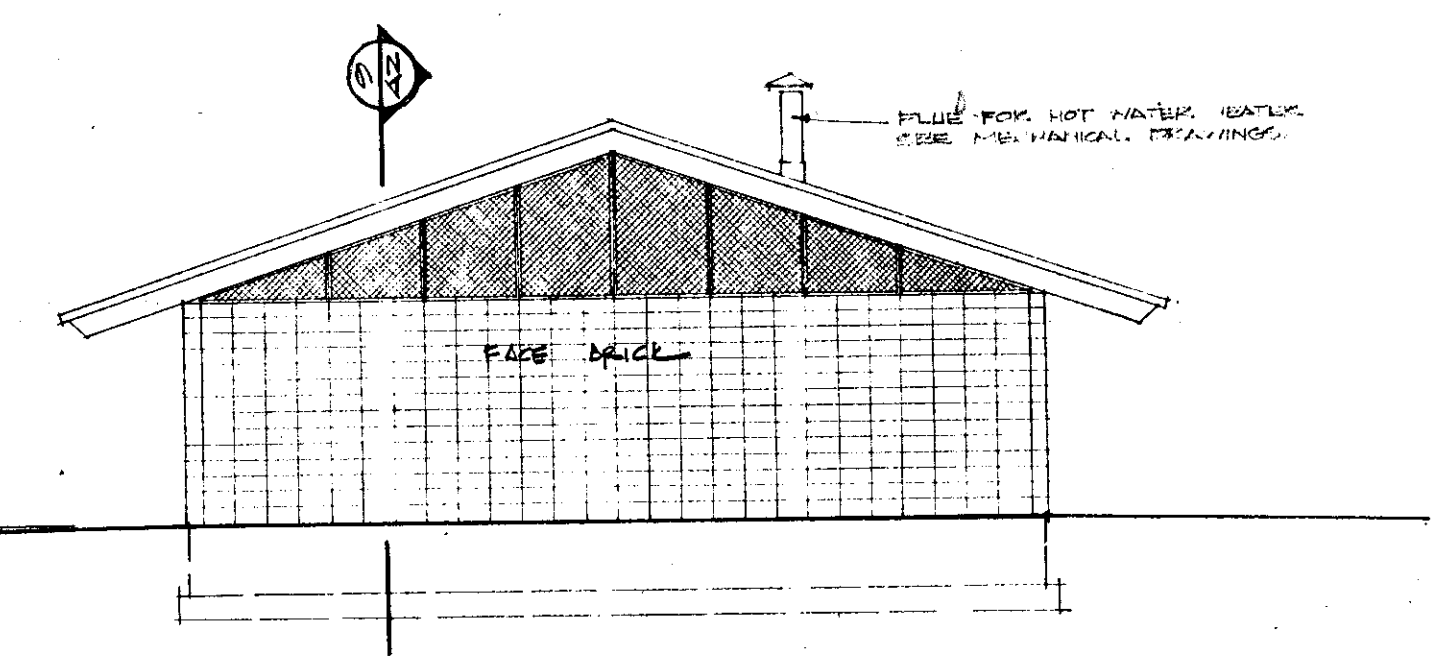

EAST & WEST ELEVATIONS

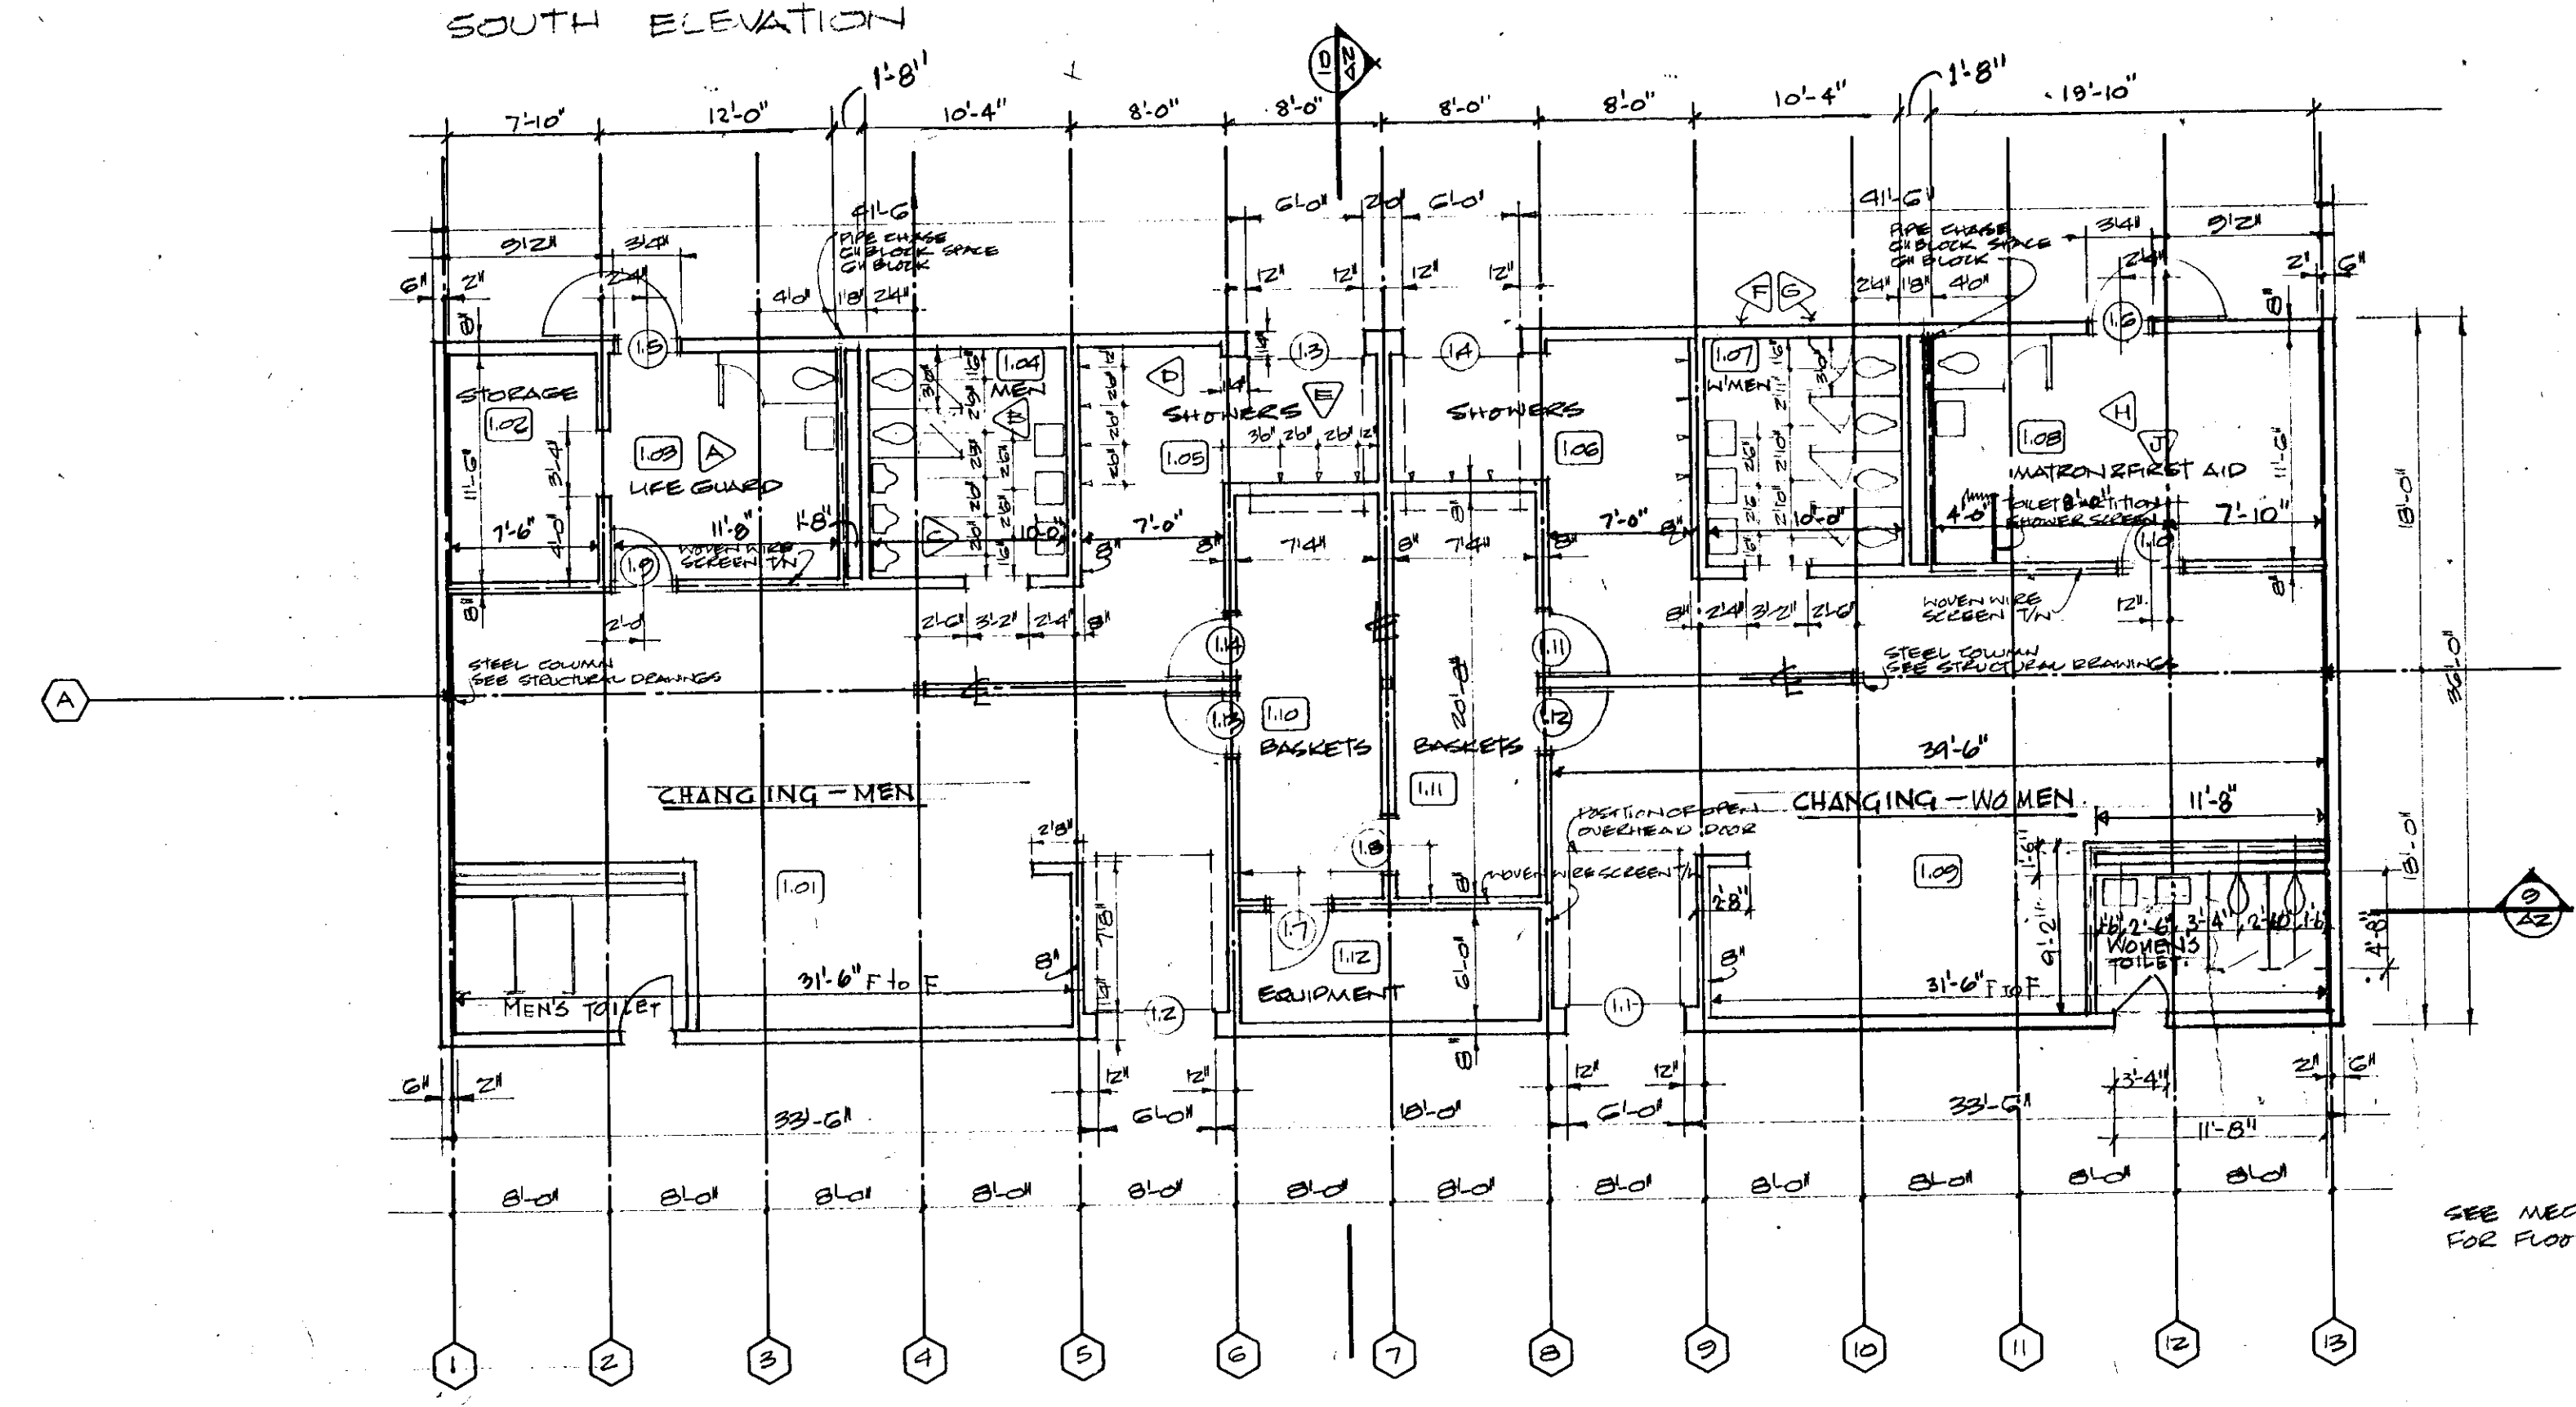

SEE MECHANICAL DRAWINGS
FOR FLOOR DRAIN LOCATIONS

REVISIONS		
NO.	DATE	REMARKS

PROJECT TITLE
**POPE TANK POOL
&
BATHHOUSE**

**ASSOCIATED
ARCHITECTS**
FARMINGTON - CONNECTICUT - 06032

LAND PLANNER
MAINE & TILLAPPAUGH
WEST HARTFORD - CONNECTICUT

MECHANICAL ENGINEER
BURTON & VAN HOUTEN
WEST HARTFORD - CONNECTICUT

STRUCTURAL ENGINEER
BURTON & VAN HOUTEN
WEST HARTFORD - CONNECTICUT

75

CORRECT AS BUILT DEC. 20-72

SHEET TITLE
**FLOOR PLAN &
ELEVATIONS**

PROJECT NO. 2470
DRAWN BY JG
CHECKED BY WFG
APPROVED BY WFG
DATE 11 SEPT 1970

SHEET NO.
AI
SHEET 1 OF 4