

REVISIONS

NO.	DATE	REMARKS

PROJECT TITLE

POPE PARK POOL
&
BATHHOUSE

ASSOCIATED ARCHITECTS
FARMINGTON • CONNECTICUT • 06032

LAND PLANNER

MAINE & TILLAPPAUGH
WEST HARTFORD CONNECTICUT


MECHANICAL ENGINEER

BURTON & VAN HOUTEN
WEST HARTFORD CONNECTICUT

STRUCTURAL ENGINEER

BURTON & VAN HOUTEN
WEST HARTFORD CONNECTICUT

CORRECT AS BUILT DEL. 70-72

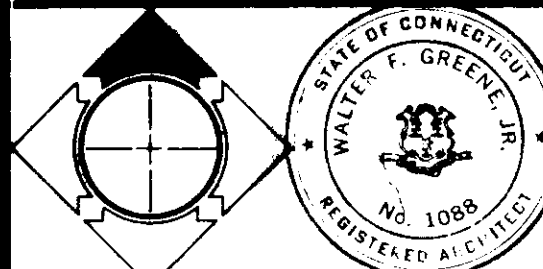

SHEET TITLE
POOL DECK LAYOUT
POOL PROFILE & CONTRACT
LIMIT LINE SECTIONS

PROJECT NO. 60410

DRAWN BY CEN

CHECKED BY WMS


APPROVED BY WMS

DATE: SEPT 1970


SHEET NO.

A4


SHEET 4 OF 4

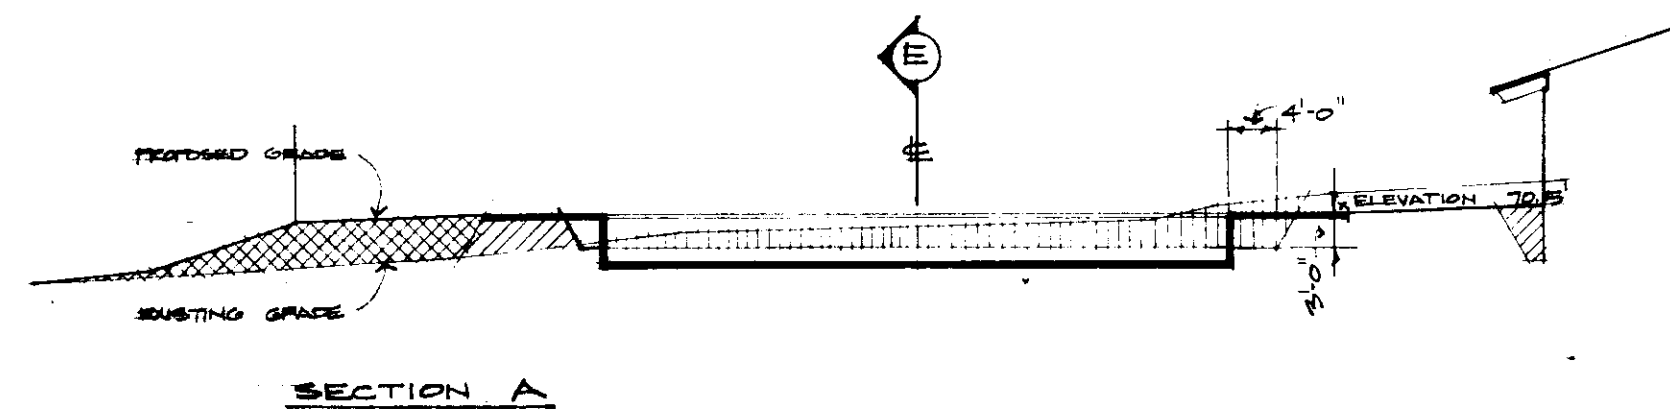


SECTION A

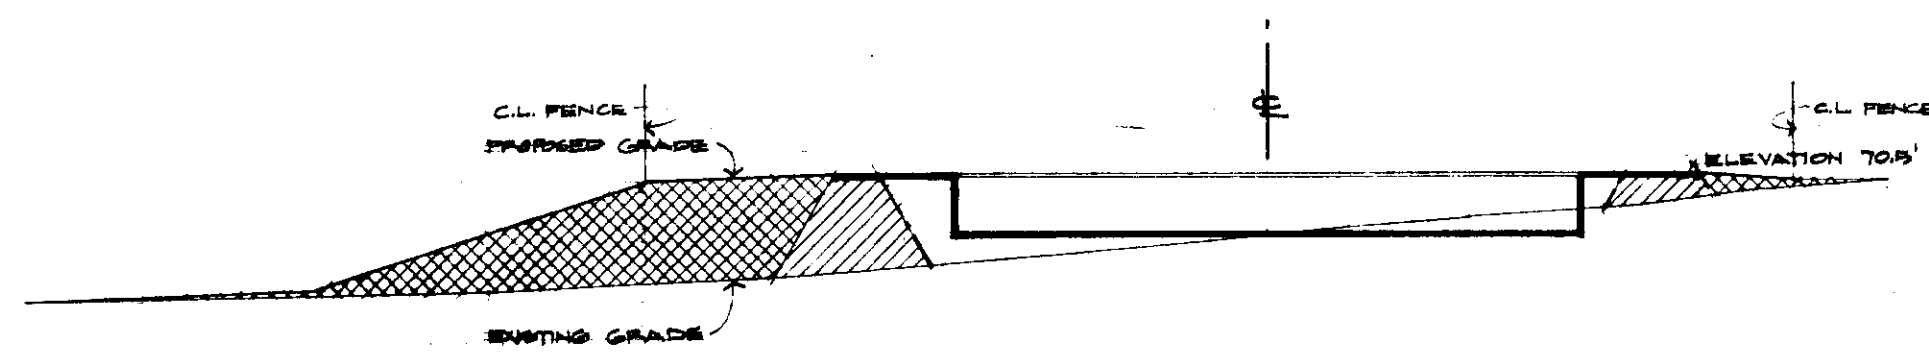

SECTION B

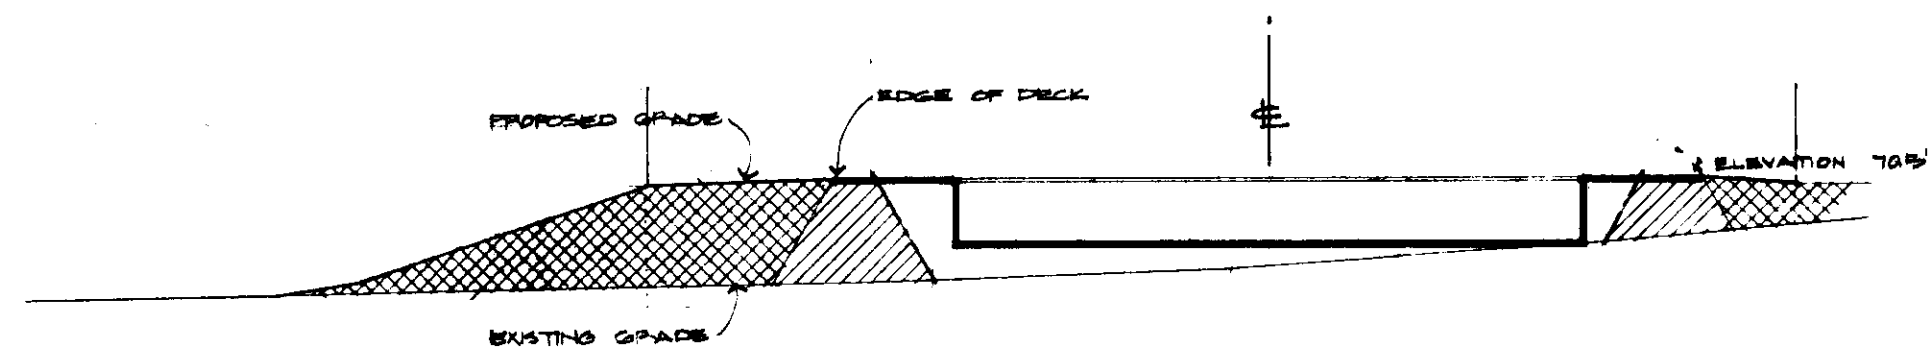

SECTION C

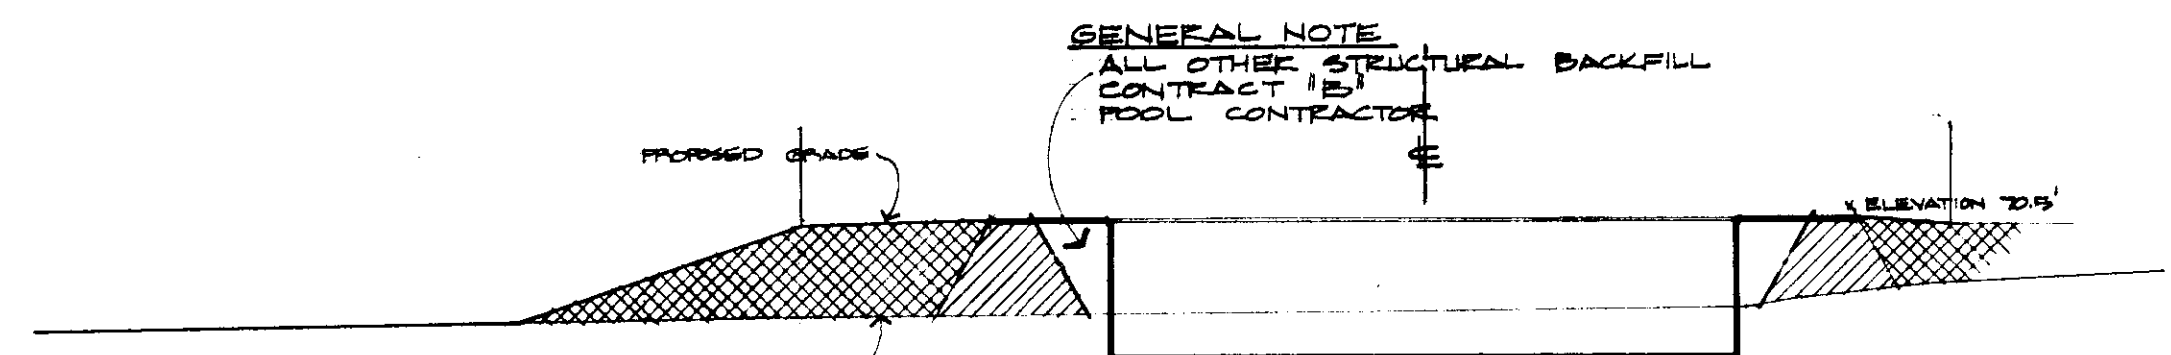


SECTION D

POOL SECTIONS
CONTRACT 1A
CUT & FILL DIAGRAMS

LEGEND:
CUT
STRUCTURAL BACKFILL
BACKFILL

SCALE 1/8" = 1'-0"

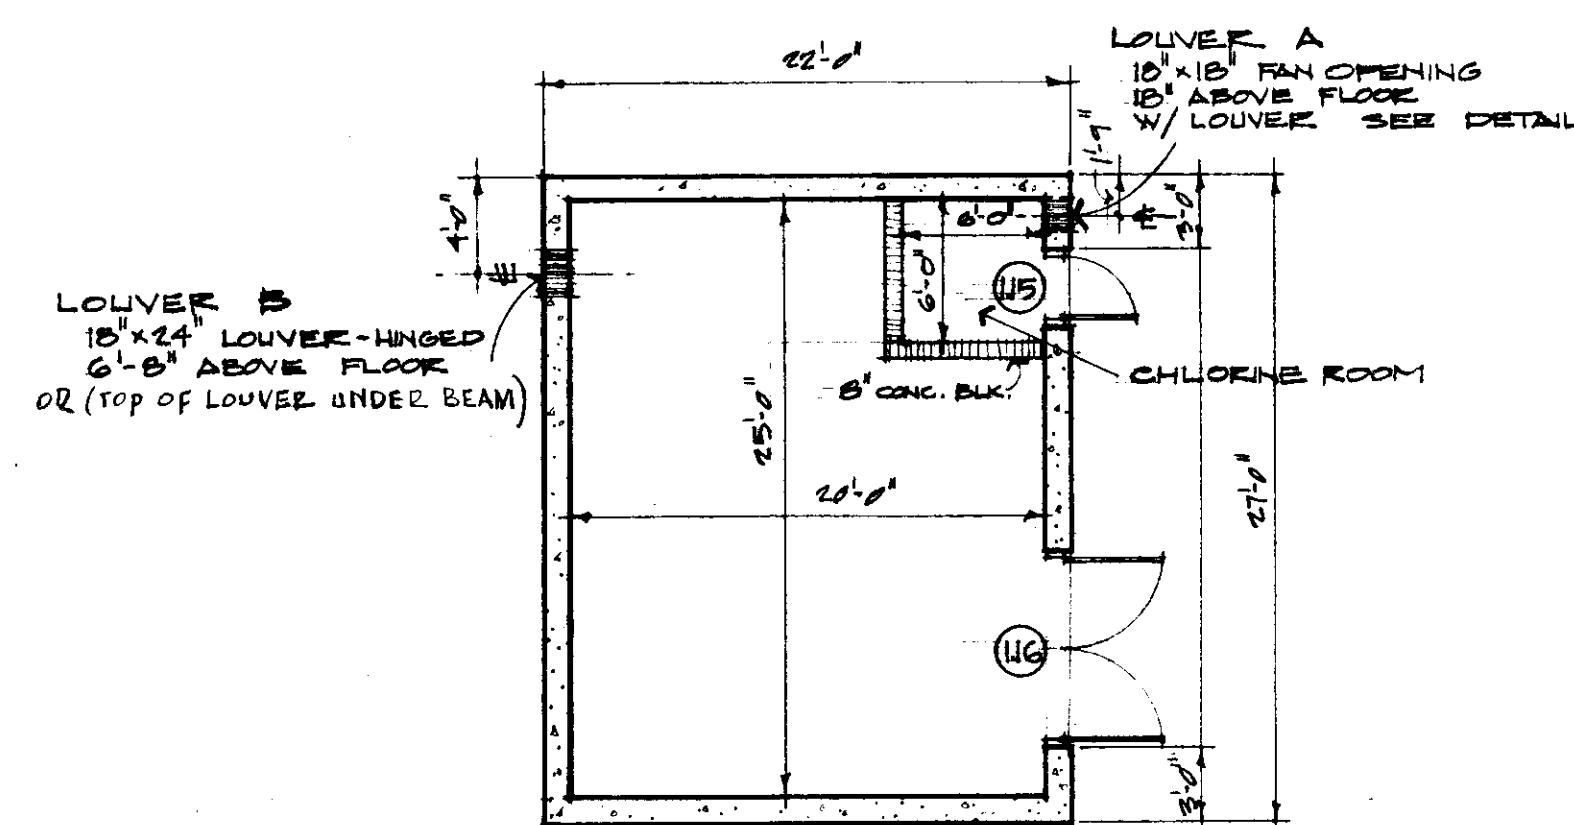

POOL EQUIPMENT ROOM
SCALE 1/8" = 1'-0"


LOUVER A & B
4" HEAVY DUTY 16 GAUGE GALVANIZED STEEL LOUVER W/ COARSE INSECT SCREEN.
LOUVER B HINGED TO SWING INTO EQUIPMENT ROOM.

LOUVER DETAIL
NTS.




SECTION E

POOL PROFILE
SCALE 1/8" = 1'-0"

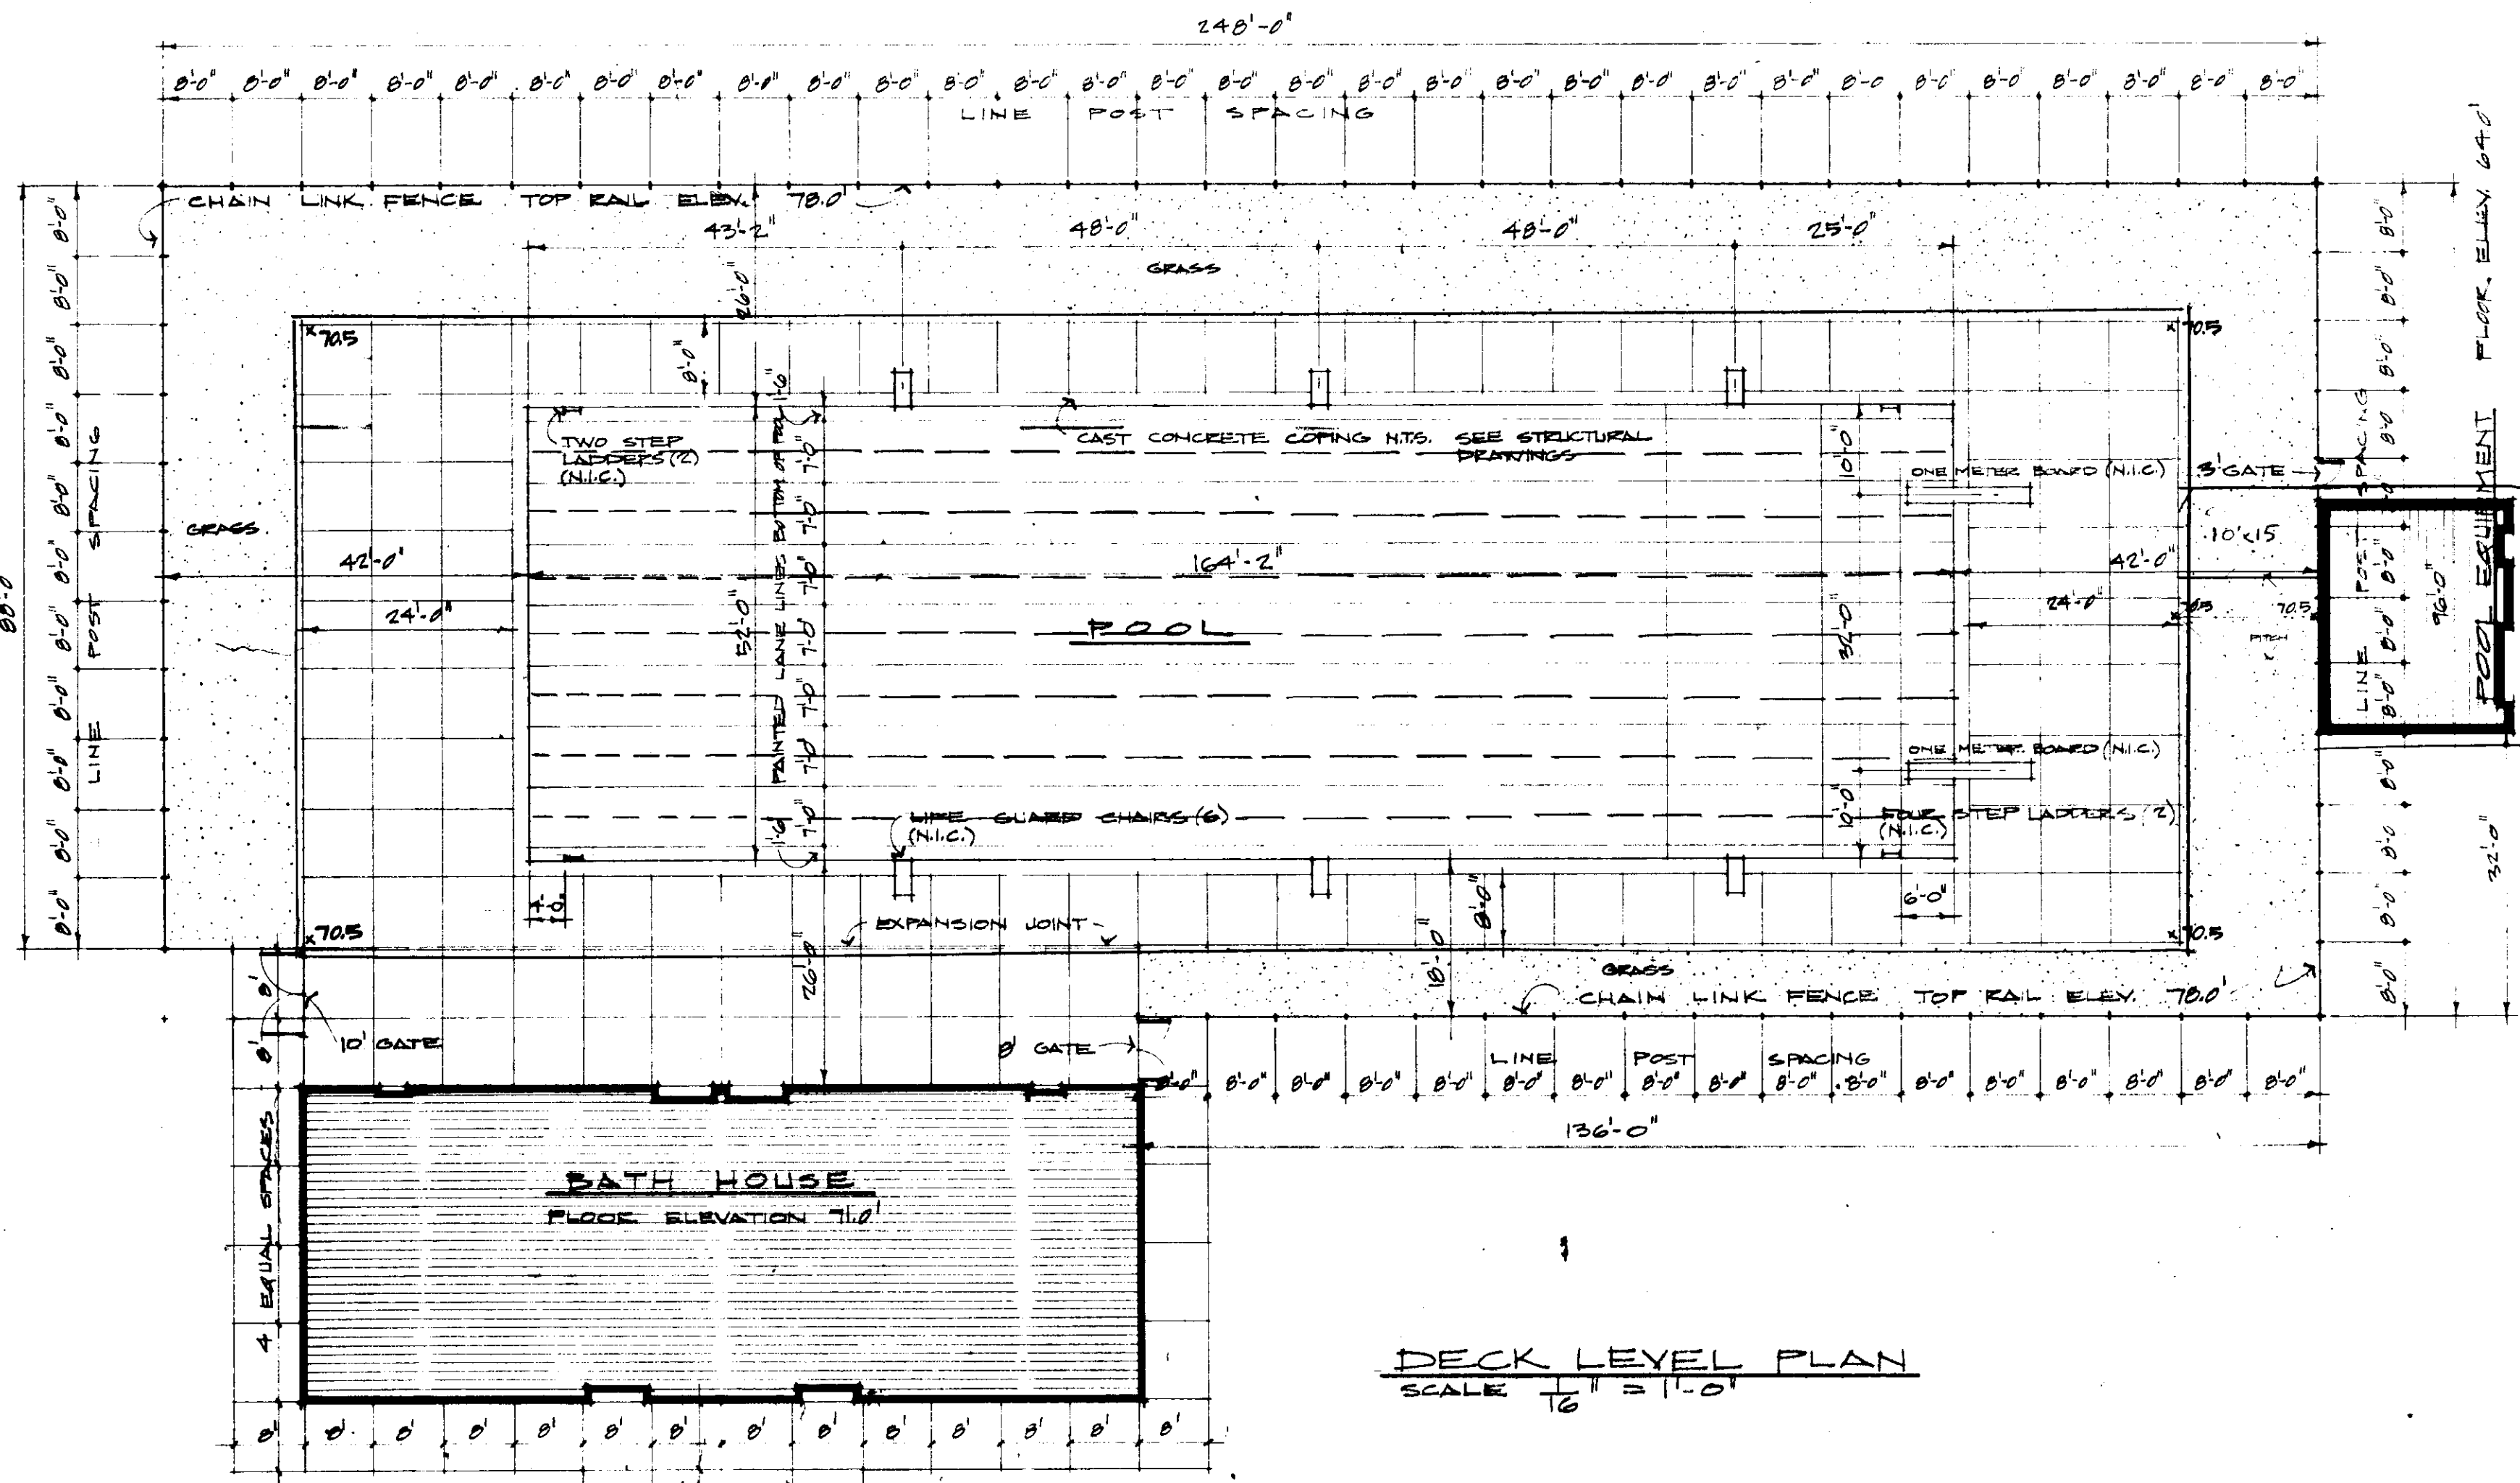

DECK LEVEL PLAN
SCALE 1/16" = 1'-0"

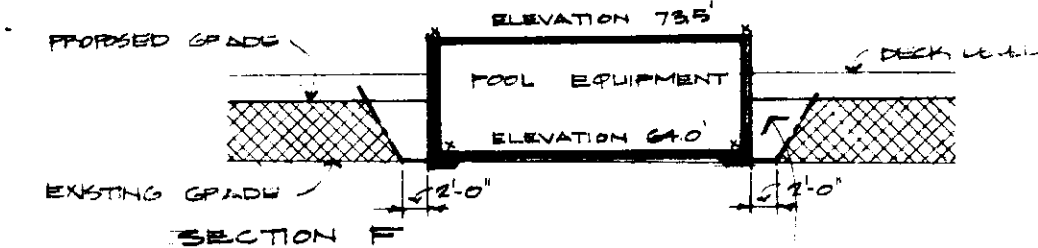

SECTION F