

REVISIONS		
NO.	DATE	REMARKS


**ASSOCIATED
ARCHITECTS**
FARMINGTON • CONNECTICUT • 06032

MECHANICAL ENGINEER
BURTON & VAN HOUTEN
WEST HARTFORD CONNECTICUT

CORRECT AS BUILT DEC. 20-75

SHEET TITLE
POOL PLUMBING
PLAN

POOL FITTING & PIPING SCHEDULE			
MARK	ITEM	LOCATION	DESCRIPTION
MD	Main Drain	Pool Floor	Swimquip #7160 18" square main outlet chrome plated brass.
SK	Skimmer	Top of Pool Wall	Swimquip #8655, U-3 Cyclocac, weir type, Automatic skimmers with cyclocac deck plate. Skimmers to be complete with regulating throat device and equalizer line.
RI	Recirculating Inlet	Pool Wall 24" Below Water Level	Josam 0750-BS adjustable 2: cast iron supply fitting with brass adjustable square head and strainer. Vandal-proof screws.
RI	Recirculating Inlet	Pool Floor	Swimquip #8416 brass adjustable floor inlet 2" in size with positive locking device.
DD	Deck Drain	Pool Deck	Zurn Z-415 triumph drain, cast iron floor drain with 8" nickel bronze strainer, clamping collar, vandal-proof screws.
AD	Area Drain	Equipment Room Floor	Zurn Z-736V sentinel drain with seepage pan integral backwater valve, cleanout and trap.

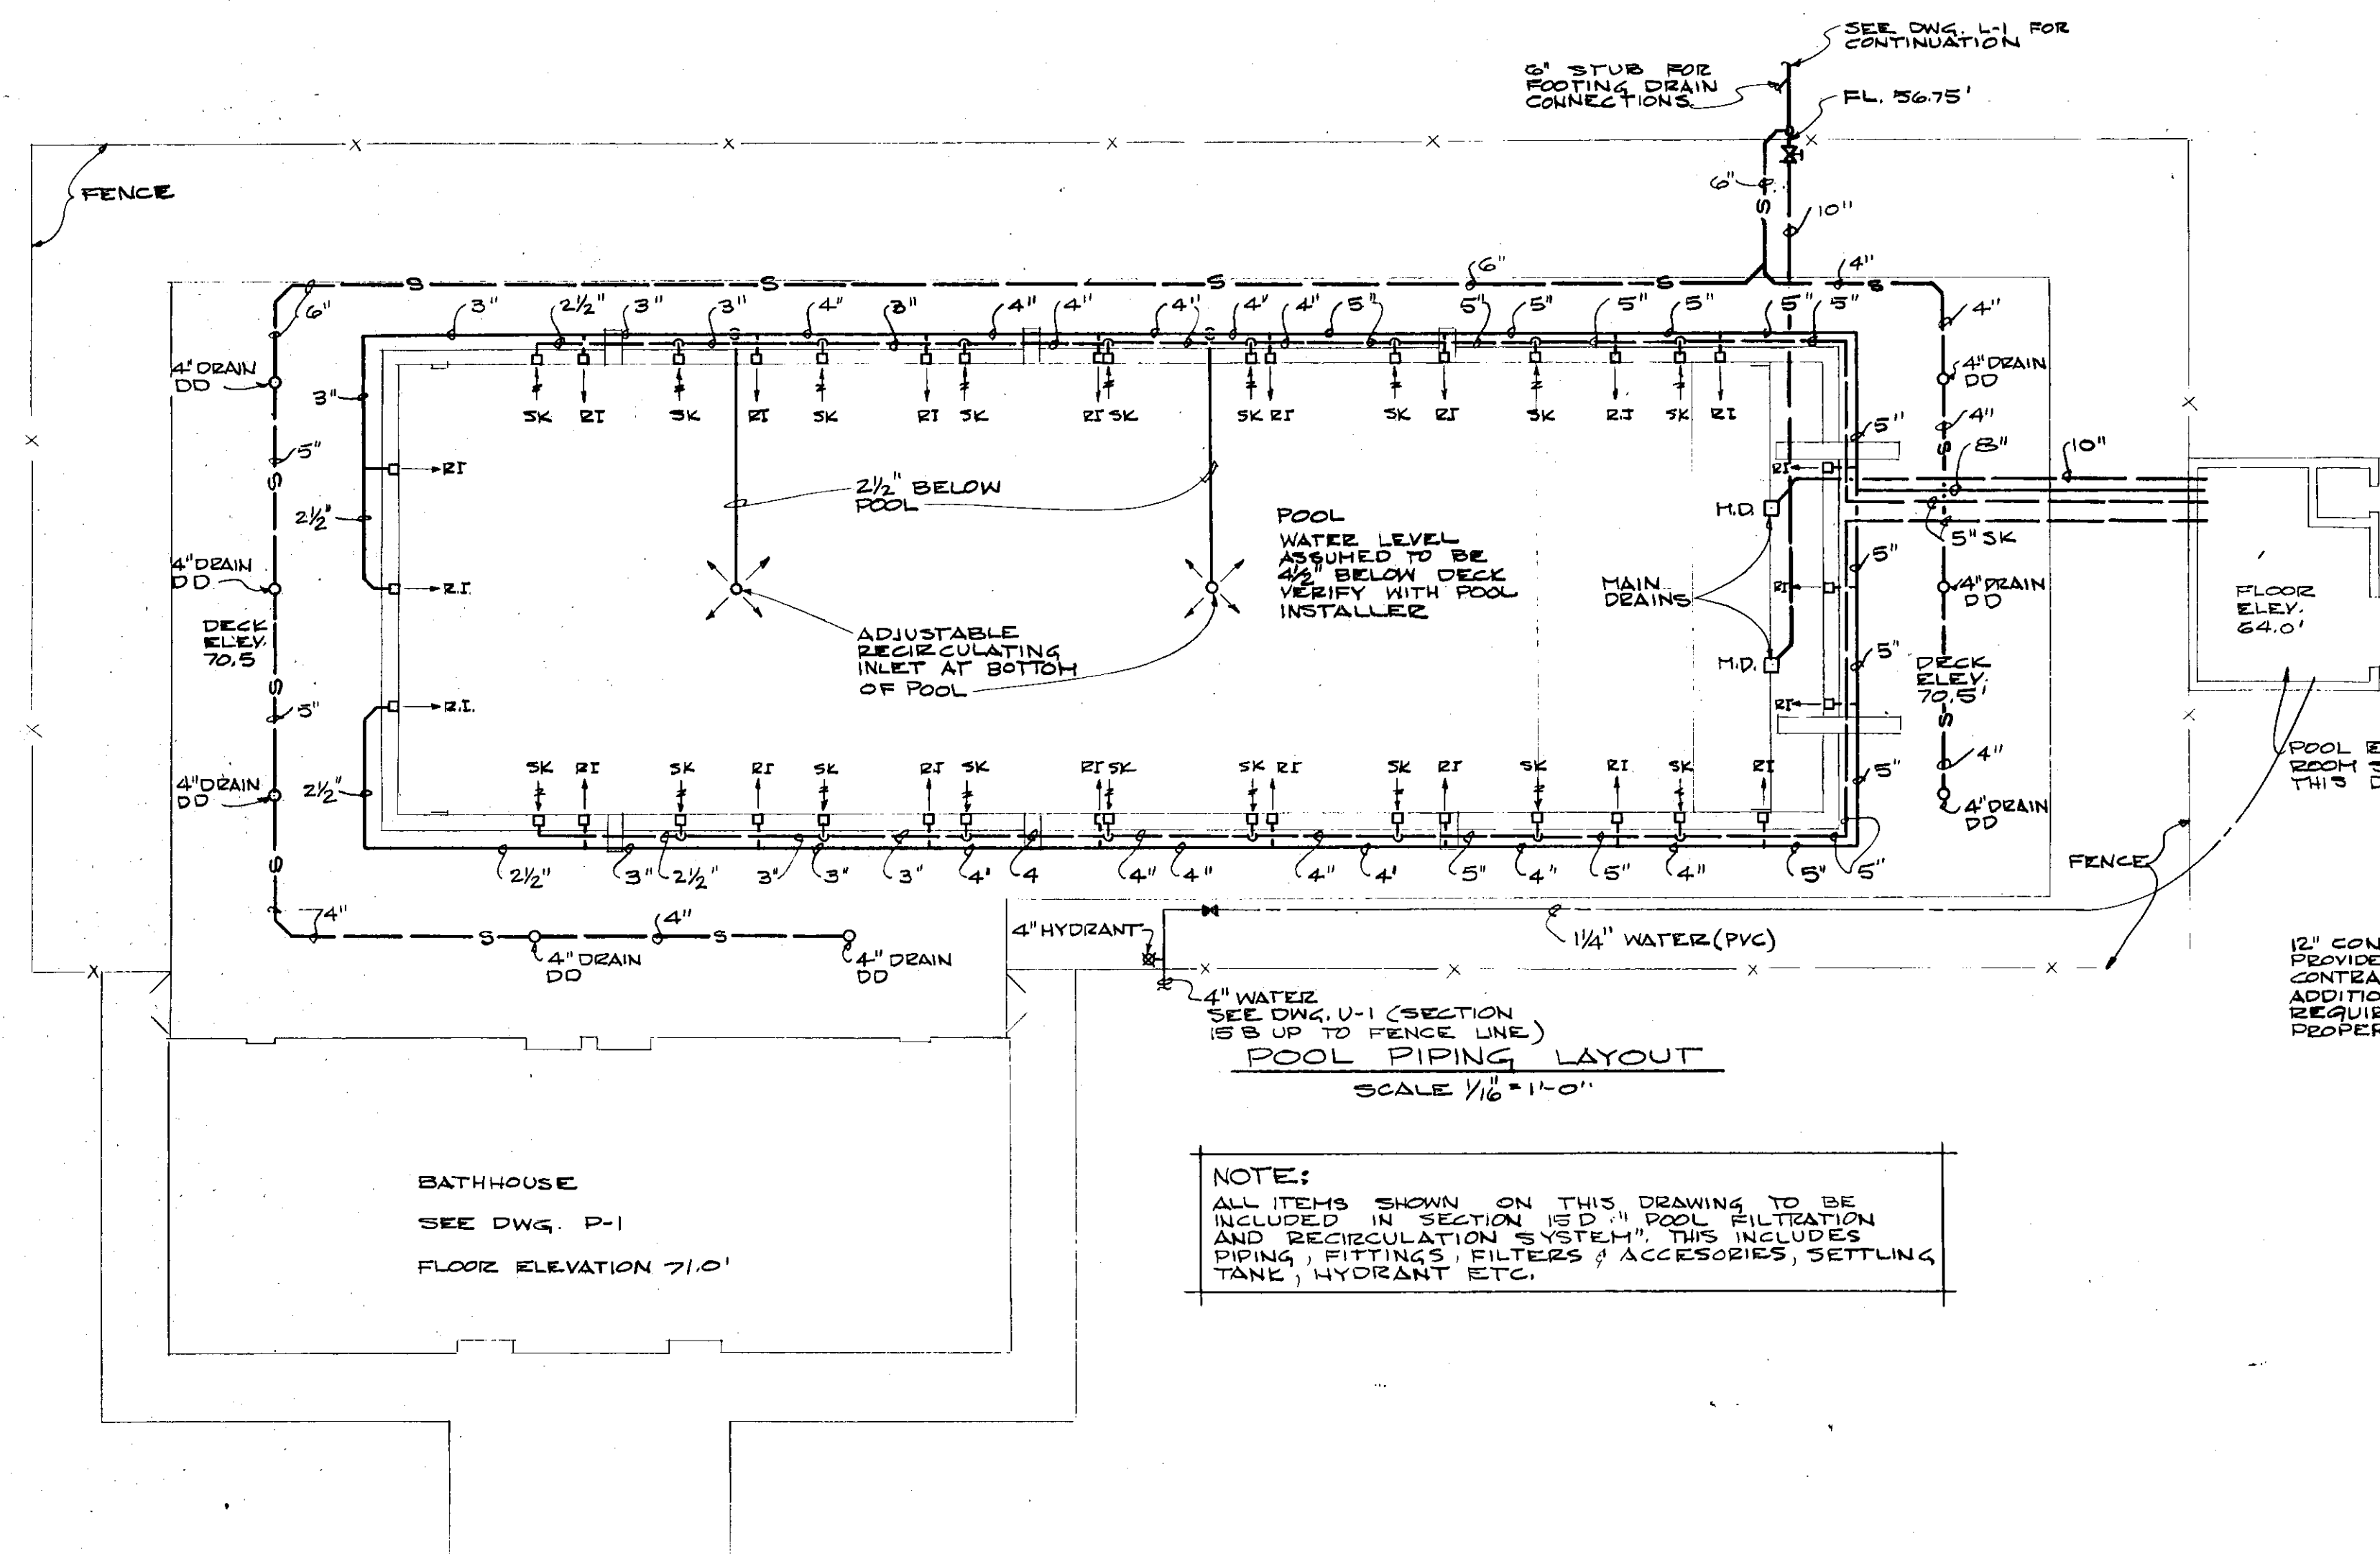

NOTE:
ALL PIPING WITHIN EQUIPMENT ROOM TO BE SCHEDULE 40 GALVANIZED STEEL UNLESS OTHERWISE NOTED.
VALVES V-1 THRU V-6 TO BE BUTTERFLY TYPE CENTERLINE WITH BUNA-N SEATS & DUCTILE IRON SISES & ADJUSTABLE LEVER OPERATORS.

C.O FOR SAN SEWER
"18" DEEP