


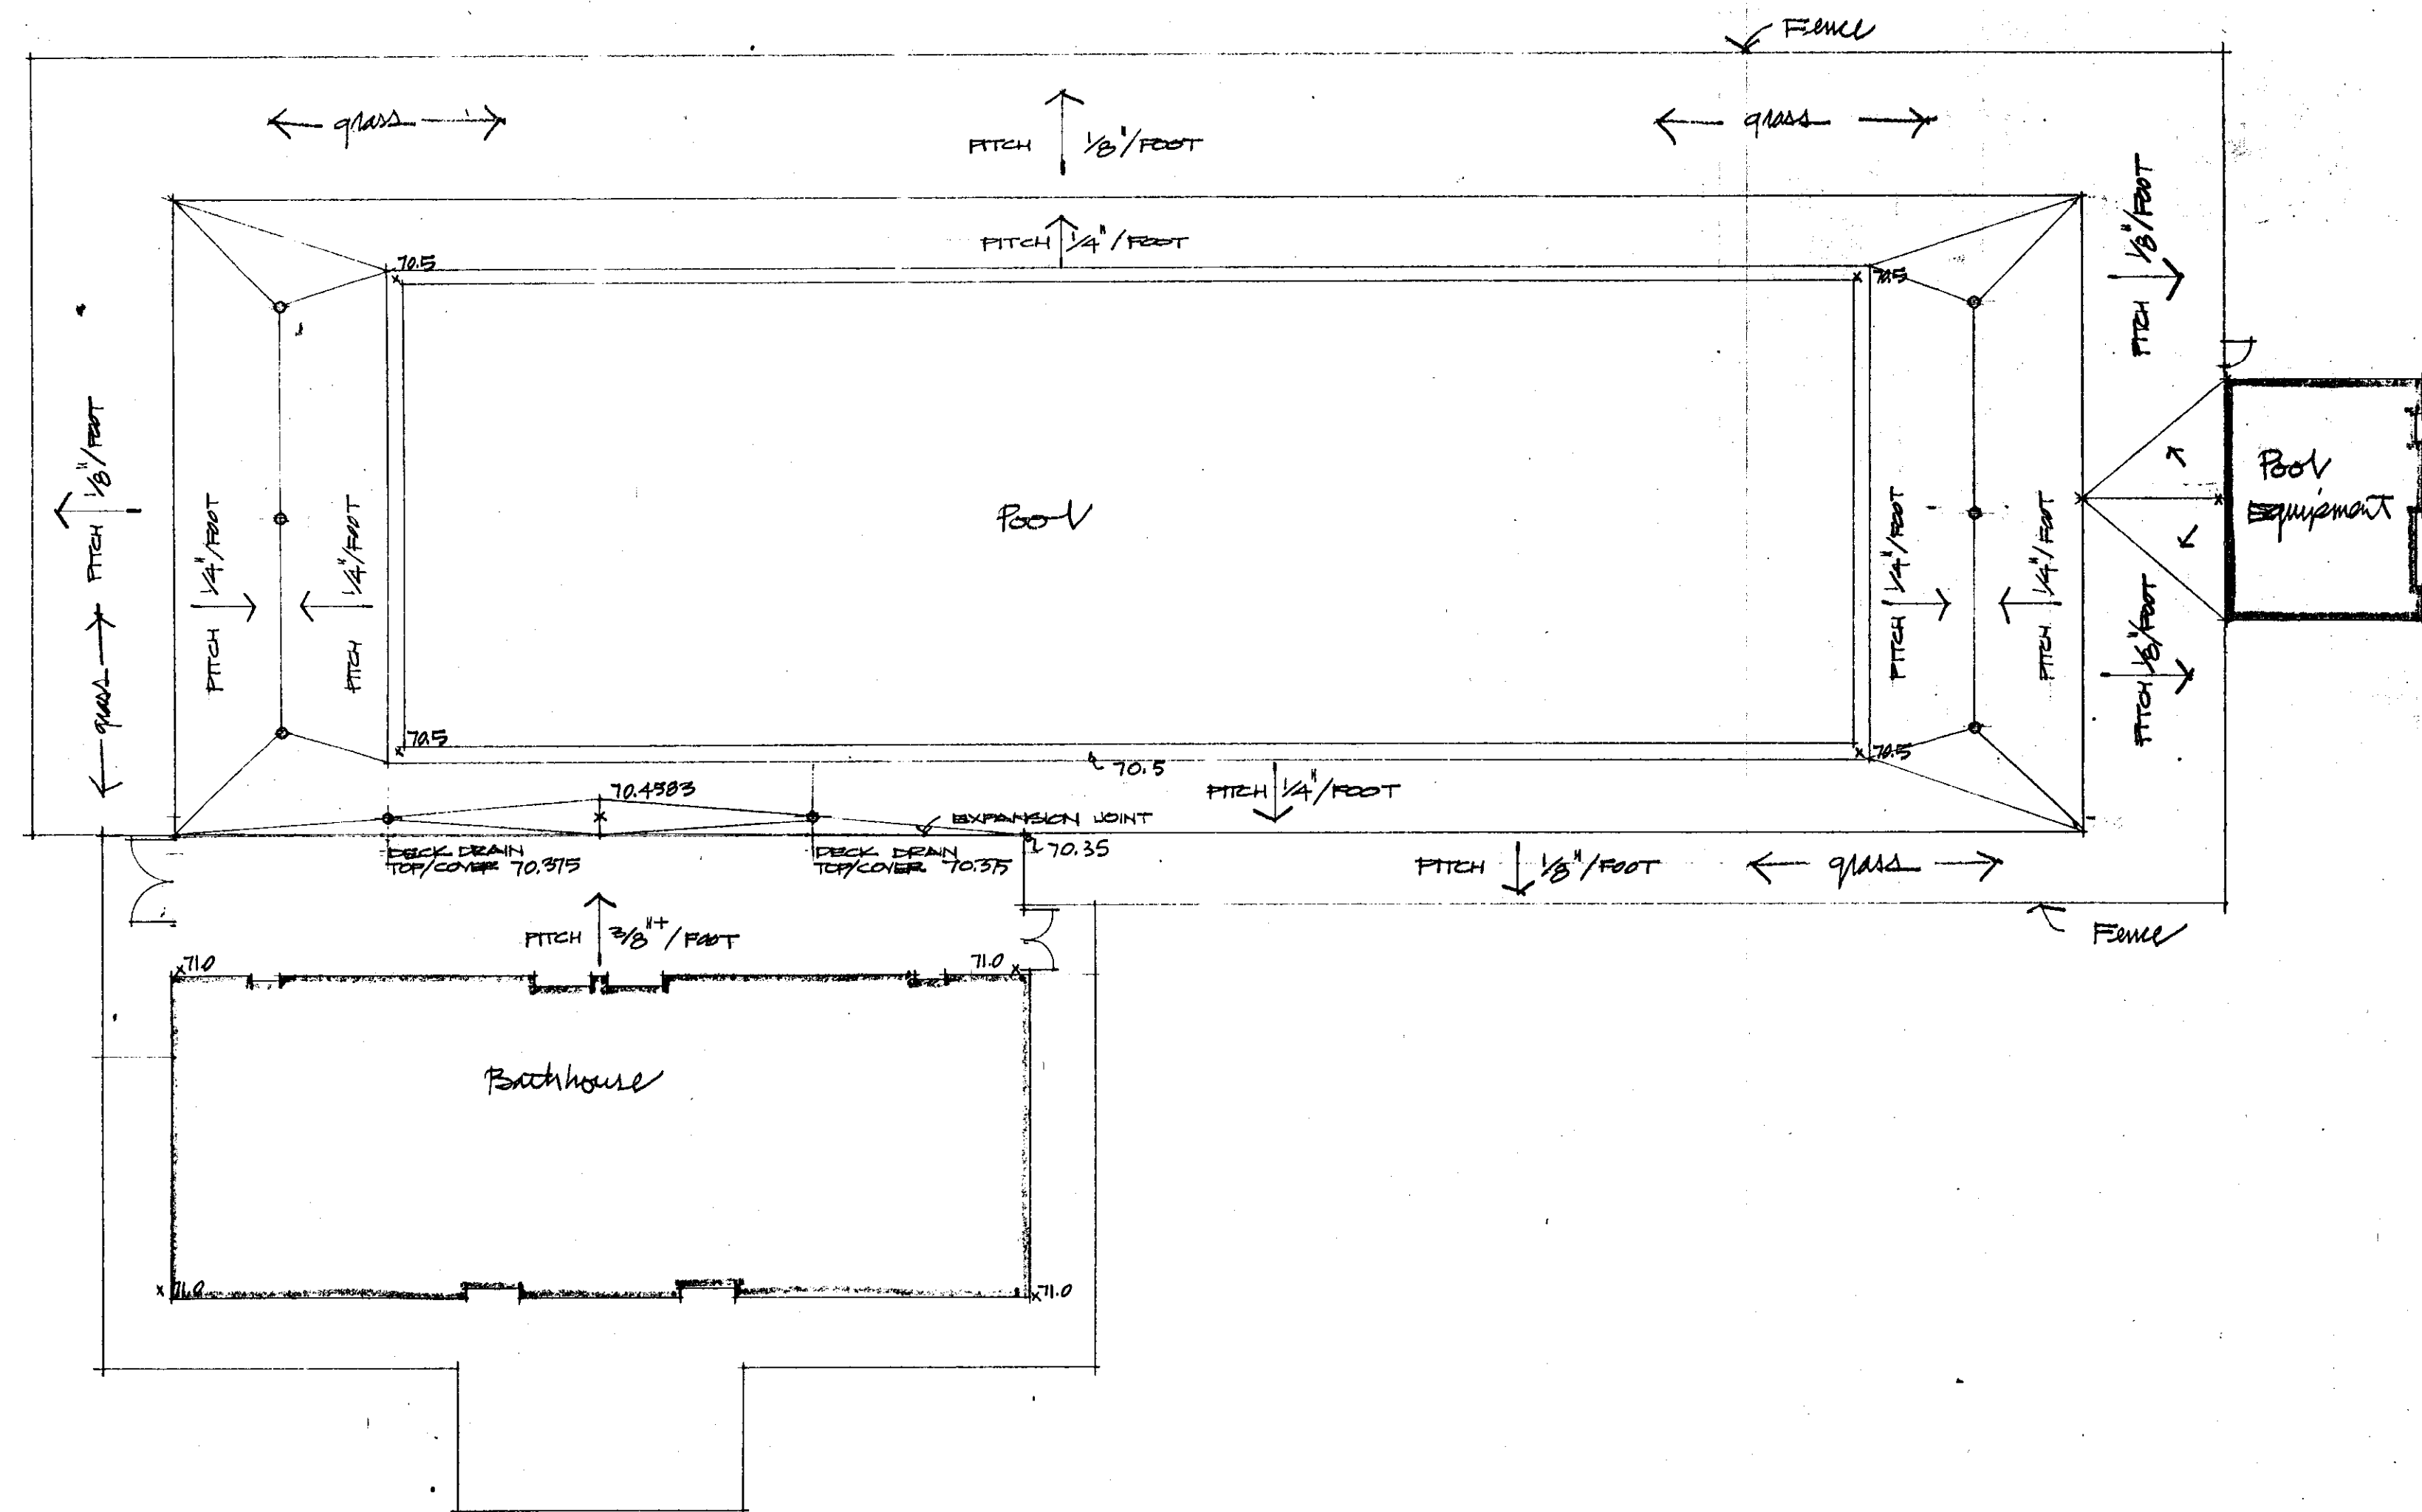

REVISIONS

NO.	DATE	REMARKS
-----	------	---------

PROJECT TITLE
 Pope Park Pool
 &
 Bathhouse

ASSOCIATED ARCHITECTS
 FARMINGTON • CONNECTICUT • 06032

Land Planner
 Maine & Ellsworth

Mechanical
 Burton & Van Houten

Structural
 Burton & Van Houten

CORRECT AS BUILT DE/20-72

SHEET TITLE
 Pool Deck
 Revised Deck Elevation

PROJECT NO. 60470
 DRAWN BY CWL
 CHECKED BY
 APPROVED BY
 DATE 29 Jun 71

SHEET NO.
 R3A
 SHEET 1 OF 1