


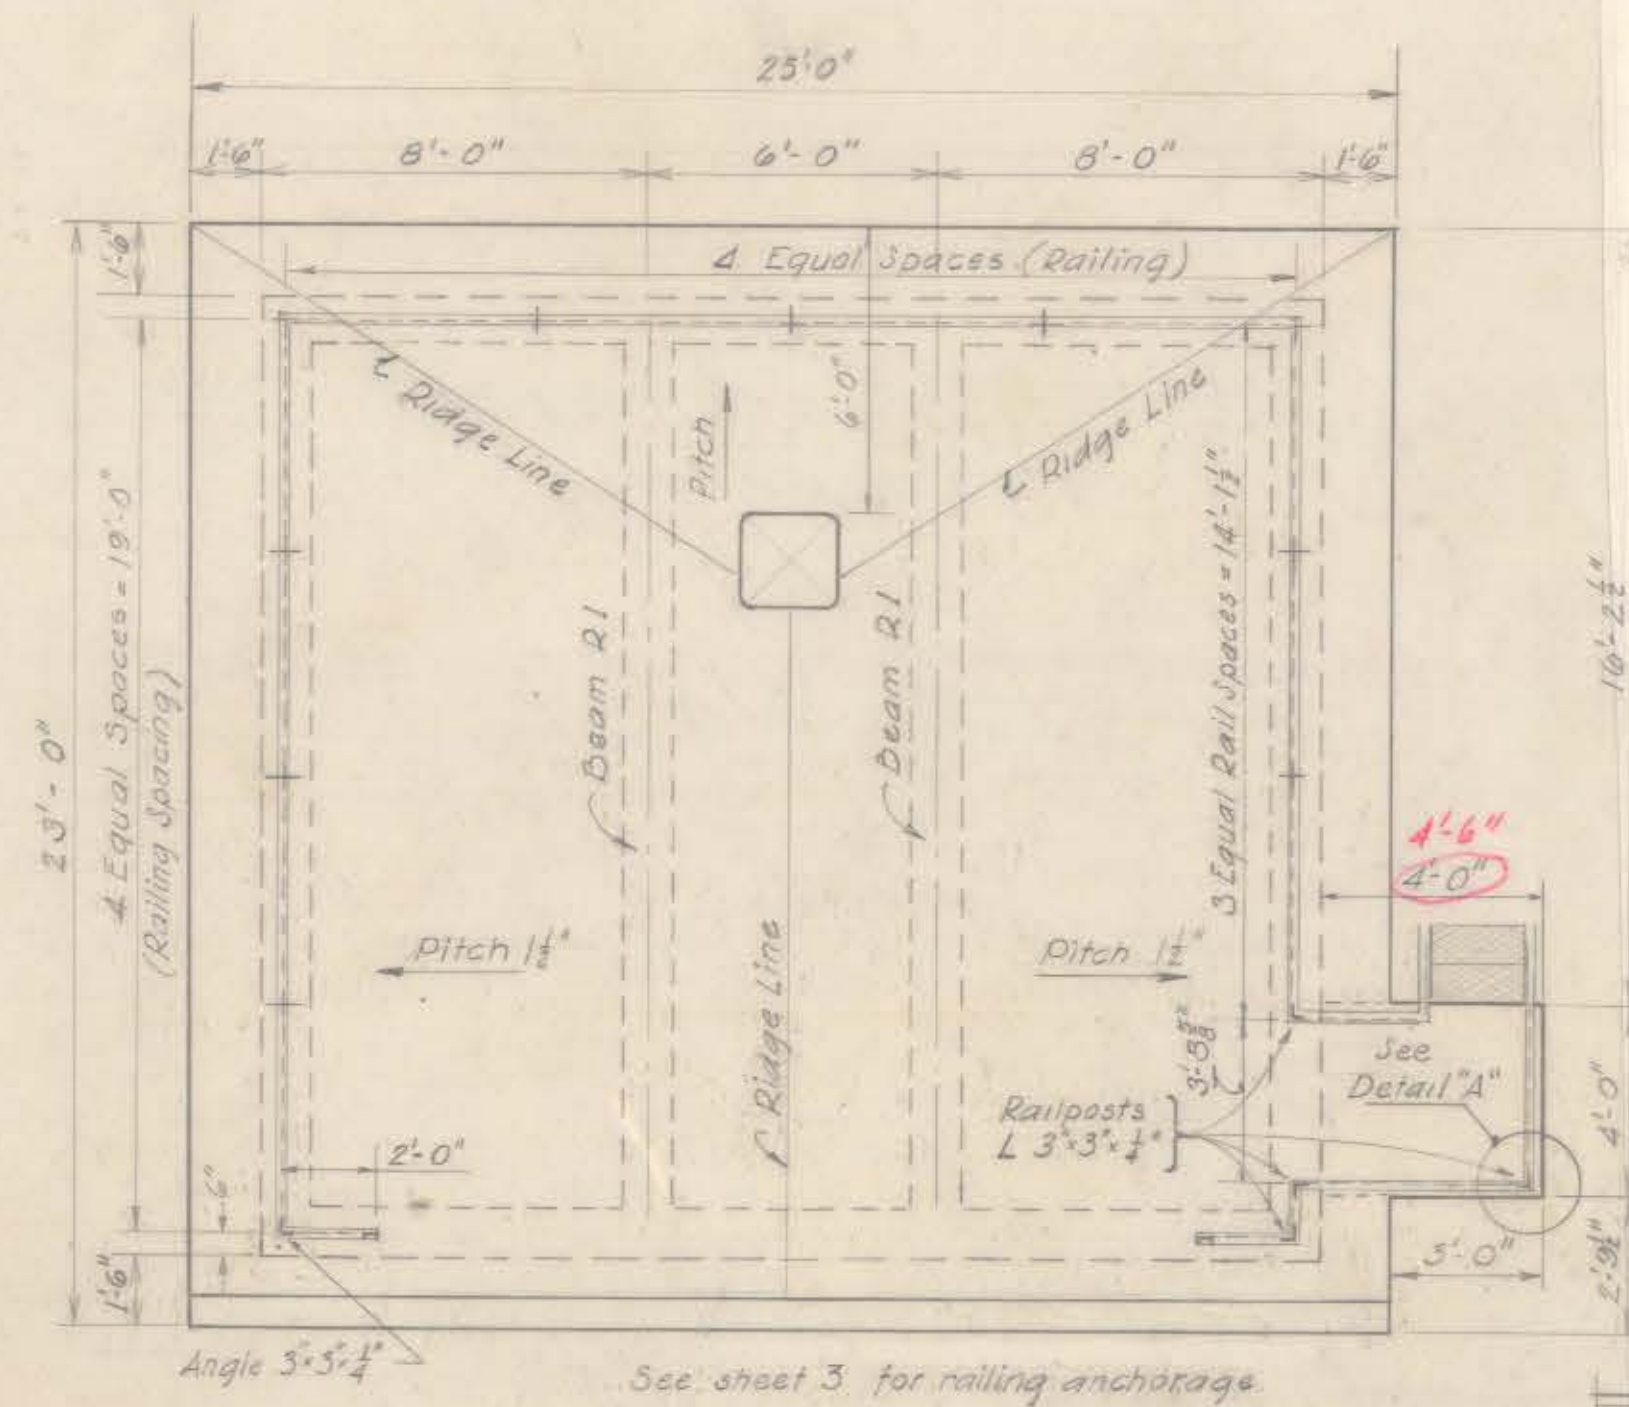
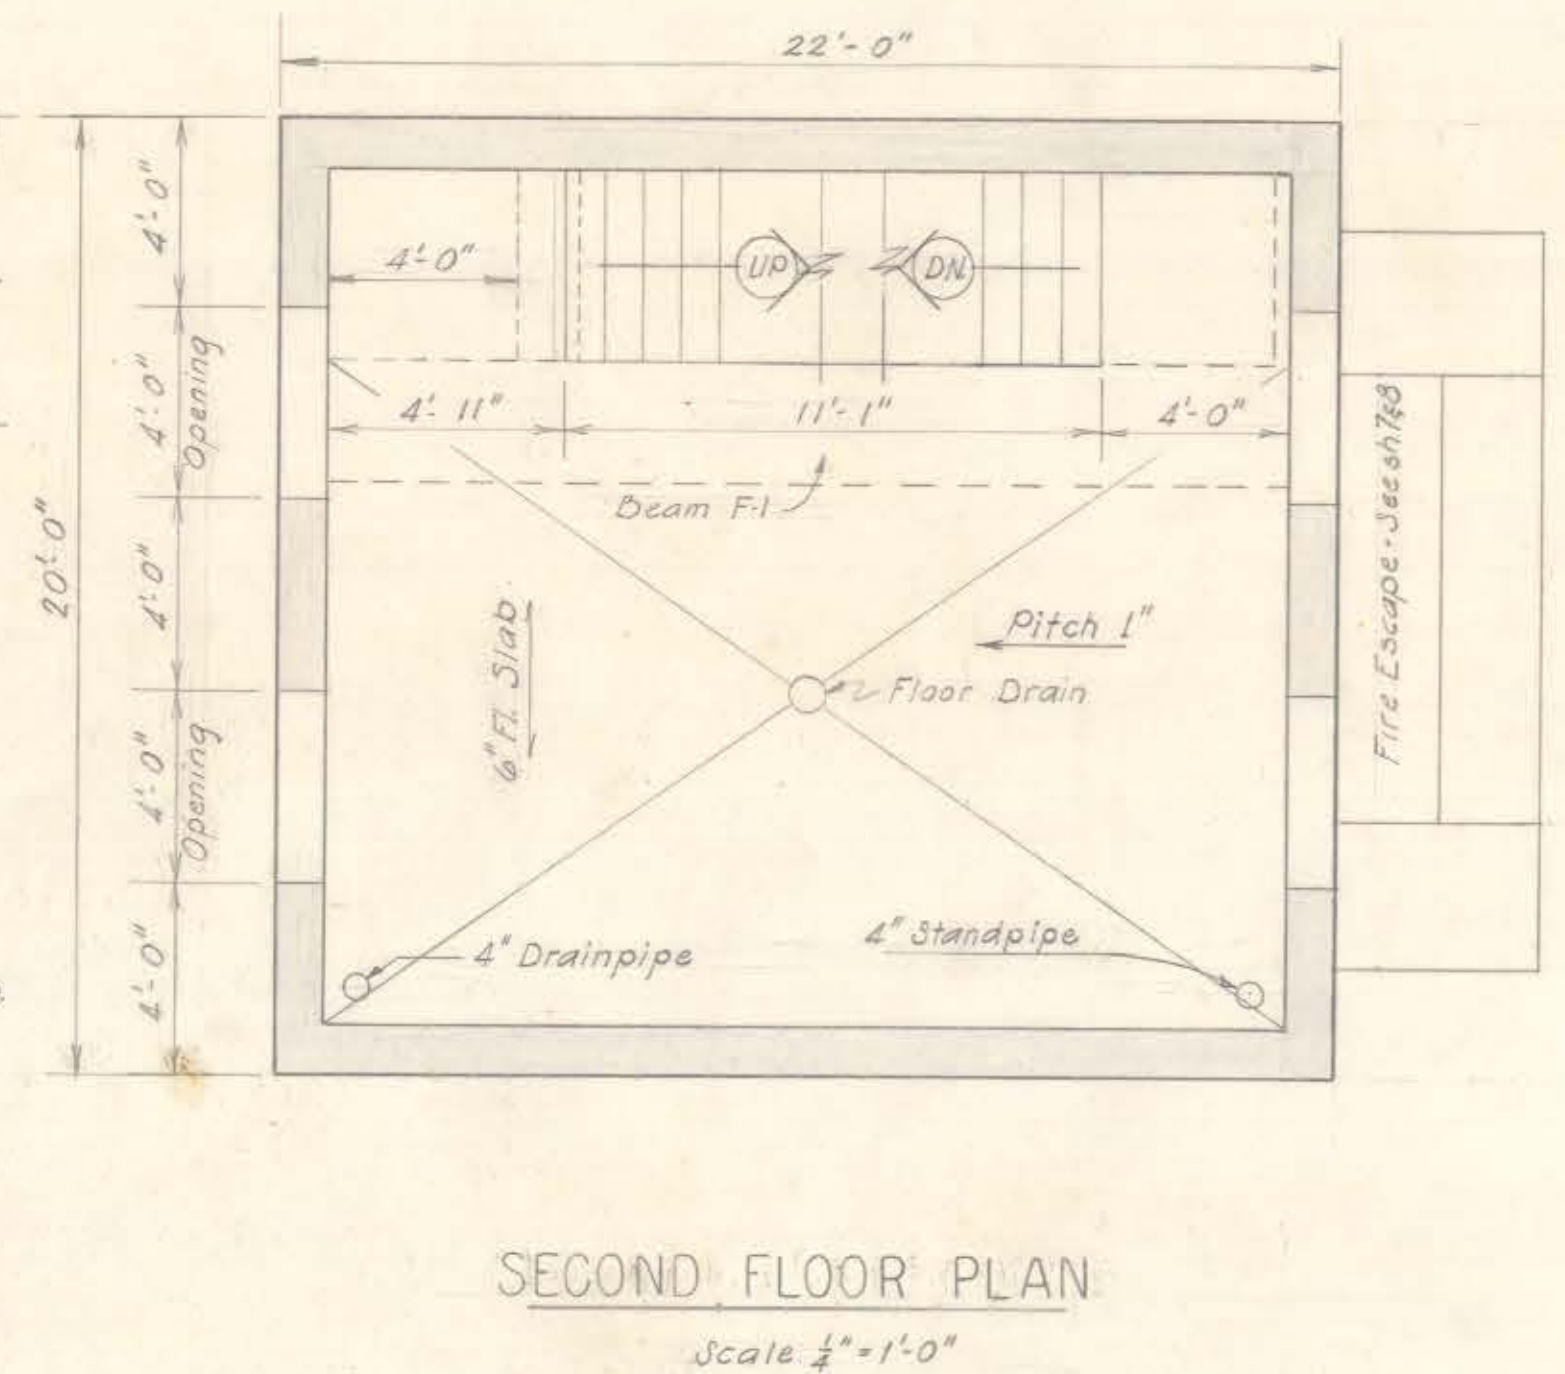
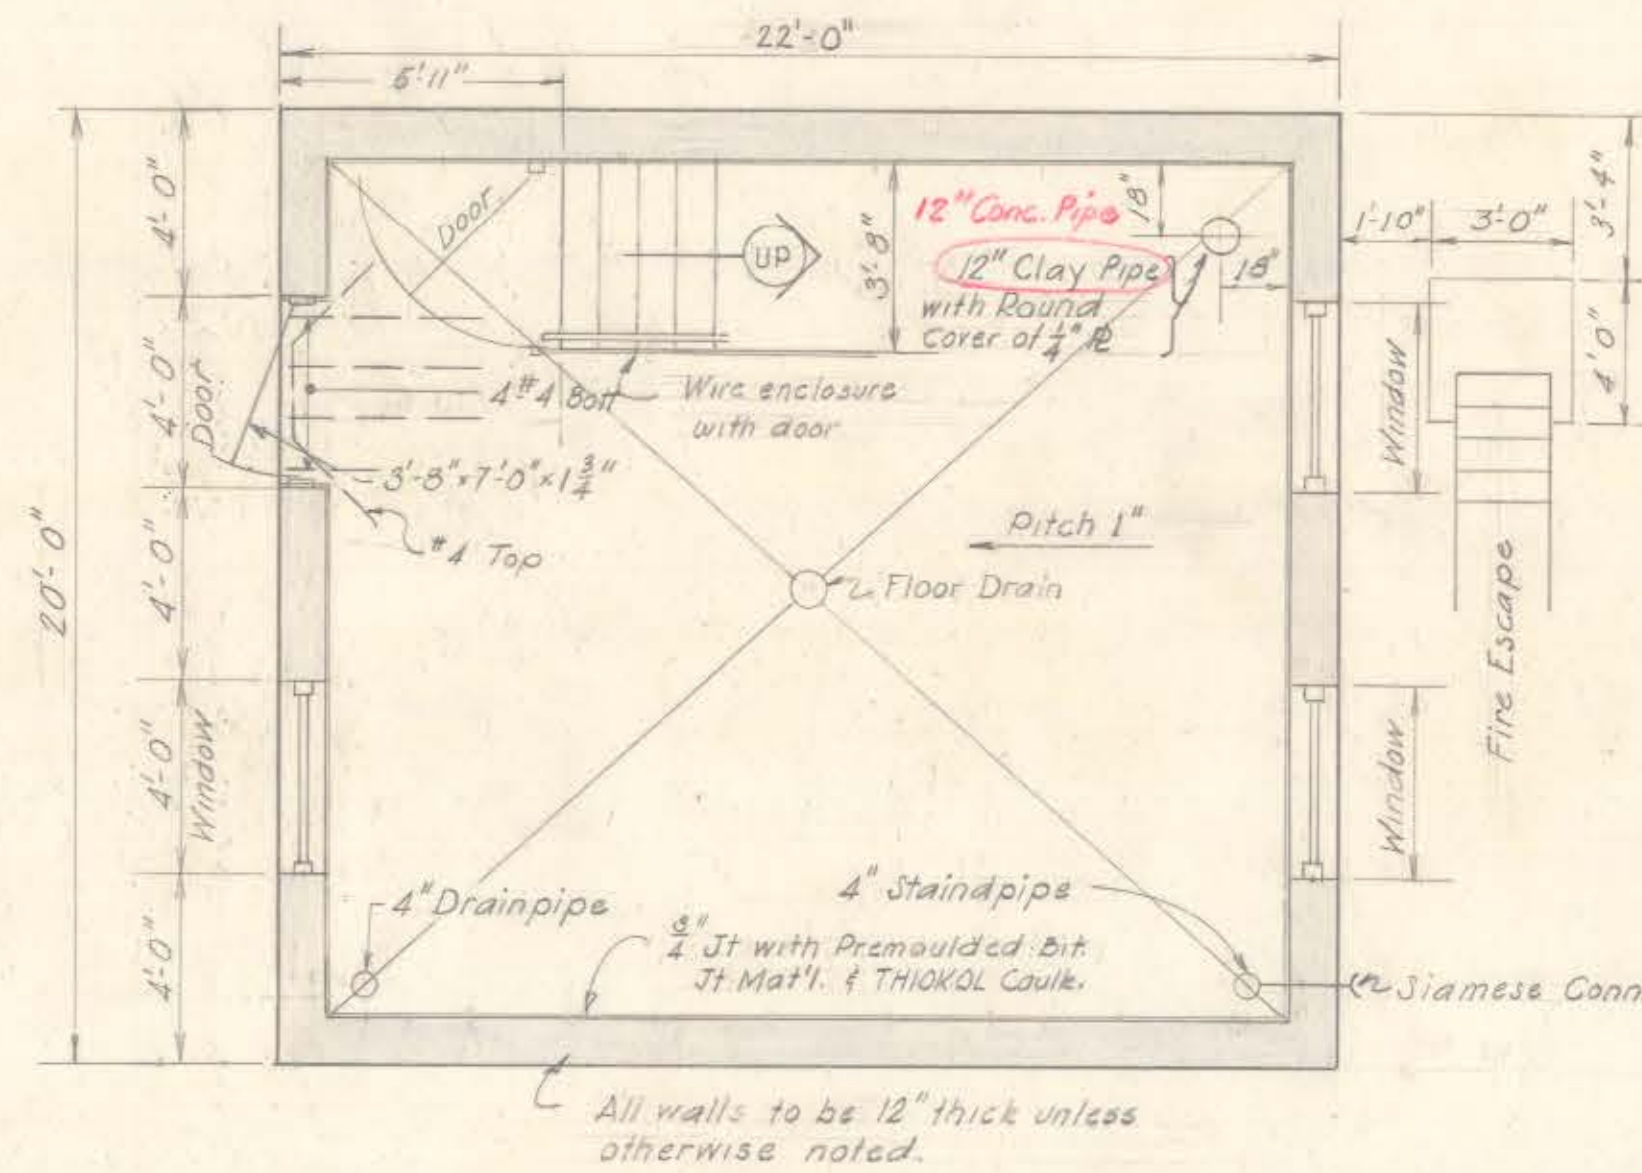
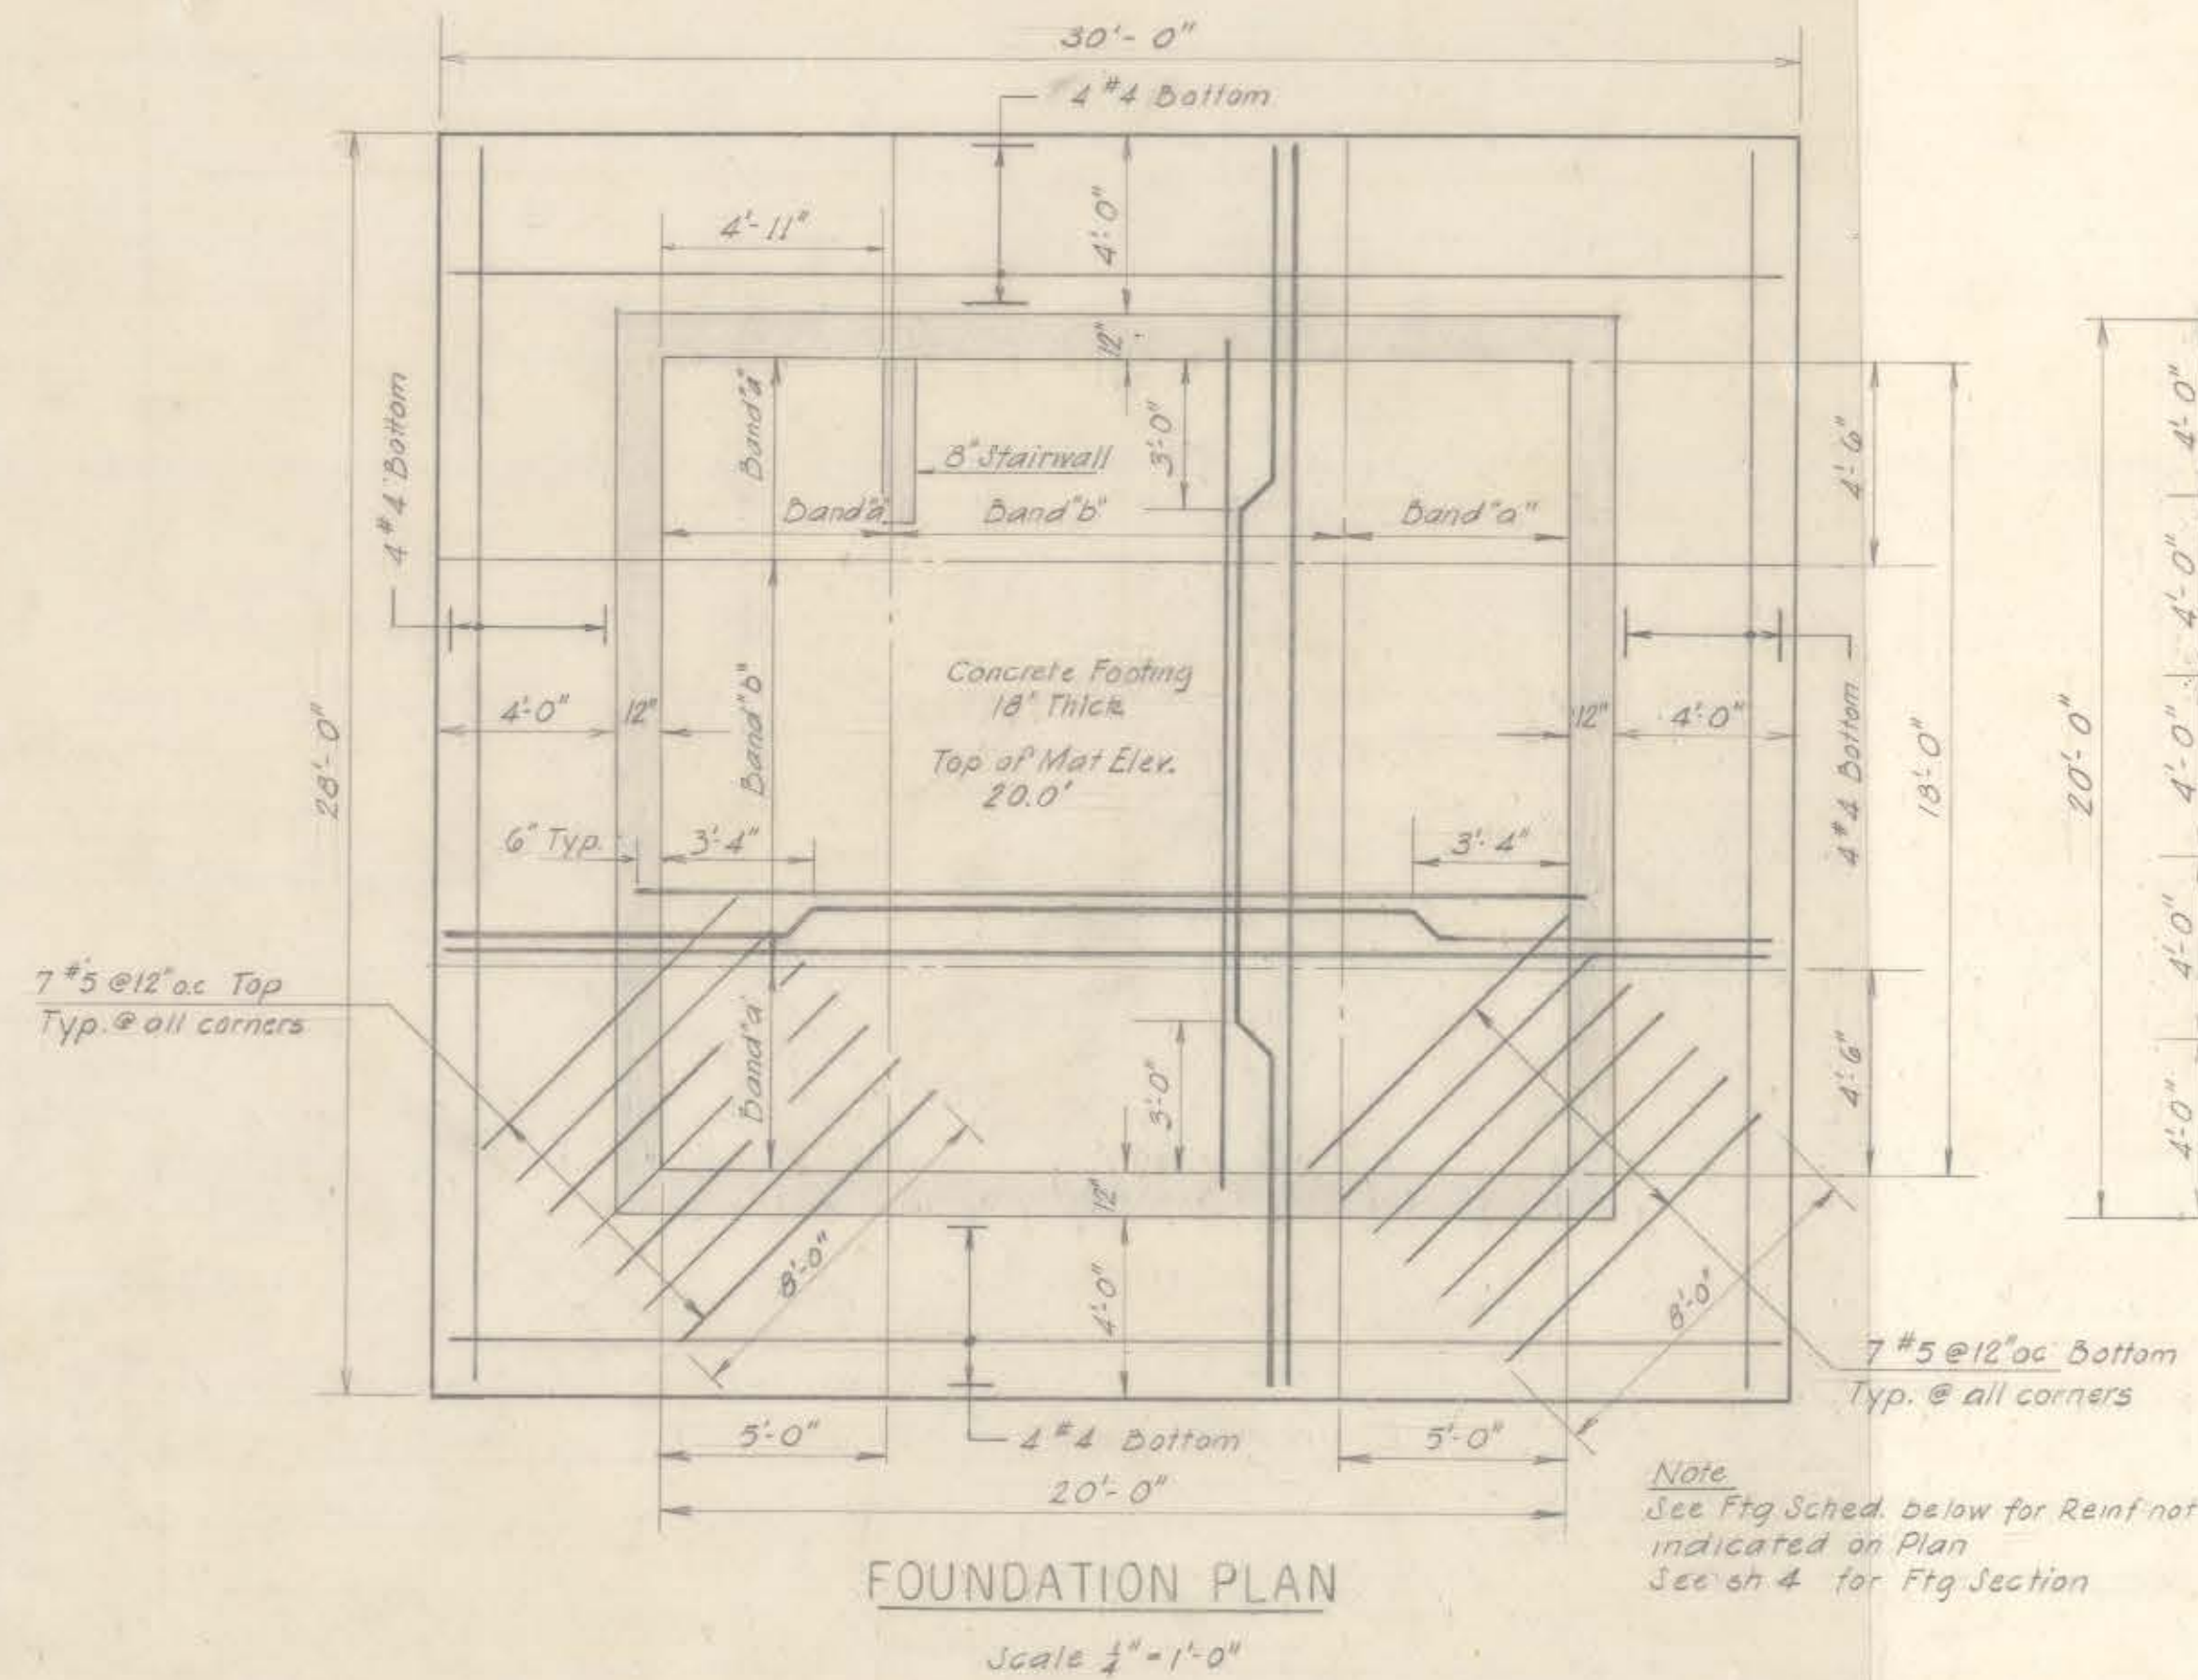


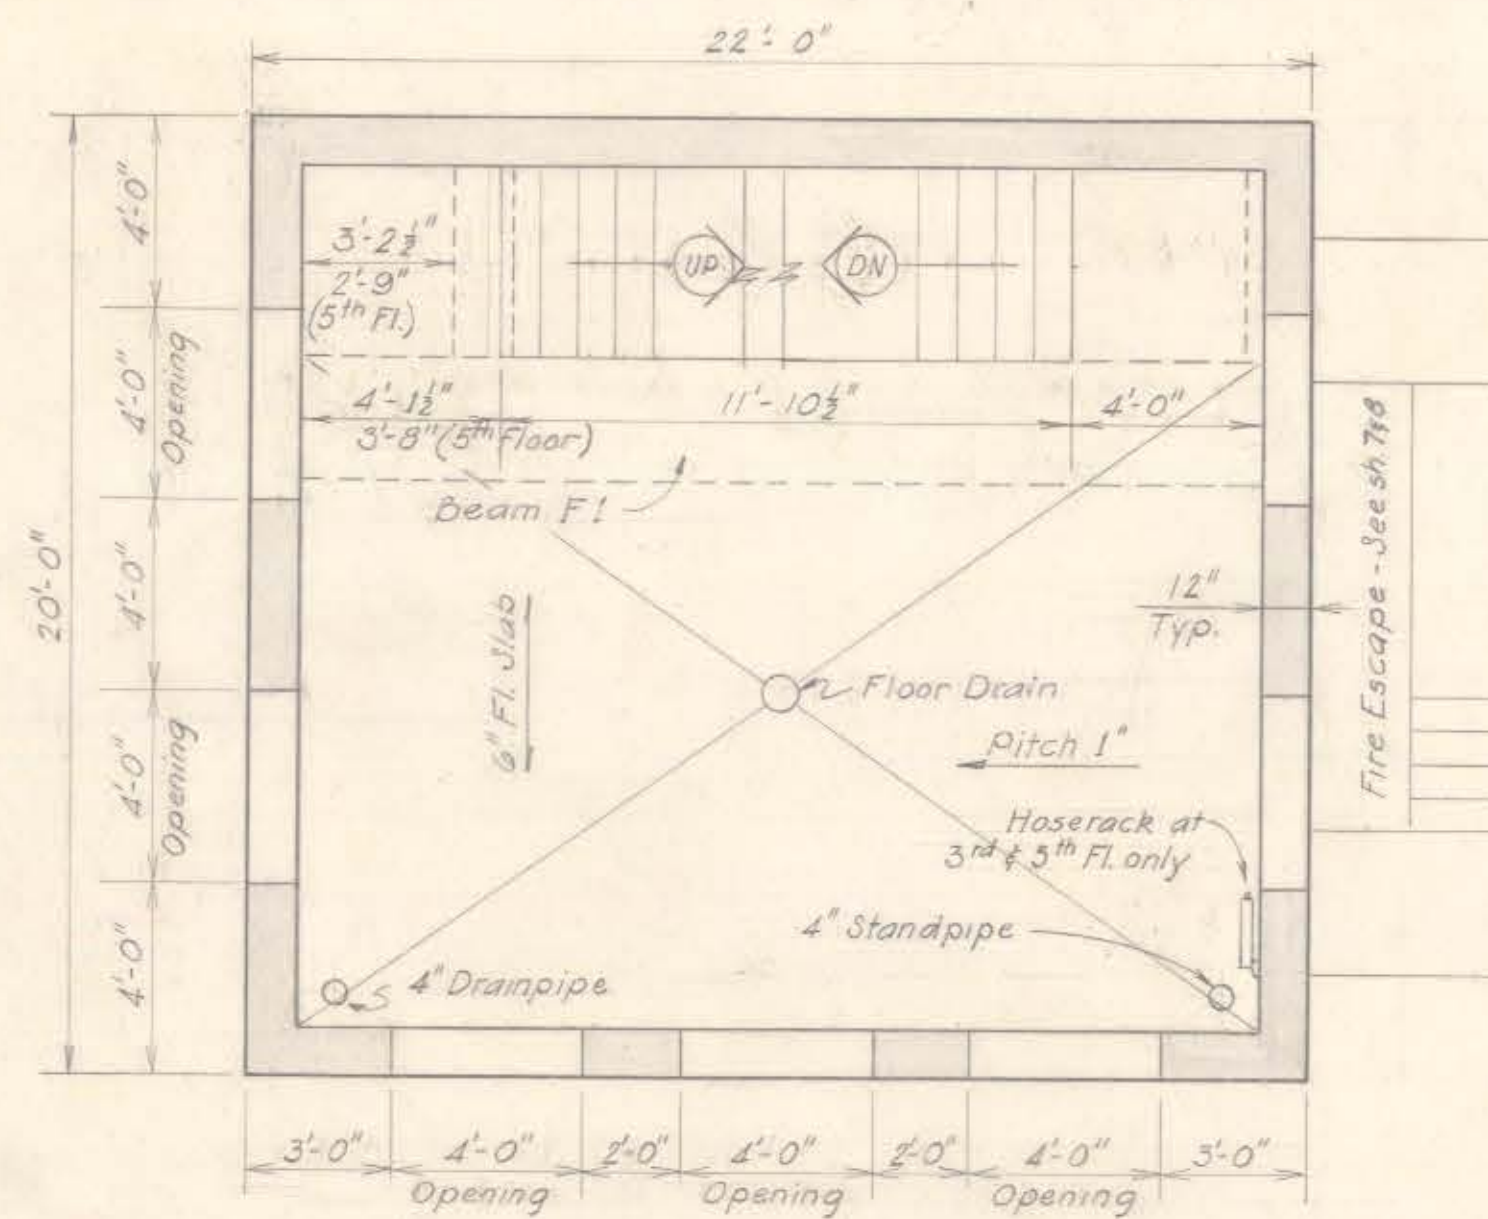

ROOF PLAN
Scale $\frac{1}{4}" = 1'-0"$

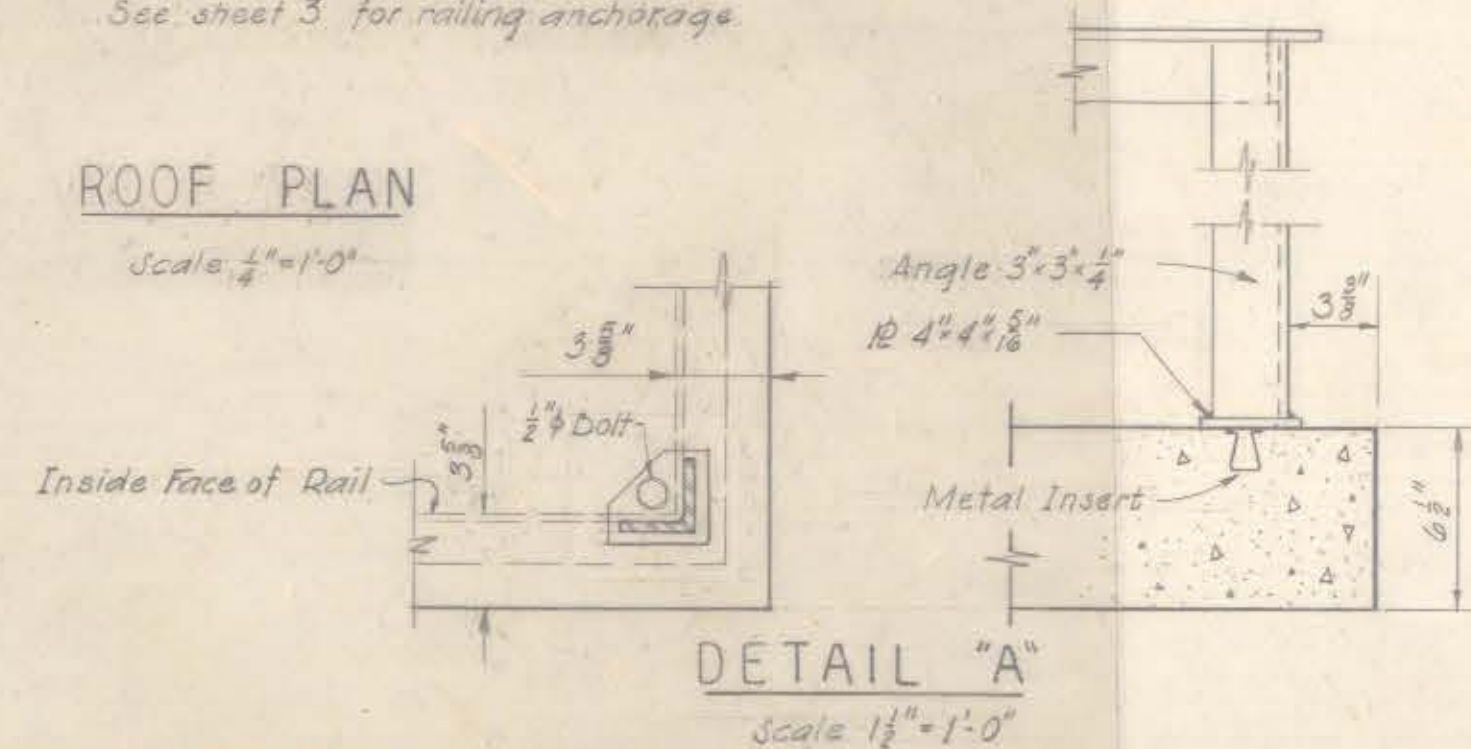

THIRD, FOURTH AND FIFTH FLOOR PLANS
Scale $\frac{1}{4}" = 1'-0"$

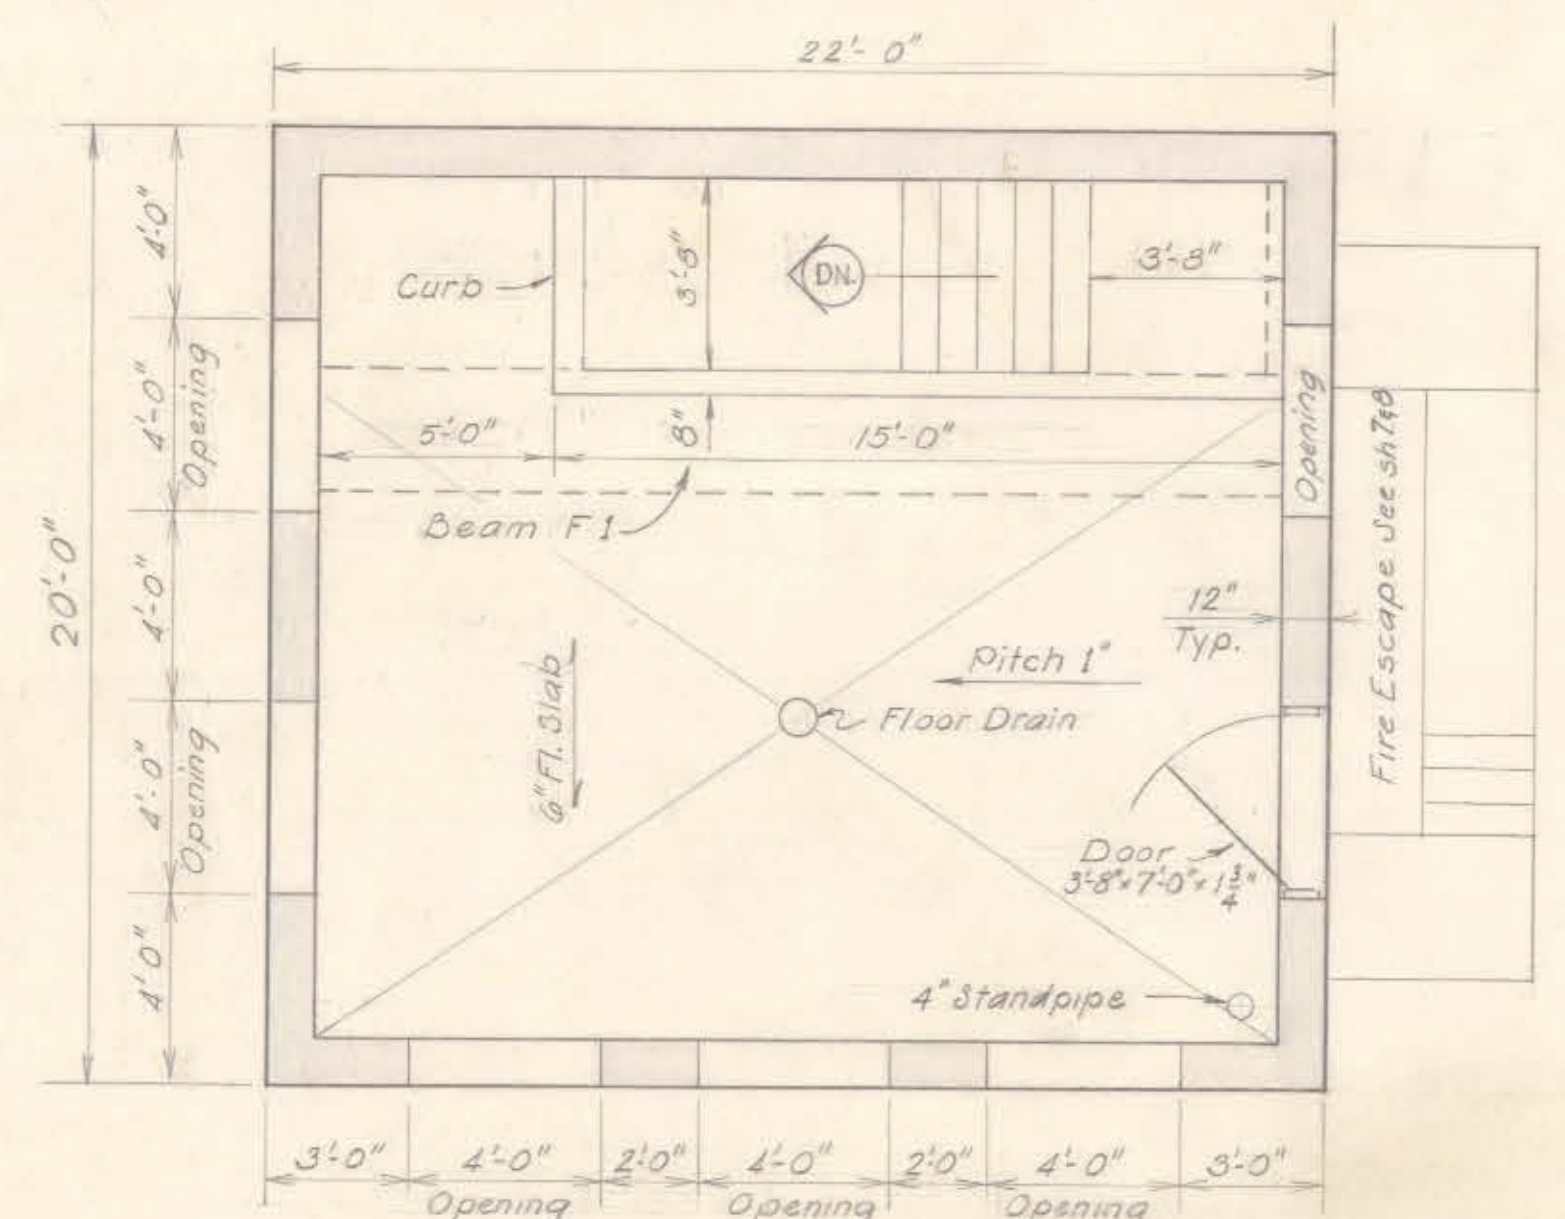

SIXTH FLOOR PLAN
Scale $\frac{1}{4}" = 1'-0"$

FOOTING SCHEDULE				
SPAN	BAND	TRUSS BAR	STR. TOP	STR. BOT.
Long	a	#6 @ 12"	#7 @ 12"	#6 @ 12"
Long	b	#7 @ 12"	#9 @ 12"	#7 @ 12"
Short	a	#7 @ 14"	#7 @ 14"	#7 @ 14"
Short	b	#8 @ 14"	#10 @ 14"	#8 @ 14"

CITY OF HARTFORD, CONNECTICUT
DEPARTMENT OF ENGINEERING

TRAINING TOWER
FOR THE
HARTFORD FIRE DEPARTMENT
CITY OF HARTFORD, CONN.

SUBMITTED: Russell E. Dwyer
RECOMMENDED: Daniel J. Cavill
APPROVED: [Signature]
CITY ARCHITECT
CITY ENGINEER

DESIGN: RED
DRAWN: RED
TRACED: CHECK

DAYBOOK NO. 09769 B
DATE MAR. 27, 1963

Red markings denote "as-built" conditions