



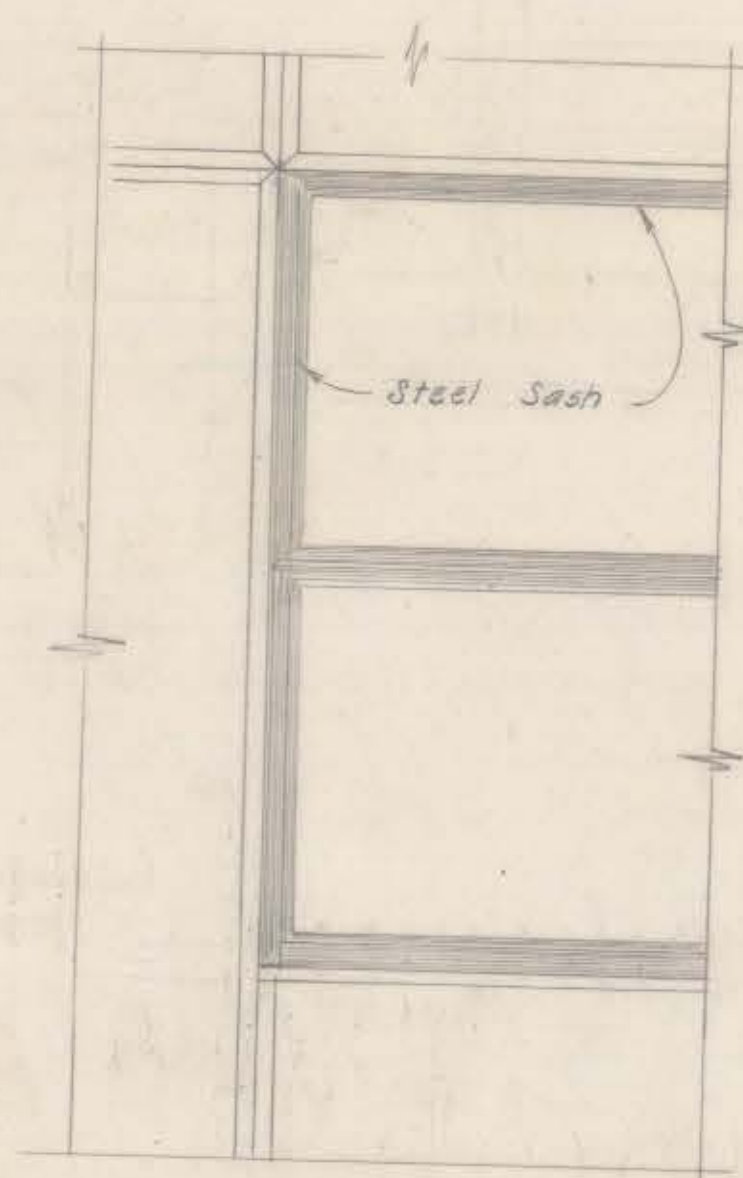

ELEVATION

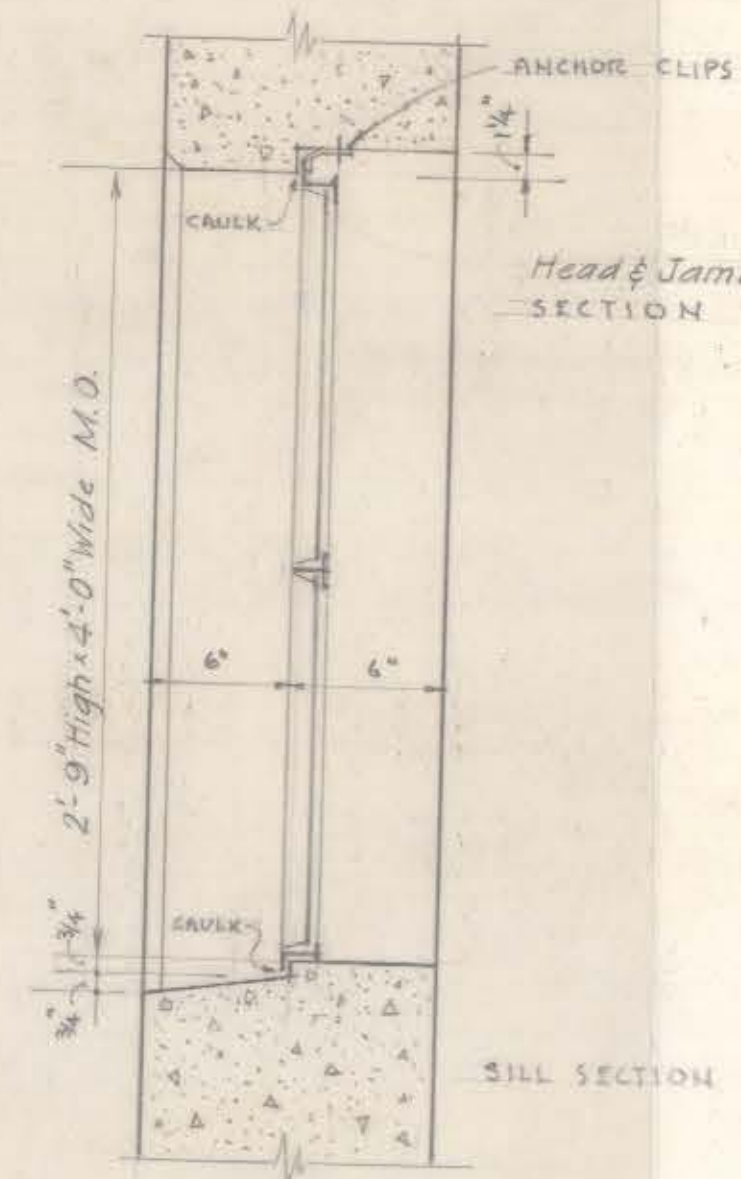


SECTION

Note: Operating sash provided - jamb grooved and sash grouted into place


DETAIL OF METAL SASH

Scale: 1 1/2" = 1'-0"

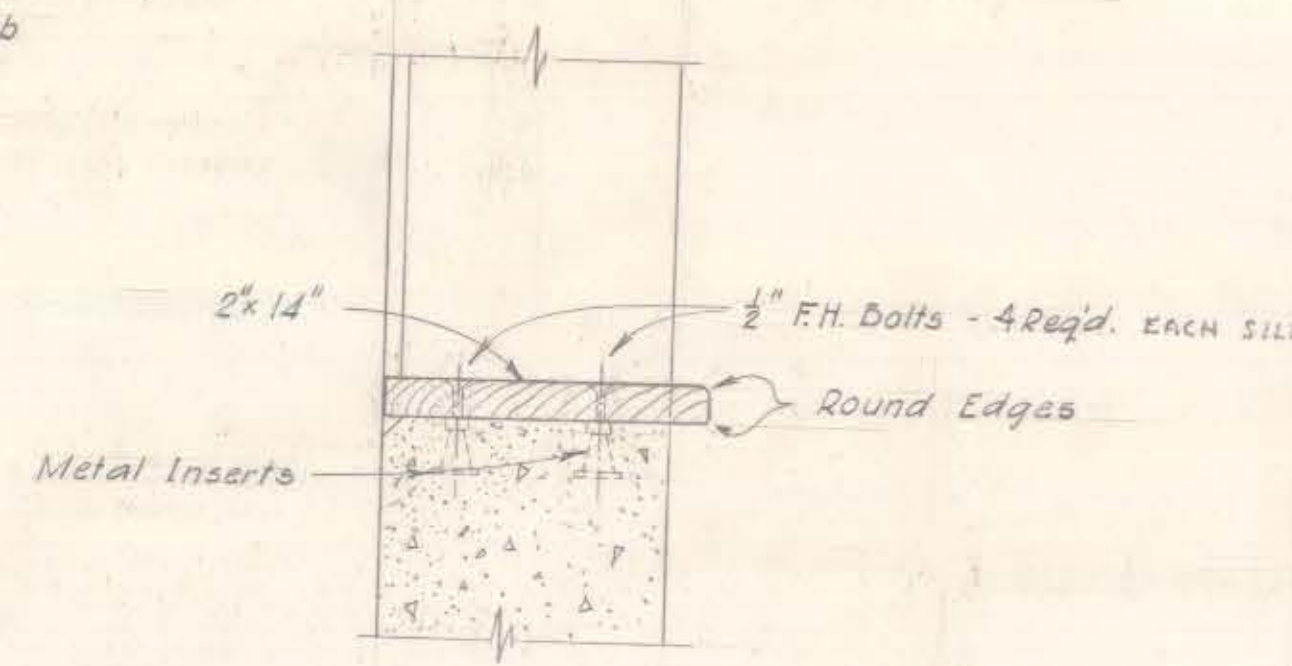

WOOD SILL

Scale 1 1/2" = 1'-0"
South & West Elevations

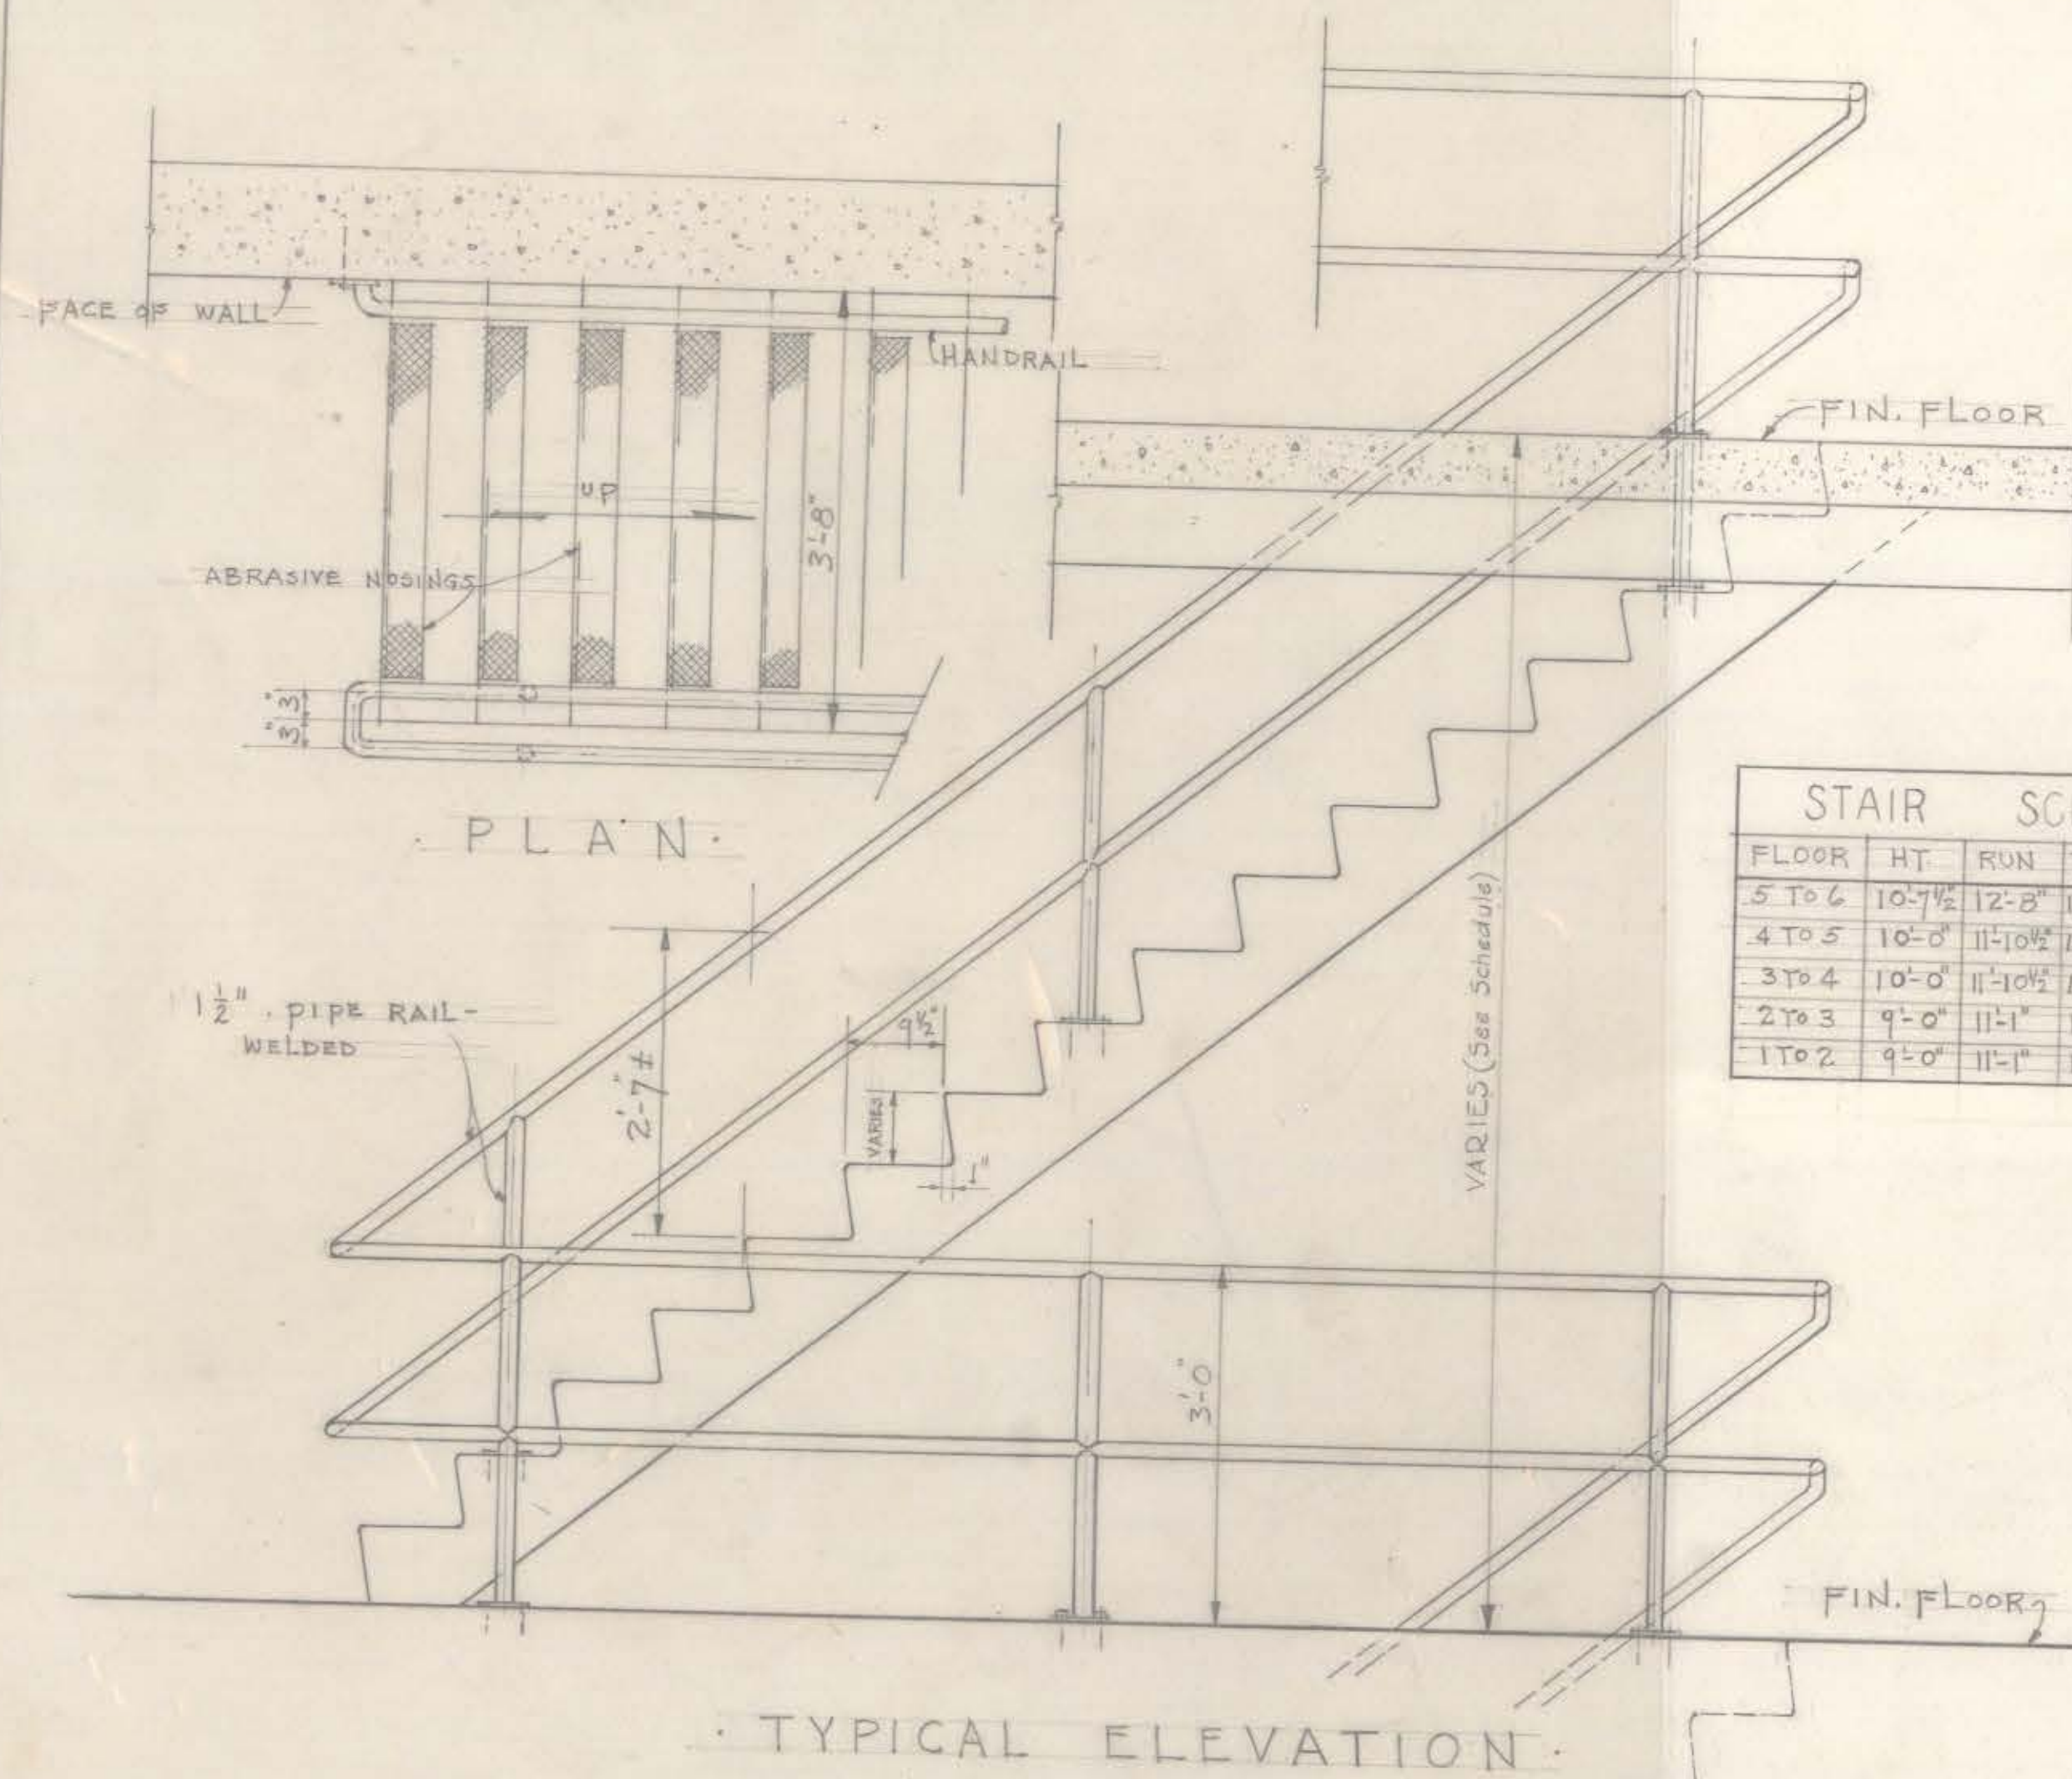


PLAN

TYPICAL ELEVATION

DETAIL OF INTERIOR STAIR


SCALE 3/4" = 1'-0"

STAIR SCHEDULE					
FLOOR	HT.	RUN	TREADS	RISERS	
5 TO 6	10'-7 1/2"	12'-8"	16 @ 9 1/2"	17 @ 7 1/2"	
4 TO 5	10'-0"	11'-10 1/2"	15 @ 9 1/2"	16 @ 7 1/2"	
3 TO 4	10'-0"	11'-10 1/2"	15 @ 9 1/2"	16 @ 7 1/2"	
2 TO 3	9'-0"	11'-1"	14 @ 9 1/2"	15 @ 7 3/4"	
1 TO 2	9'-0"	11'-1"	14 @ 9 1/2"	15 @ 7 3/4"	

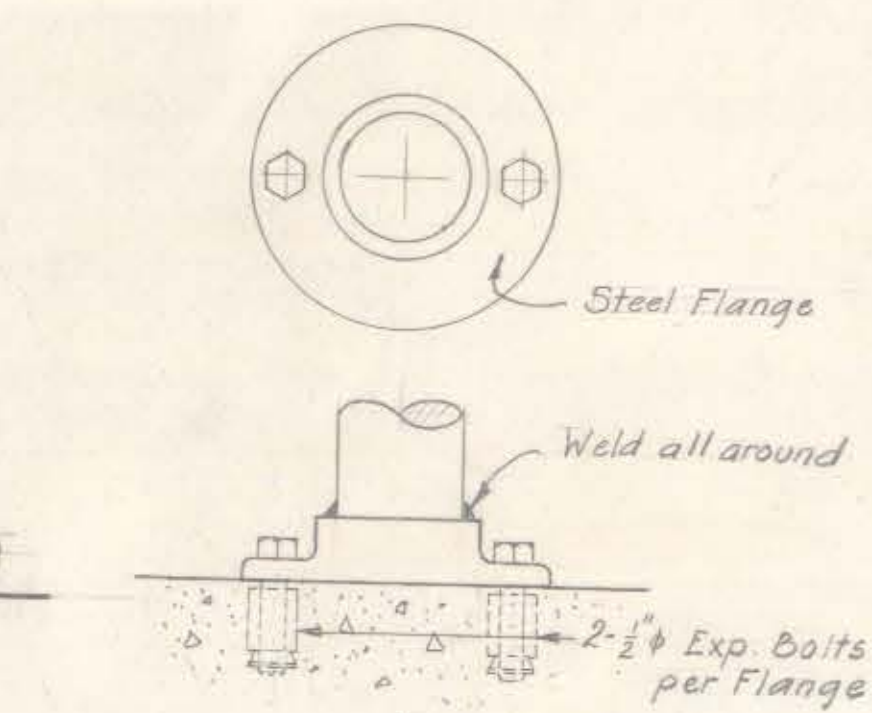


RAIL ANCHORAGE DETAIL

Not to Scale

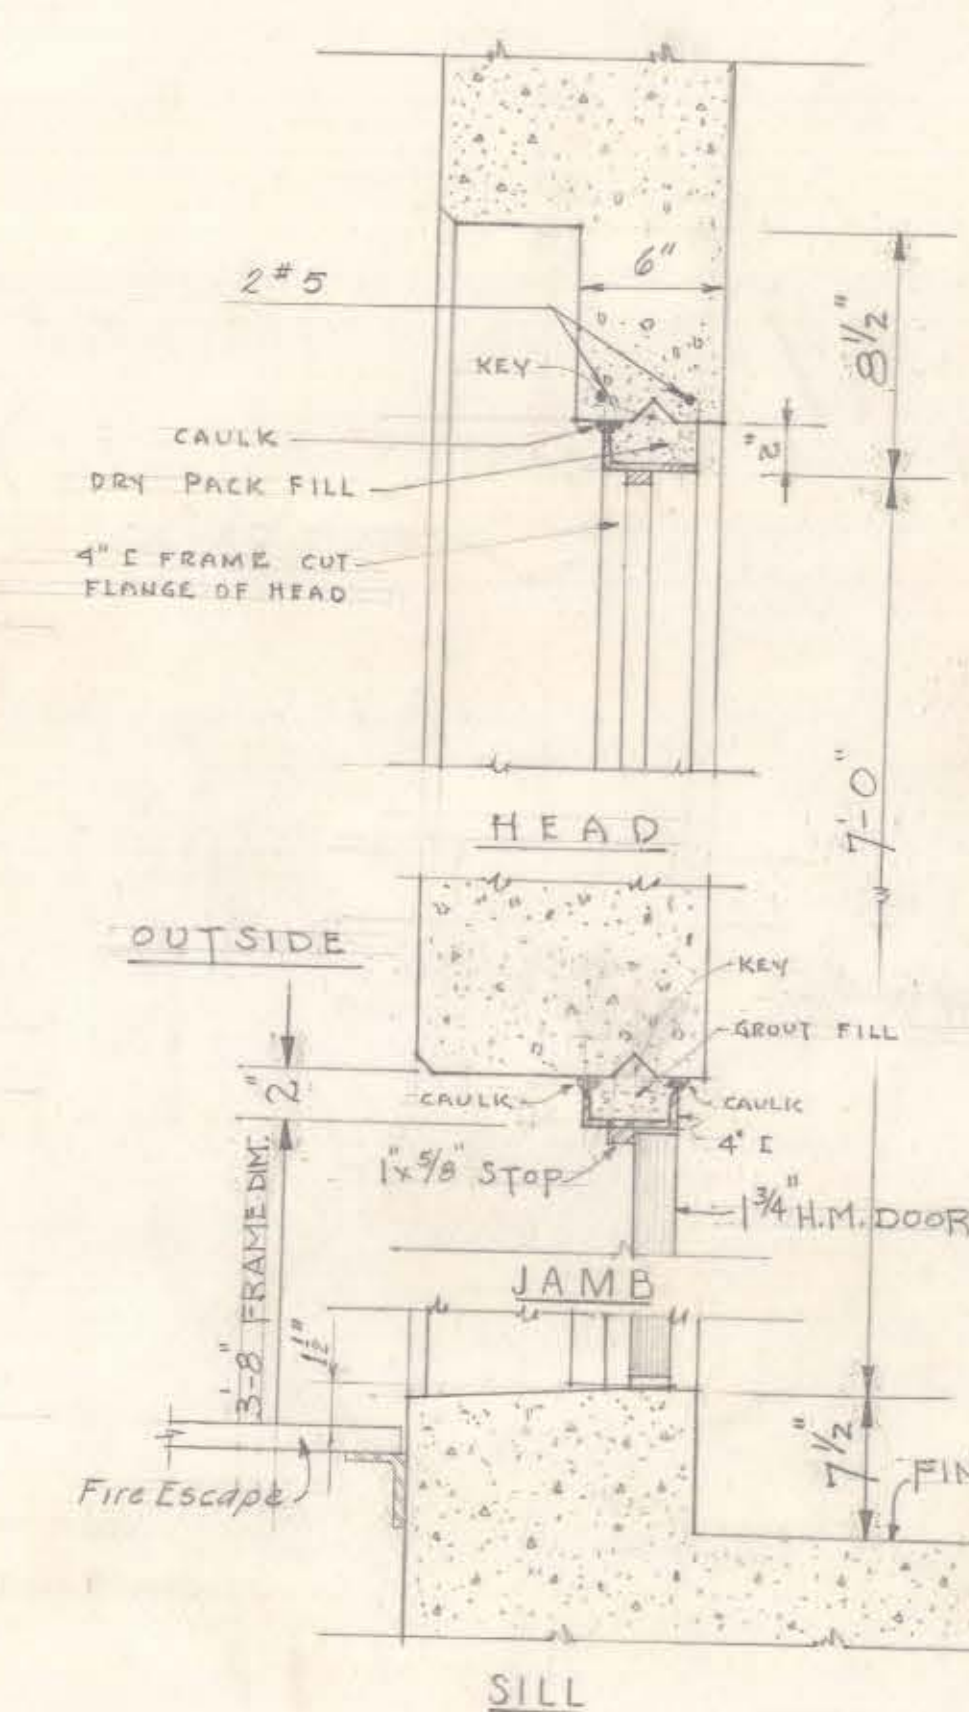


SIXTH FLOOR DOOR

Scale 1 1/2" = 1'-0"

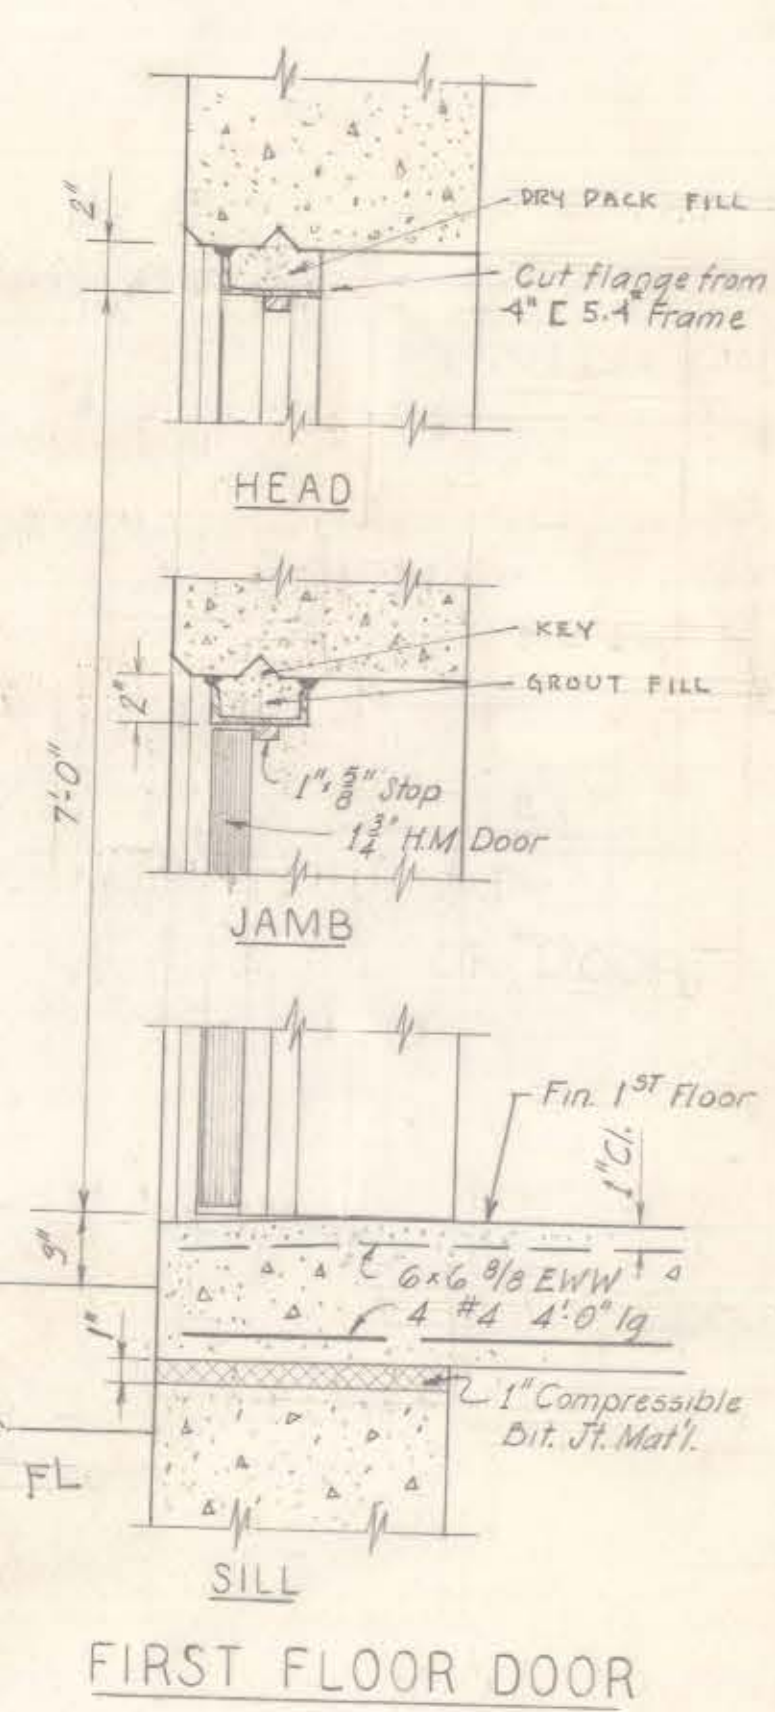

FIRST FLOOR DOOR

Scale 1 1/2" = 1'-0"

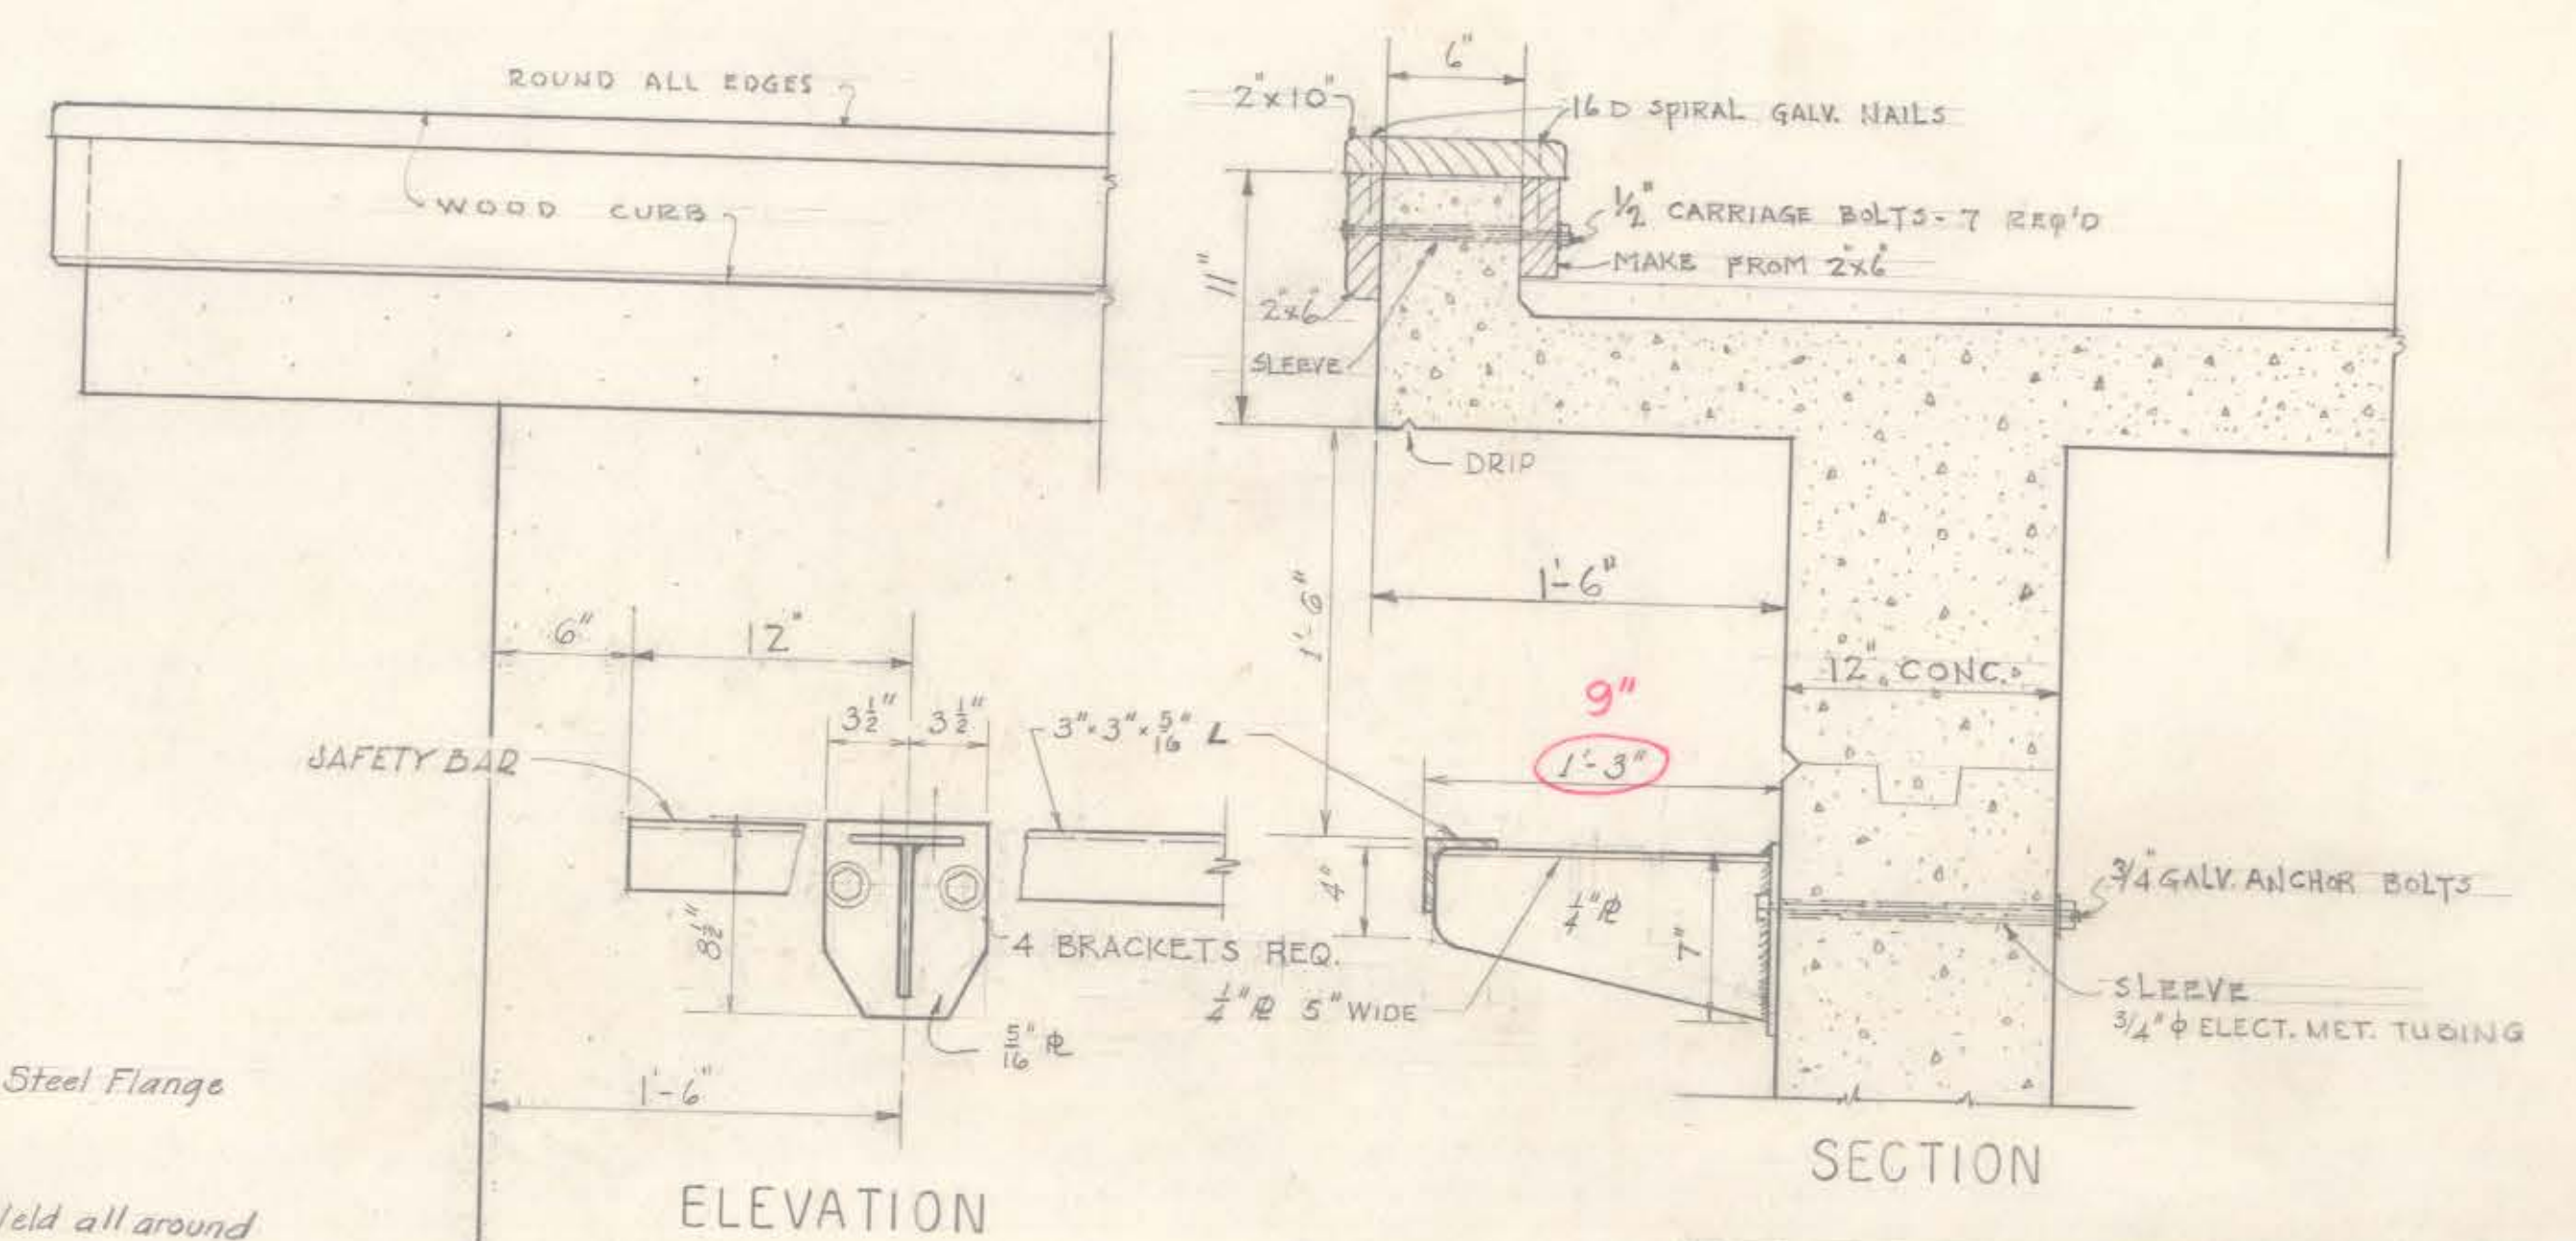

ELEVATION

SECTION

DETAIL OF SOUTH OVERHANG AND SAFETY BAR

Scale 1 1/2" = 1'-0"

Red markings denote "as built" conditions

CITY OF HARTFORD, CONNECTICUT DEPARTMENT OF ENGINEERING			
TRAINING TOWER FOR THE HARTFORD FIRE DEPARTMENT CITY OF HARTFORD, CONN.			
SUBMITTED Russell E. Dory	RECOMMENDED Daniel J. Tarrillo	APPROVED Peter A. Parsons	
CITY ARCHITECT	CITY ENGINEER		
DESIGN AHS	DRAWN AHS	DAYBOOK NO. 09769 F	
TRACED	CHECK	DATE MAR. 27 1963	