
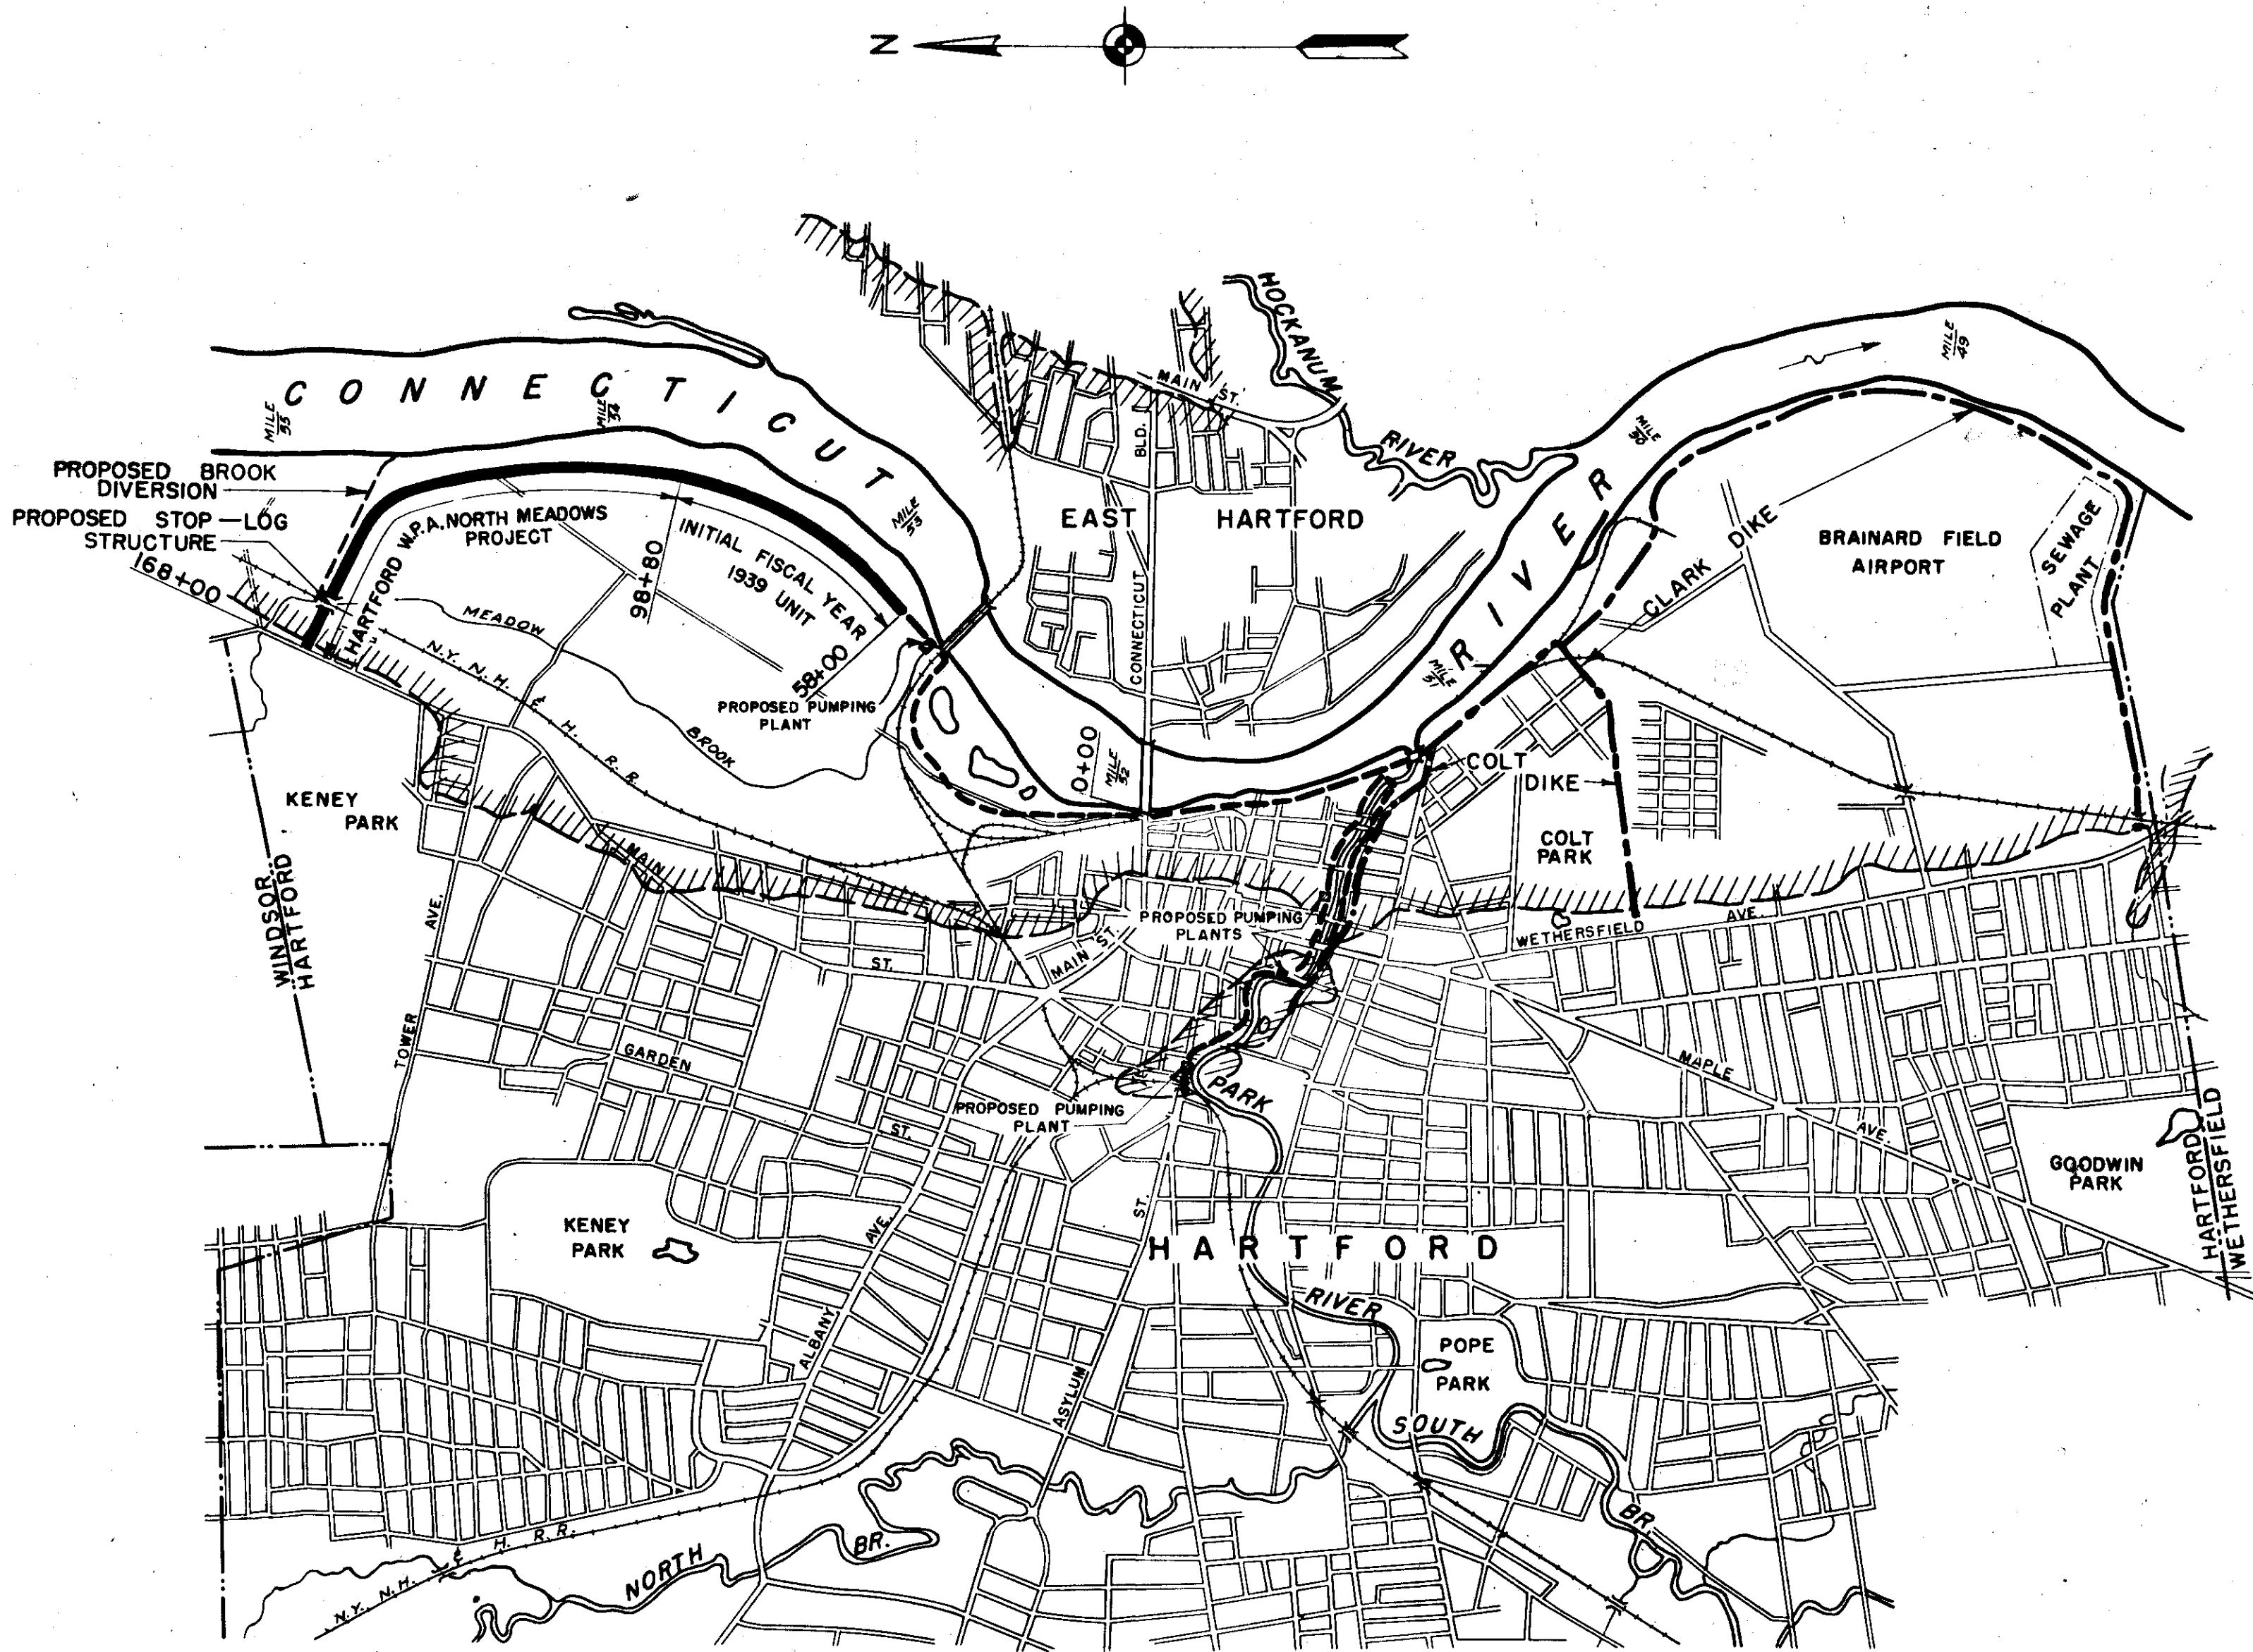


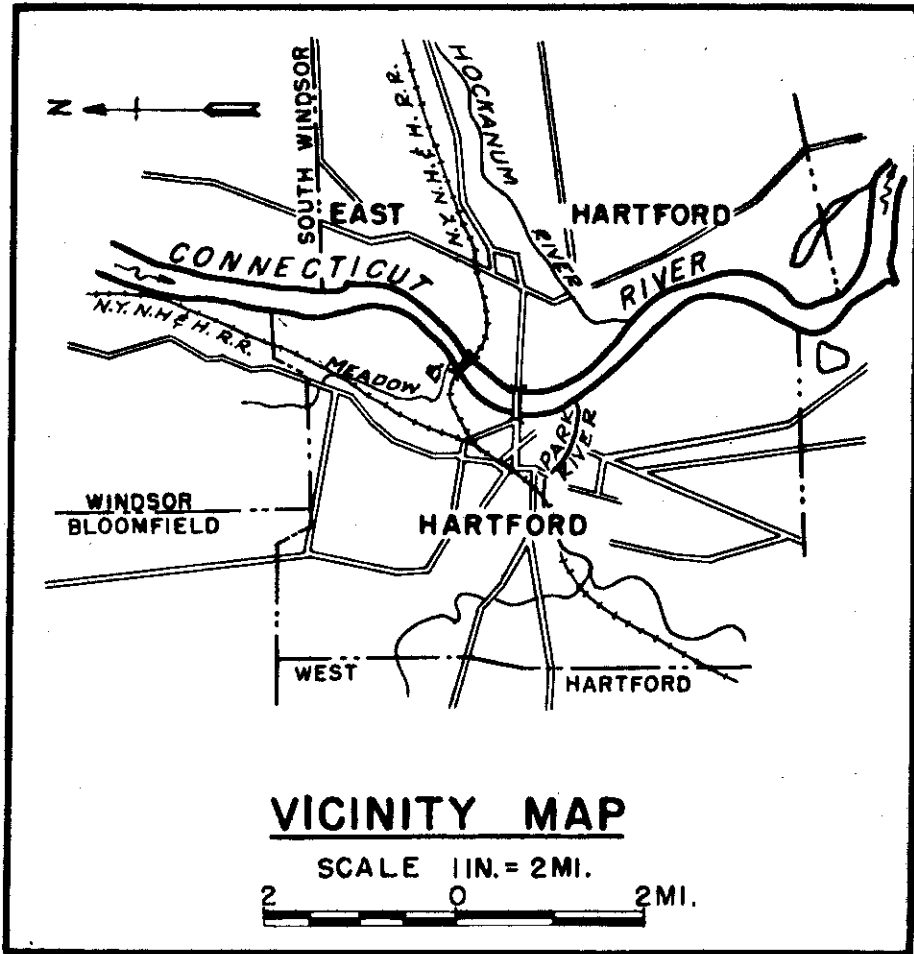

INDEX TO DRAWINGS

SHEET NO	DESCRIPTION	FILE NO.
1	PROJECT LOCATION AND INDEX.	CT-4-1110
PLANS OF SUBSURFACE EXPLORATIONS NORTH MEADOWS DIKE (Complete)		
2	SUBSURFACE EXPLORATIONS.	CT-2-1095
3	RECORD OF SUBSURFACE EXPLORATION NO. 1	CT-2-1102
4	RECORD OF SUBSURFACE EXPLORATION NO. 2	CT-2-1100
5	RECORD OF SUBSURFACE EXPLORATION NO. 3	CT-2-1098
6	RECORD OF SUBSURFACE EXPLORATION NO. 4	CT-2-1097
7	RIVER CROSS-SECTIONS	CT-4-1114
CONSTRUCTION PLANS HARTFORD-W.P.A.-NORTH MEADOWS PROJECT (Station 98+00 to 168+00—exclusive of stop log structure)		
8	BORROW AREAS	CT-4-1113
9	GENERAL PLAN	CT-4-1115
10	LAYOUT OF STEEL SHEET PILING	CT-4-1116
11	MEADOW BROOK DIVERSION	CT-4-1117
12	EMBANKMENT DETAILS	CT-4-1118
13	RAMPS, NO. 1	CT-4-1119
14	RAMPS, NO. 2	CT-4-1141
NORTH MEADOWS DIKE INITIAL FISCAL YEAR 1939 UNIT		
15	STEEL SHEET PILING AND CUT-OFF TRENCH	CT-4-1181

LEGEND

Proposed Project.	—————
Present Dike.	-----
Future Construction.	-----
Overflow Limits of the March 1936 Flood.	

CONNECTICUT RIVER FLOOD CONTROL
NORTH MEADOWS DIKE
PROJECT LOCATION AND INDEX
HARTFORD, CONN.

CONNECTICUT RIVER, CONNECTICUT
IN 15 SHEETS SCALE 1 IN. = 2000 FT. SHEET NO. 1
2000' 0' 4000'

U. S. ENGINEER OFFICE, PROVIDENCE, R. I., OCT. 1938

SUBMITTED: *J. S. Burns* APPROVED: *W. B. Rogers*
PRINCIPAL ENGINEER CAPT. CORPS OF ENGINEERS DISTRICT ENGINEER
CHIEF, ENGINEERING SECTION CHIEF, FLOOD CONTROL DIV.

DESIGNED: *David B. Keaton* DRAWN BY: *J. H.* FILE NO. CT-4-1110
SENIOR ENGINEER CHECKED BY: *J. H.* TO ACCOMPANY SPECIFICATIONS DATED OCT. 1, 1938

12-31-45	As Built				
12-15-38	Addition of Sheet No. 15	K.H.W.	A.B.N.	280	
DATE	REVISION	REV. BY	OK BY	AP BY	