
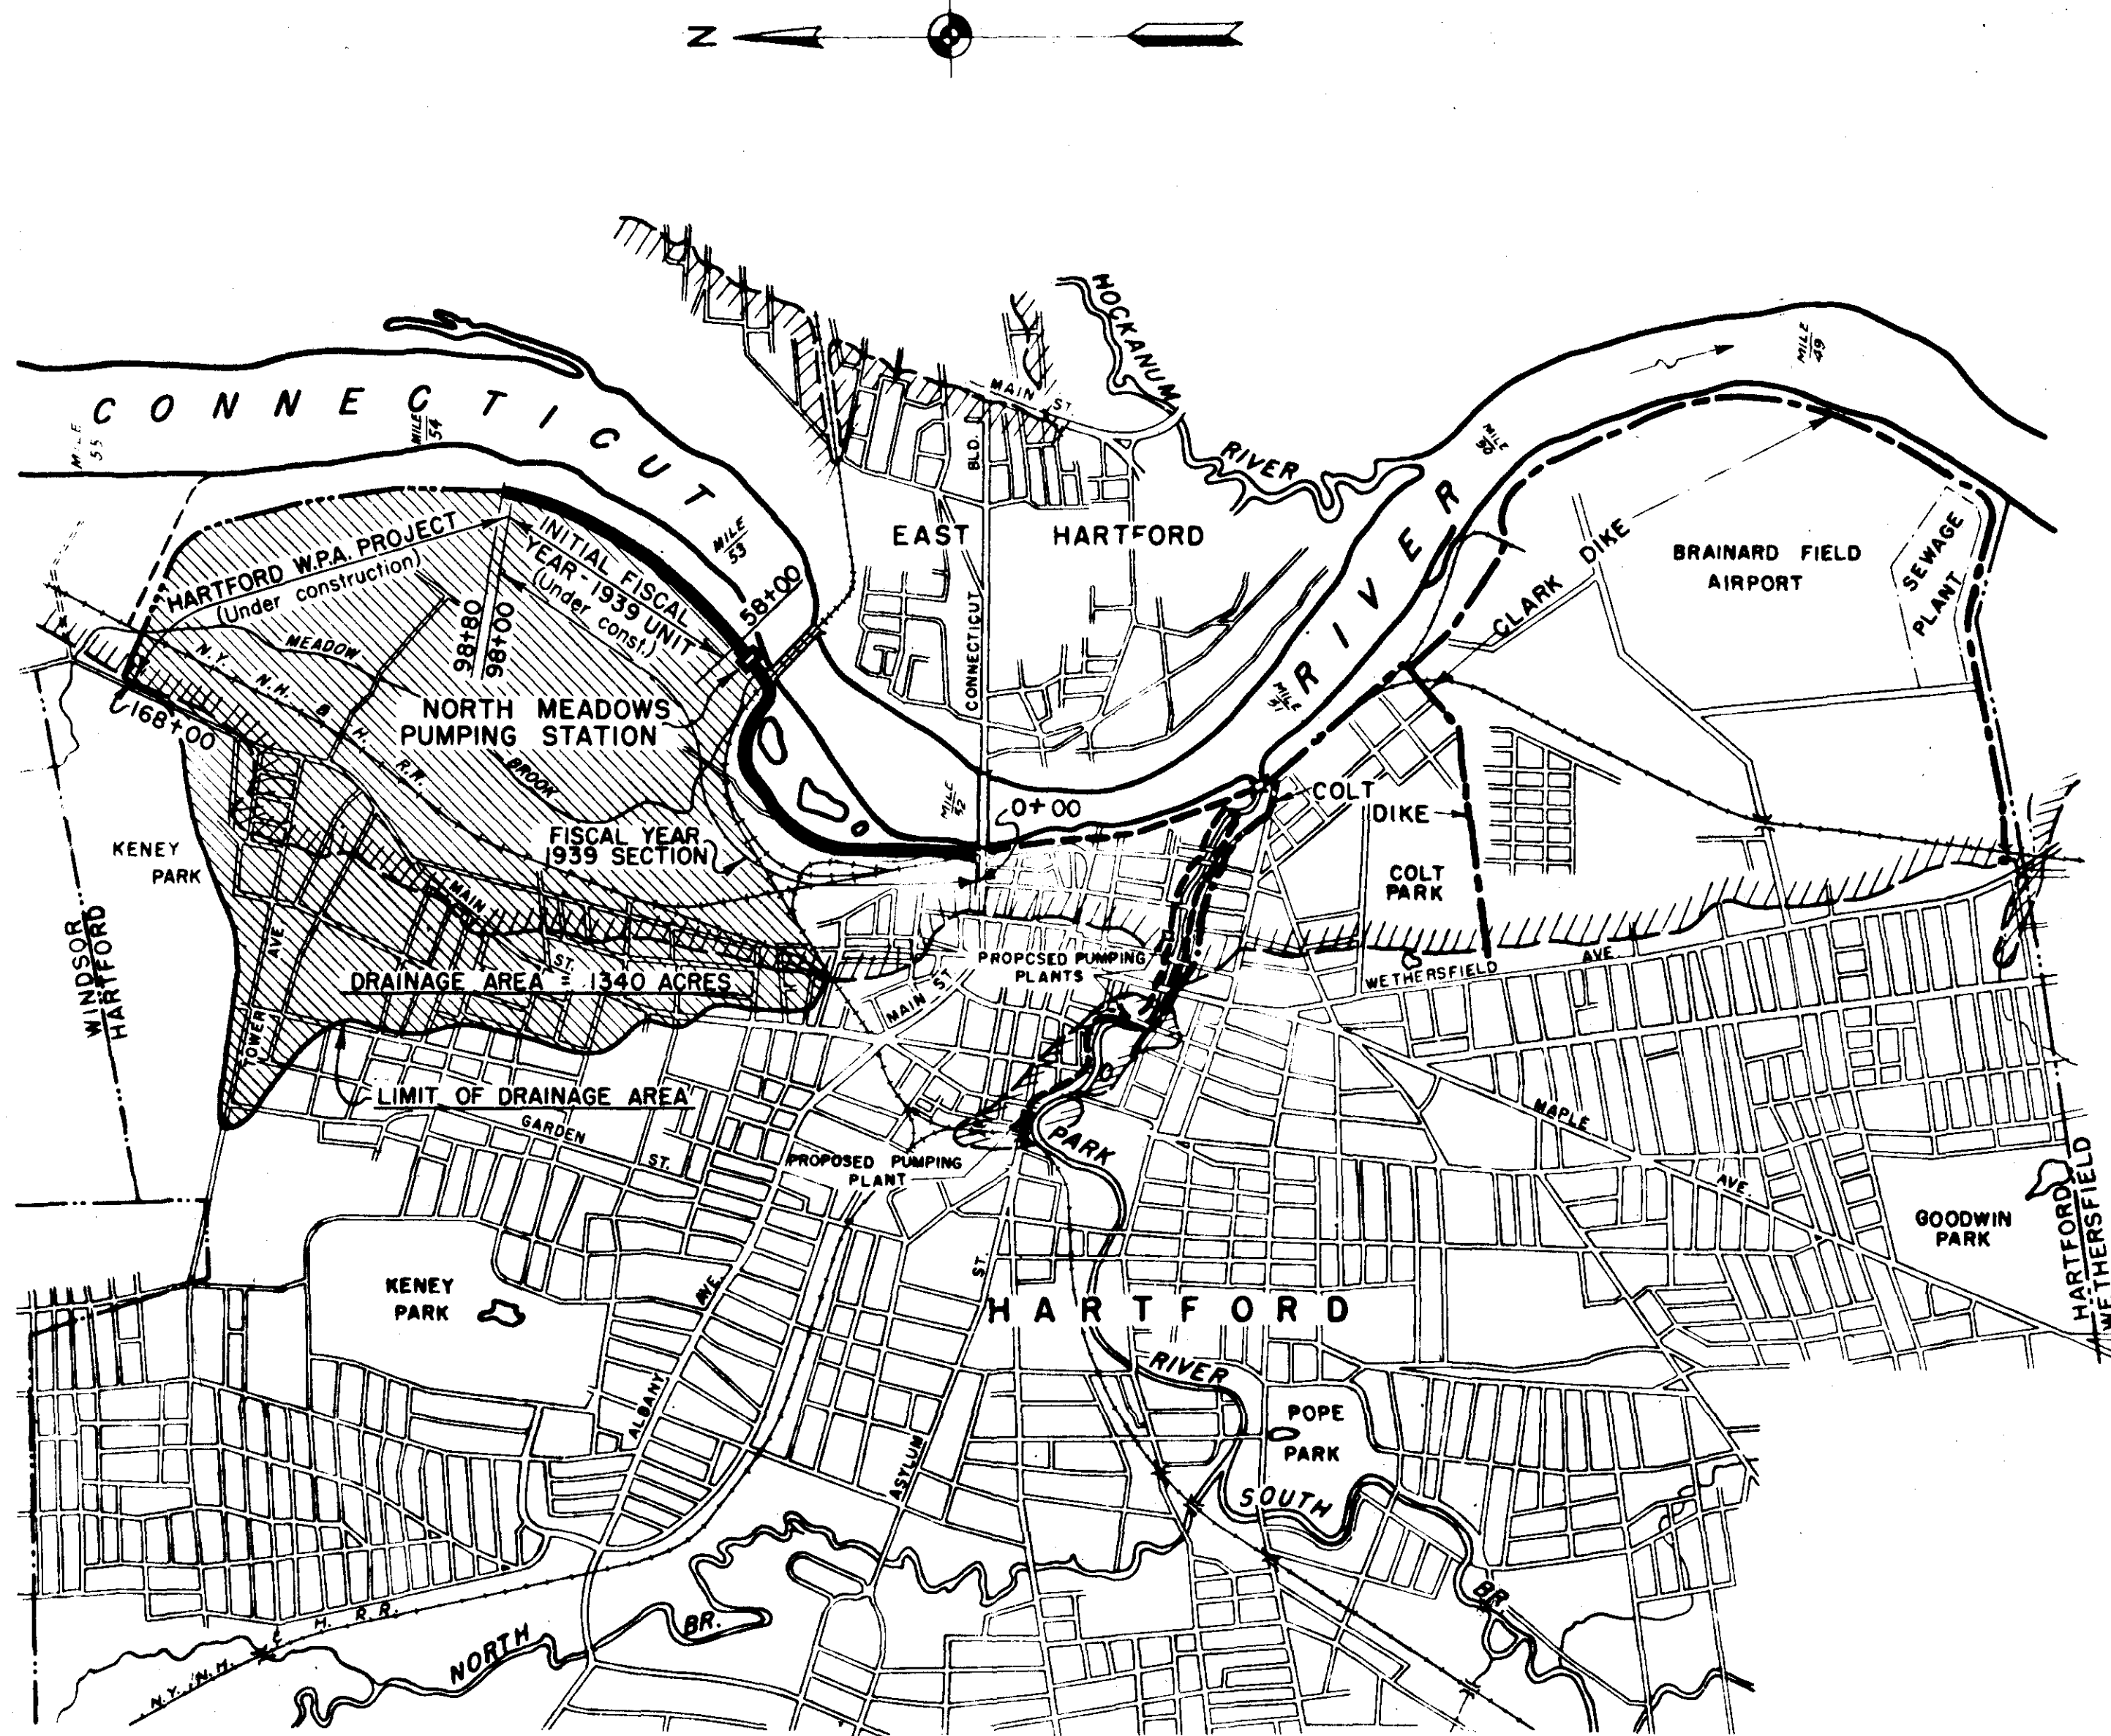


INDEX TO DRAWINGS

SHEET NO.	DESCRIPTION	FILE NO.
1	PROJECT LOCATION AND INDEX	CT-4-1252
2	HYDROGRAPH NO. 1	CT-3-1089
3	HYDROGRAPH NO. 2	CT-3-1090
4	GEOLOGY DRAWINGS	
5	SUBSURFACE EXPLORATION	CT-2-1147
6	CONSTRUCTION DRAWINGS	
7	POND LAYOUT	CT-4-1253
8	GENERAL PLAN	CT-4-1254
9	OUTLET CONDUIT PROFILE AND EXCAVATION DETAILS	CT-4-1255
10	INTAKE STRUCTURE EXCAVATION AND RIPRAP	CT-4-1256
11	OUTLET STRUCTURE EXCAVATION	CT-4-1257
12	ARCHITECTURAL DRAWINGS	
13	SOUTH ELEVATION	CT-4-1258
14	NORTH ELEVATION	CT-4-1259
15	EAST ELEVATION	CT-4-1260
16	WEST ELEVATION	CT-4-1261
17	PLAN OF OPERATING FLOOR	CT-4-1262
18	SECTIONS, ROOF PLAN AND DETAILS	CT-4-1263
19	DOOR AND WINDOW DETAILS	CT-4-1264
20	GATE HOUSE, ELEVATIONS AND SECTIONS	CT-4-1265
21	STRUCTURAL DRAWINGS	
22	EAST WALL STEEL REINFORCEMENT	CT-4-1266
23	WEST WALL STEEL REINFORCEMENT	CT-4-1267
24	OPERATING FLOOR SLAB	CT-4-1268
25	BEAM SECTIONS THROUGH FLOOR	CT-4-1269
26	ROOF FRAMING PLAN	CT-4-1270
27	FRAMING DETAILS	CT-4-1271
28	ROOF SLAB	CT-4-1272
29	STAIRS AND WALKWAYS	CT-4-1273
30	PLAN OF PUMP ROOM AND SUCTION CONDUIT FLOORS	CT-4-1274
31	CONDUIT TRANSITION AND OUTLET	CT-4-1275
32	PLAN OF CONDUIT ROOF SLABS	CT-4-1276
33	TRANSVERSE SECTIONS	CT-4-1277
34	DETAILS FOR INTAKE AND INTAKE WING WALL	CT-4-1278
35	INTAKE WING WALLS	CT-4-1279
36	PLAN OF DISCHARGE CONDUIT FLOOR	CT-4-1280
37	CONDUIT DETAILS NO. 1	CT-4-1281
38	CONDUIT DETAILS NO. 2	CT-4-1282
39	OUTLET GATE STRUCTURE	CT-4-1283
40	STEEL REINFORCEMENT NO. 1	CT-4-1284
41	STEEL REINFORCEMENT NO. 2	CT-4-1285
42	STEEL REINFORCEMENT NO. 3	CT-4-1286
43	STEEL REINFORCEMENT NO. 4	CT-4-1287
44	STEEL REINFORCEMENT NO. 5	CT-4-1288
45	STEEL REINFORCEMENT NO. 6	CT-4-1289
46	STEEL REINFORCEMENT NO. 7	CT-4-1290
47	STEEL REINFORCEMENT NO. 8	CT-4-1291
48	MISCELLANEOUS STEEL DRAWING	
49	TRASH RACKS, DOOR FRAMES AND LADDERS	CT-4-1292
50	MECHANICAL DRAWINGS	
51	GENERAL ARRANGEMENT OF EQUIPMENT NO. 1	CT-4-1293
52	GENERAL ARRANGEMENT OF EQUIPMENT NO. 2	CT-4-1294
53	GENERAL ARRANGEMENT OF EQUIPMENT NO. 3	CT-4-1295
54	INTAKE SLUICE GATES	CT-4-1296
55	OUTLET SLUICE GATES	CT-4-1297
56	SLUICE GATE OIL SUPPLY SYSTEM	CT-4-1298
57	PLUMBING AND HEATING NO. 1	CT-4-1299
58	PLUMBING AND HEATING NO. 2	CT-4-1300
59	PLUMBING AND HEATING NO. 3	CT-4-1301
60	GASOLINE PIPING SYSTEM	CT-4-1302
61	GASOLINE PIPING DETAILS	CT-4-1303
62	EXHAUST PIPING	CT-4-1304
63	ELECTRIC LIGHT AND POWER SYSTEM NO. 1	CT-4-1305
64	ELECTRIC LIGHT AND POWER SYSTEM NO. 2	CT-4-1306
65	ELECTRIC LIGHT AND POWER SYSTEM NO. 3	CT-4-1307
66	PUMPING EQUIPMENT FOUNDATIONS	CT-4-1950
67	PUMPING EQUIPMENT FOUNDATIONS	CT-4-1951
68	EQUIPMENT FOUNDATIONS	CT-4-1952

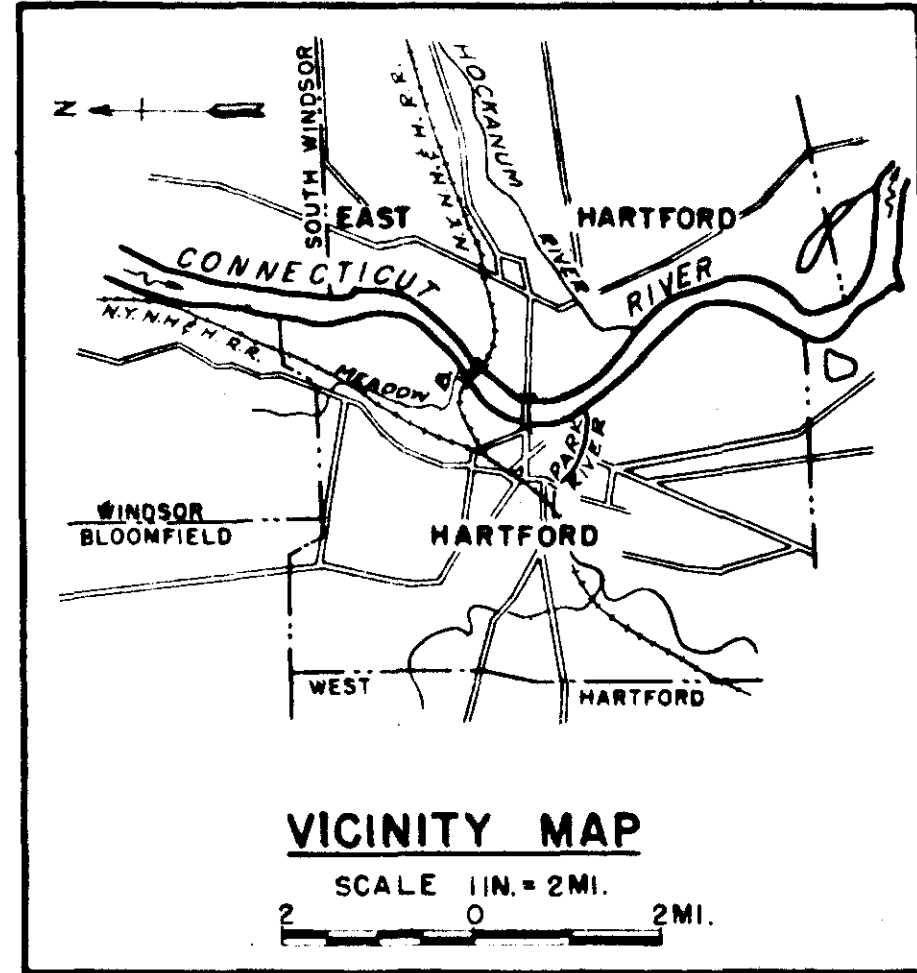

LEGEND

- Fiscal Year 1939 Section, Dike Contract
- Hartford-W.P.A. Project
- Present Dike
- Future Construction
- Overflow Limits of the March 1936 Flood

NOTE

Initial Fiscal Year 1939 Unit designates limits of steel sheet piling under construction.

NOTE: ELEVATIONS REFER TO MEAN SEA LEVEL DATUM EXCEPT HYDROGRAPH SHEETS NOS. 2 AND 3.

12-31-45	As built				
10-13-39	Sheets No. 60, 61, 62 added	J.C.S.	H.W.	J.S.B.	
KEY	DATE	REVISION (Indicated by Δ)	REV. BY	CK. BY	AP. BY

CONNECTICUT RIVER FLOOD CONTROL
NORTH MEADOWS PUMPING STATION
FISCAL YEAR 1939 SECTION
PROJECT LOCATION AND INDEX
HARTFORD, CONN.

CONNECTICUT RIVER CONNECTICUT
IN 62 SHEETS SCALE: 1 IN = 2000 FT. SHEET NO. 1

U. S. ENGINEER OFFICE, PROVIDENCE, R.I., FEB. 1939

SUBMITTED: *Amid B. Nielsen* APPROVAL: *J.S. Burns* APPROVED: *J.S. Burns*
HEAD, DESIGN SECTION SENIOR ENGINEER PRINCIPAL ENGINEER
DESIGNED: *J. Hartley* DRAWN BY: E. J. H. FILE NO. CT-4-1252
ASST. ENGINEER CHECKED BY: W. A. E.