


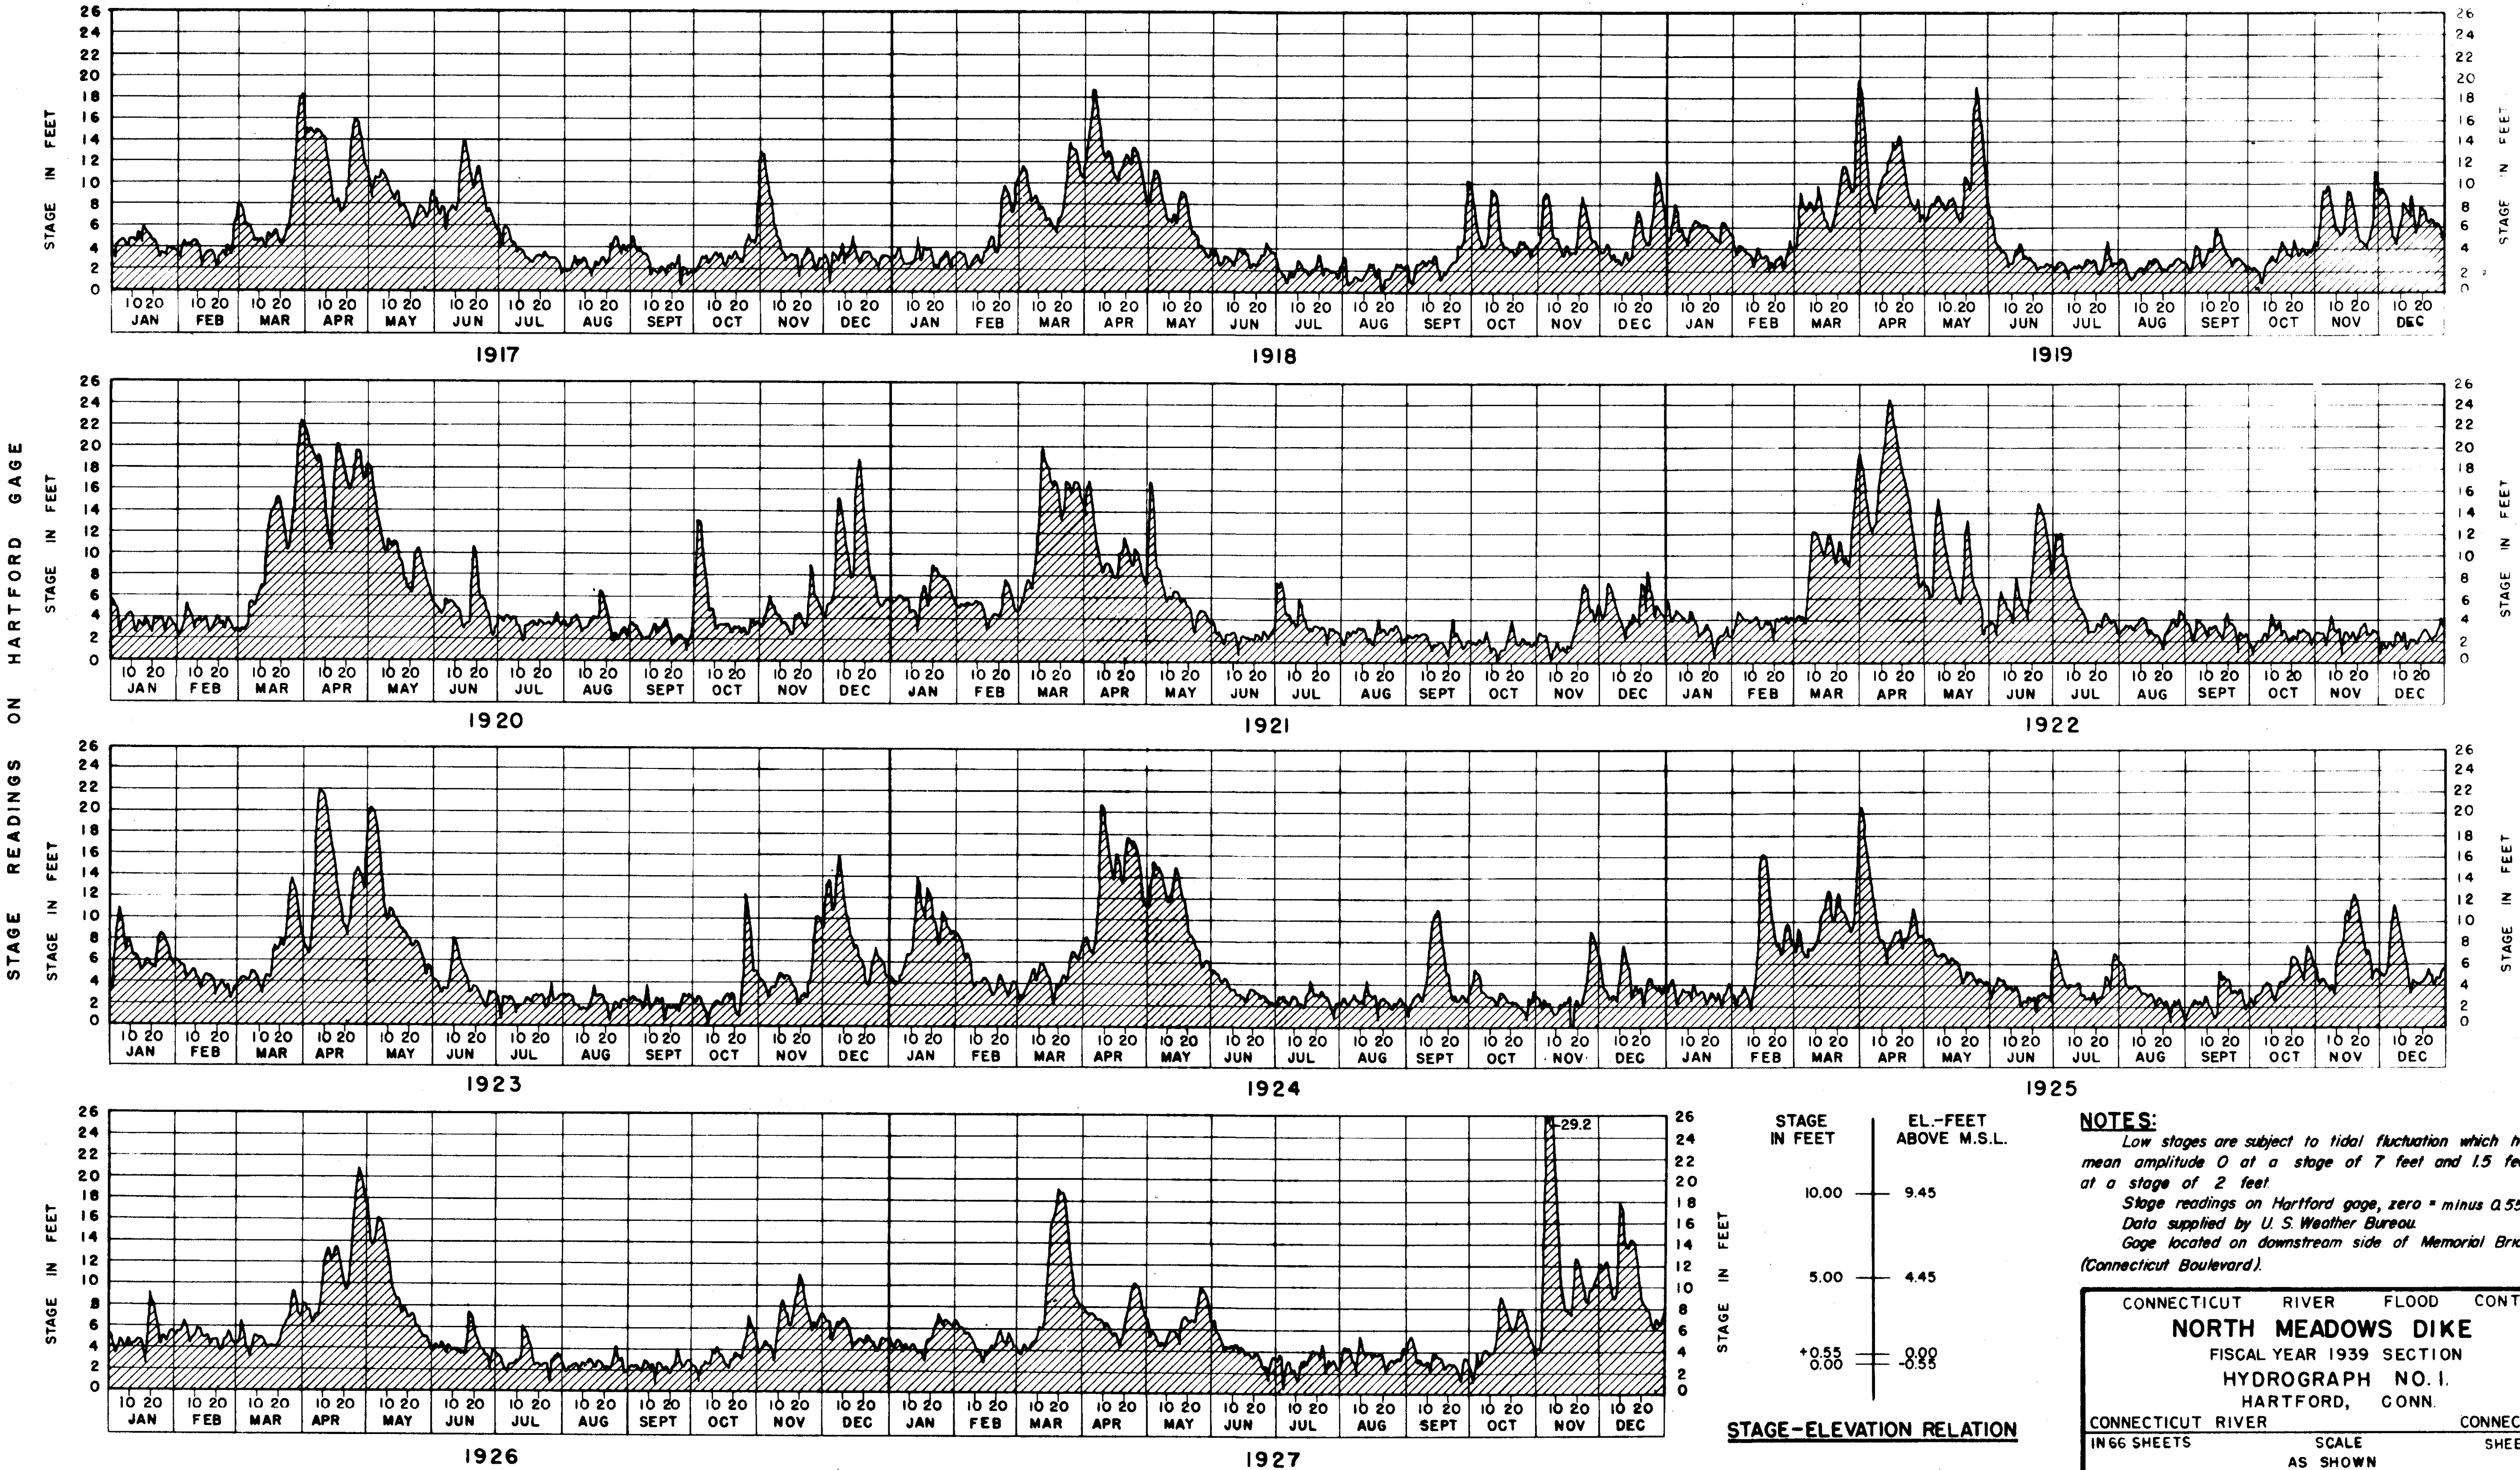

NOTES:
Low stages are subject to tidal fluctuation which has a mean amplitude 0 at a stage of 7 feet and 1.5 feet at a stage of 2 feet.
Stage readings on Hartford gage, zero = minus 0.55' M.S.L.
Data supplied by U. S. Weather Bureau.
Gage located on downstream side of Memorial Bridge (Connecticut Boulevard).

CONNECTICUT RIVER FLOOD CONTROL	
NORTH MEADOWS DIKE	
FISCAL YEAR 1939 SECTION	
HYDROGRAPH NO. 1.	
HARTFORD, CONN.	
CONNECTICUT RIVER	CONNECTICUT
IN 66 SHEETS	SHEET NO. 2
SCALE AS SHOWN	
U.S. ENGINEER OFFICE, PROVIDENCE, R. I., APRIL 1939	
SUBMITTED: <i>John B. Drake</i> ENGINEER HEAD, HYDRAULICS SECTION	APPROVED: <i>J. S. Burns</i> PRINCIPAL ENGINEER CHIEF, P.C. ENGINEERING DIV.
COMPILED: <i>Reginald M. Hays</i> ASSOC. ENGINEER	DRAWN BY: W.W.V. & F.C.T. CHECKED BY: W.C.N.
FILE NO. CT-3-1093	

12/31/45	As-Built				
DATE	REVISION	REV. BY	CK. BY	AP. BY	