
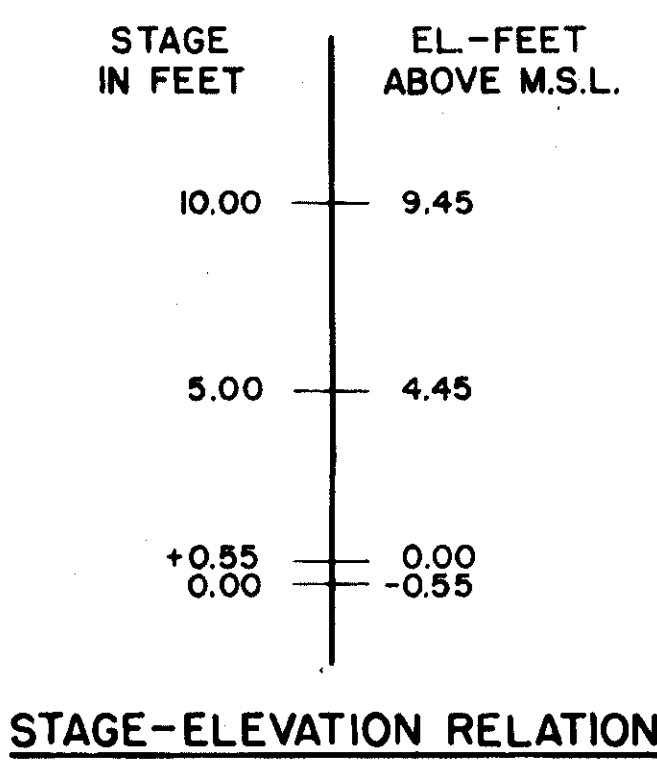


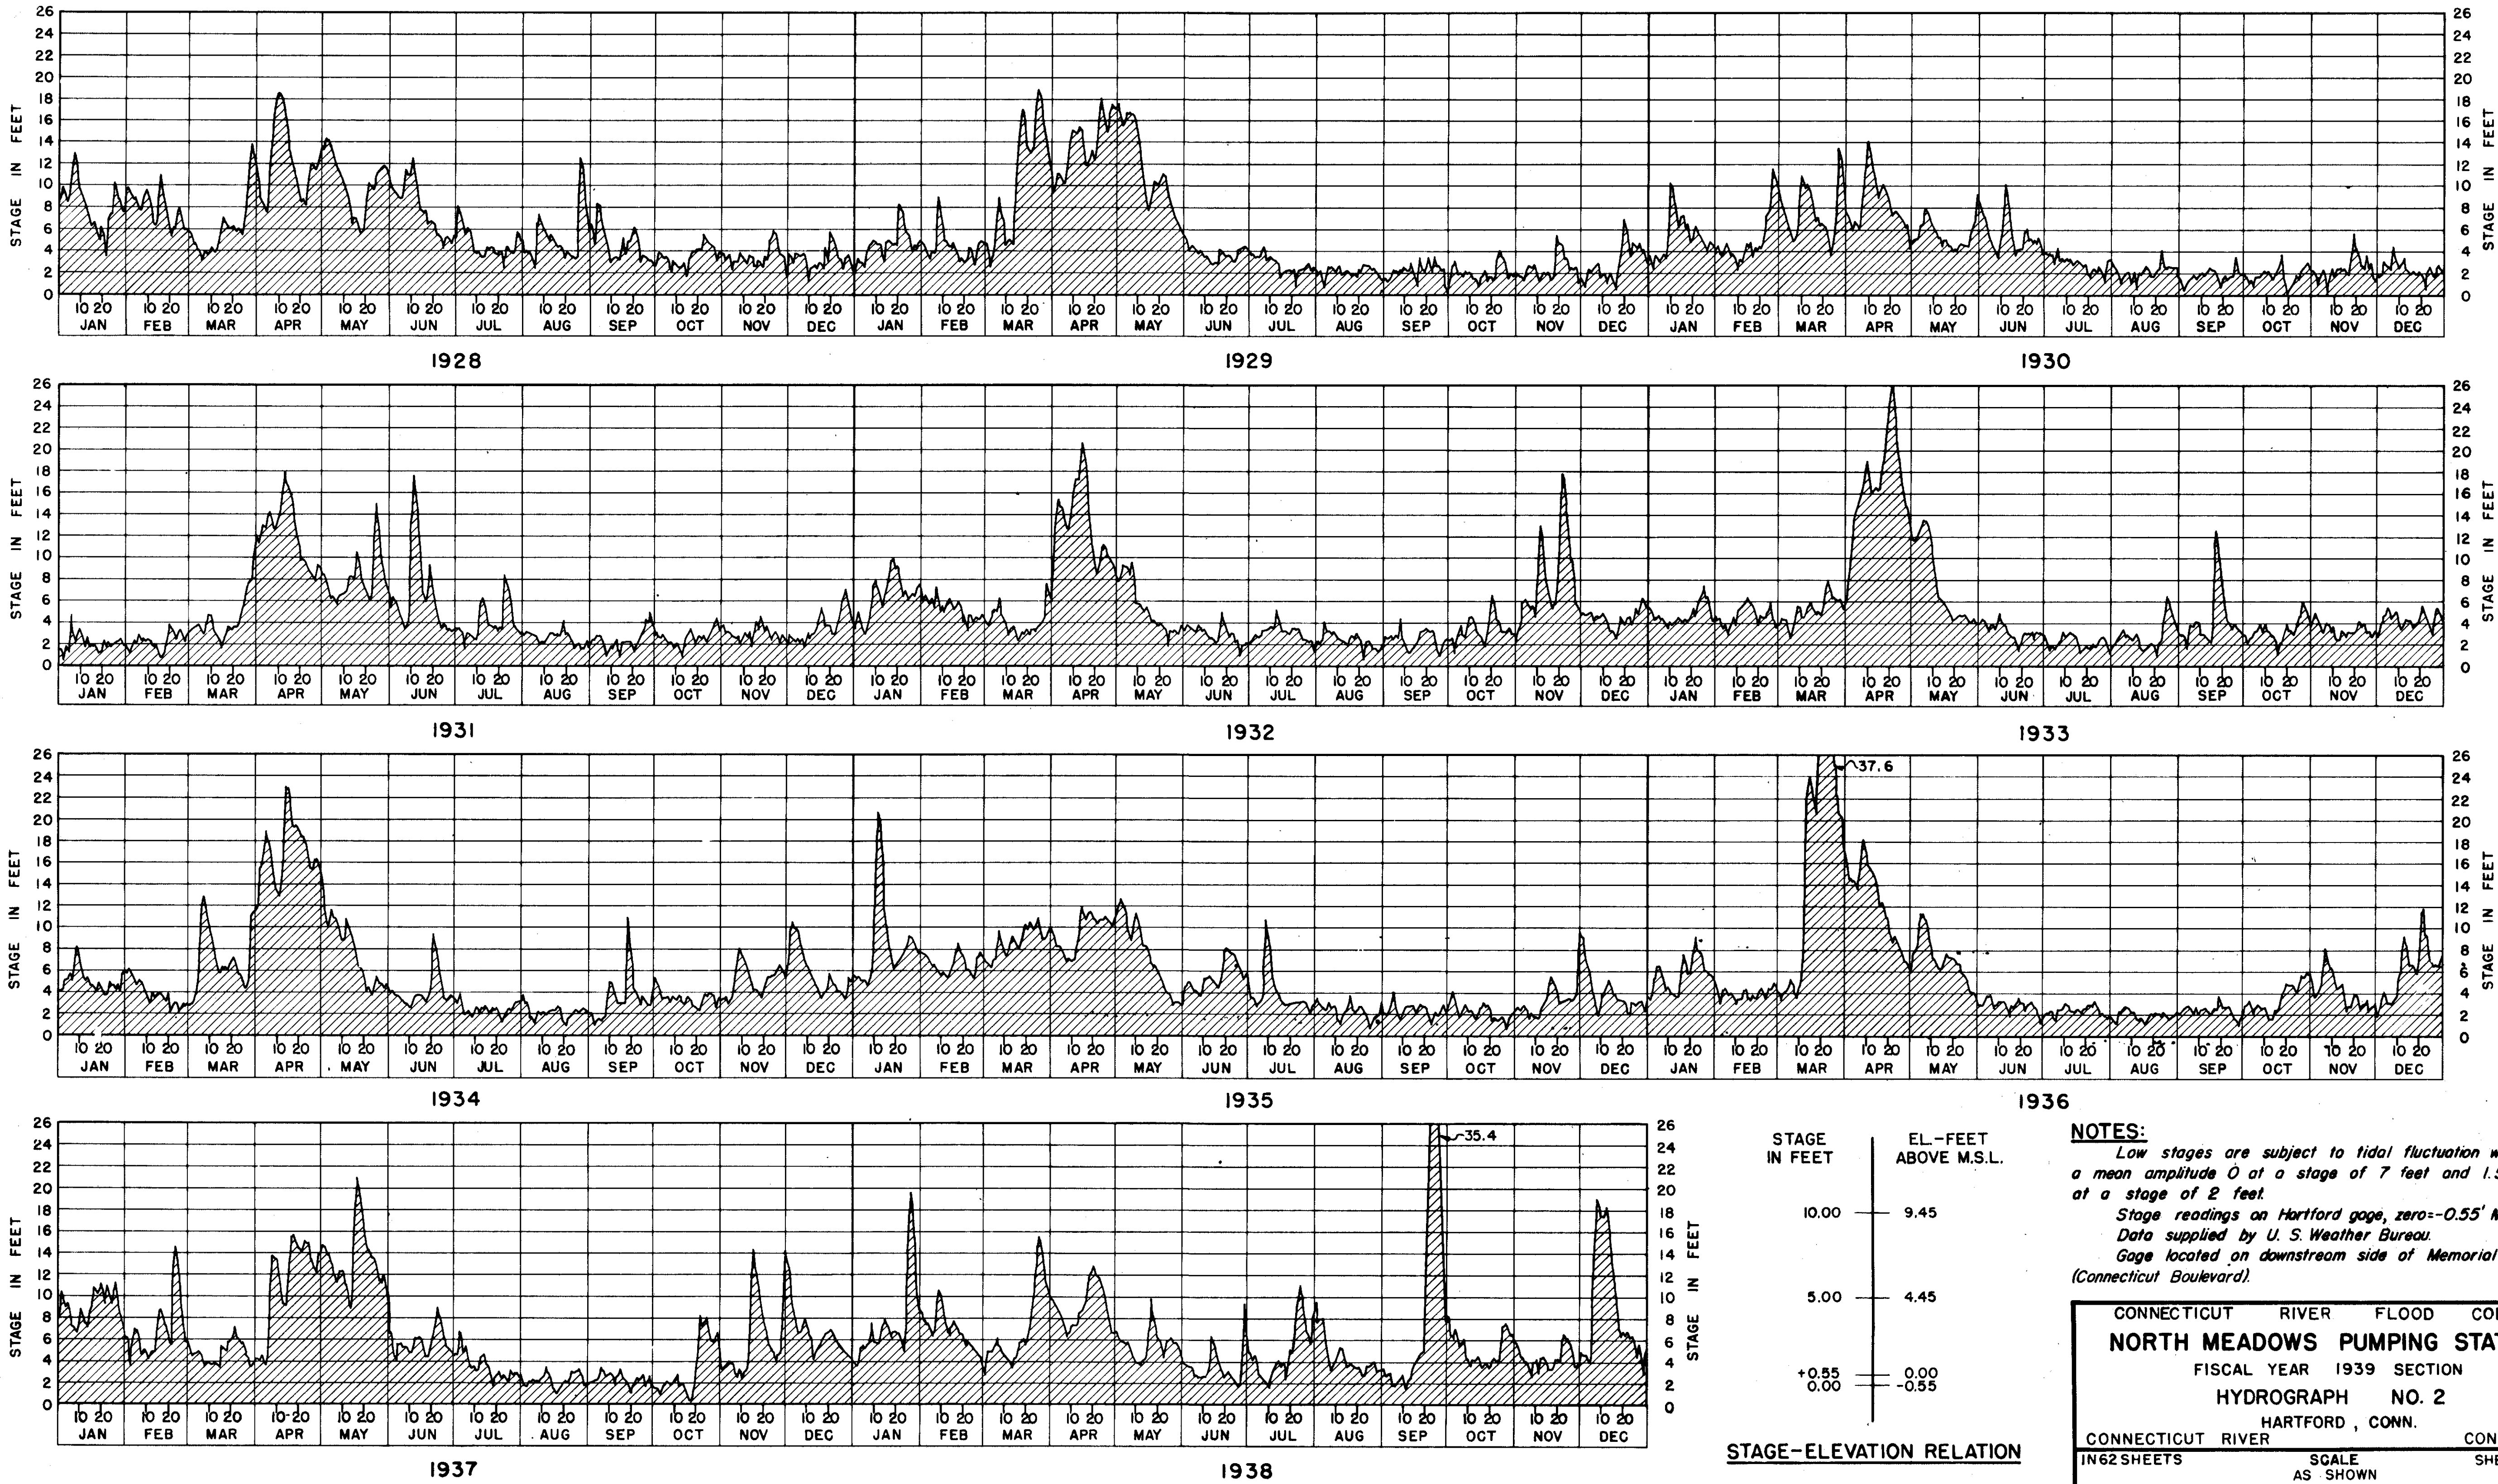

NOTES:
Low stages are subject to tidal fluctuation which has a mean amplitude 0 at a stage of 7 feet and 1.5 feet at a stage of 2 feet.
Stage readings on Hartford gage, zero--0.55' M.S.L.
Data supplied by U. S. Weather Bureau.
Gage located on downstream side of Memorial Bridge (Connecticut Boulevard).

CONNECTICUT RIVER FLOOD CONTROL		
NORTH MEADOWS PUMPING STATION		
FISCAL YEAR 1939 SECTION		
HYDROGRAPH NO. 2		
HARTFORD, CONN.		
CONNECTICUT RIVER	HARTFORD, CONN.	CONNECTICUT
162 SHEETS	SCALE AS SHOWN	SHEET NO. 3
U. S. ENGINEER OFFICE, PROVIDENCE, R.I., FEB. 1939		
SUBMITTED: <i>James B. Smith</i>	RECOMMENDED: <i>J. B. Smith</i>	APPROVED: <i>W. W. M.</i>
ENGINEER	PRINCIPAL ENGINEER	LT. COL. CORPS OF ENGINEERS
HEAD, HYDRAULICS SECTION	CHIEF, F.C. ENGINEERING DIV.	DISTRICT ENGINEER
COMPILED: <i>W. W. M.</i>	DRAWN BY: W.W.V. & F.C.T.	FILE NO. CT-3-1090
CHECKED BY: <i>W. W. M.</i>	CHECKED BY:	

12-31-45	As built				
DATE	REVISION	REV. BY	CK. BY	AP. BY	