


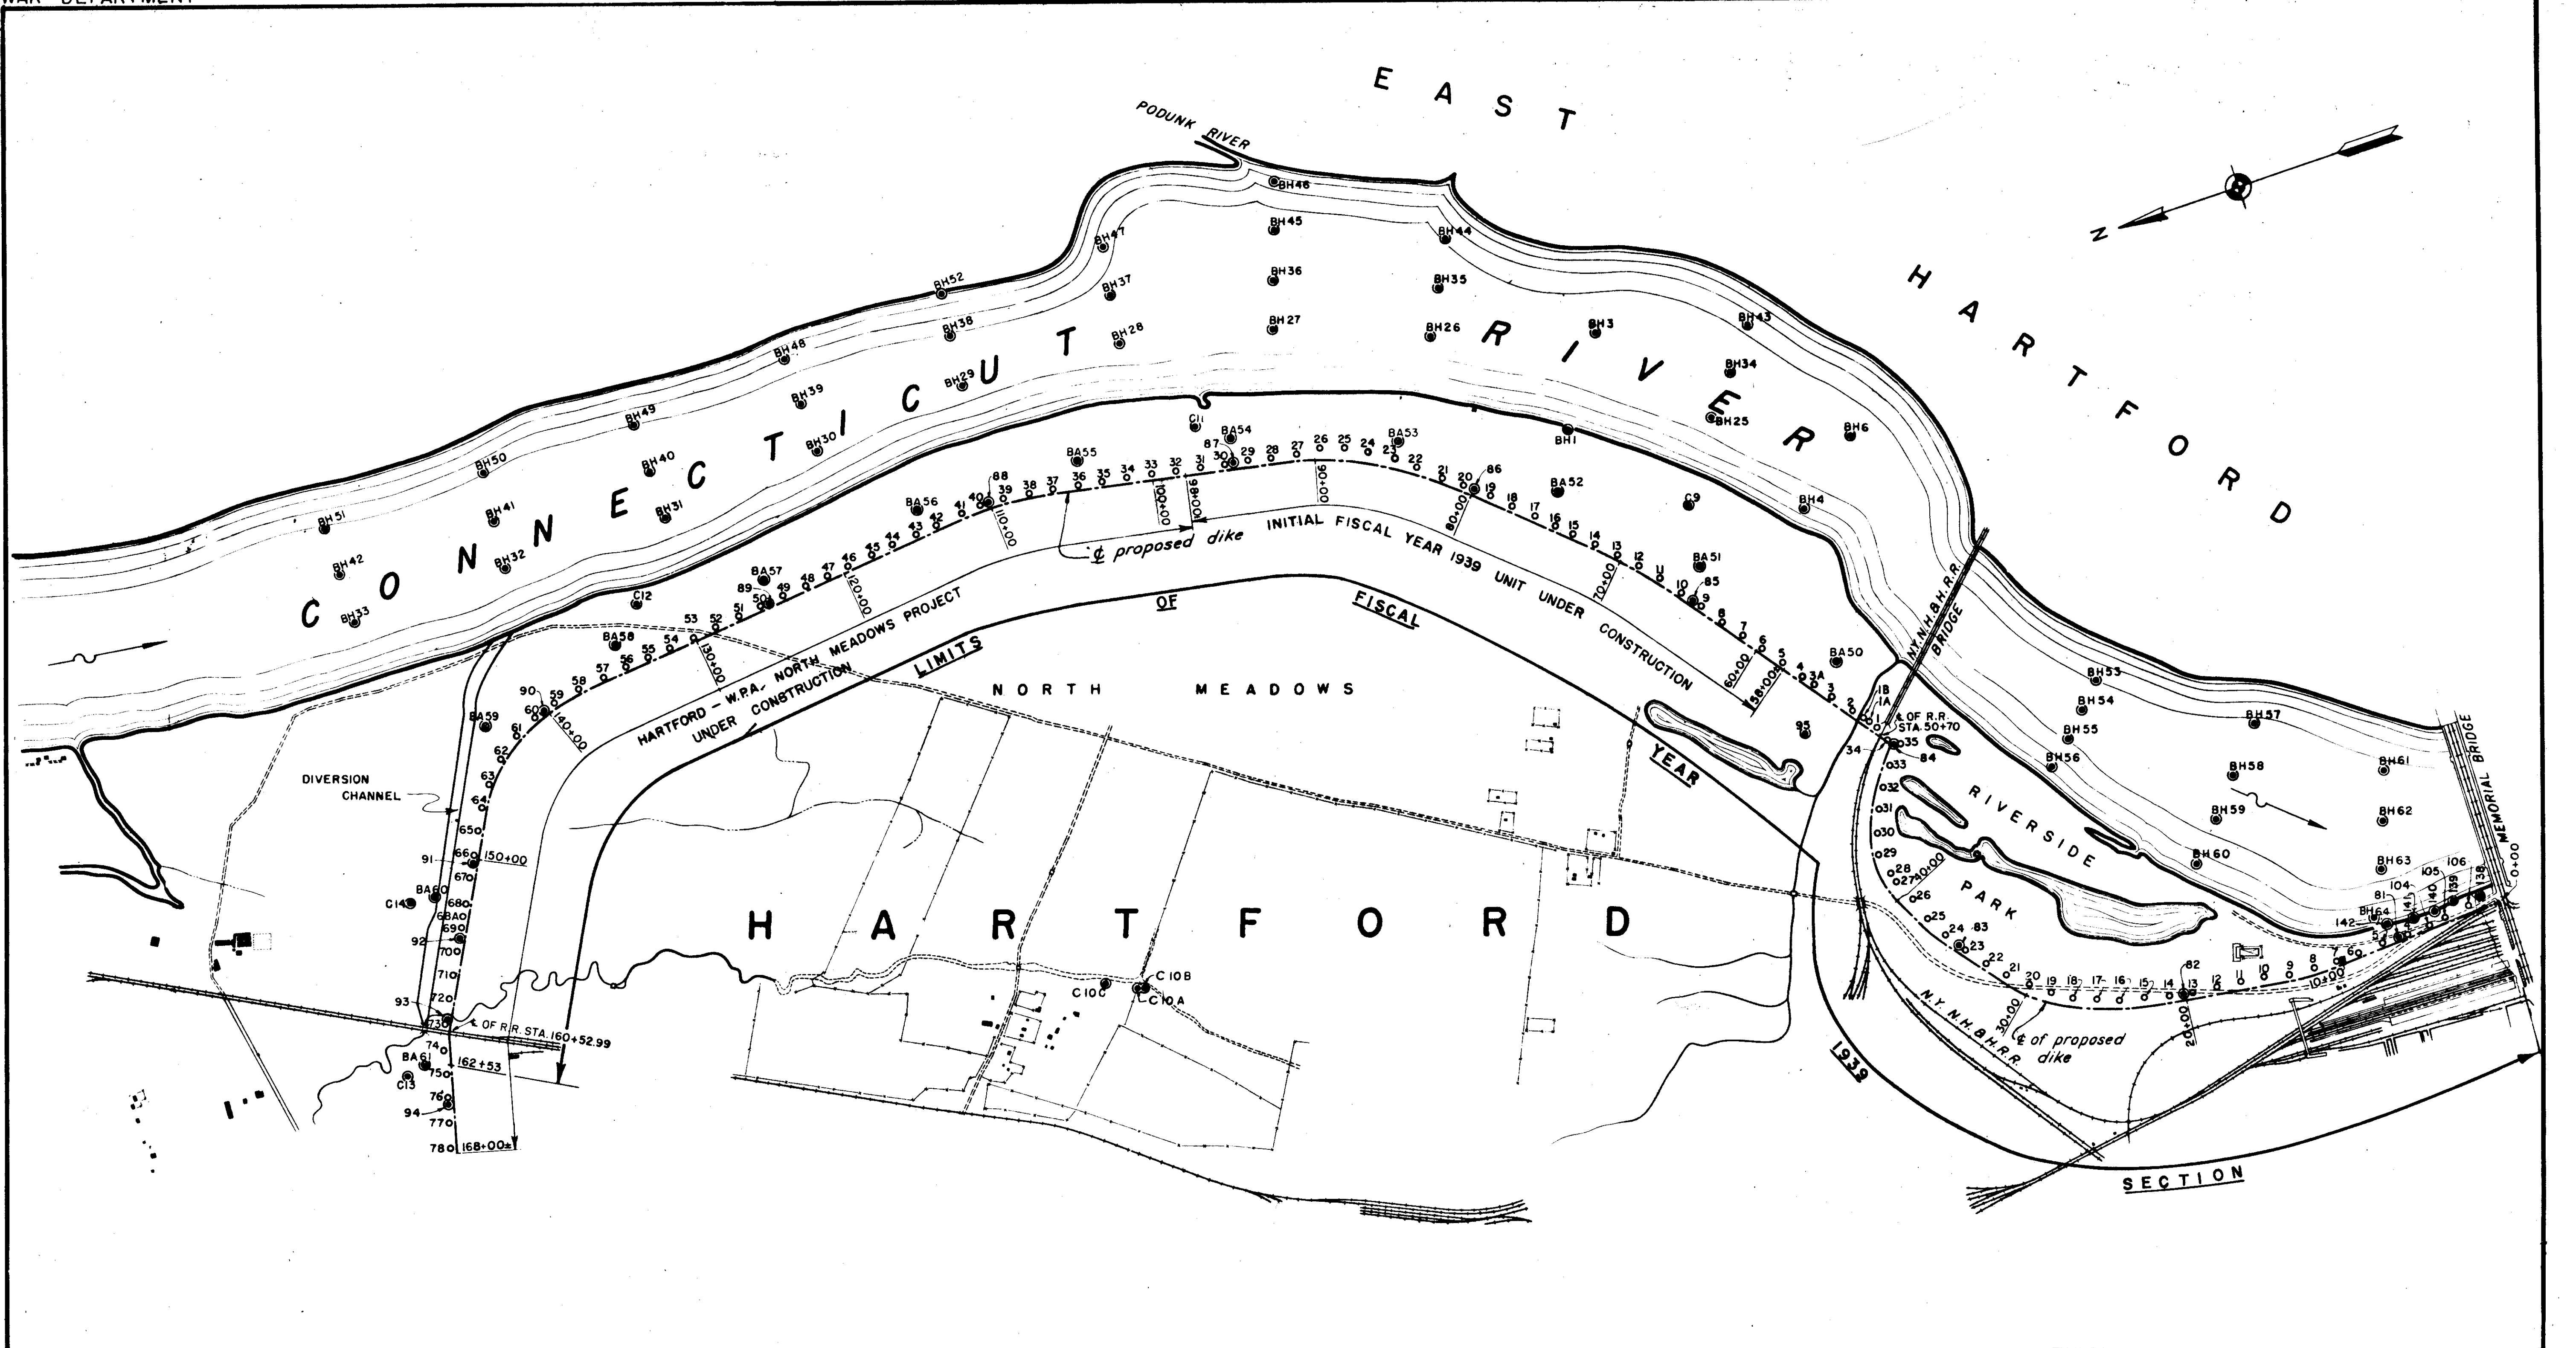

NOTE:
For records of U.S.E.D. core borings (except BH 138 thru BH 142) and auger borings see Sheet No. 5.
For records of Hartford borings in Riverside Park (Sta. 0+0 to Sta. 50+70) see Sheet No. 6.
For records of Hartford borings between Sta. 50+70 and Sta. 102+00 see Sheet No. 7.
For records of Hartford borings between Sta. 102+00 and Sta. 168+00 see Sheet No. 8.
For records of U.S.E.D. core borings BH 138 thru BH 142 see Sheet No. 9.

- LEGEND**
- Core Borings by City of Hartford.
(Records on Sheets No. 6, 7 & 8.)
 - Core Borings by U.S.E.D.
(Records on Sheets No. 5 and 9.)
 - Auger Borings by U.S.E.D.
(Records on Sheet No. 5.)

12/31/45	As-Built				
DATE	REVISION	REV. BY	CK. BY	AP. BY	

CONNECTICUT RIVER FLOOD CONTROL		
NORTH MEADOWS DIKE		
FISCAL YEAR 1939 SECTION		
SUBSURFACE EXPLORATIONS		
HARTFORD, CONN.		
CONNECTICUT RIVER	CONNECTICUT	
IN 66 SHEETS	SCALE: 1 IN. = 500 FT.	SHEET NO. 4
U. S. ENGINEER OFFICE, PROVIDENCE, R. I., APRIL 1939		
SUBMITTED:	APPROVED:	APPROVED:
SENIOR GEOLOGIST	PRINCIPAL ENGINEER	CHIEF OF ENGINEERS
HEAD, GEOLOGY SECTION	CHIEF, F.C. ENGINEERING DIV.	DISTRICT ENGINEER
COMPILED:	DRAWN BY:	FILE NO. GT-2-1140
ASST. ENGINEER	TRACED BY: G.S.P. - I.S.W.	CHECKED BY: P.A.