


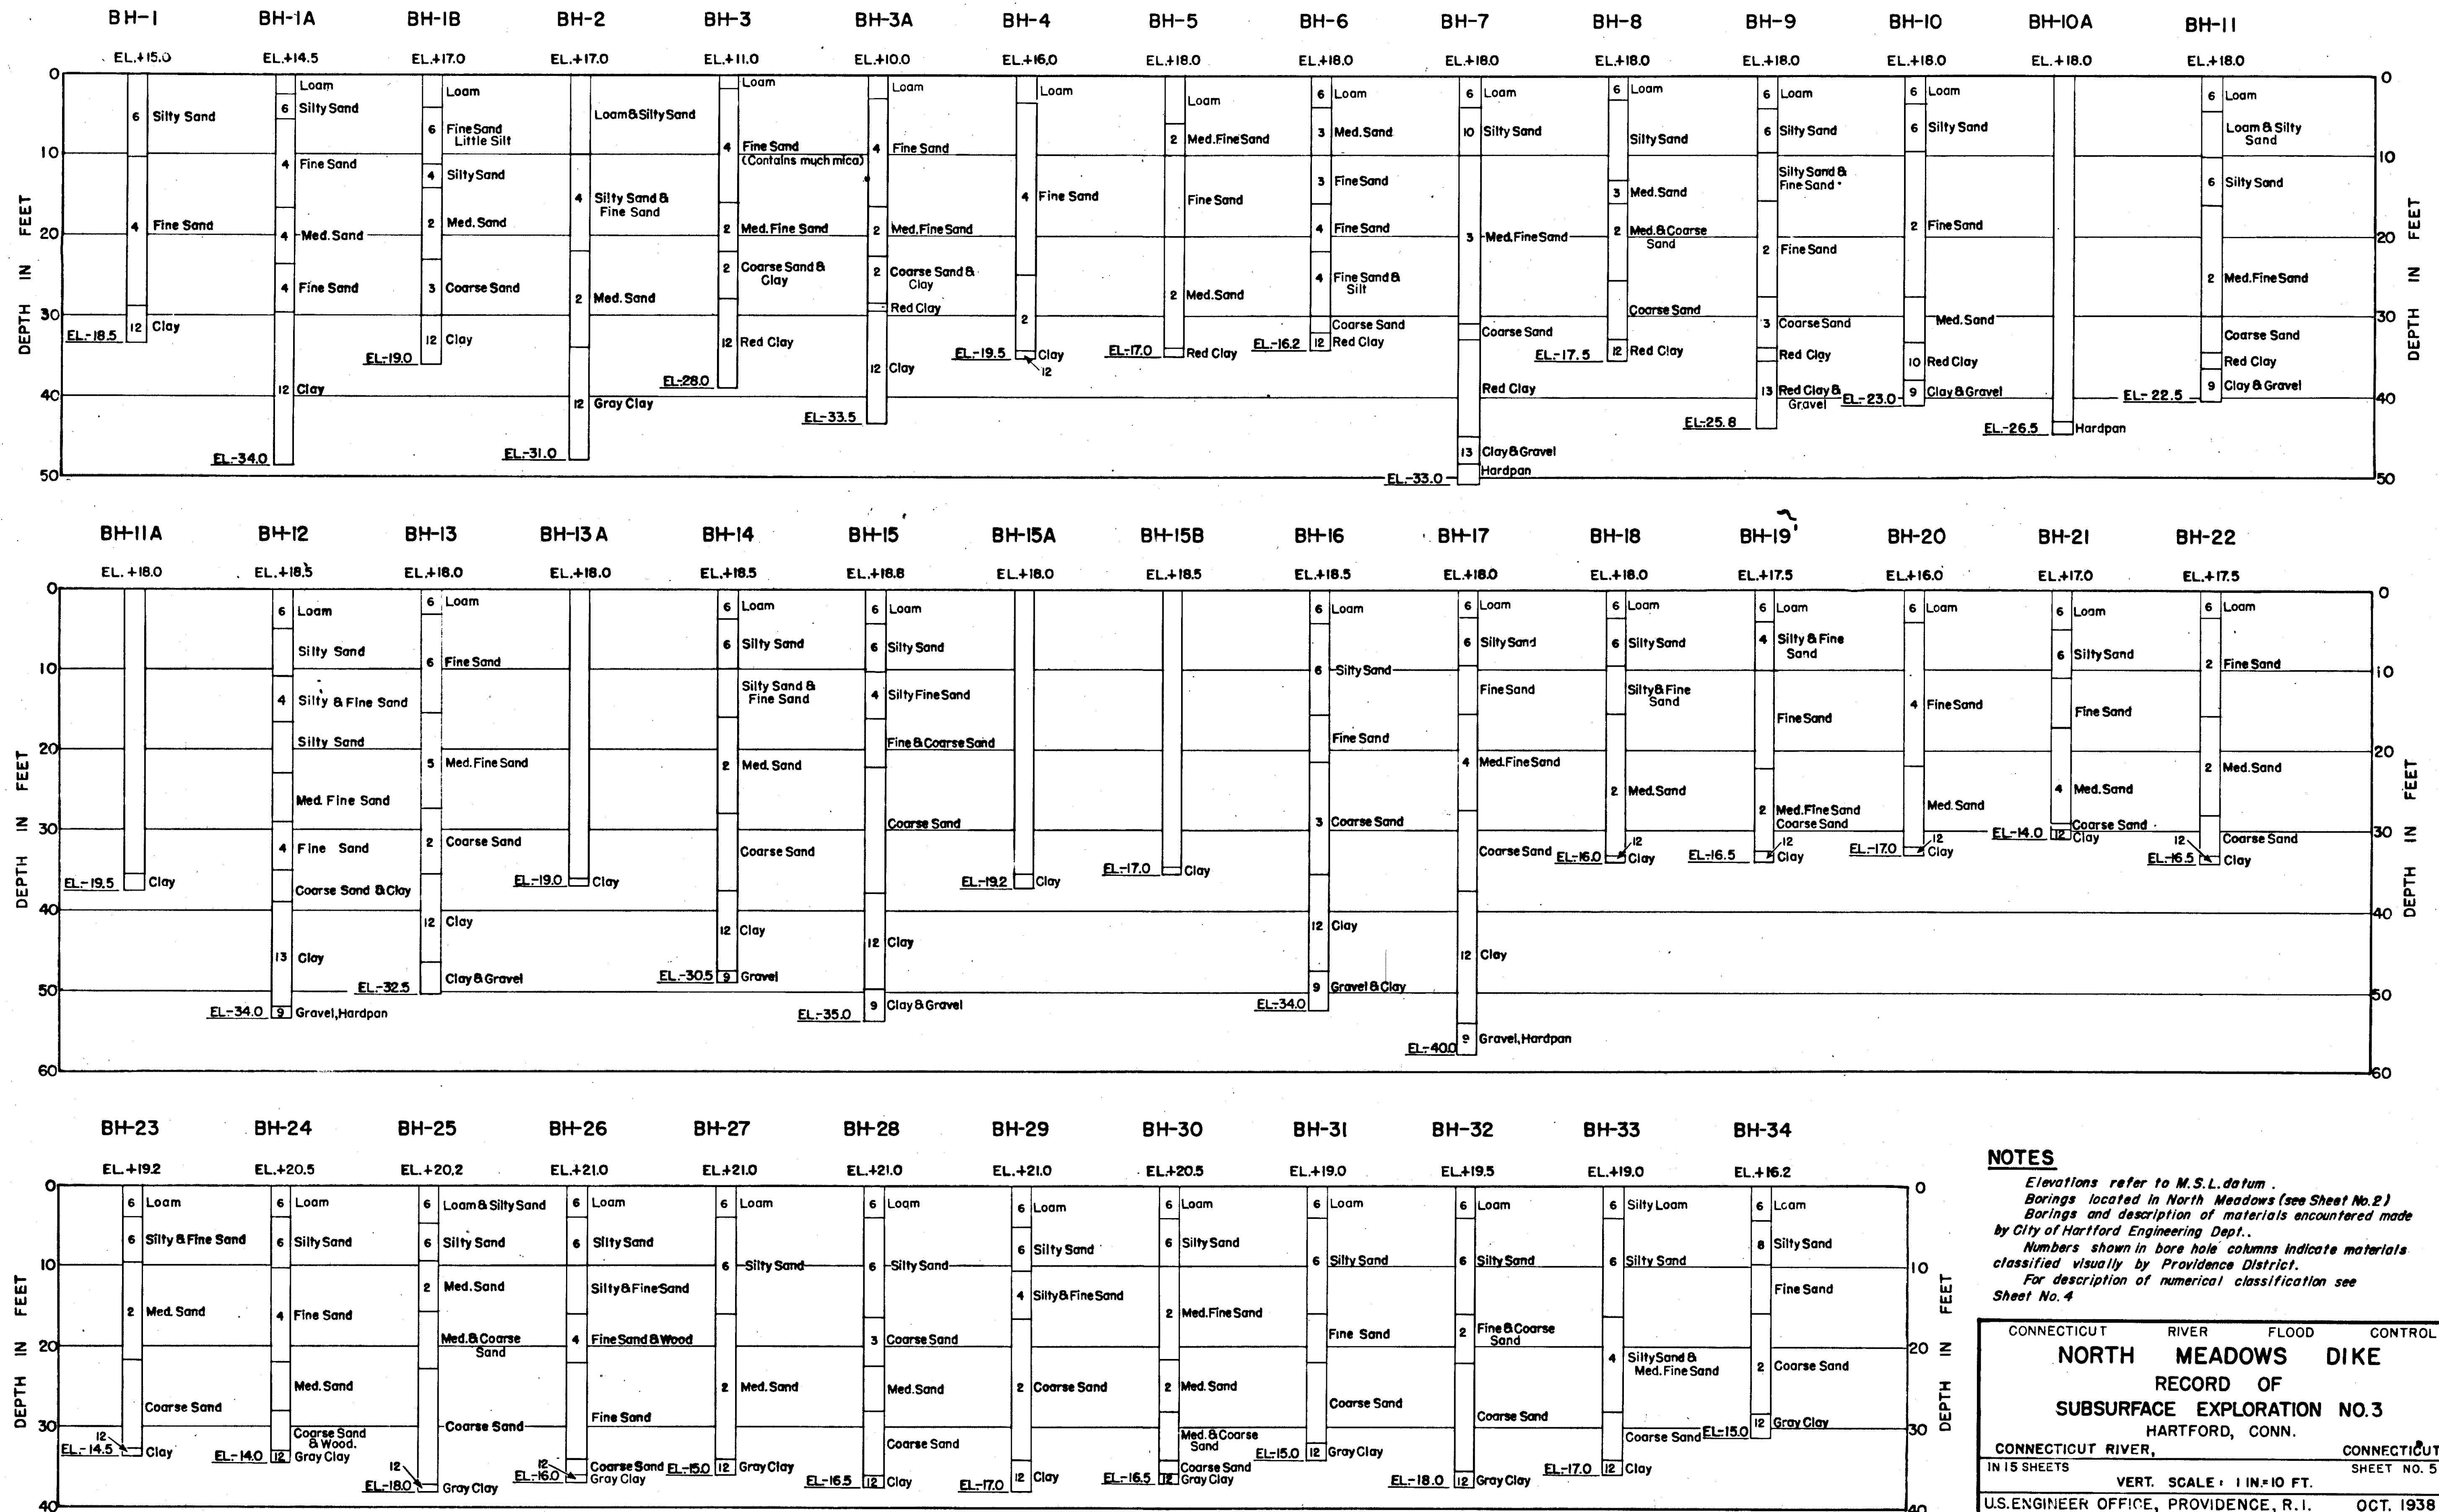

NOTES

Elevations refer to M.S.L. datum.
Borings located in North Meadows (see Sheet No. 2)
Borings and description of materials encountered made
by City of Hartford Engineering Dept.
Numbers shown in bore hole columns indicate materials
classified visually by Providence District.
For description of numerical classification see
Sheet No. 4

CONNECTICUT RIVER FLOOD CONTROL	
NORTH MEADOWS DIKE	
RECORD OF	
SUBSURFACE EXPLORATION NO. 3	
HARTFORD, CONN.	
CONNECTICUT RIVER, CONNECTICUT.	
IN 15 SHEETS	SHEET NO. 5
VERT. SCALE: 1 IN. = 10 FT.	
U.S. ENGINEER OFFICE, PROVIDENCE, R.I. OCT. 1938	
SUBMITTED J. D. Burns PRINCIPAL ENGINEER	APPROVED R. E. Hink CAPT. CORPS OF ENGINEERS CHIEF, FLOOD CONTROL DIV.
DRAWN BY H. A. Sullivan GEOLOGIST	FILE NO. CT-2-1098 TO ACCOMPANY SPECIFICATIONS DATED OCT. 1, 1938

12-31-45 As Built