



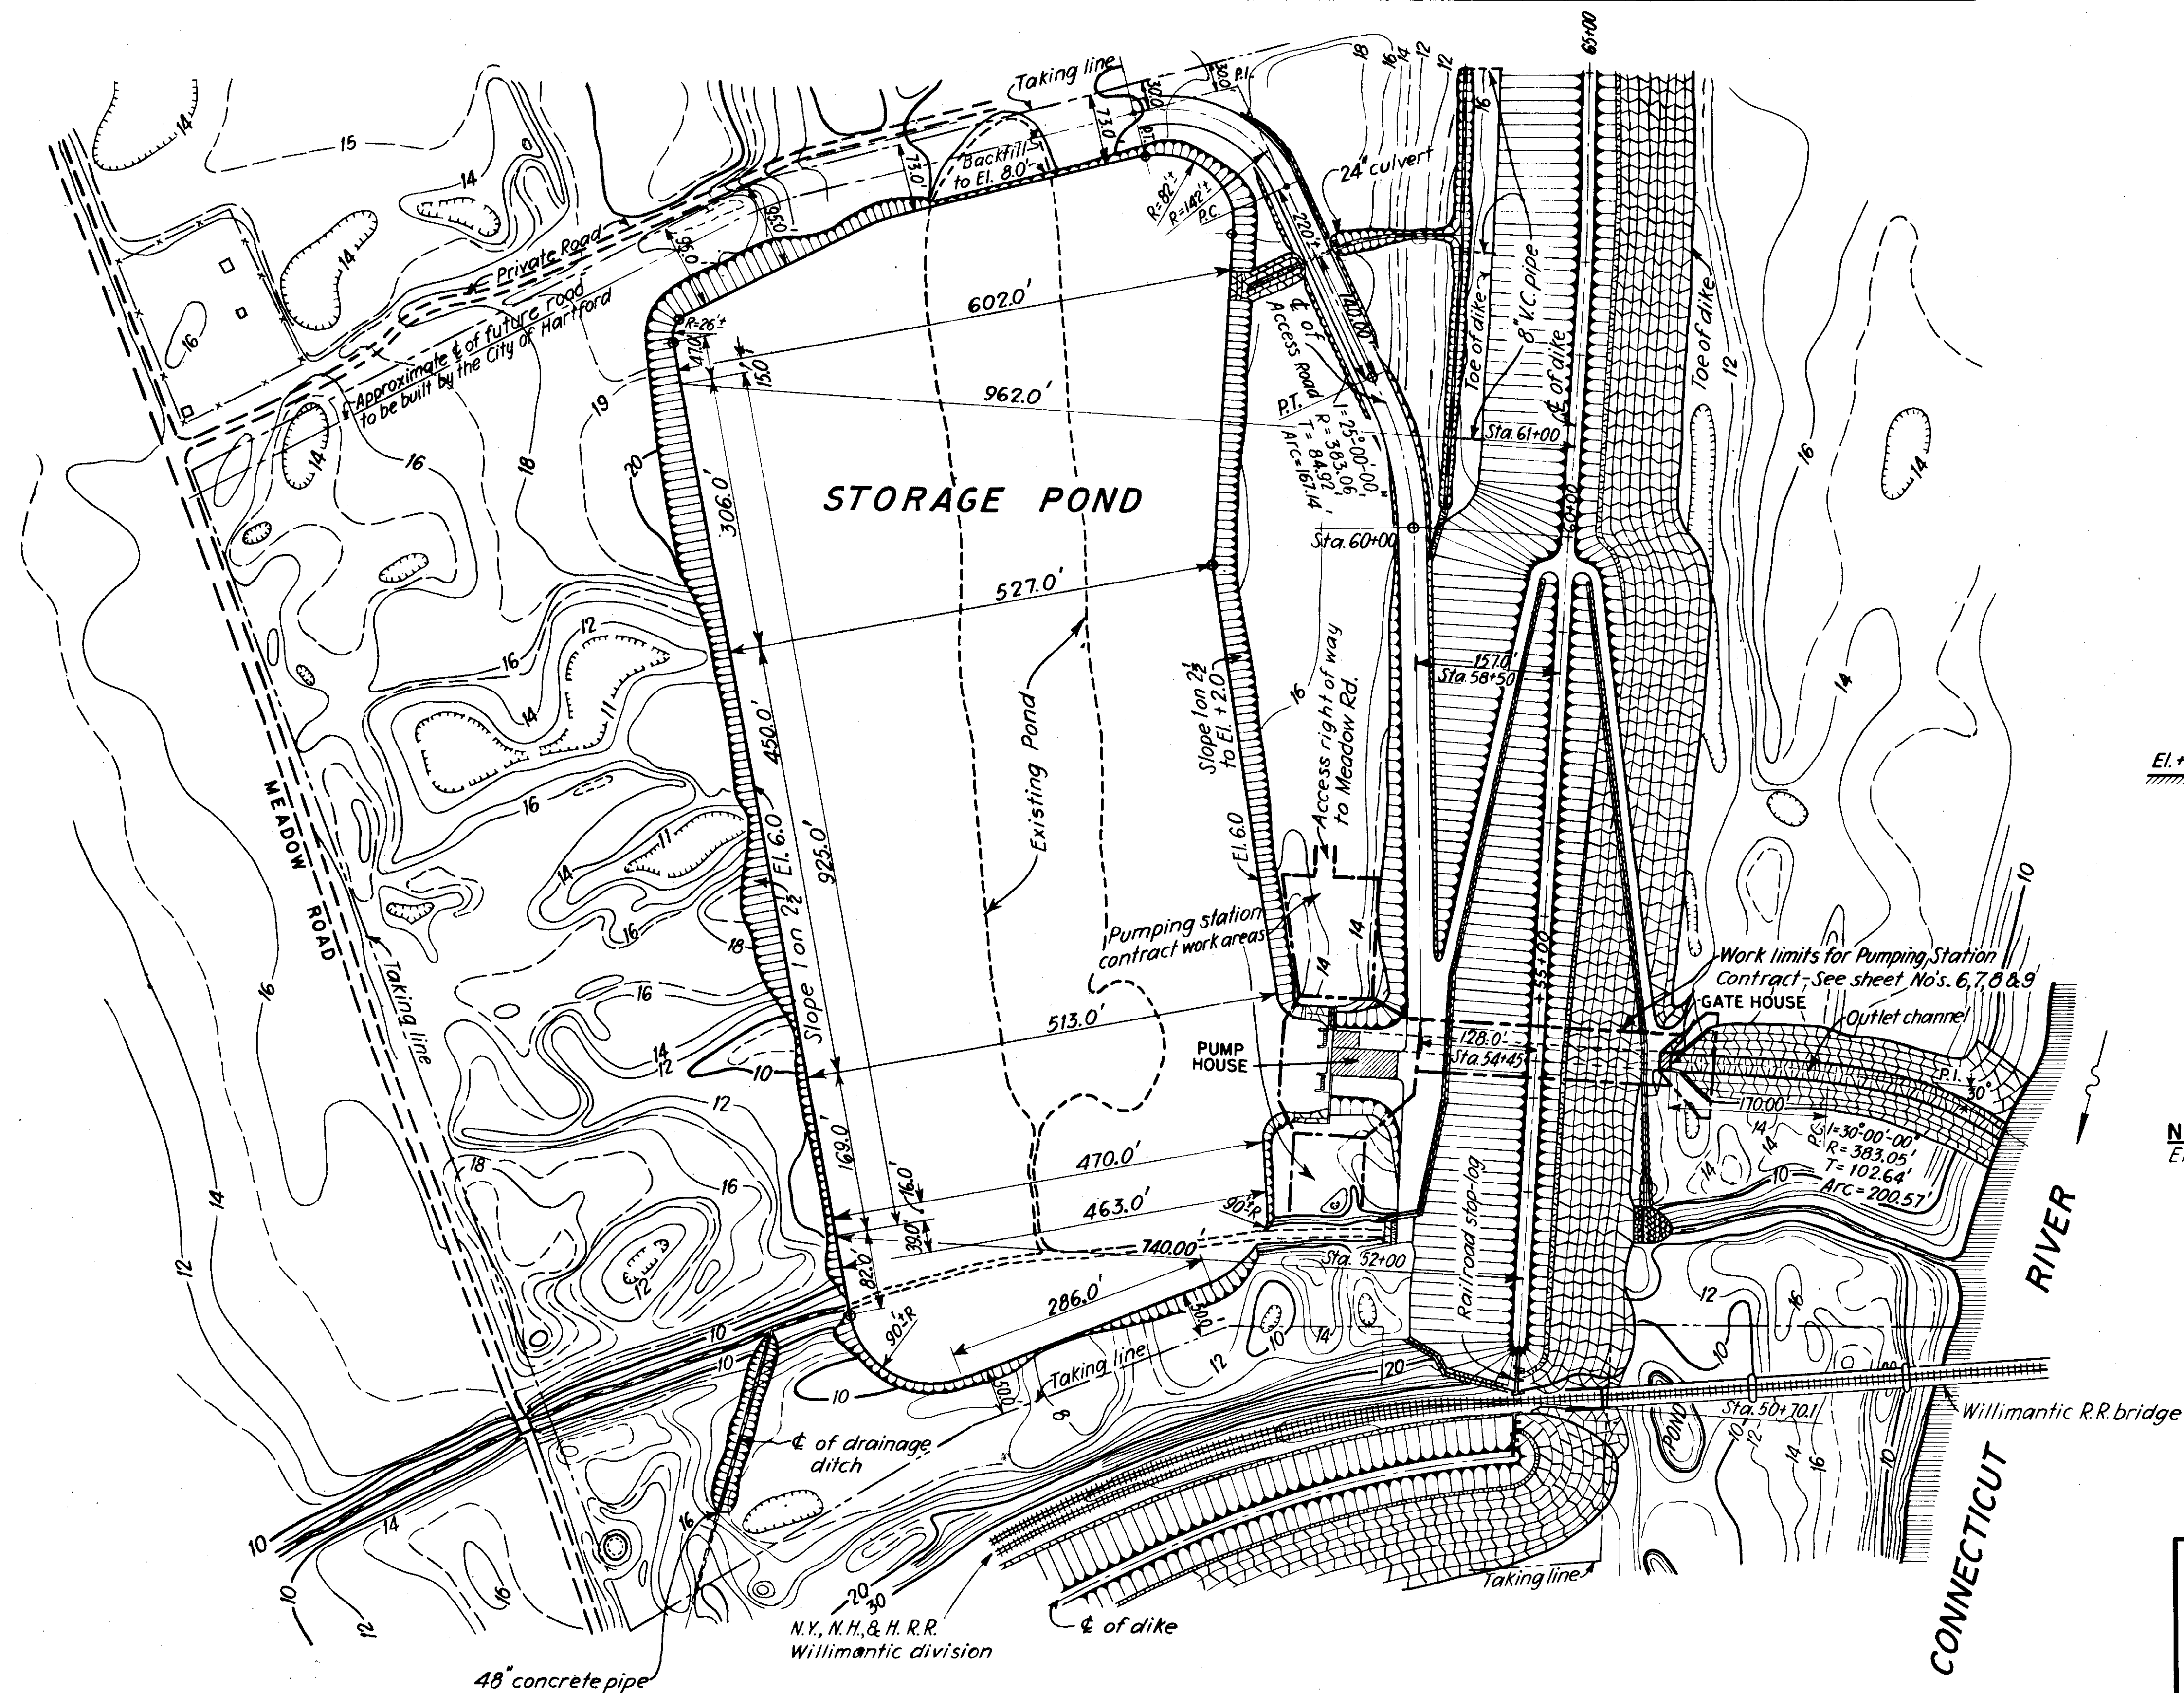

PLAN OF STORAGE POND
SCALE 1"=100'

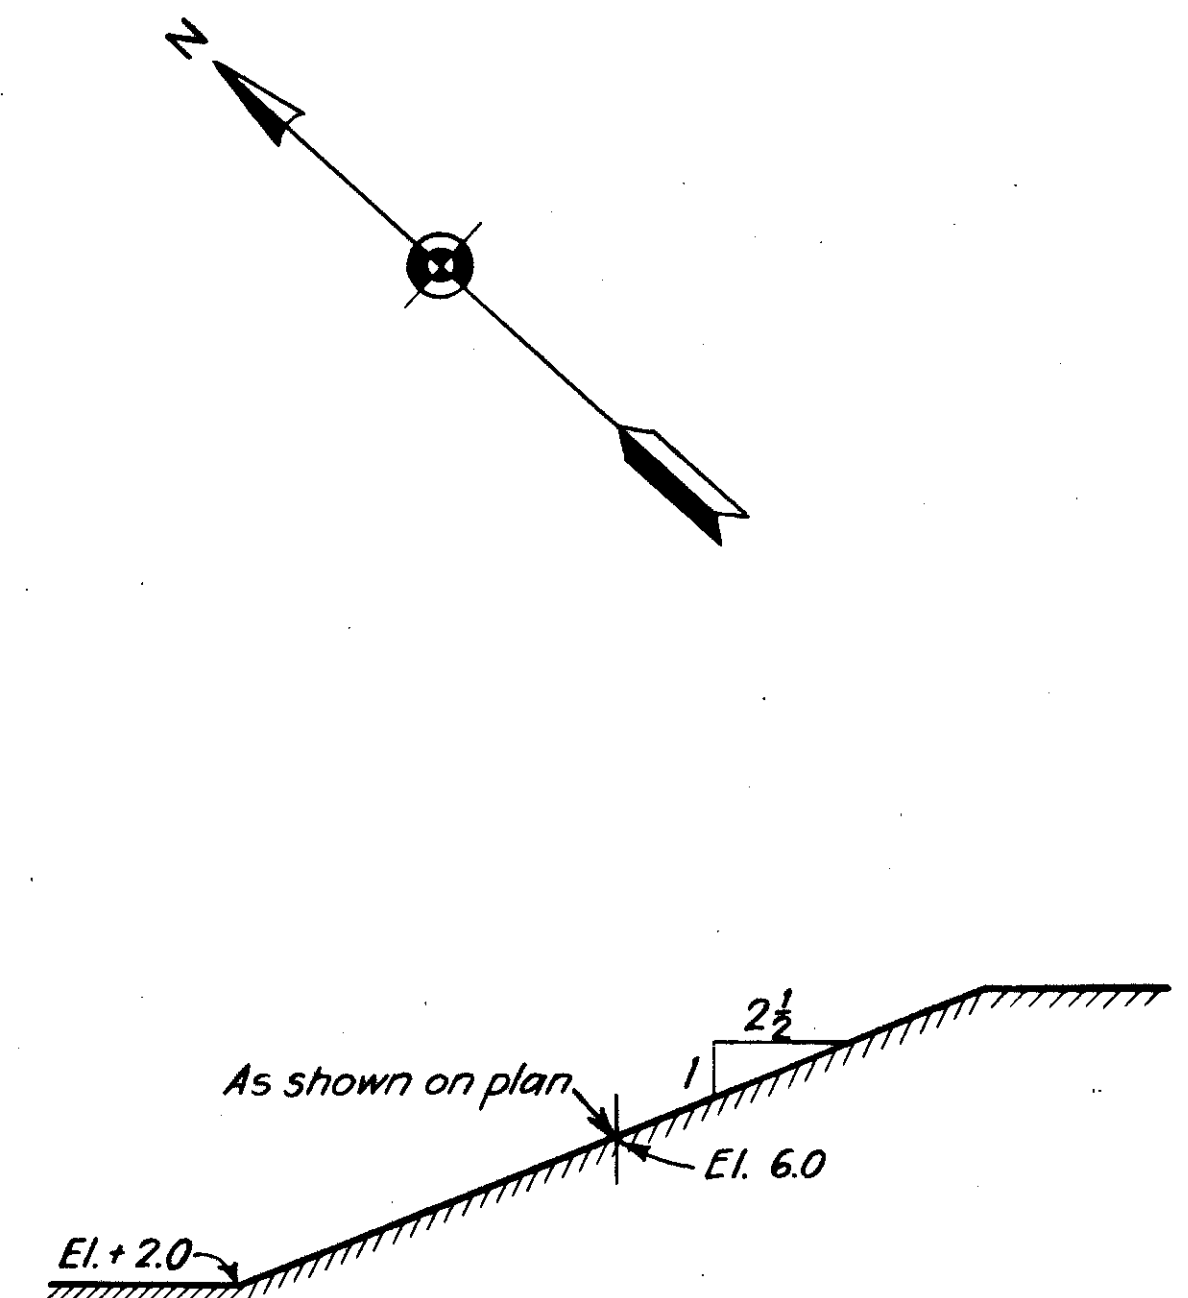

**TYPICAL SLOPE SECTION FOR
POND EXCAVATION**

SCALE 1"=5'-0"
5' 0' 5' 10'

NOTE:
Elevations refer to mean sea level datum

CONNECTICUT RIVER FLOOD CONTROL
NORTH MEADOWS PUMPING STATION
FISCAL YEAR 1939 SECTION
POND LAYOUT
HARTFORD, CONN.

CONNECTICUT RIVER CONNECTICUT
IN 62 SHEETS SCALE: 1"=100 FT. SHEET NO. 5
100' 0' 100' 200'

U. S. ENGINEER OFFICE, PROVIDENCE, R. I., FEB. 1939

SUBMITTED: <i>Wm. B. Nelson</i> SENIOR ENGINEER	APPROVAL RECOMMENDED: <i>J. B. Burns</i> PRINCIPAL ENGINEER	APPROVED: <i>W. B. Nelson</i> DISTRICT ENGINEER
HEAD, DESIGN SECTION	CHIEF, F.C. ENGINEERING DIV.	CHIEF, DISTRICT ENGINEERS
DESIGNED: <i>J. S. Smith</i> ASSOC. ENGINEER	DRAWN BY: P. D. M. TRACED BY: C. J. M. CHECKED BY: W. A. G.	FILE NO. CT-4-1253

DATE	REVISION	REV. BY	AP. BY	CK. BY
12-31-15	As built			