


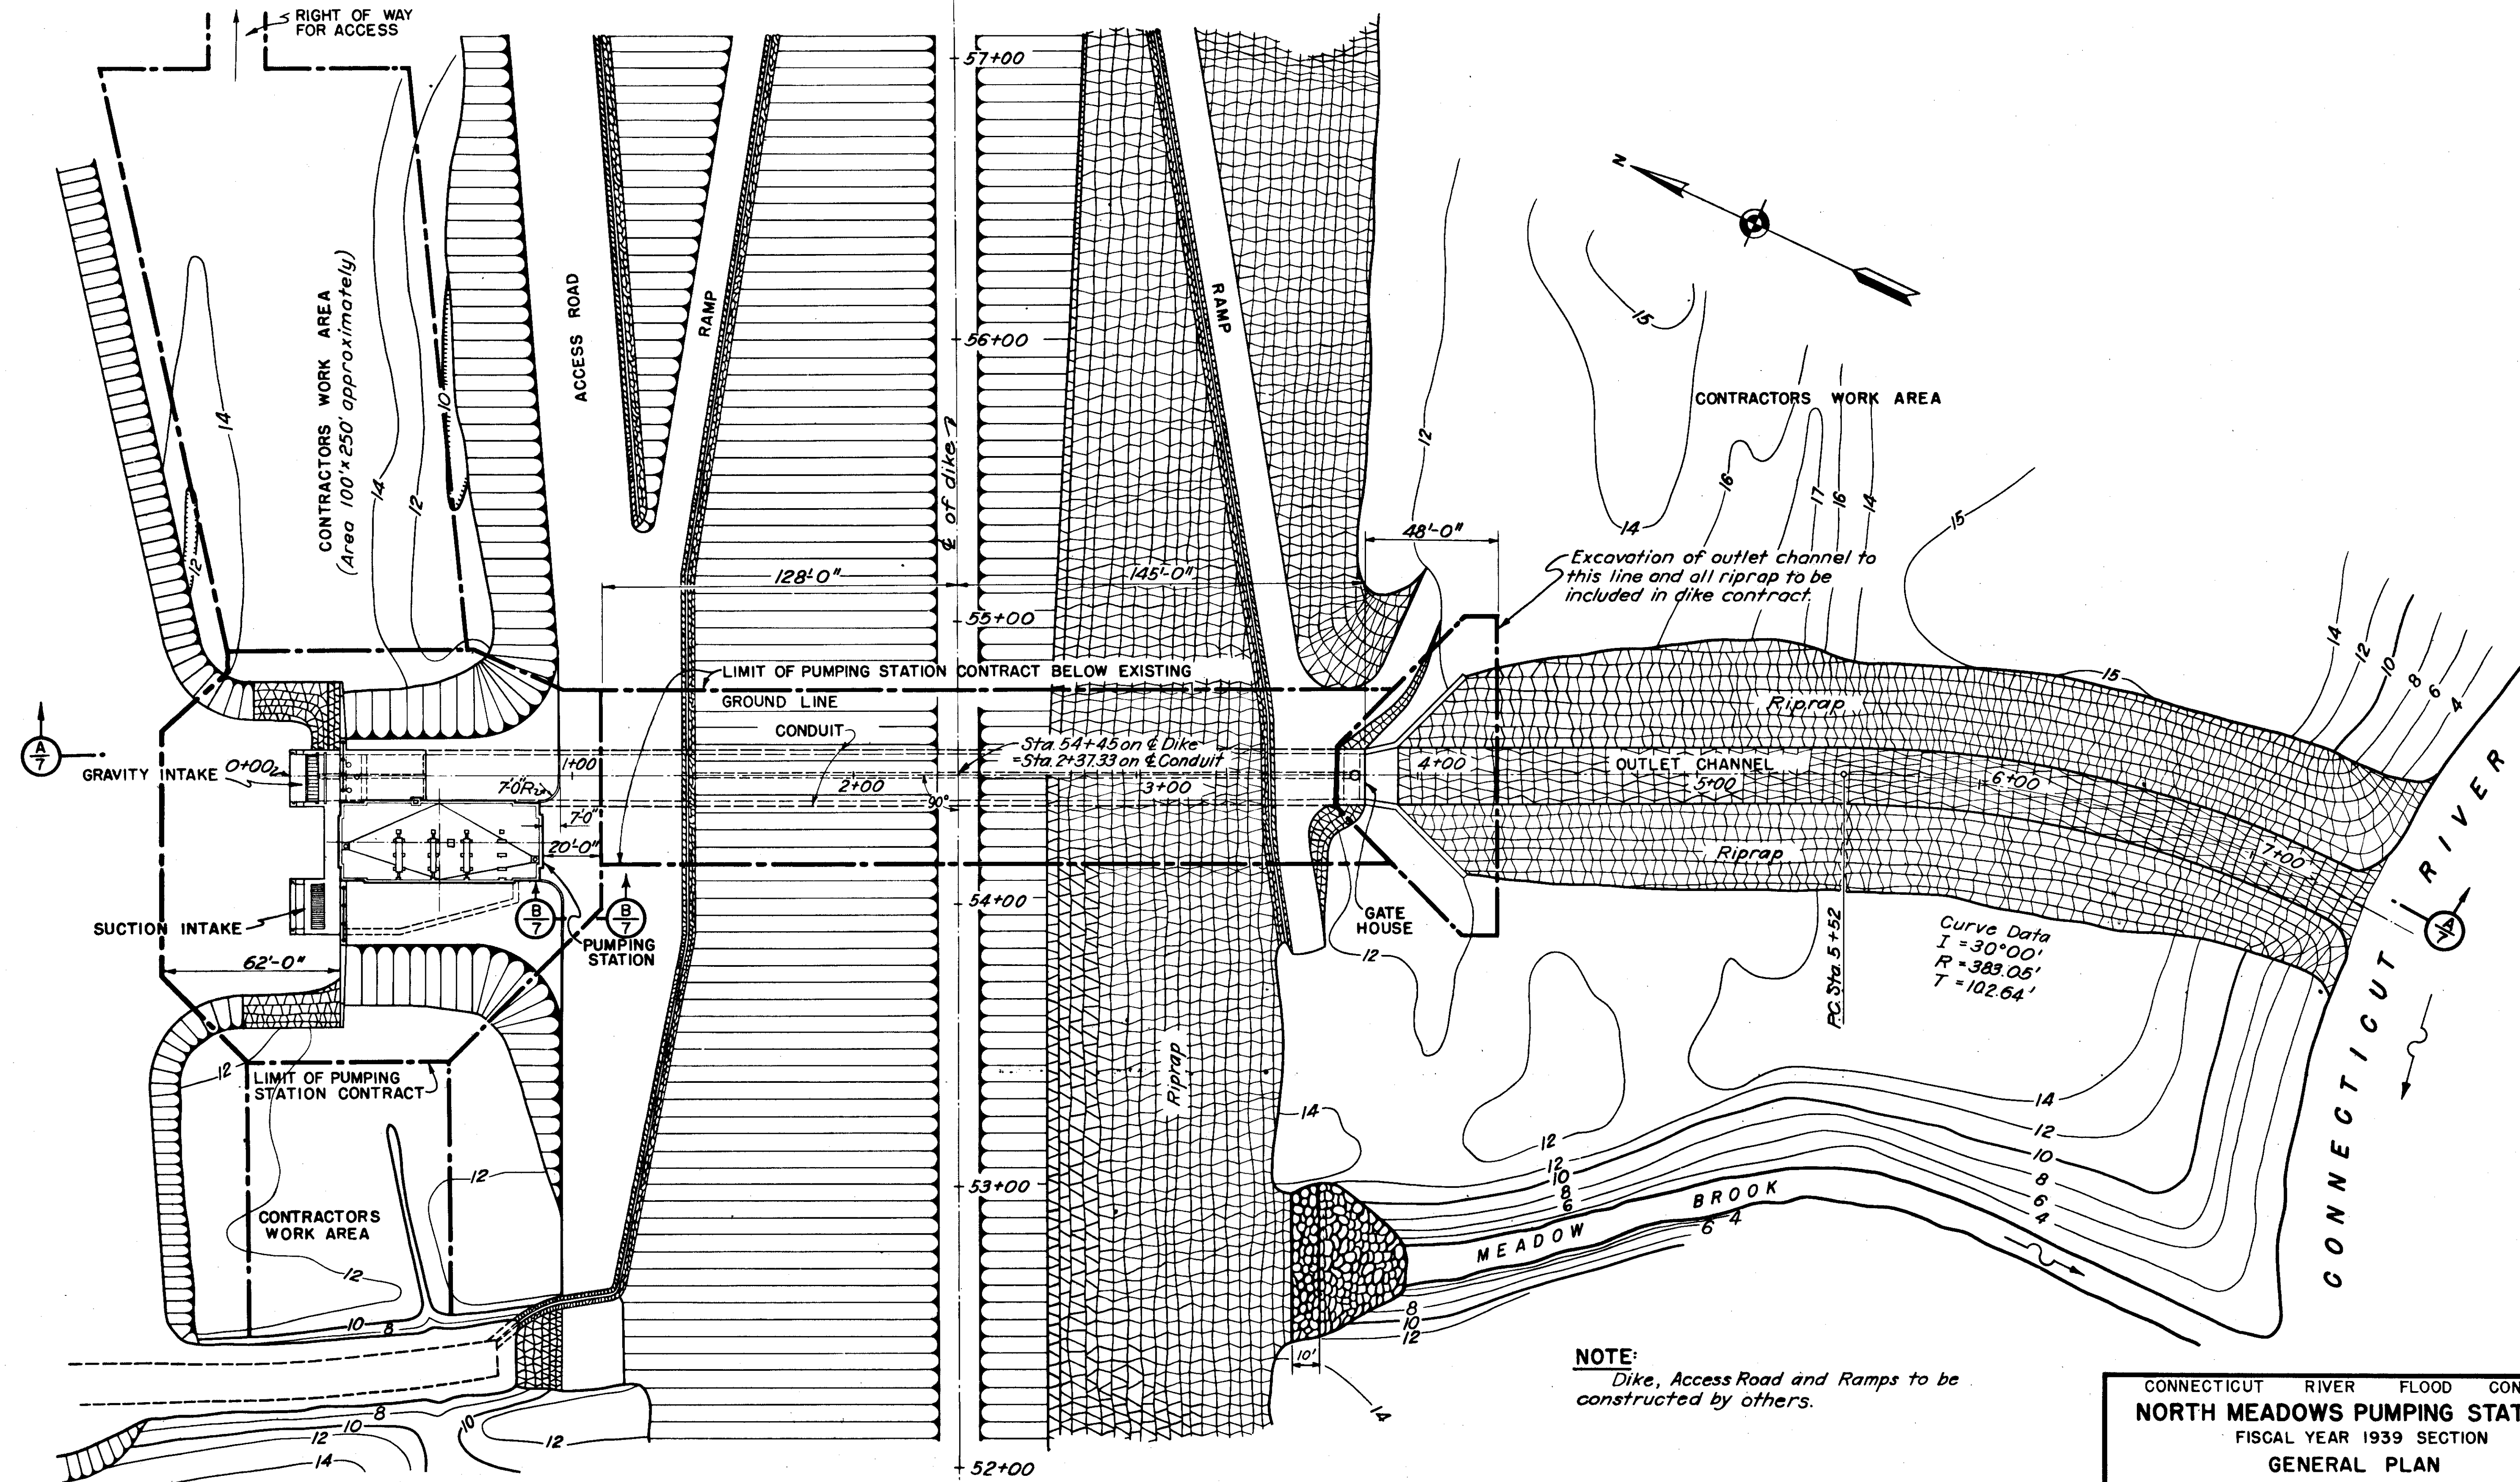

NOTE:
Dike, Access Road and Ramps to be constructed by others.

12-31-15	As built				
DATE	REVISION	REV	BY	CK	BY

CONNECTICUT RIVER FLOOD CONTROL
NORTH MEADOWS PUMPING STATION
FISCAL YEAR 1939 SECTION
GENERAL PLAN
HARTFORD, CONN.

CONNECTICUT RIVER CONNECTICUT
IN 62 SHEETS SCALE 1 IN. = 30 FT. SHEET NO 6

U.S. ENGINEER OFFICE, PROVIDENCE, R.I., FEB. 1939

SUBMITTED: *Amos B. Bishop* APPROVAL: *J. D. Burns* APPROVED: *W. H. Hadden*
SENIOR ENGINEER PRINCIPAL ENGINEER LT. COL. CORPS OF ENGINEERS
HEAD, DESIGN SECTION CHIEF, F.C. ENGINEERING DIV. DISTRICT ENGINEER

DESIGNED: *J. Hartley* DRAWN BY: M.B.M.C. FILE NO. CT-4-1254
ASSOC. ENGINEER CHECKED BY: M.A.A.