
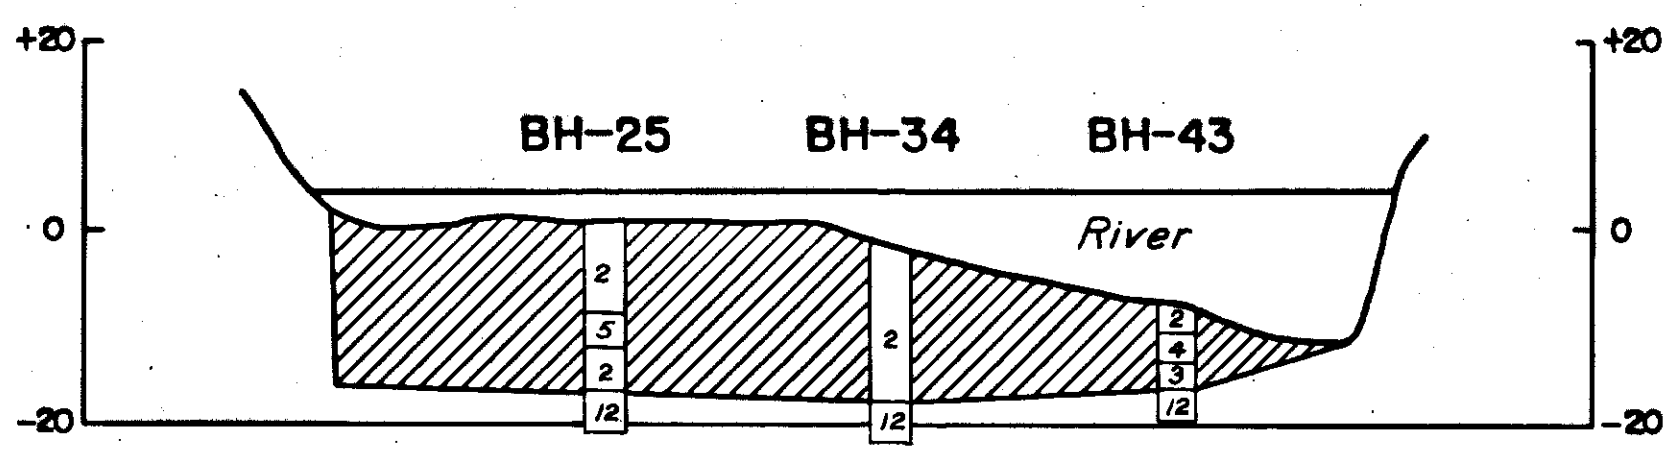
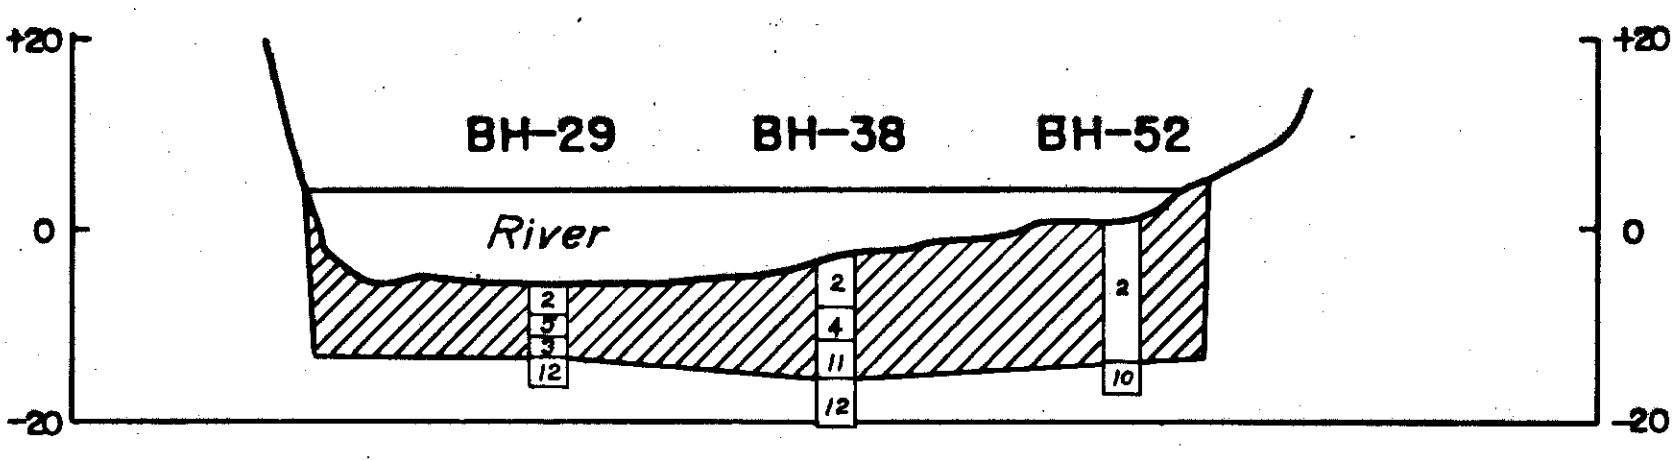
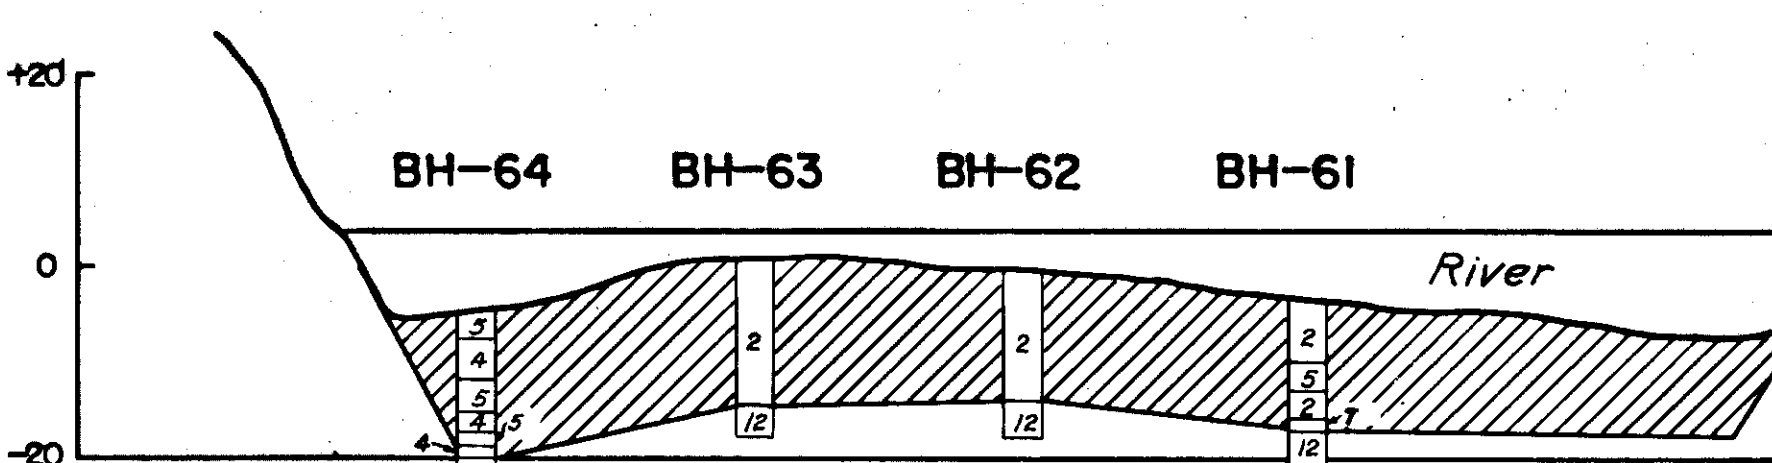
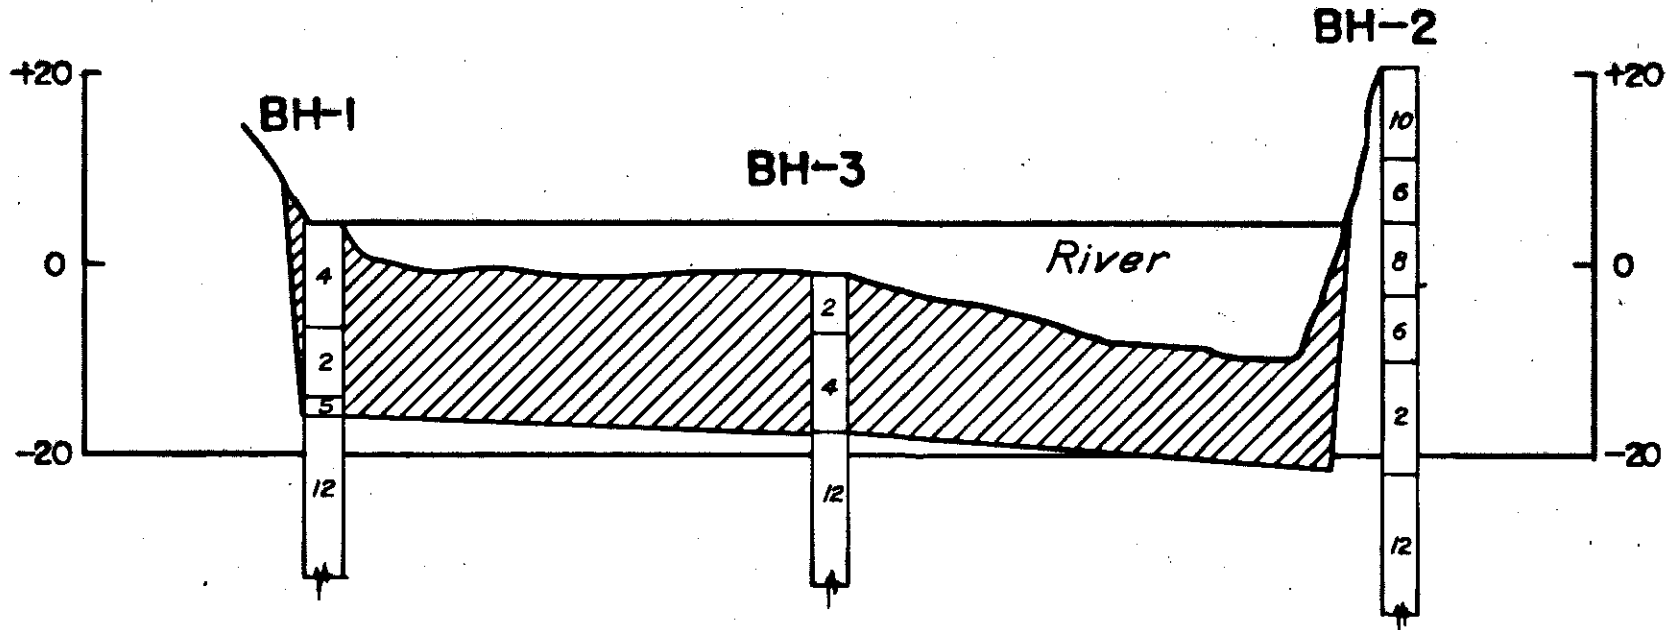
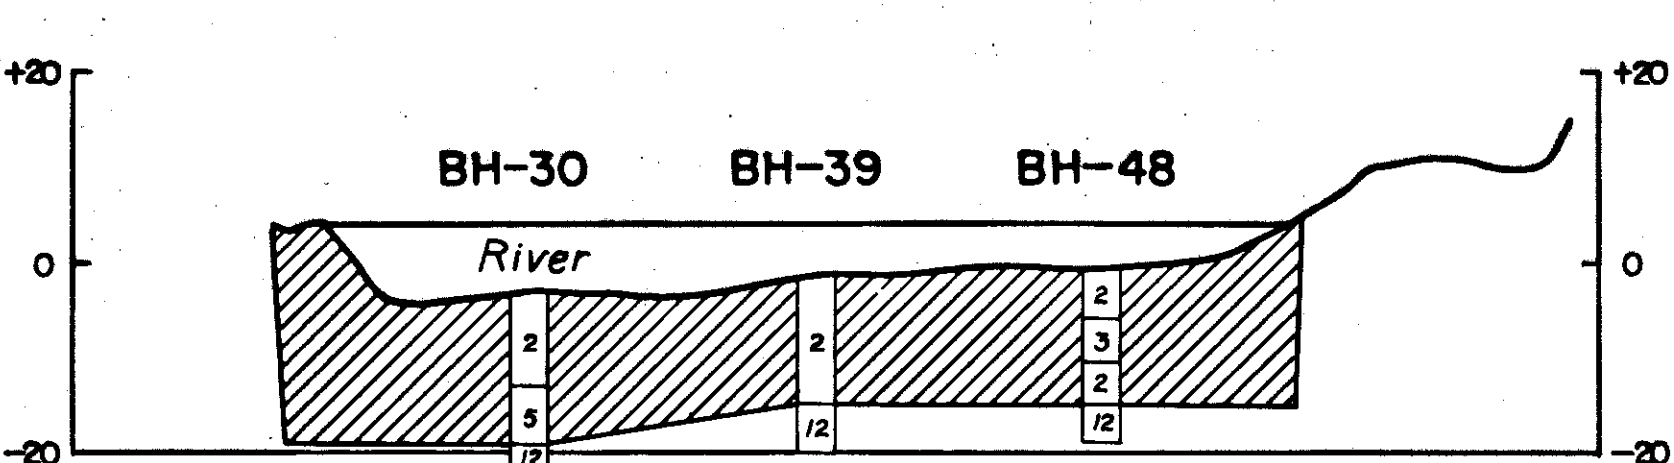
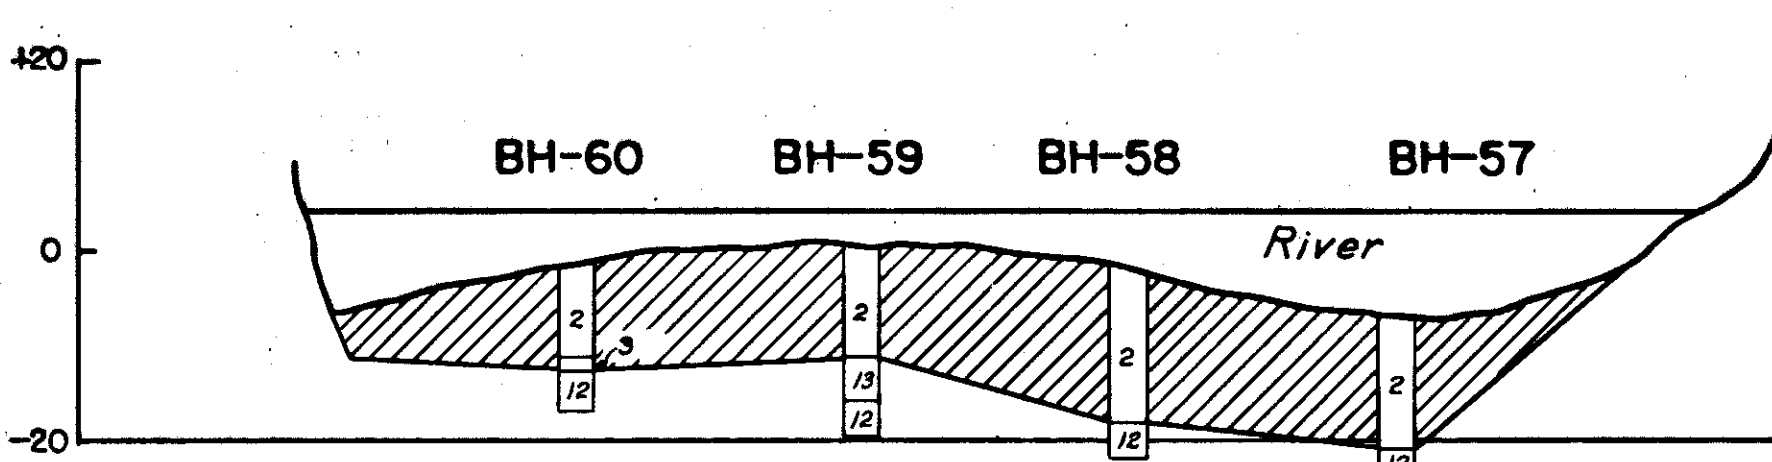
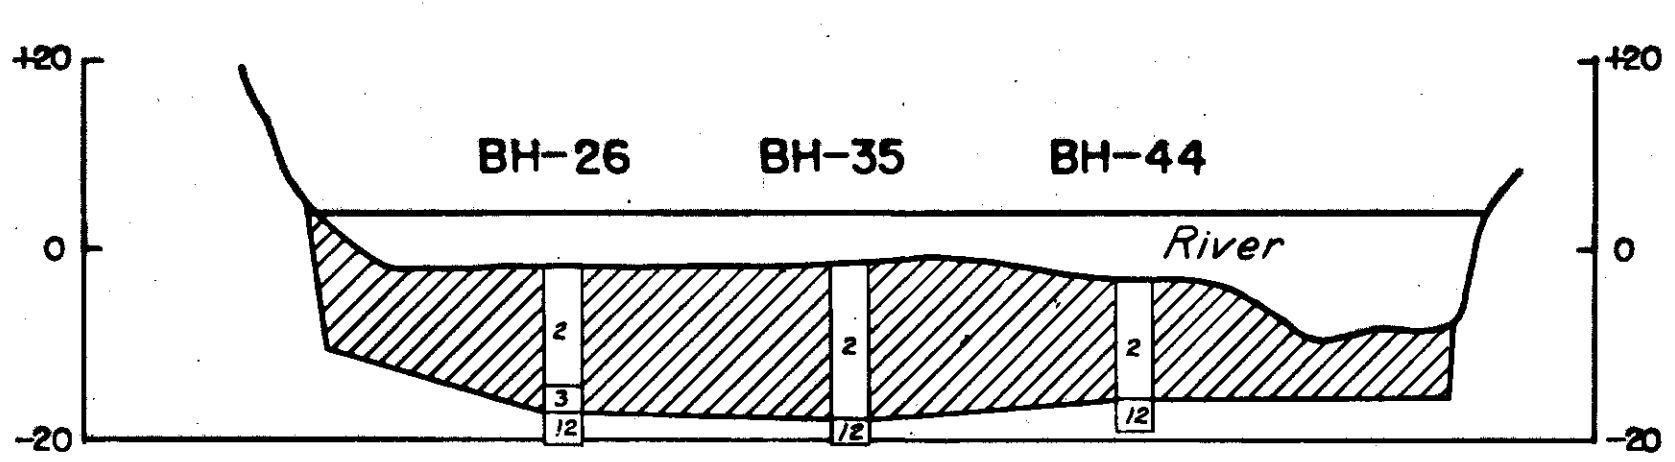
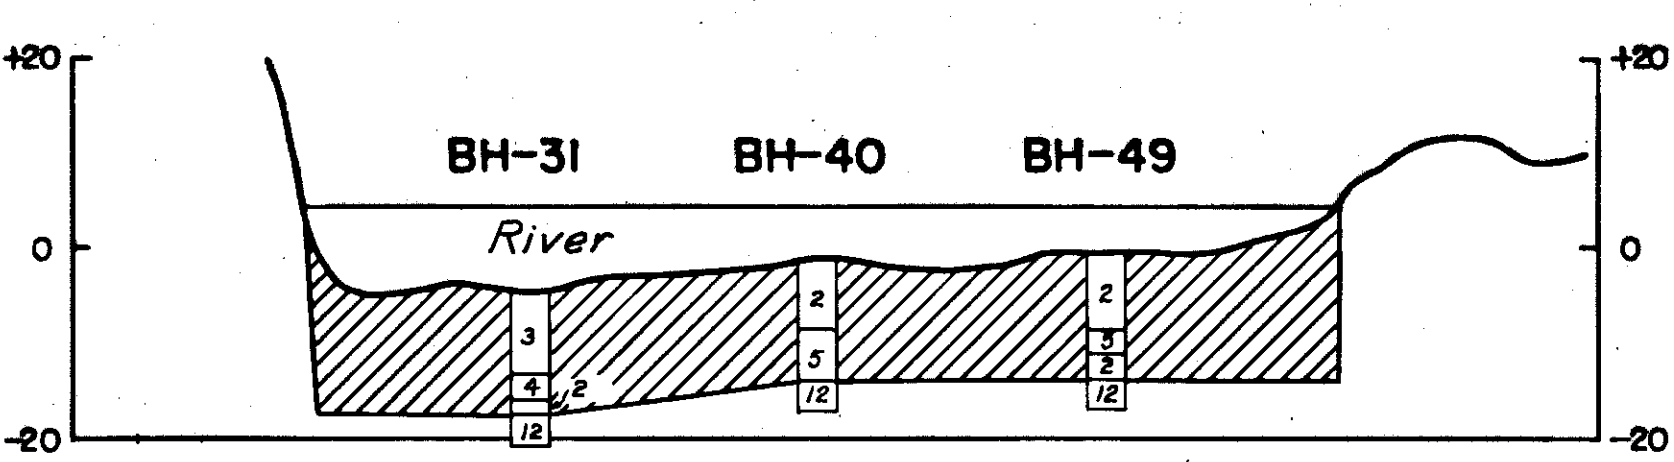
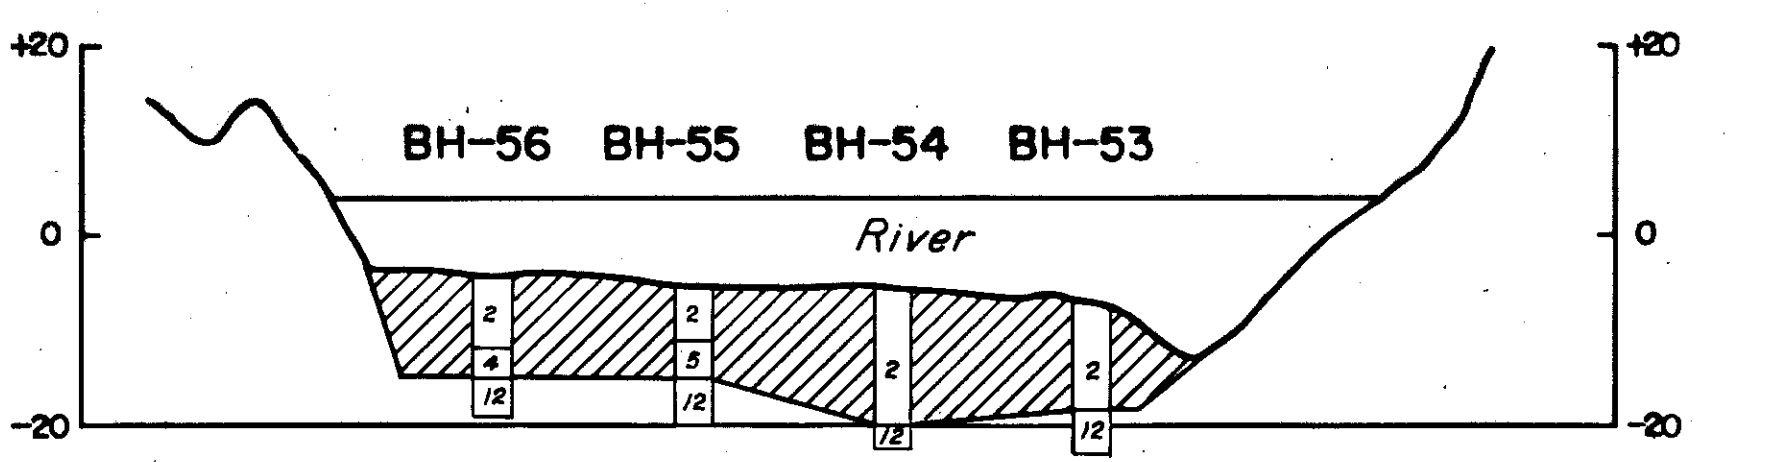
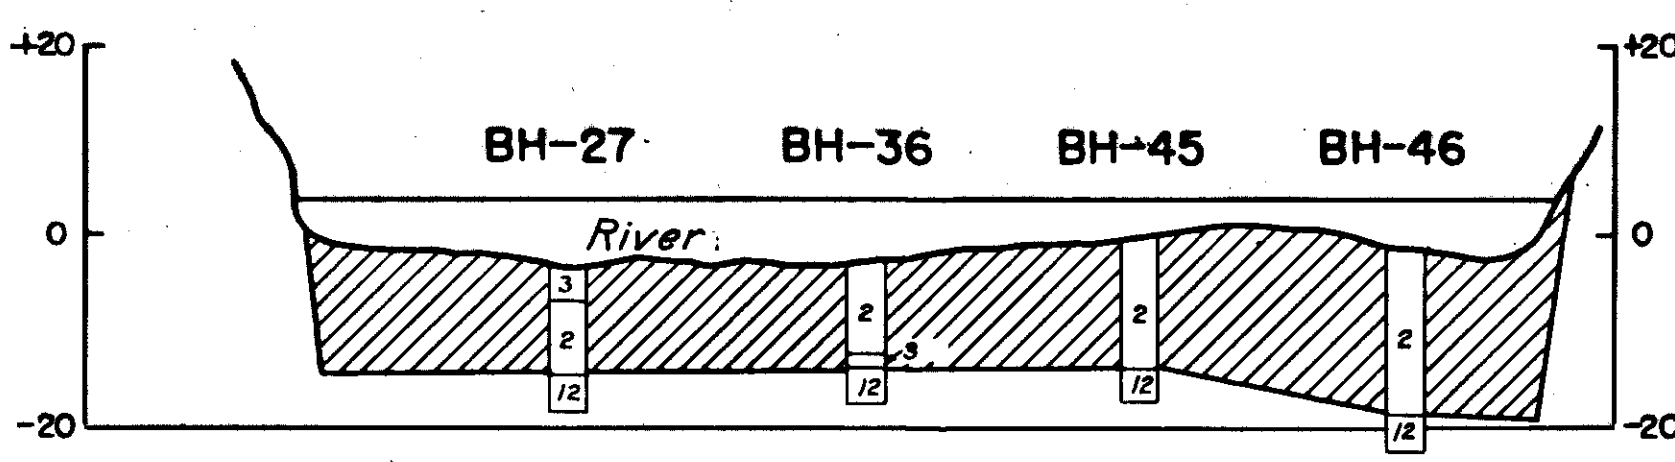
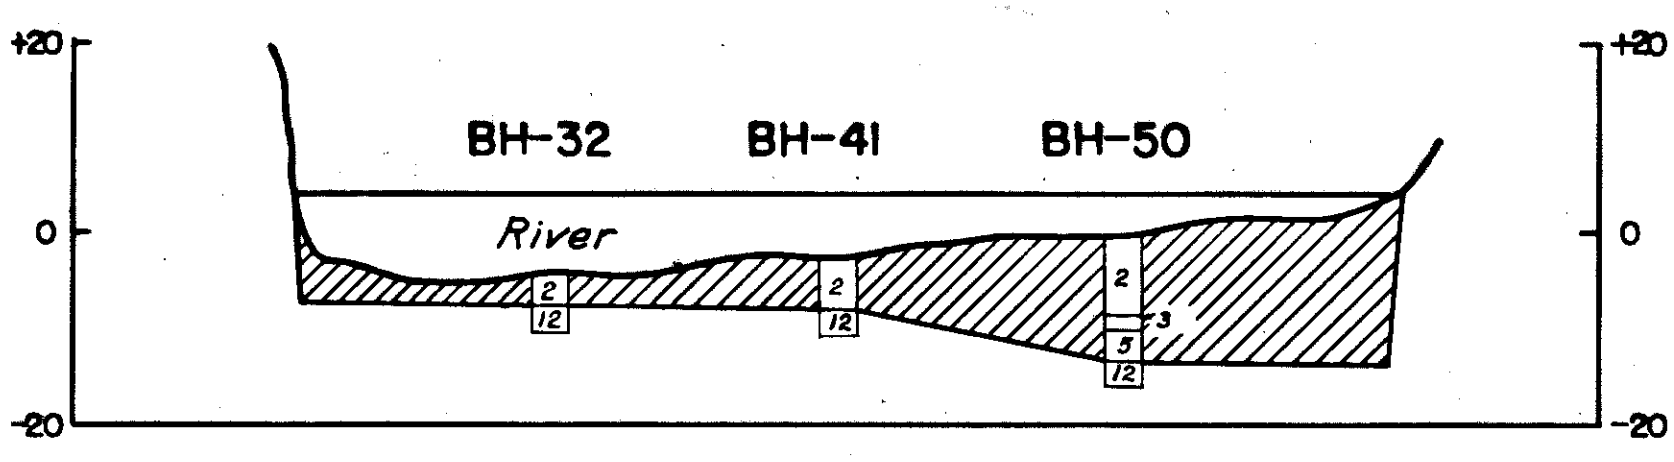
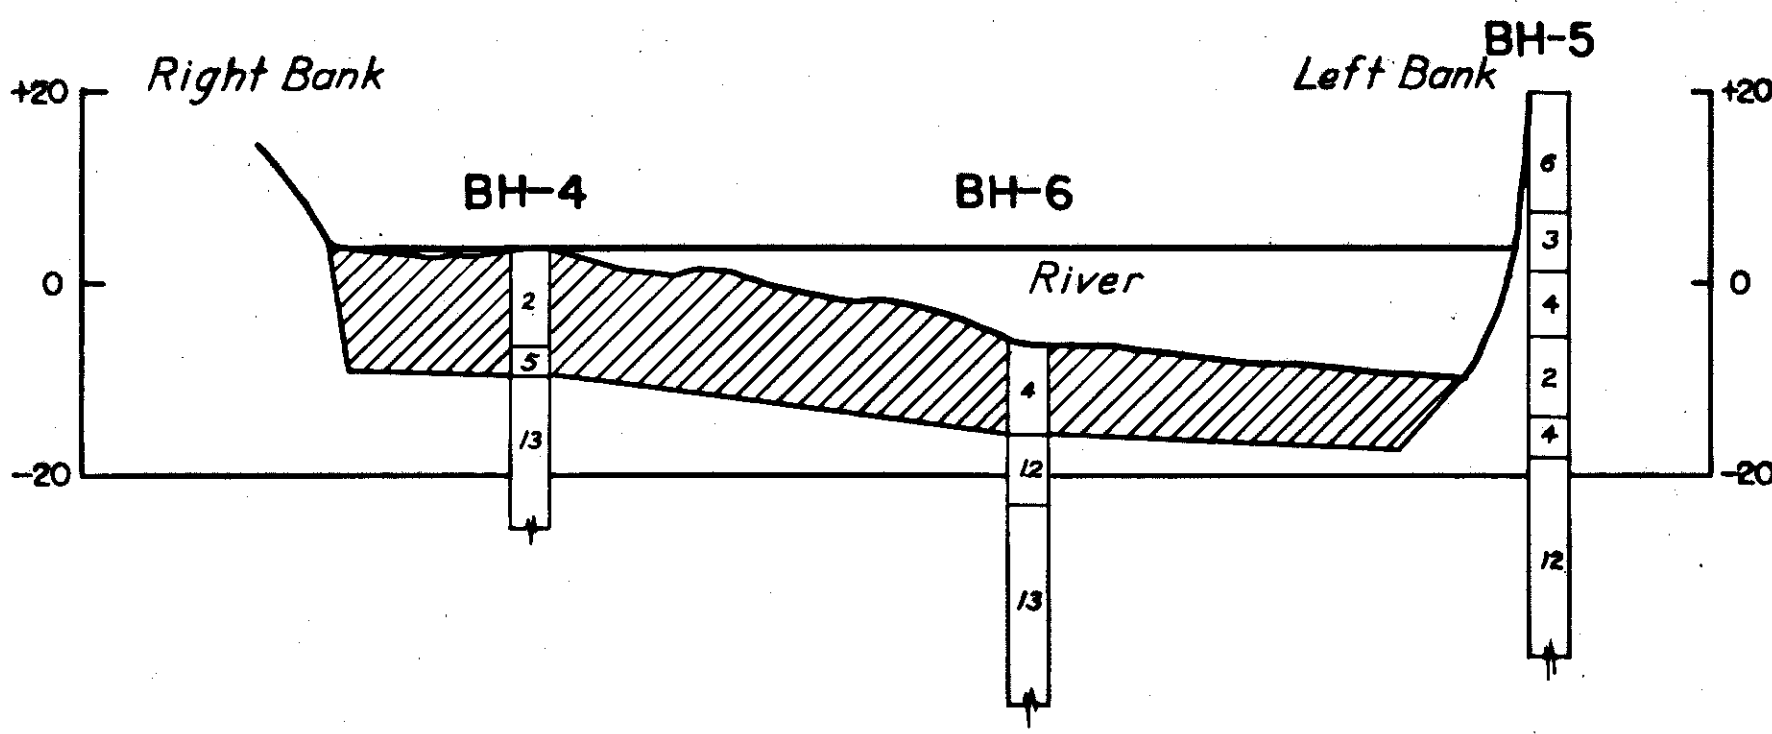
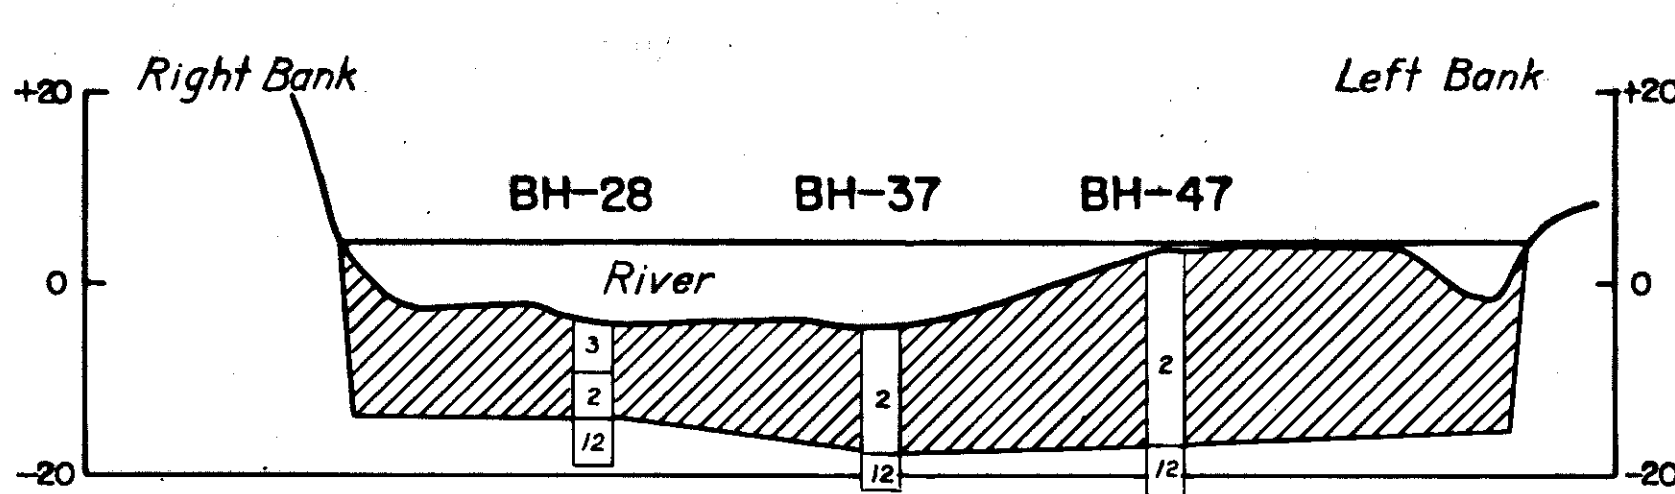


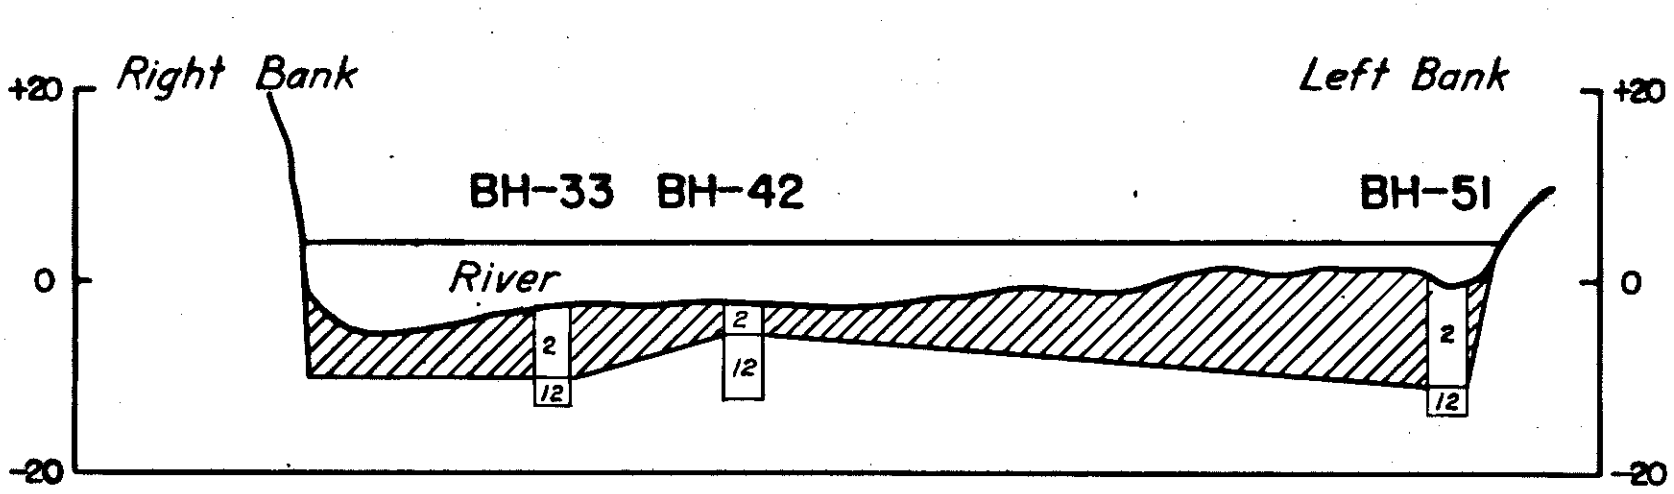

NOTES:
Elevations refer to Mean Sea Level Datum.
For location of borings see sheet No.2
For description of numerical classifications
see Sheet No. 4
Cross hatched areas show limit of borrow.

CONNECTICUT RIVER FLOOD CONTROL		
NORTH MEADOWS DIKE		
RIVER CROSS-SECTIONS		
HARTFORD, CONN.		
CONNECTICUT RIVER,	CONNECTICUT.	
IN 15 SHEETS	HORIZONTAL SCALE: 1 IN=200 FT.	SHEET NO. 7
VERTICAL SCALE: 1 IN=20 FT.		
U. S. ENGINEER OFFICE, PROVIDENCE, R. I., OCT. 1938		
SUBMITTED	APPROVAL	RECOMMENDATION
PRINCIPAL ENGINEER	CAPT. CORPS OF ENGINEERS	LT. COL. CORPS OF ENGINEERS
CHIEF ENGINEERING SECTION	CHIEF FLOOD CONTROL DIV.	DISTRICT ENGINEER
DRAWN BY: W.A.S.	FILE NO. CT-4-1114	
COMPILED: <i>Paul J. Quinn</i>	TO ACCOMPANY SPECIFICATIONS	
GEOLOGIST	DATED OCT. 1, 1938	
CHECKED BY: P. H. J.		

12-31-45 As Built