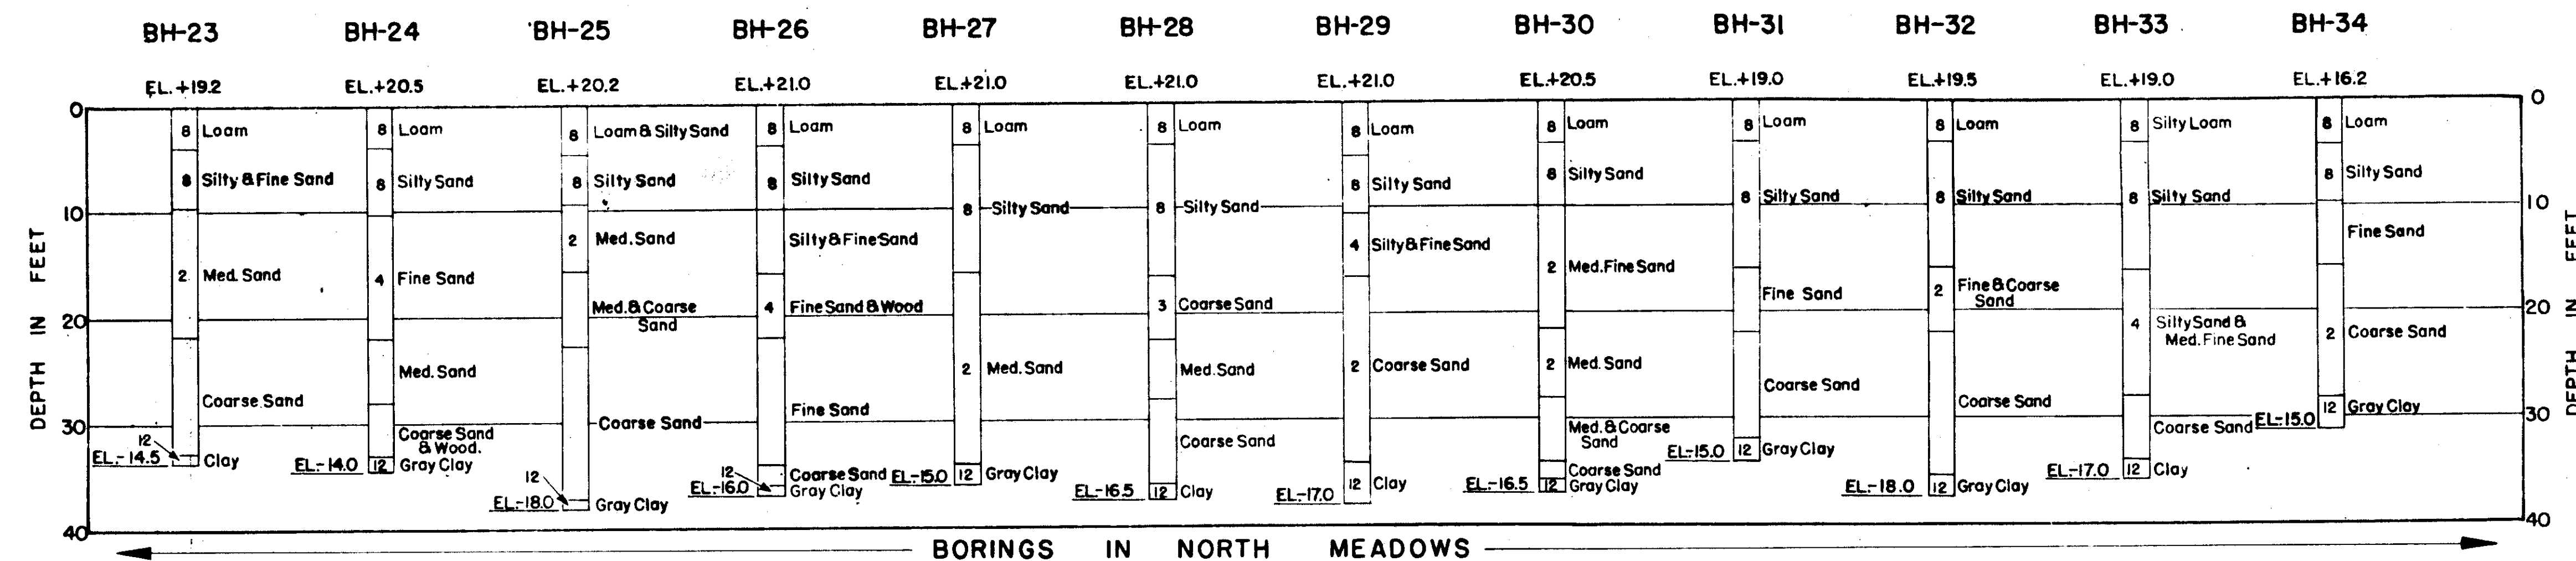
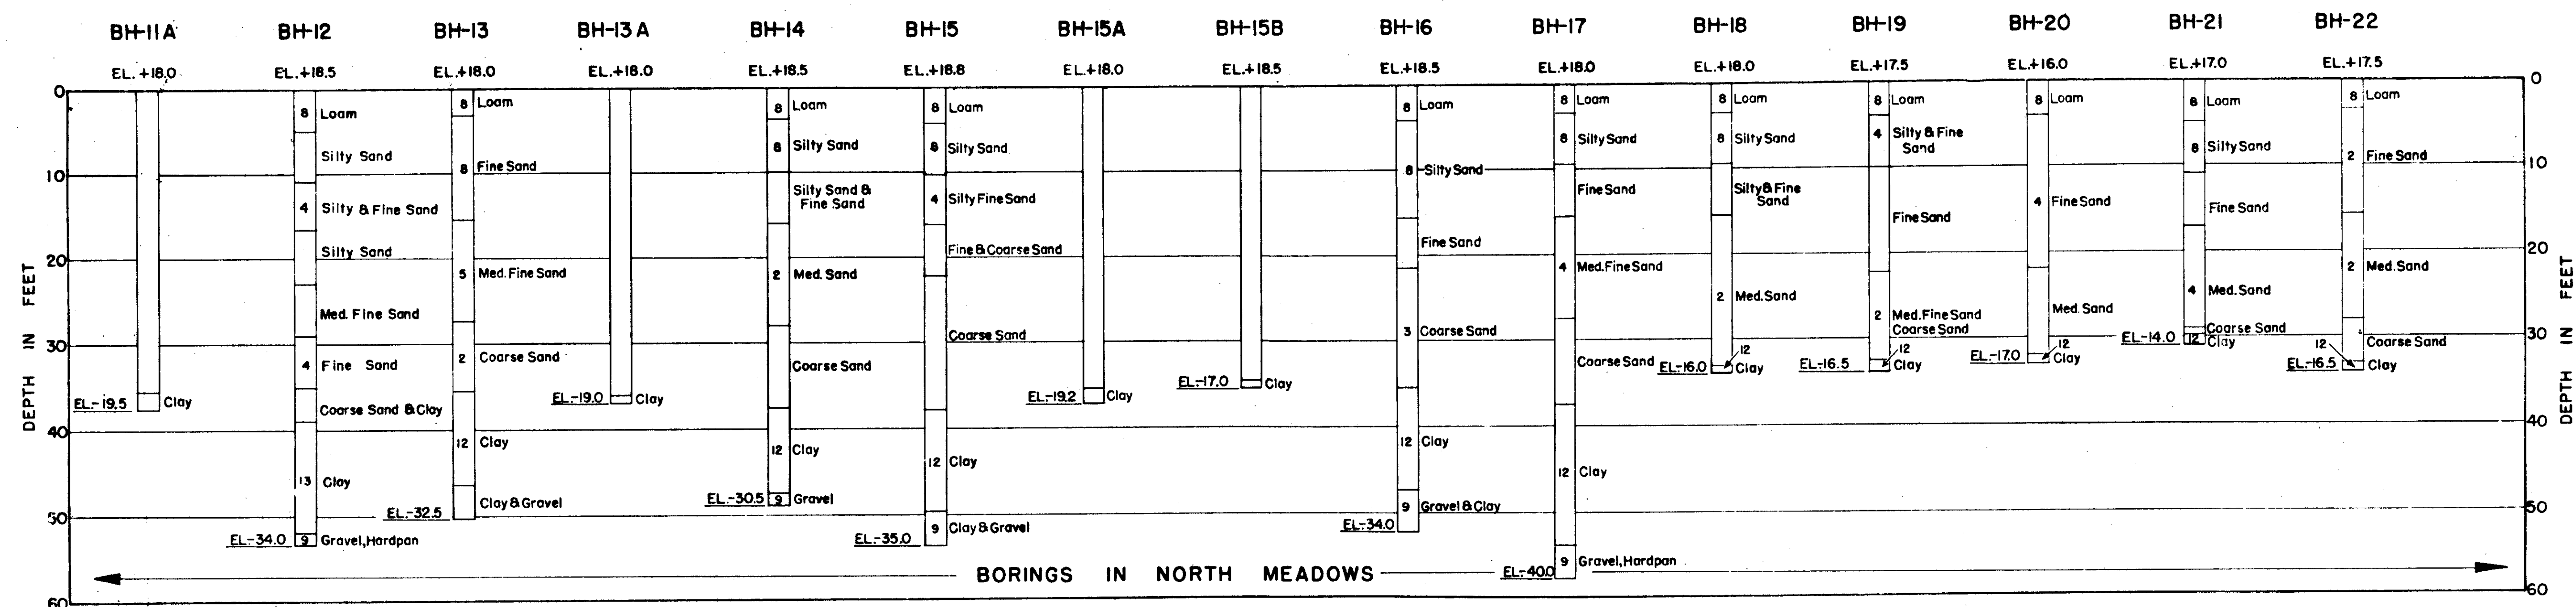
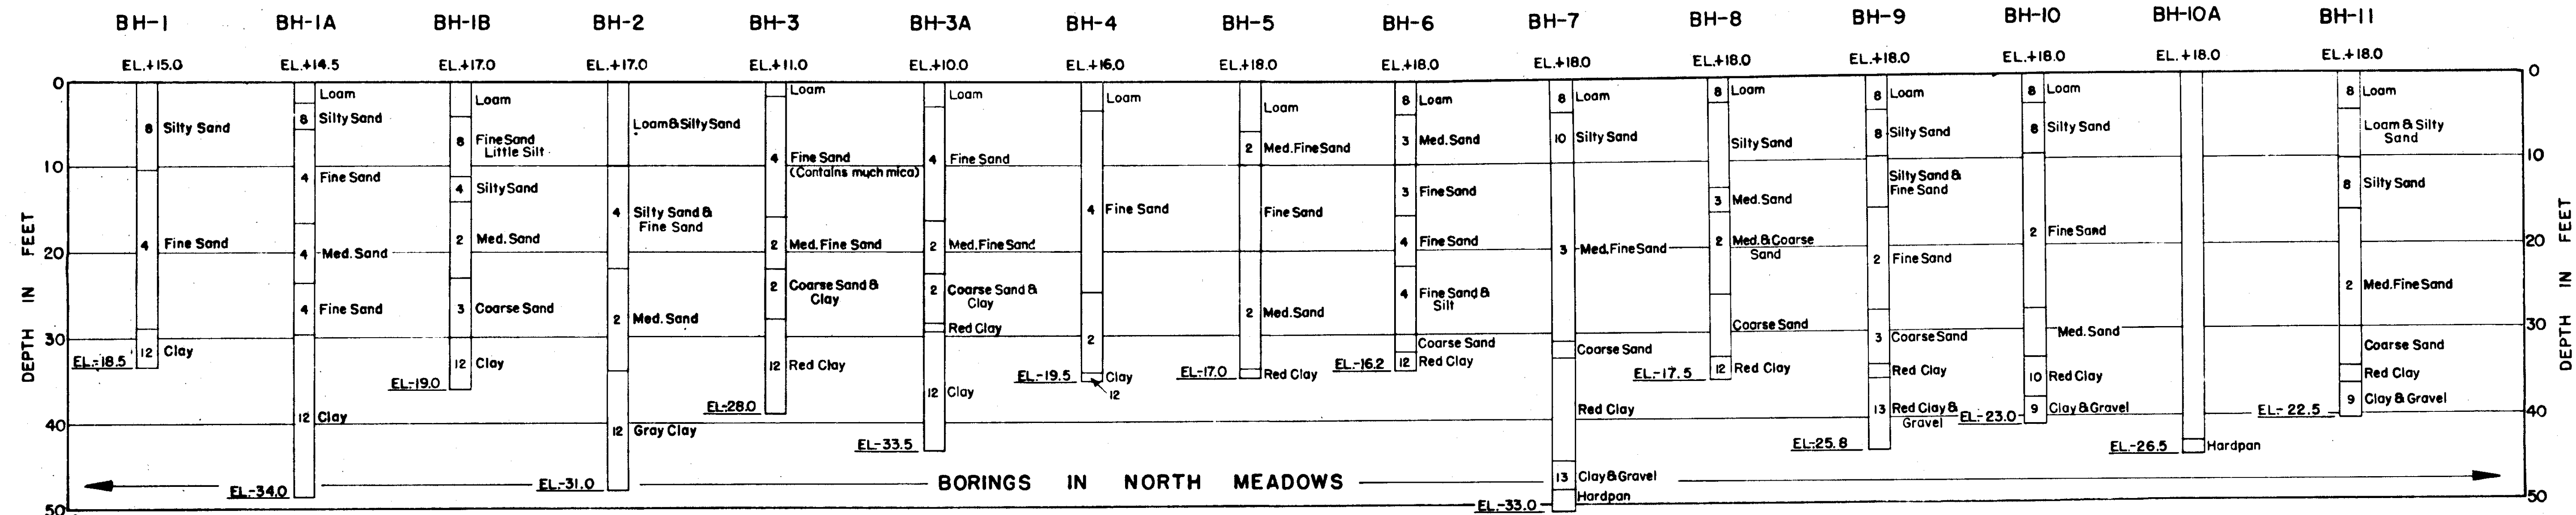


**NOTES**

Elevations refer to M.S.L. datum.
For location of borings see Sheet No. 4. (Symbol--a)
Borings and description of materials encountered made by City of Hartford Engineering Dept..
Numbers shown in bore hole columns indicate materials classified visually by Providence District.
For description of numerical classification see Sheet No. 6.

CONNECTICUT RIVER FLOOD CONTROL			
NORTH MEADOWS DIKE			
FISCAL YEAR 1939 SECTION			
RECORD OF SUBSURFACE EXPLORATIONS NO. 3			
HARTFORD, CONN.			
CONNECTICUT RIVER		CONNECTICUT	
IN 66 SHEETS		SHEET NO. 7	
VERT. SCALE: 1 IN = 10 FT.			
U.S. ENGINEER OFFICE, PROVIDENCE, R.I. APRIL 1939			
SUBMITTED: <i>W. C. Slagter</i>		APPROVED: <i>J. B. Burns</i>	
SENIOR GEOLOGIST		PRINCIPAL ENGINEER	
HEAD, GEOLOGY SECTION		CHIEF, F.C. ENGINEERING DIV.	
COMPILED: <i>W. C. Slagter</i>		DRAWN BY: P.H.S.	
AS ST. ENGINEER		TRACED BY: J. M. L. & I. C. W.	
CHECKED BY: P. H. S.		FILE NO. CT-2-1143	

12/31/45 As-Built