




BORROW AREA D

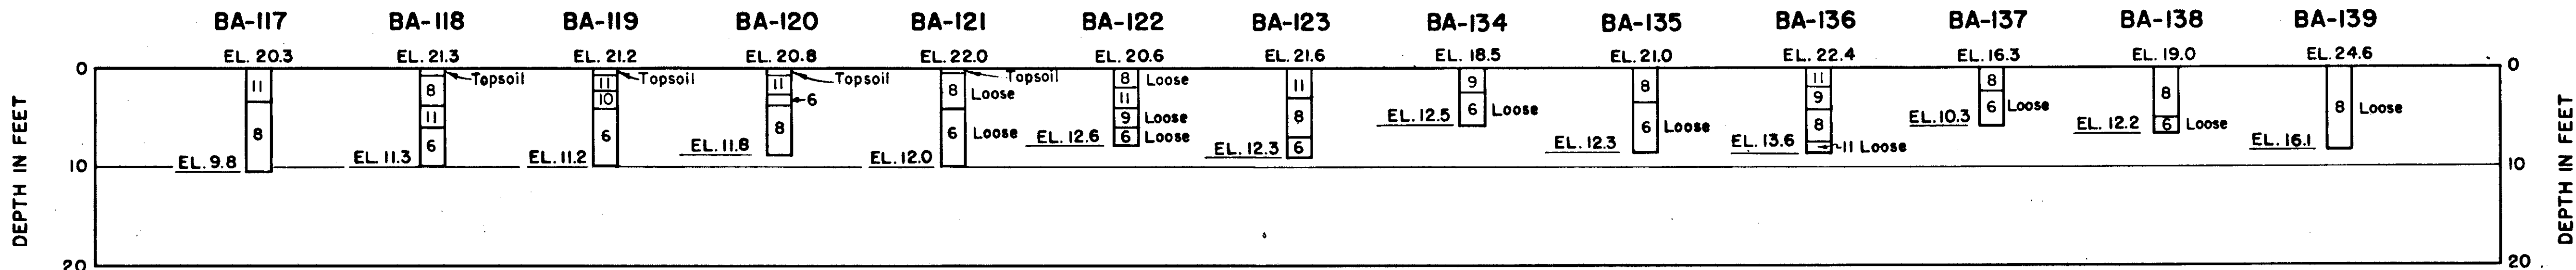


BORROW AREA D

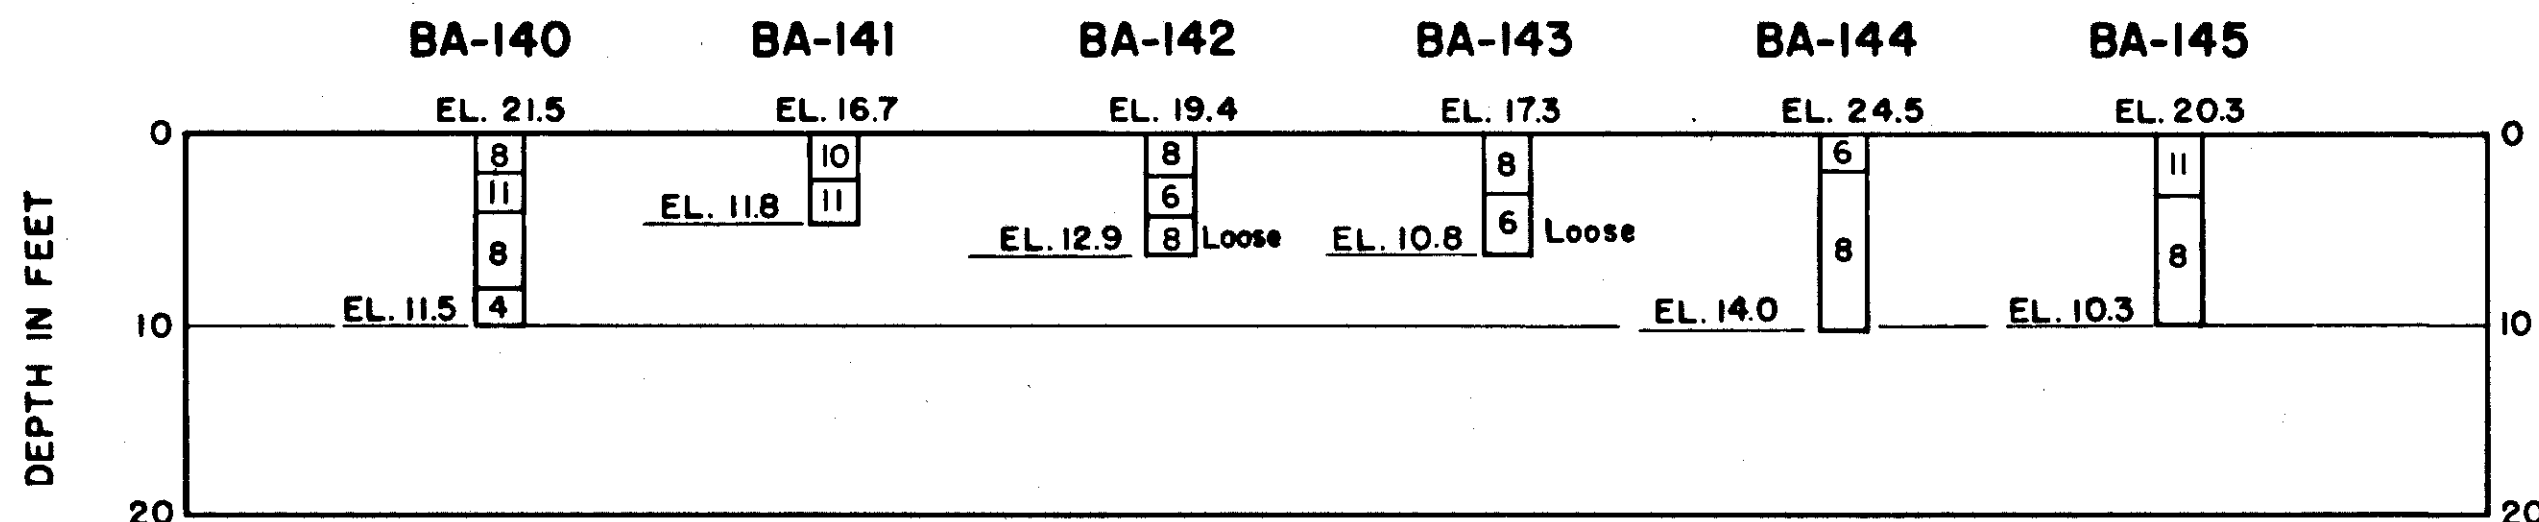

BORROW AREA D

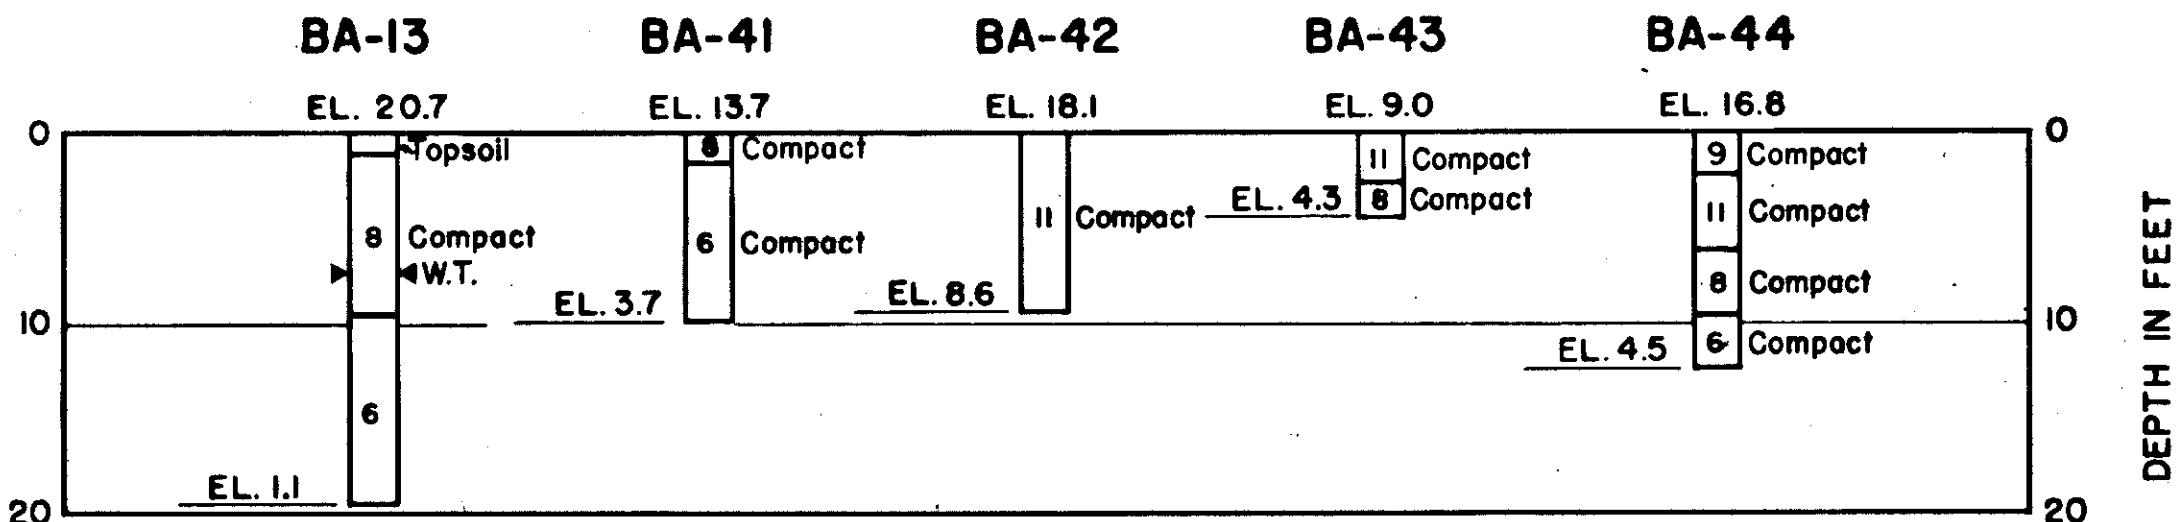

BORROW AREA E

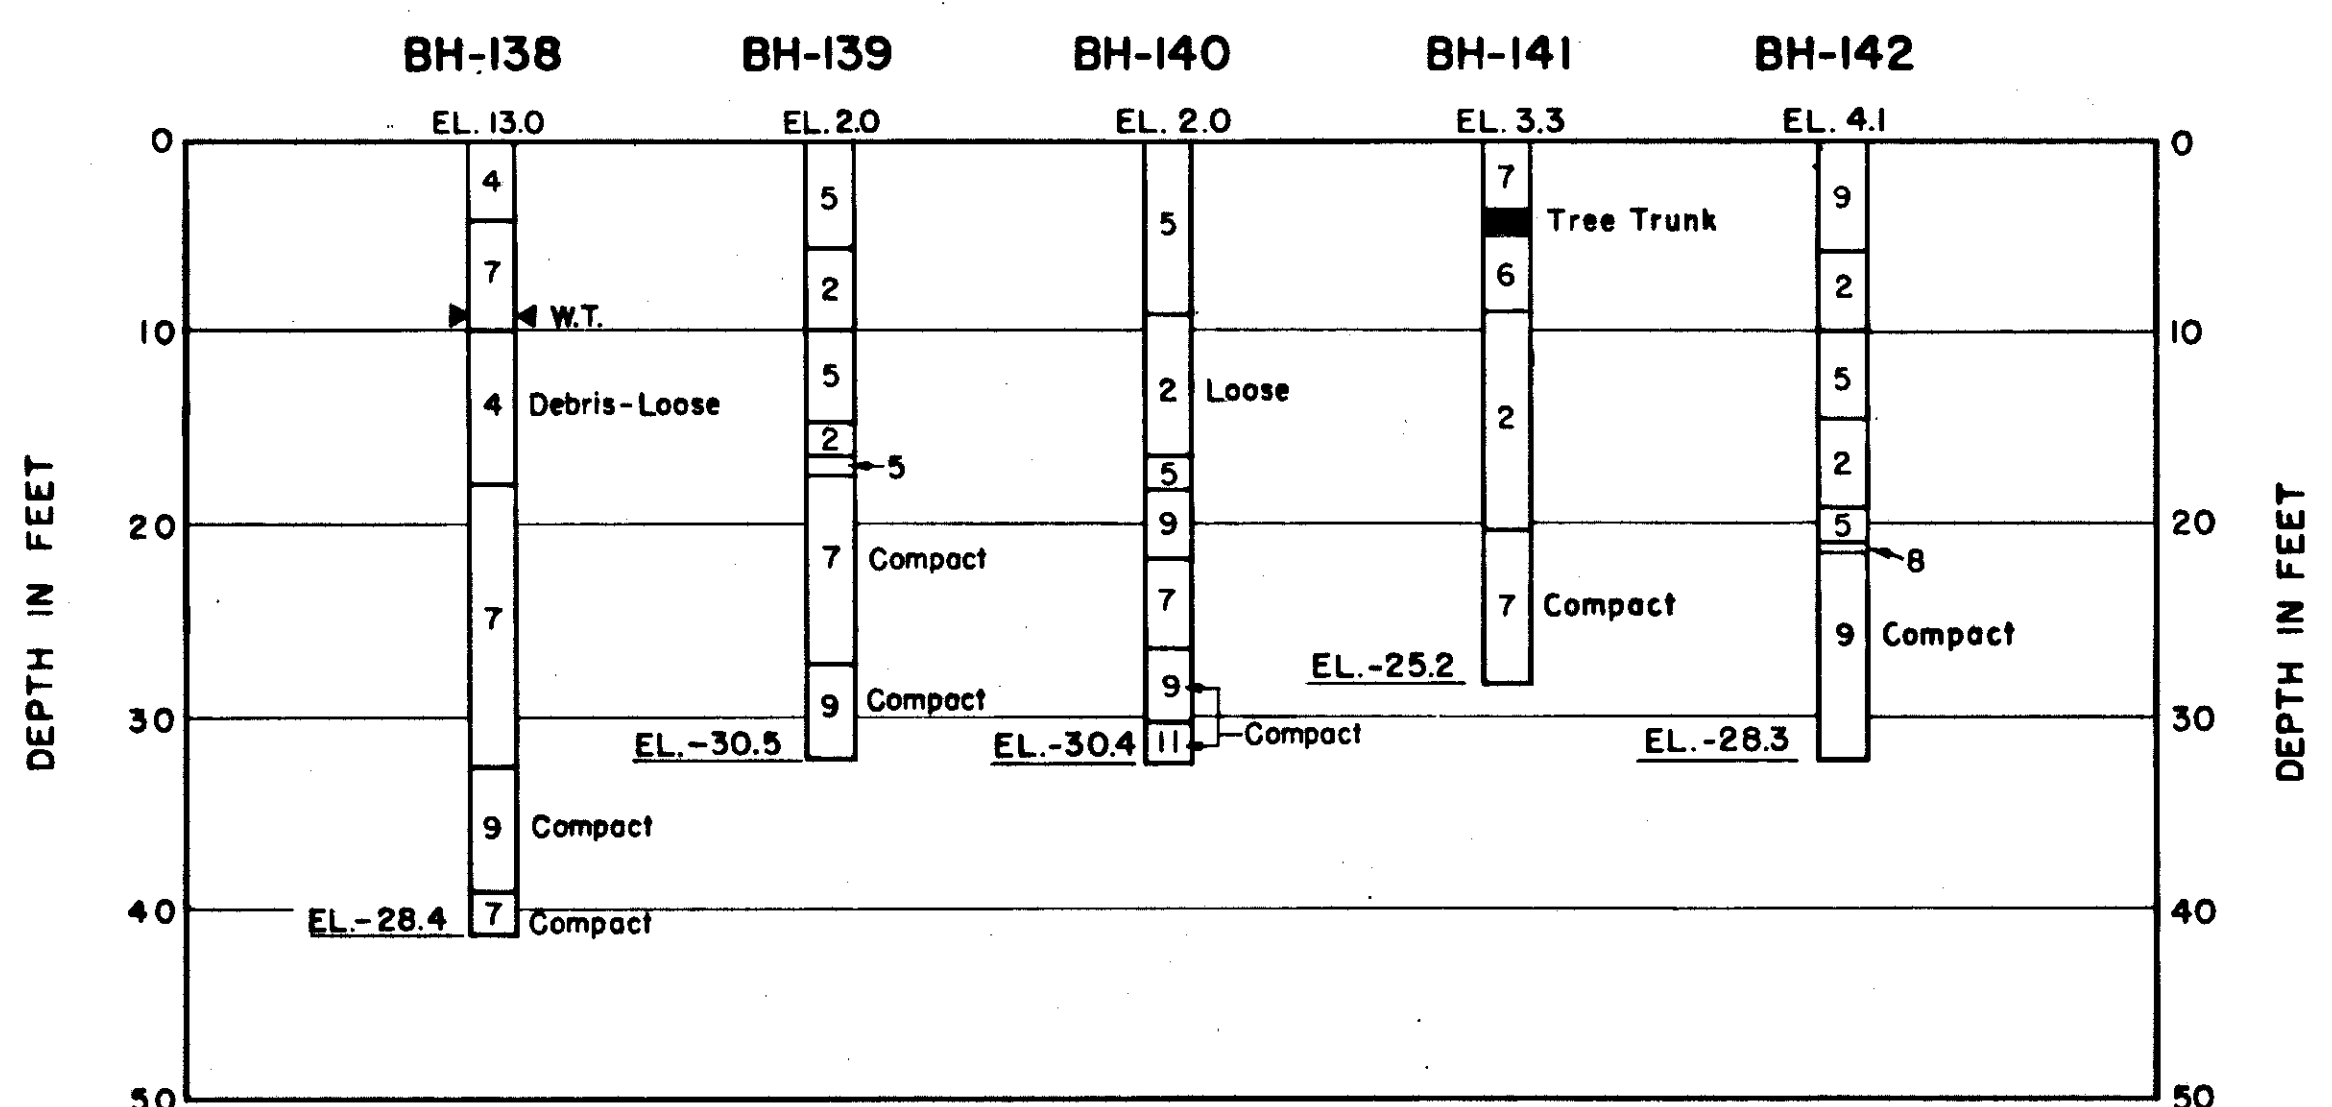

BORINGS ADJACENT TO MEMORIAL BRIDGE

NOTES:
Elevations refer to M.S.L. datum.
For locations of core borings see Sheet No. 4 (Symbol-⊙)
For description of numerical classes see Sheet No. 6
For locations of auger borings see Sheet No. 11 (Symbol-⊙)
Water table elevation coincides with bottom of auger boring unless otherwise indicated.
Borings shown on this sheet made by Providence District, U. S. E. D.

LEGEND:
BH Core boring
BA Auger boring
W.T. Water Table at time of exploration

12/31/45	As-Built	REVISION	REV. BY	CK. BY	AP. BY
----------	----------	----------	---------	--------	--------

CONNECTICUT RIVER FLOOD CONTROL	
NORTH MEADOWS DIKE	
FISCAL YEAR 1939 SECTION	
RECORD OF SUBSURFACE EXPLORATIONS NO. 5	
HARTFORD, CONN.	
CONNECTICUT RIVER	CONNECTICUT
IN 66 SHEETS	VERT. SCALE: 1 IN. = 10 FT.
SHEET NO. 9	
U.S. ENGINEER OFFICE, PROVIDENCE, R.I. APRIL 1939	
SUBMITTED: <i>W. E. Johnson</i>	APPROVED: <i>J. D. Burns</i>
SENIOR GEOLOGIST	PRINCIPAL ENGINEER
HEAD, GEOLOGY SECTION	CHIEF, F.C. ENGINEERING DIV.
COMPILED: <i>W. E. Johnson</i>	DRAWN BY: <i>W. F. B.</i>
ASST. ENGINEER	CHECKED BY: <i>H. J.</i>
FILE NO. CT-2-1135	