
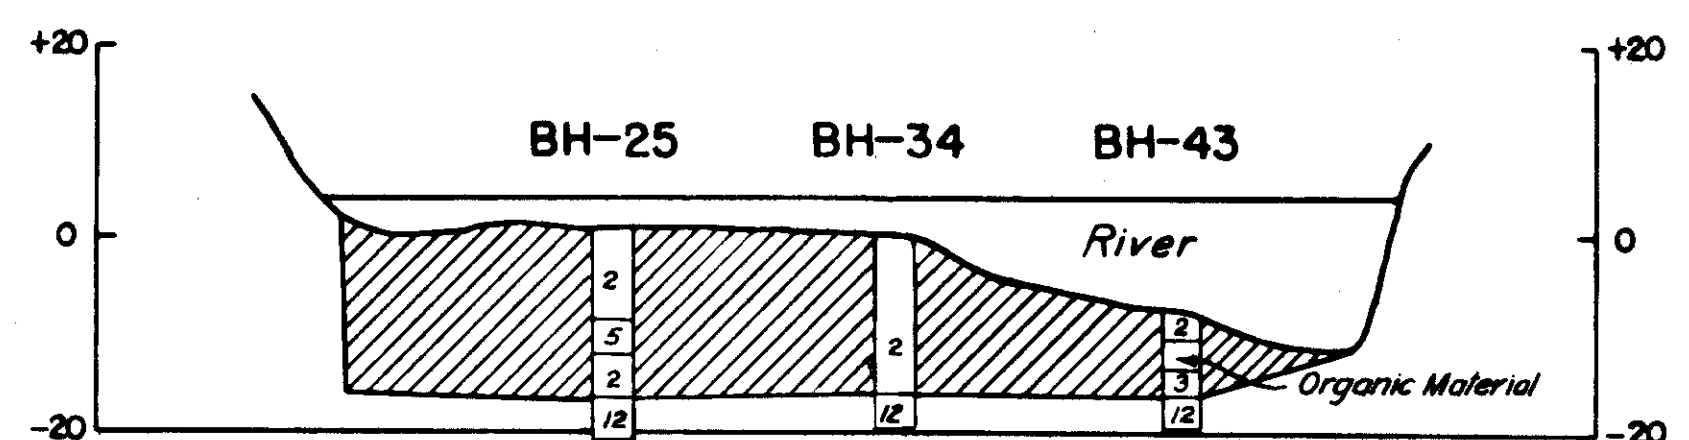
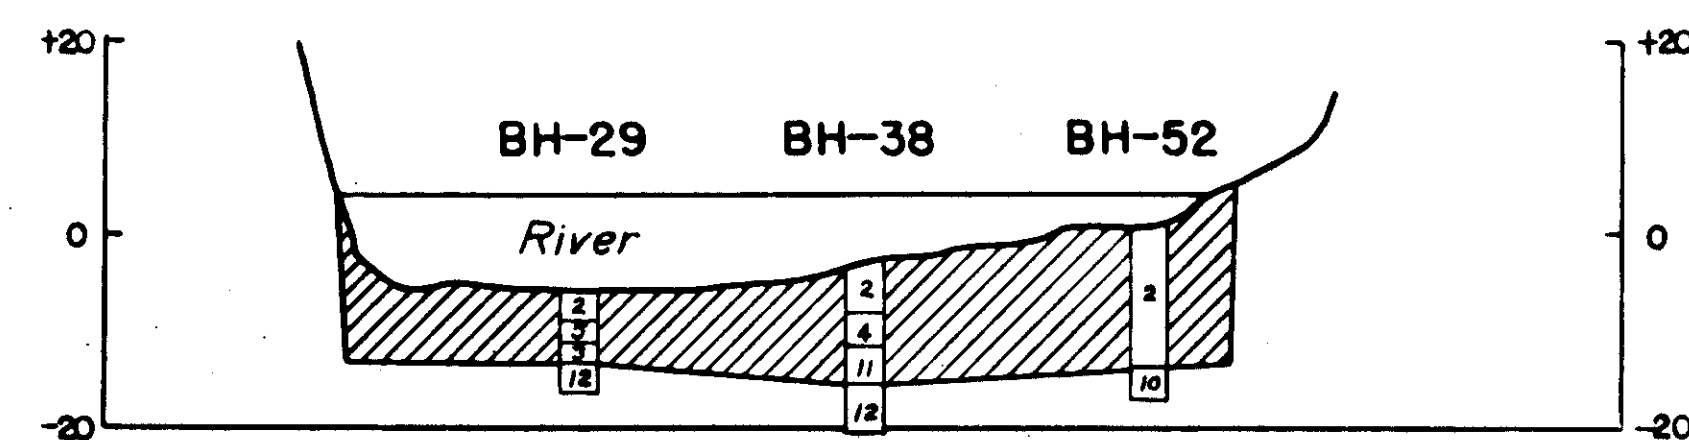
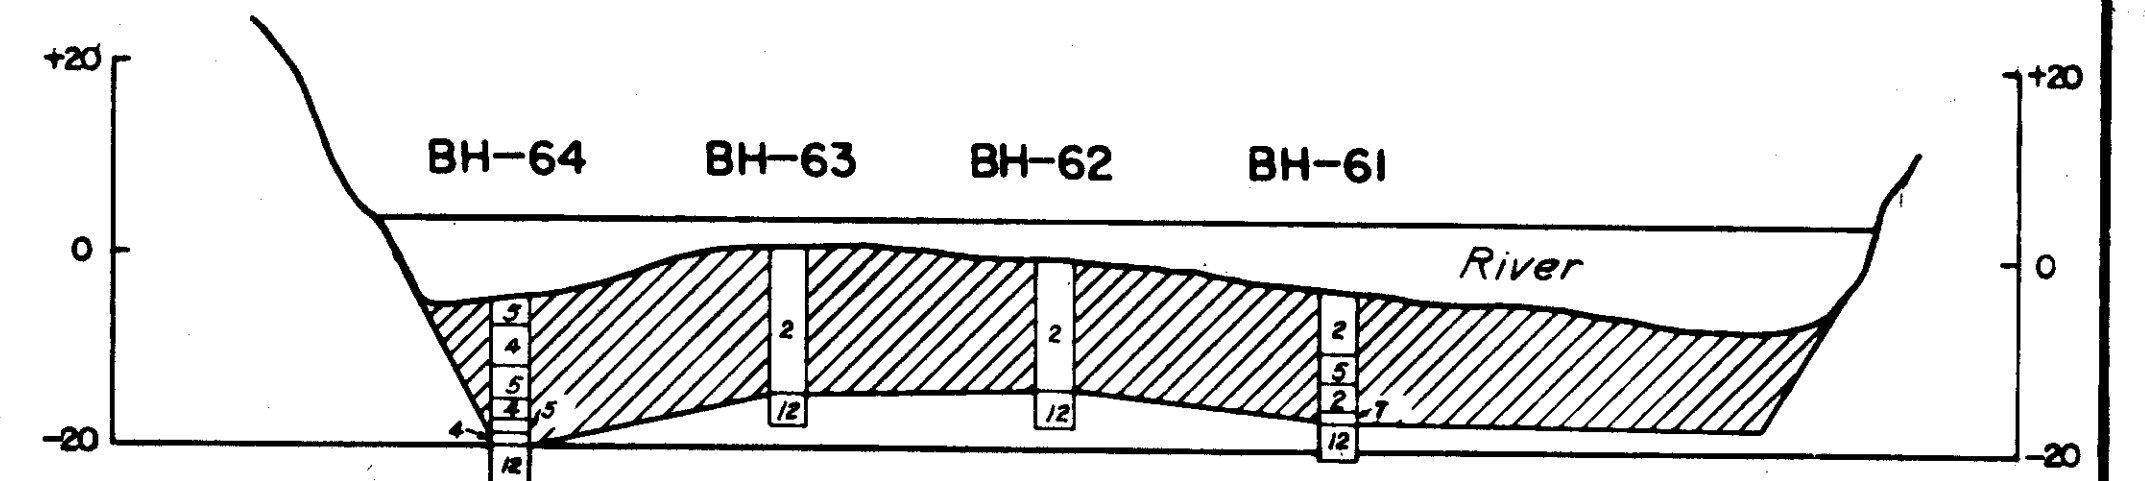
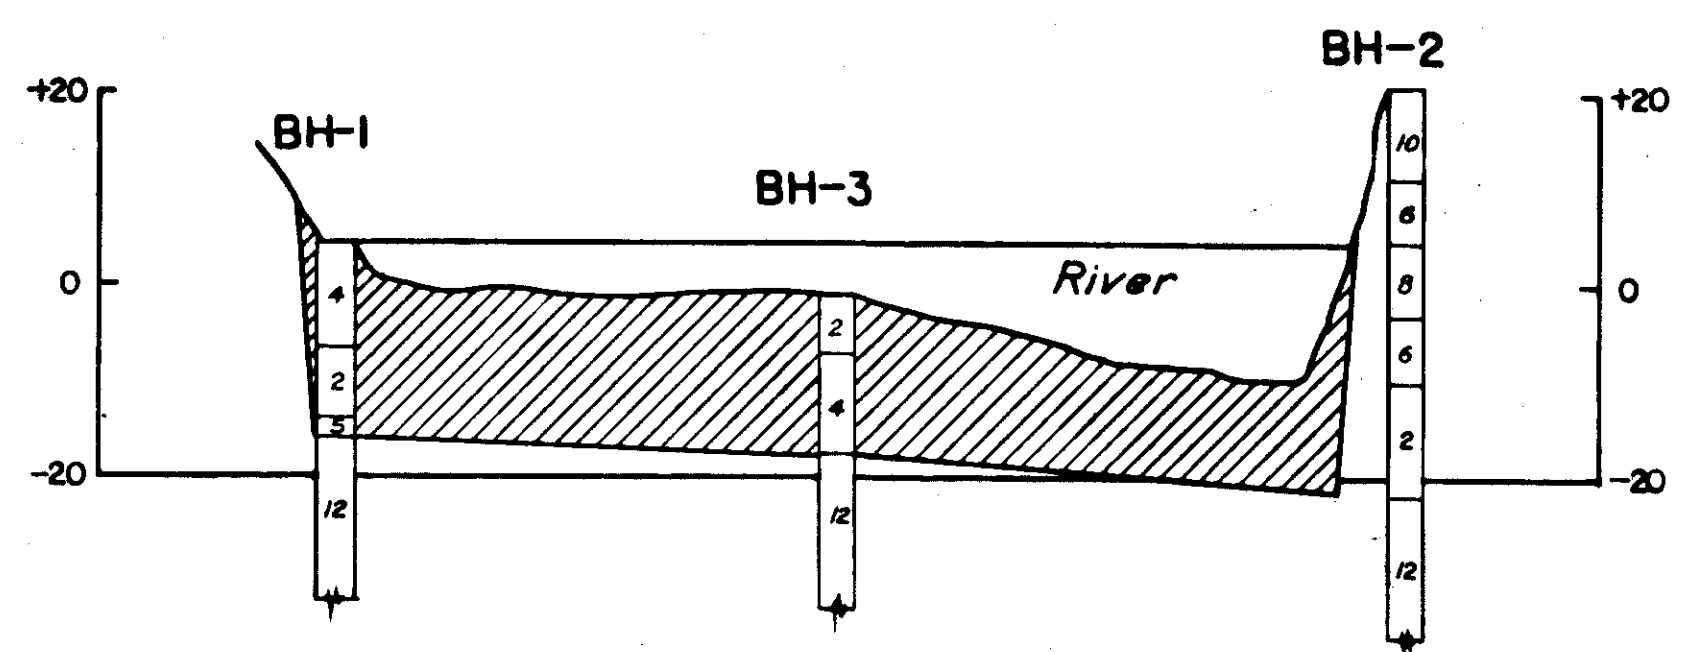
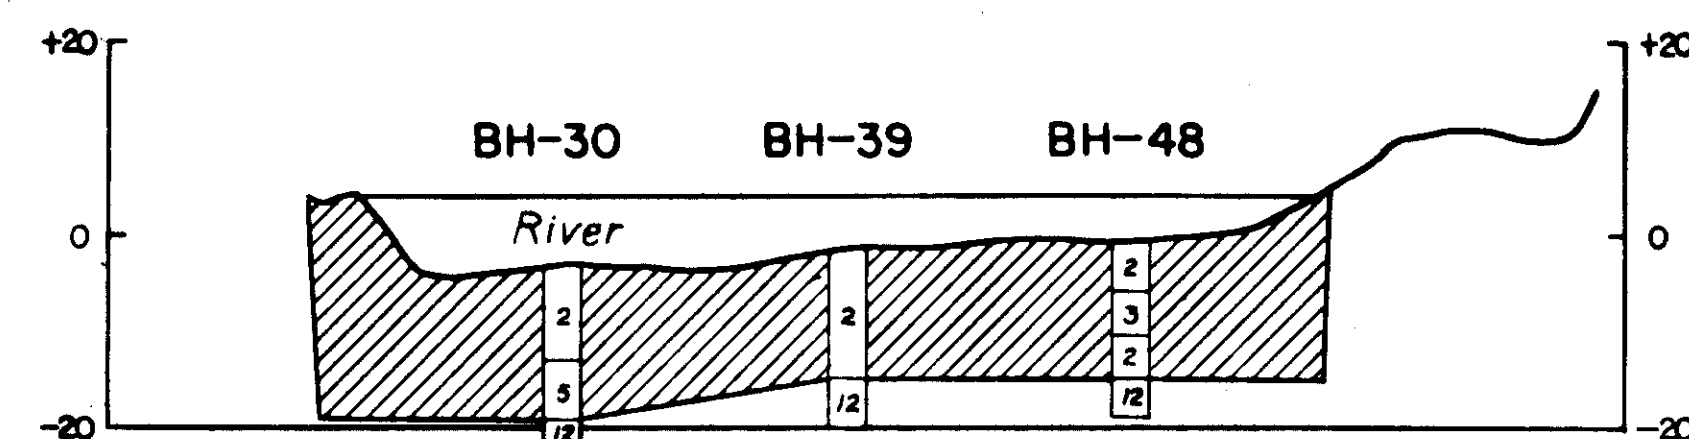
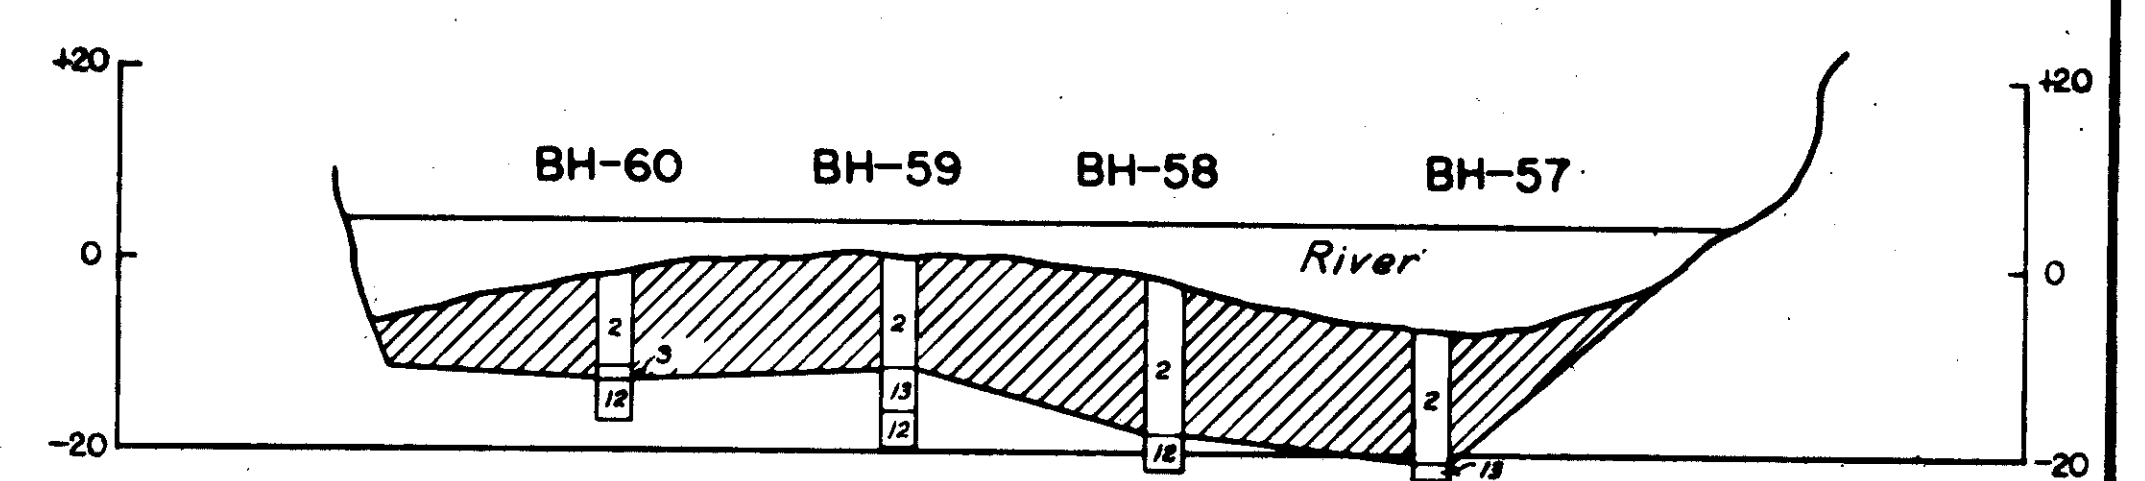
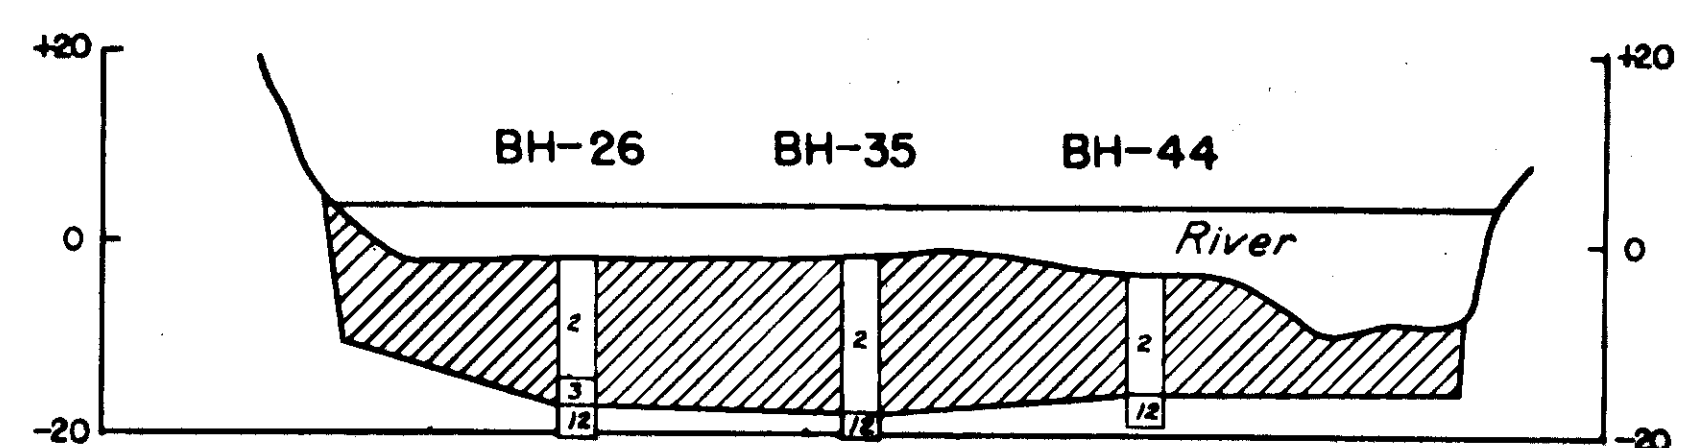
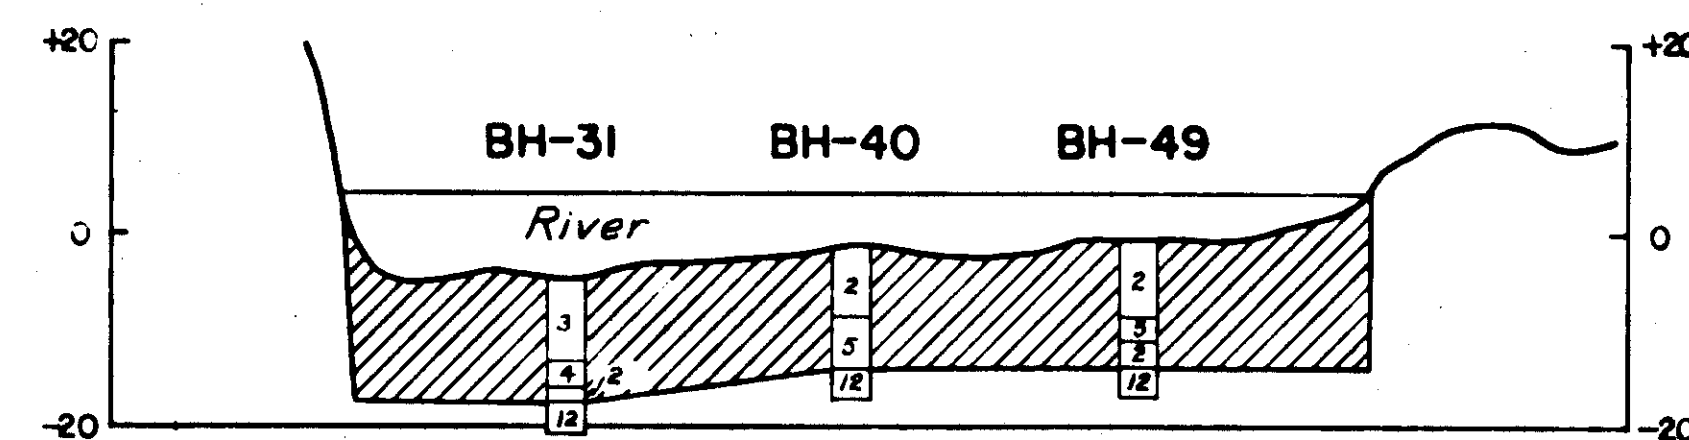
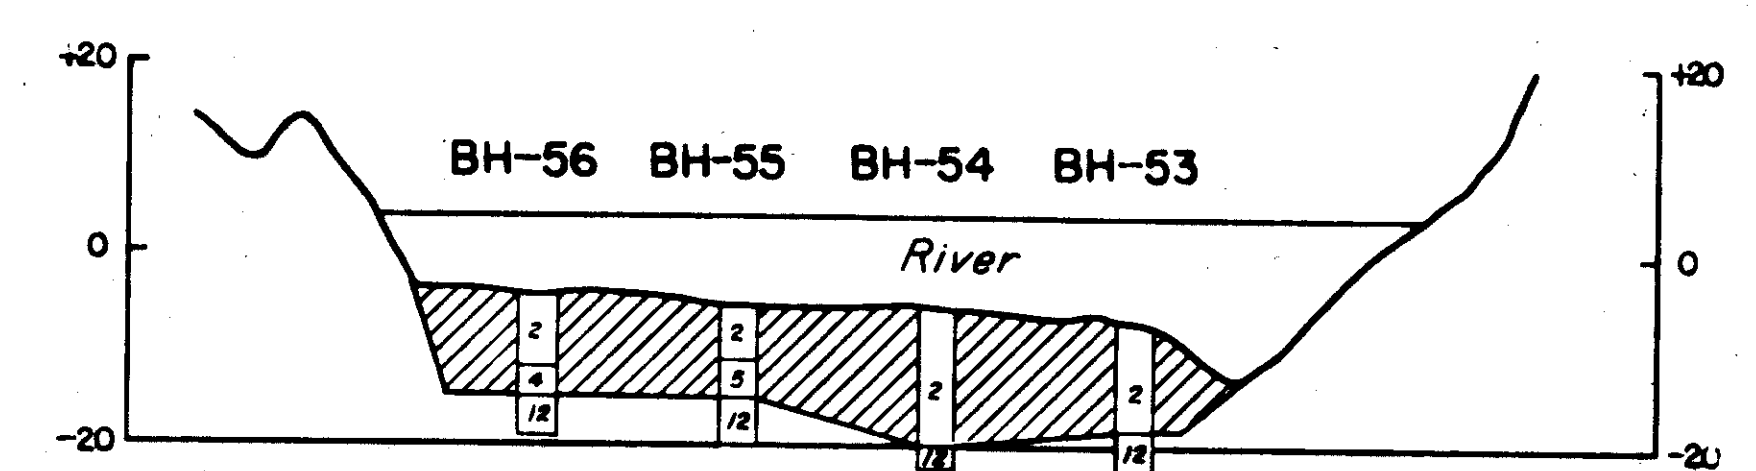
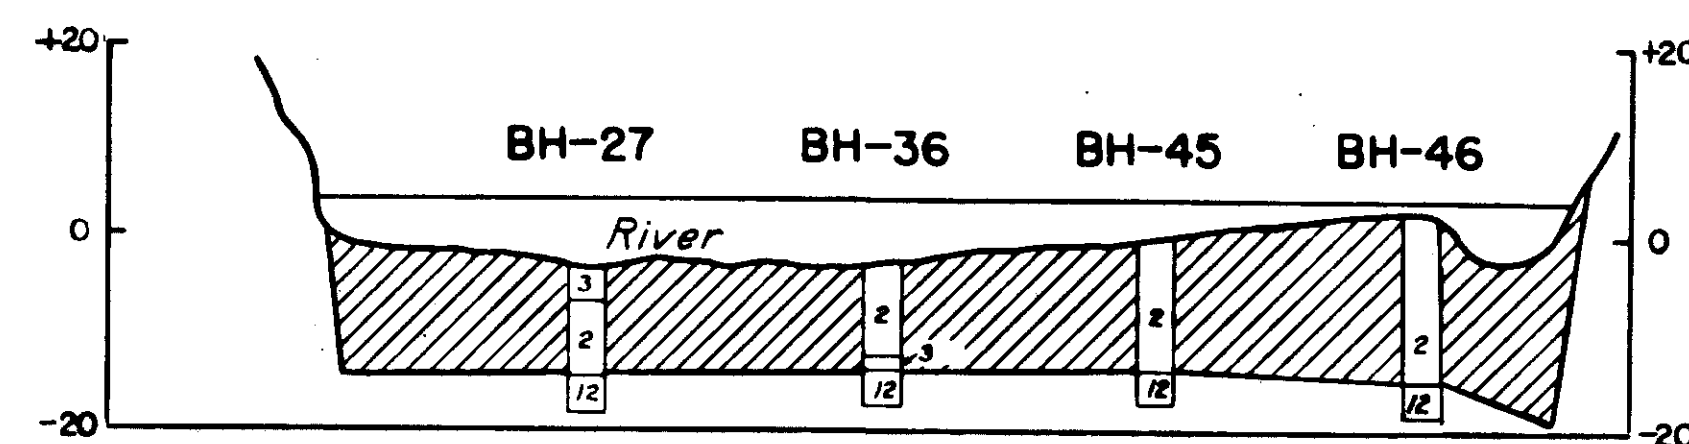
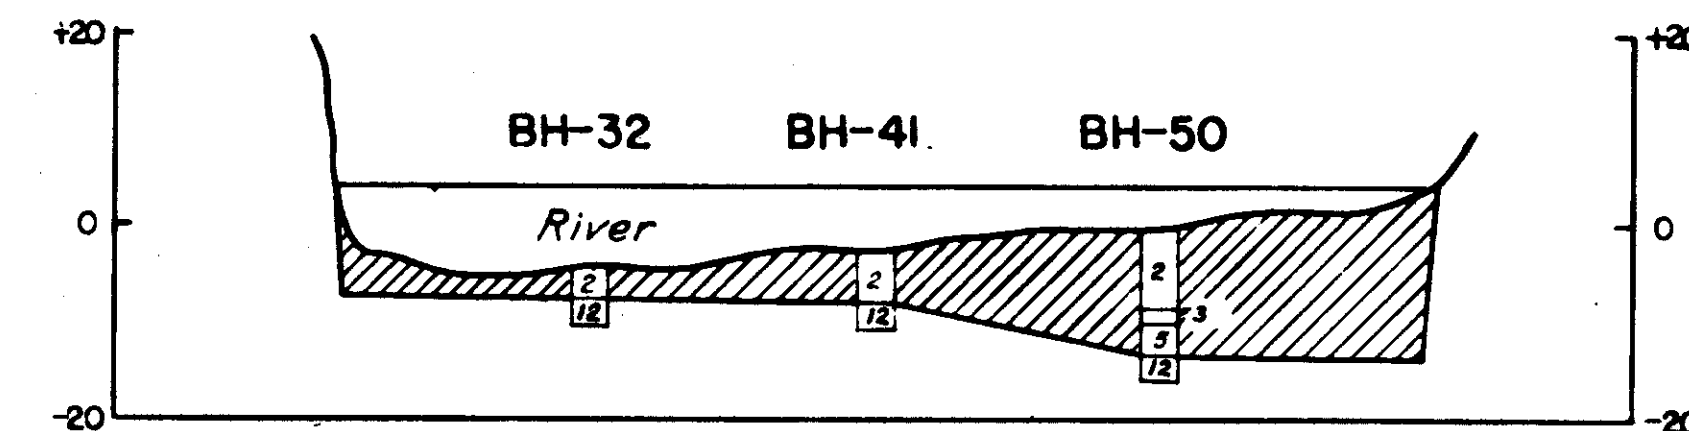
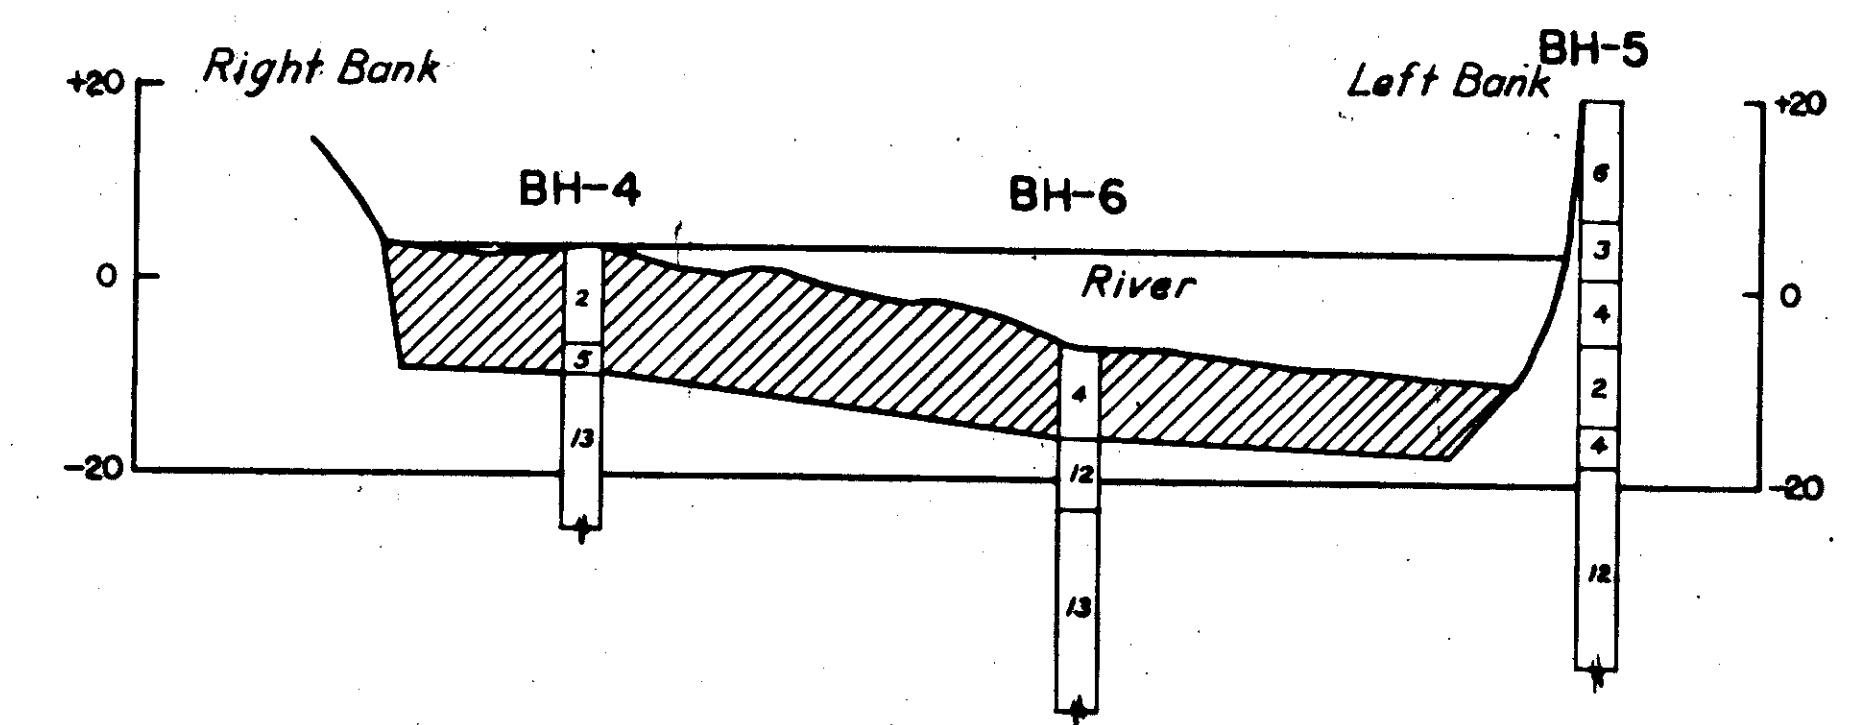
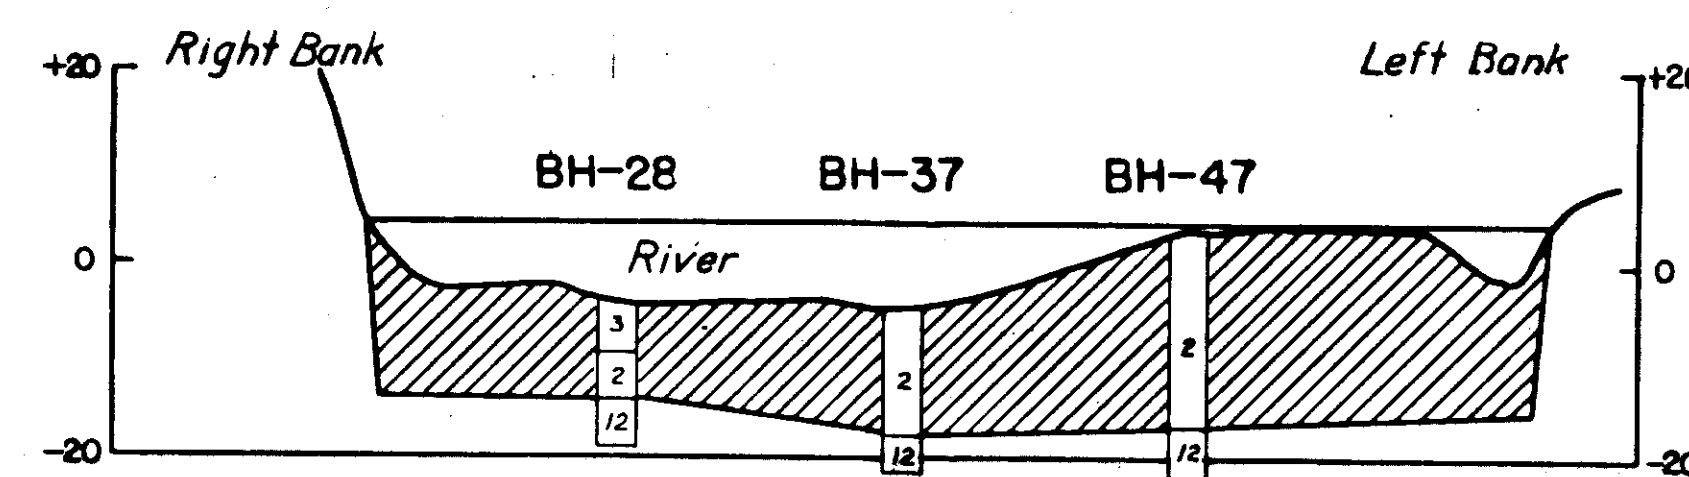


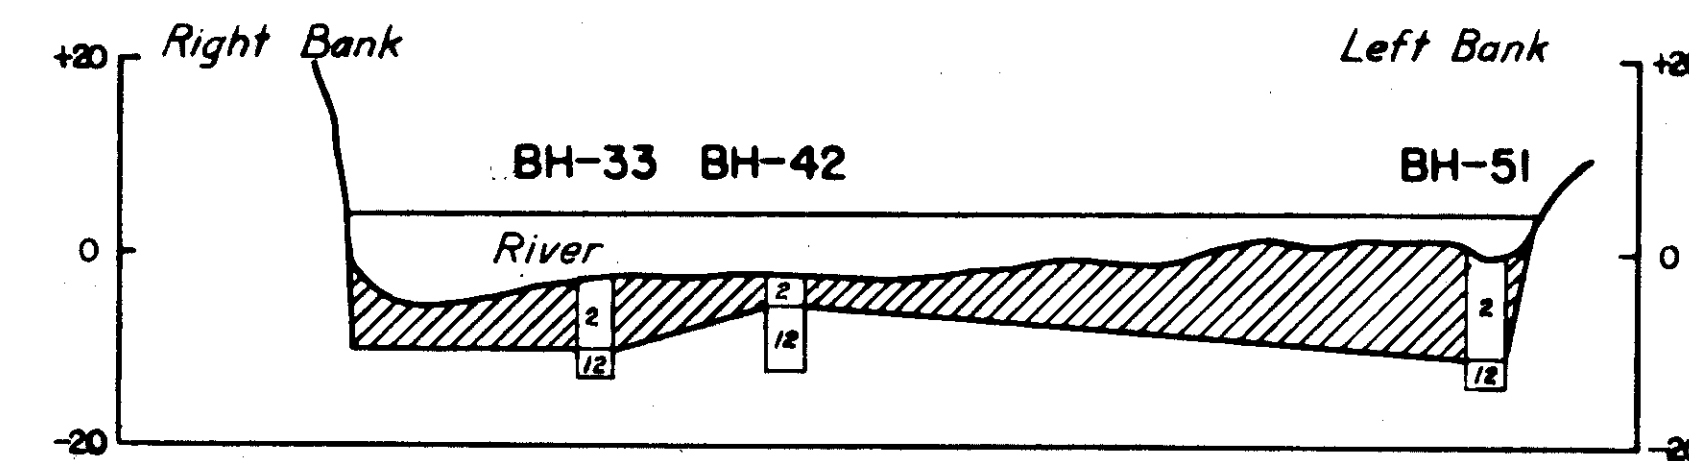

NOTES:

Elevations refer to Mean Sea Level Datum.
For location of borings see sheet No. 4.
For description of numerical classifications see Sheet No. 6.
Cross hatched areas show limit of borrow.

DATE	As-Built	REVISION	REV. BY	CK. BY	AR. BY
12/31/45					

CONNECTICUT RIVER FLOOD CONTROL		
NORTH MEADOWS DIKE		
FISCAL YEAR 1939 SECTION		
RIVER CROSS SECTIONS		
HARTFORD, CONN.		
CONNECTICUT RIVER	CONNECTICUT	
IN 66 SHEETS	HORIZONTAL SCALE: 1 IN = 200 FT.	SHEET NO. 10
VERTICAL SCALE: 1 IN = 20 FT.		
U. S. ENGINEER OFFICE, PROVIDENCE, R. I., APRIL 1939		
SUBMITTED:	APPROVAL RECOMMENDED:	APPROVED:
REGIONAL GEOLOGIST	PRINCIPAL ENGINEER	LT. COL. CORPS OF ENGINEERS
HEAD, GEOLOGY SECTION	CHIEF, F. C. ENGINEERING DIV.	DISTRICT ENGINEER
COMPILED:	DRAWN BY: W. A. S.	FILE NO. CT-2-1145
ASST. ENGINEER	CHECKED BY: P. H. J.	