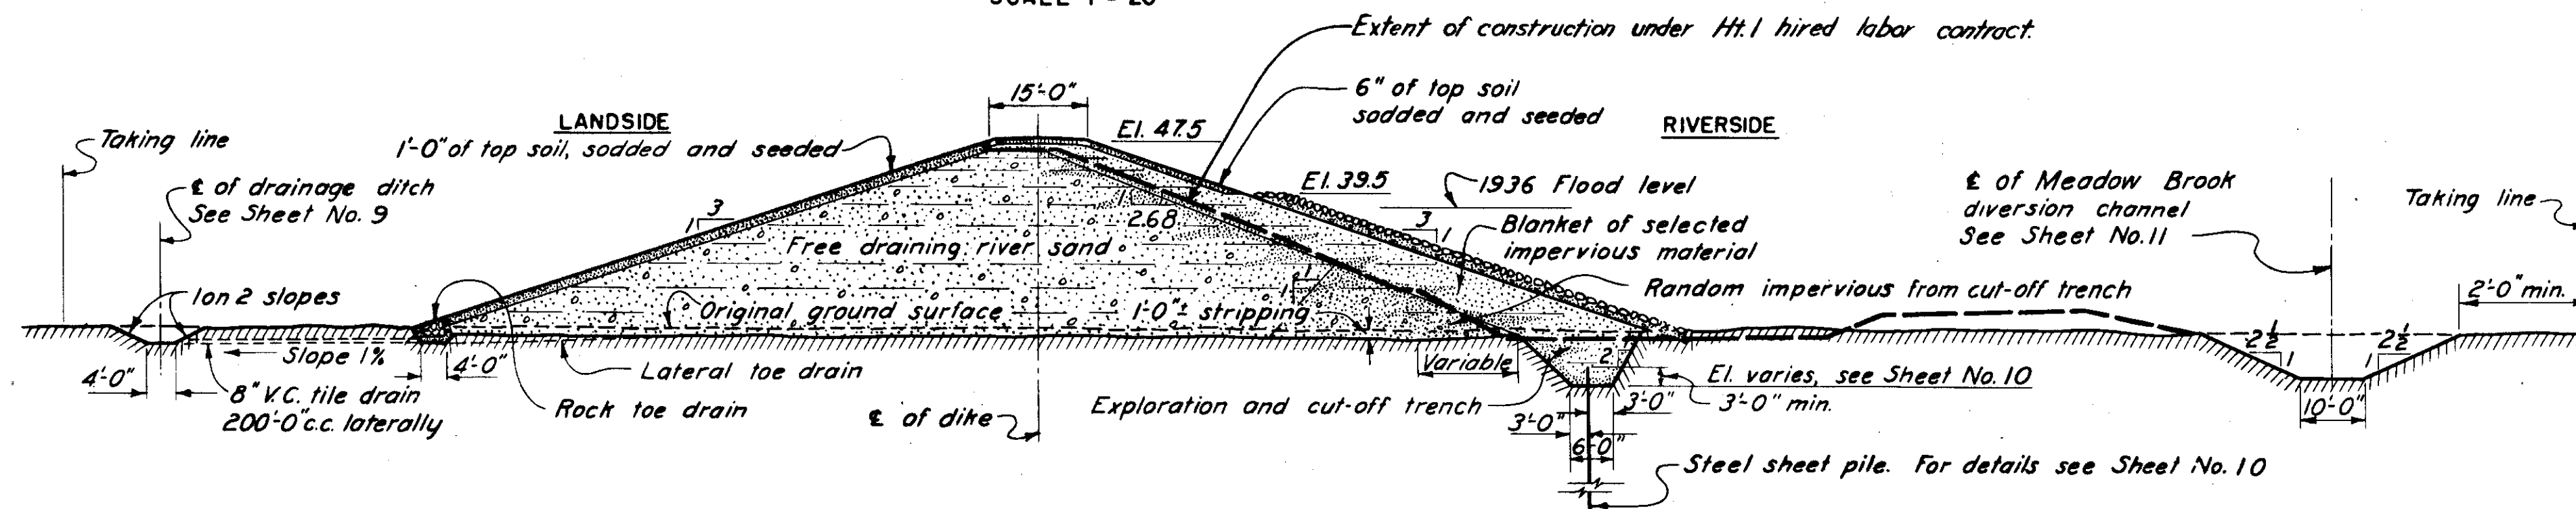
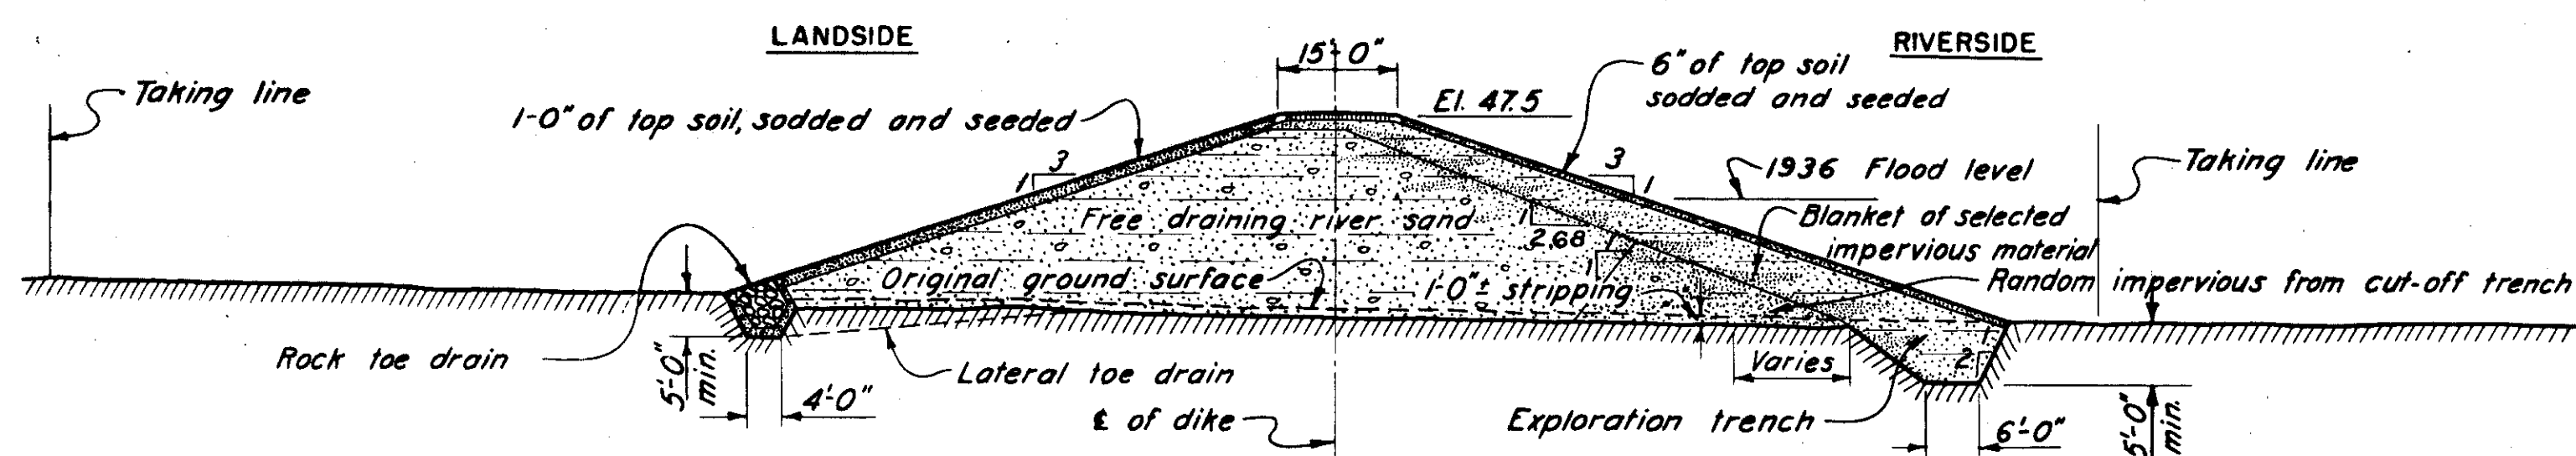



SECTION AT STA. 125+00

TYPICAL FROM STA. 98+00 TO STA. 138+00
SCALE 1" = 20'

SECTION AT STA. 150+00


TYPICAL FROM STA. 138+00 TO STA. 159+53
SCALE 1" = 20'

SECTION AT STA. 164+00

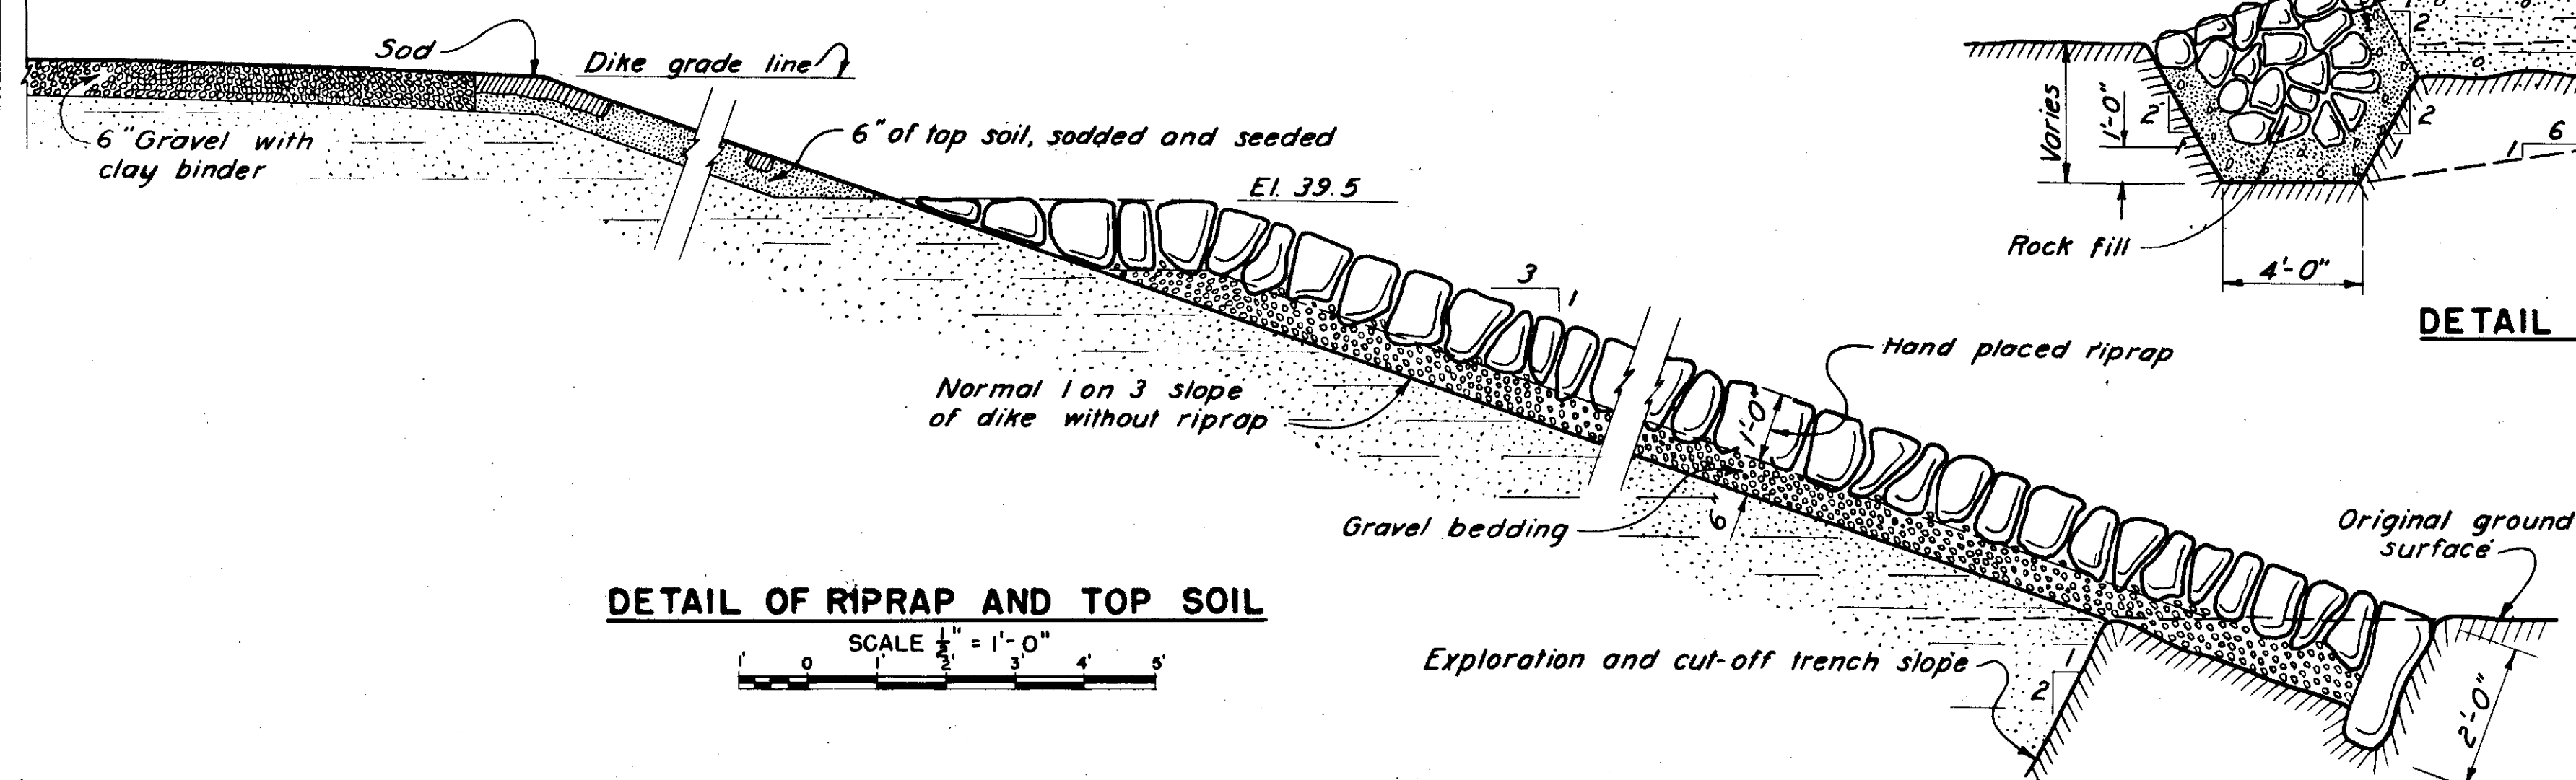TYPICAL FROM STA. 161+53 TO STA. 168+00
SCALE 1" = 20'


DETAIL OF RIPRAP AND TOP SOIL

SCALE 1/4" = 1'-0"

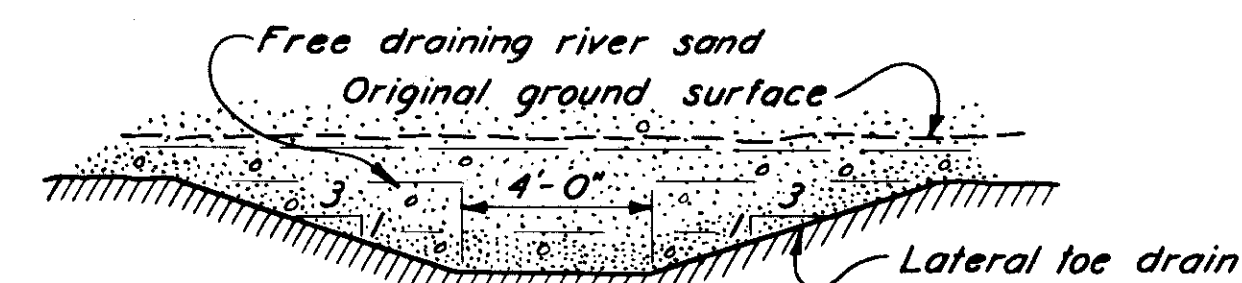

SECTION A-A

SCALE 1/4" = 1'-0"

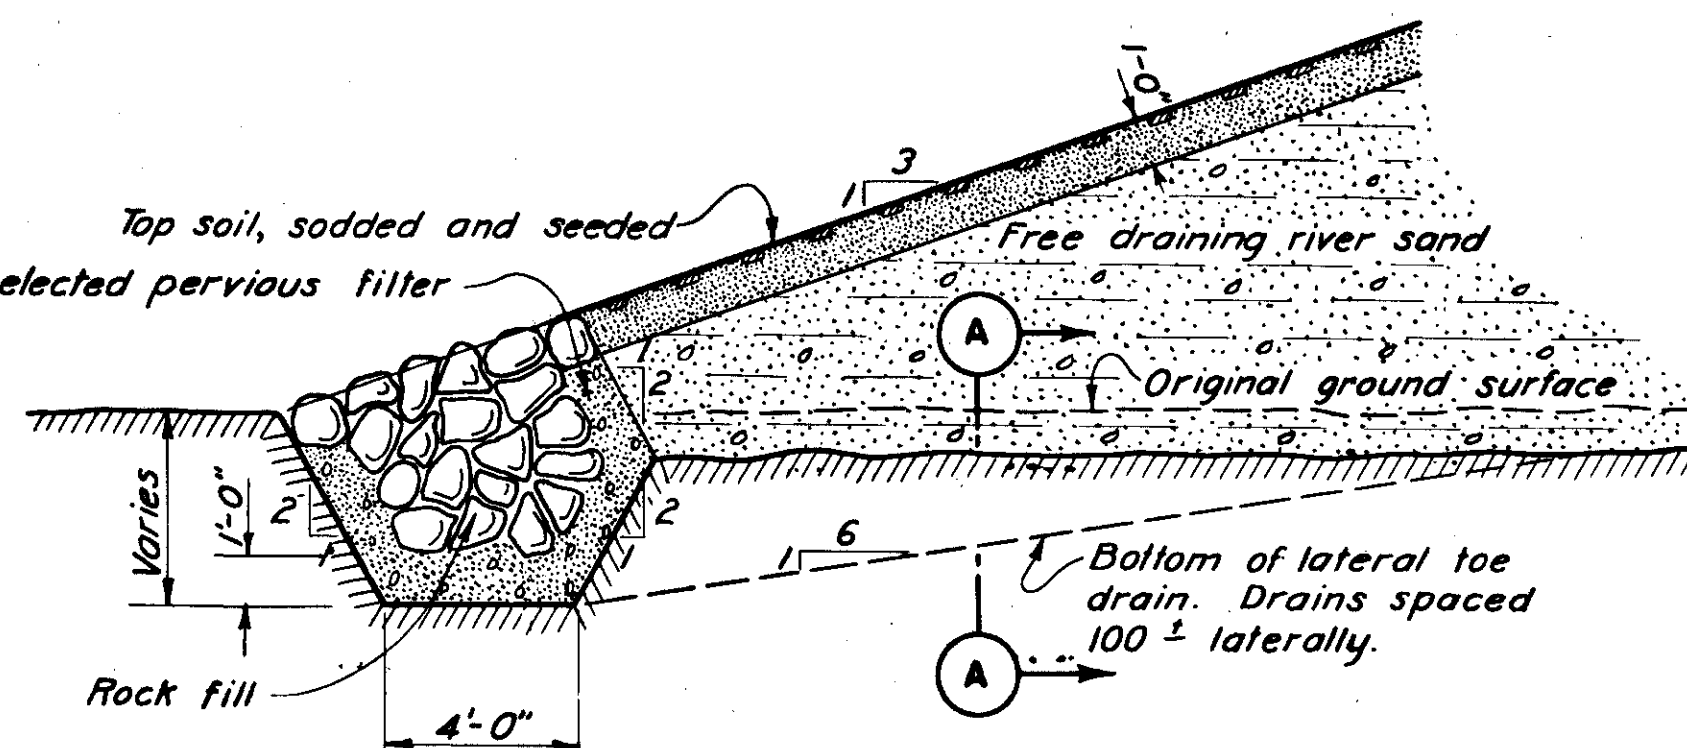

DETAIL OF ROCK TOE DRAIN

SCALE 1/4" = 1'-0"

12-31-45 As built, revision

DETAIL OF TOP OF DIKE

SCALE 1/4" = 1'-0"

0 5 10

SCHEDULE OF 8" V.C. TILE LATERAL DRAIN PIPE			
STATION	LIN. FT.	STATION	LIN. FT.
102+00	38	129+00	24
104+00	50	131+00	16
106+00	50	133+00	28
108+00	50	135+00	40
110+00	46	140+00	38
112+00	48	142+00	38
114+00	46	144+00	34
119+00	56	146+00	38
121+00	54	148+00	34
123+00	50	150+00	38
125+00	50	152+00	34
127+00	50	TOTAL	338

NOTE

Elevations refer to Mean Sea Level Datum.

HARTFORD-W.P.A.-NORTH MEADOWS PROJECT

CONNECTICUT RIVER FLOOD CONTROL

NORTH MEADOWS DIKE
EMBANKMENT DETAILS
HARTFORD, CONN.CONNECTICUT RIVER, CONNECTICUT
1115 SHEETS SCALE 1/4" = 1'-0" SHEET NO. 12

U.S. ENGINEER OFFICE, PROVIDENCE, R. I., OCT. 1938

SUBMITTED: J. J. Osburn, PRINCIPAL ENGINEER
 APPROVED: R. E. Link, CAPT. CORPS OF ENGINEERS
 CHIEF ENGINEERING SECTION
 DESIGNED: M. B. Fisher, SENIOR ENGINEER
 DRAWN BY: M. B. M.
 TRACED BY: H. E. W.
 FILE NO. CT-4-1118
 TO ACCOMPANY SPECIFICATIONS
 DATED OCT. 1, 1938