



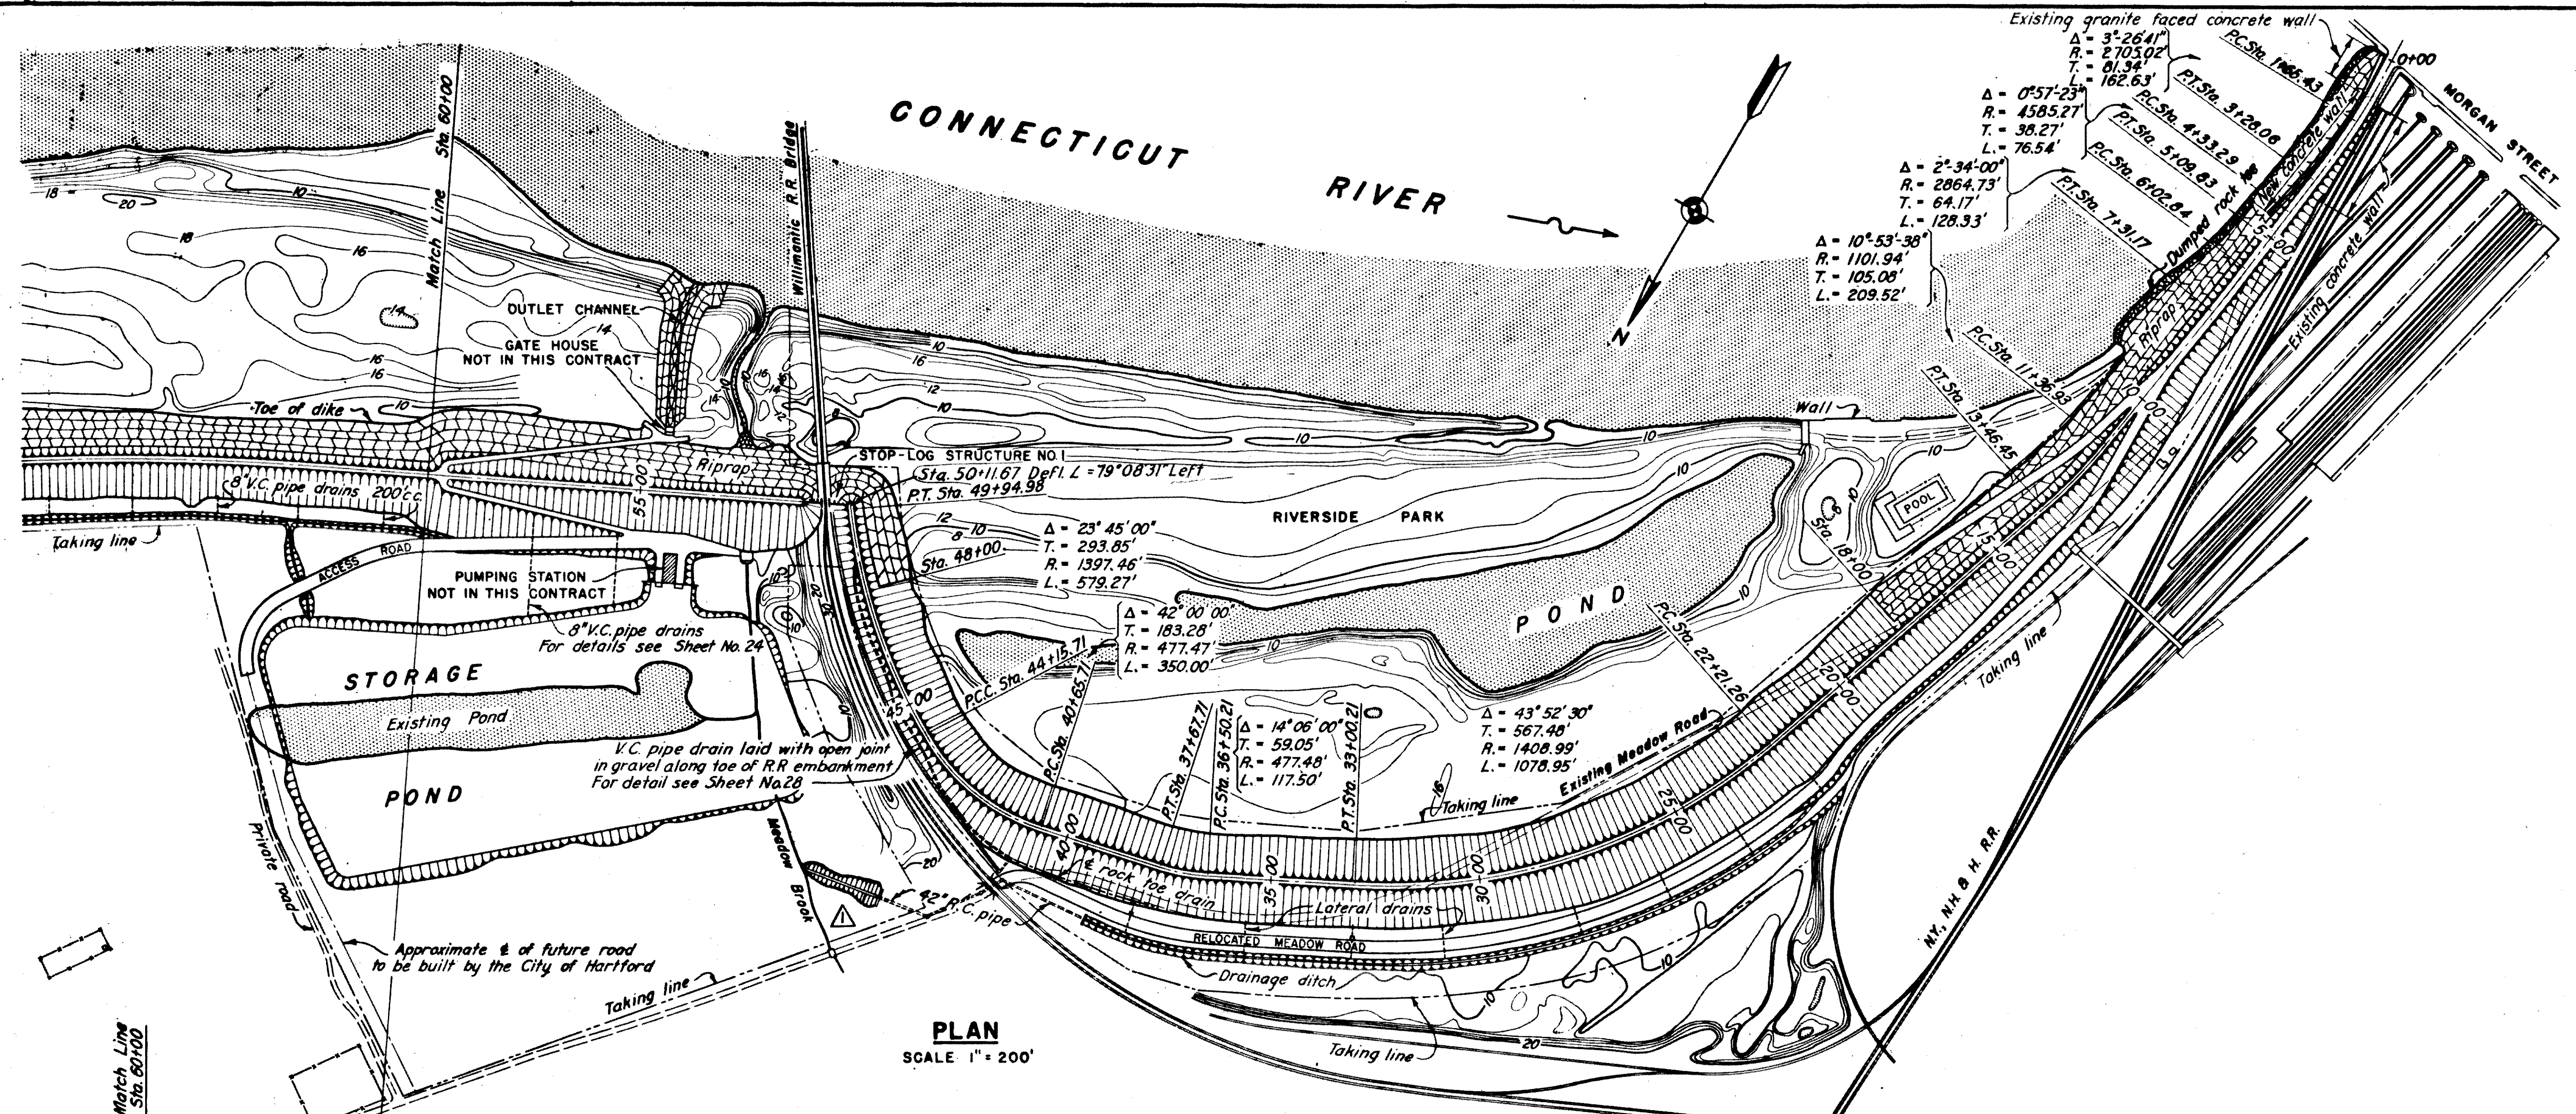

PLAN
SCALE: 1" = 200'

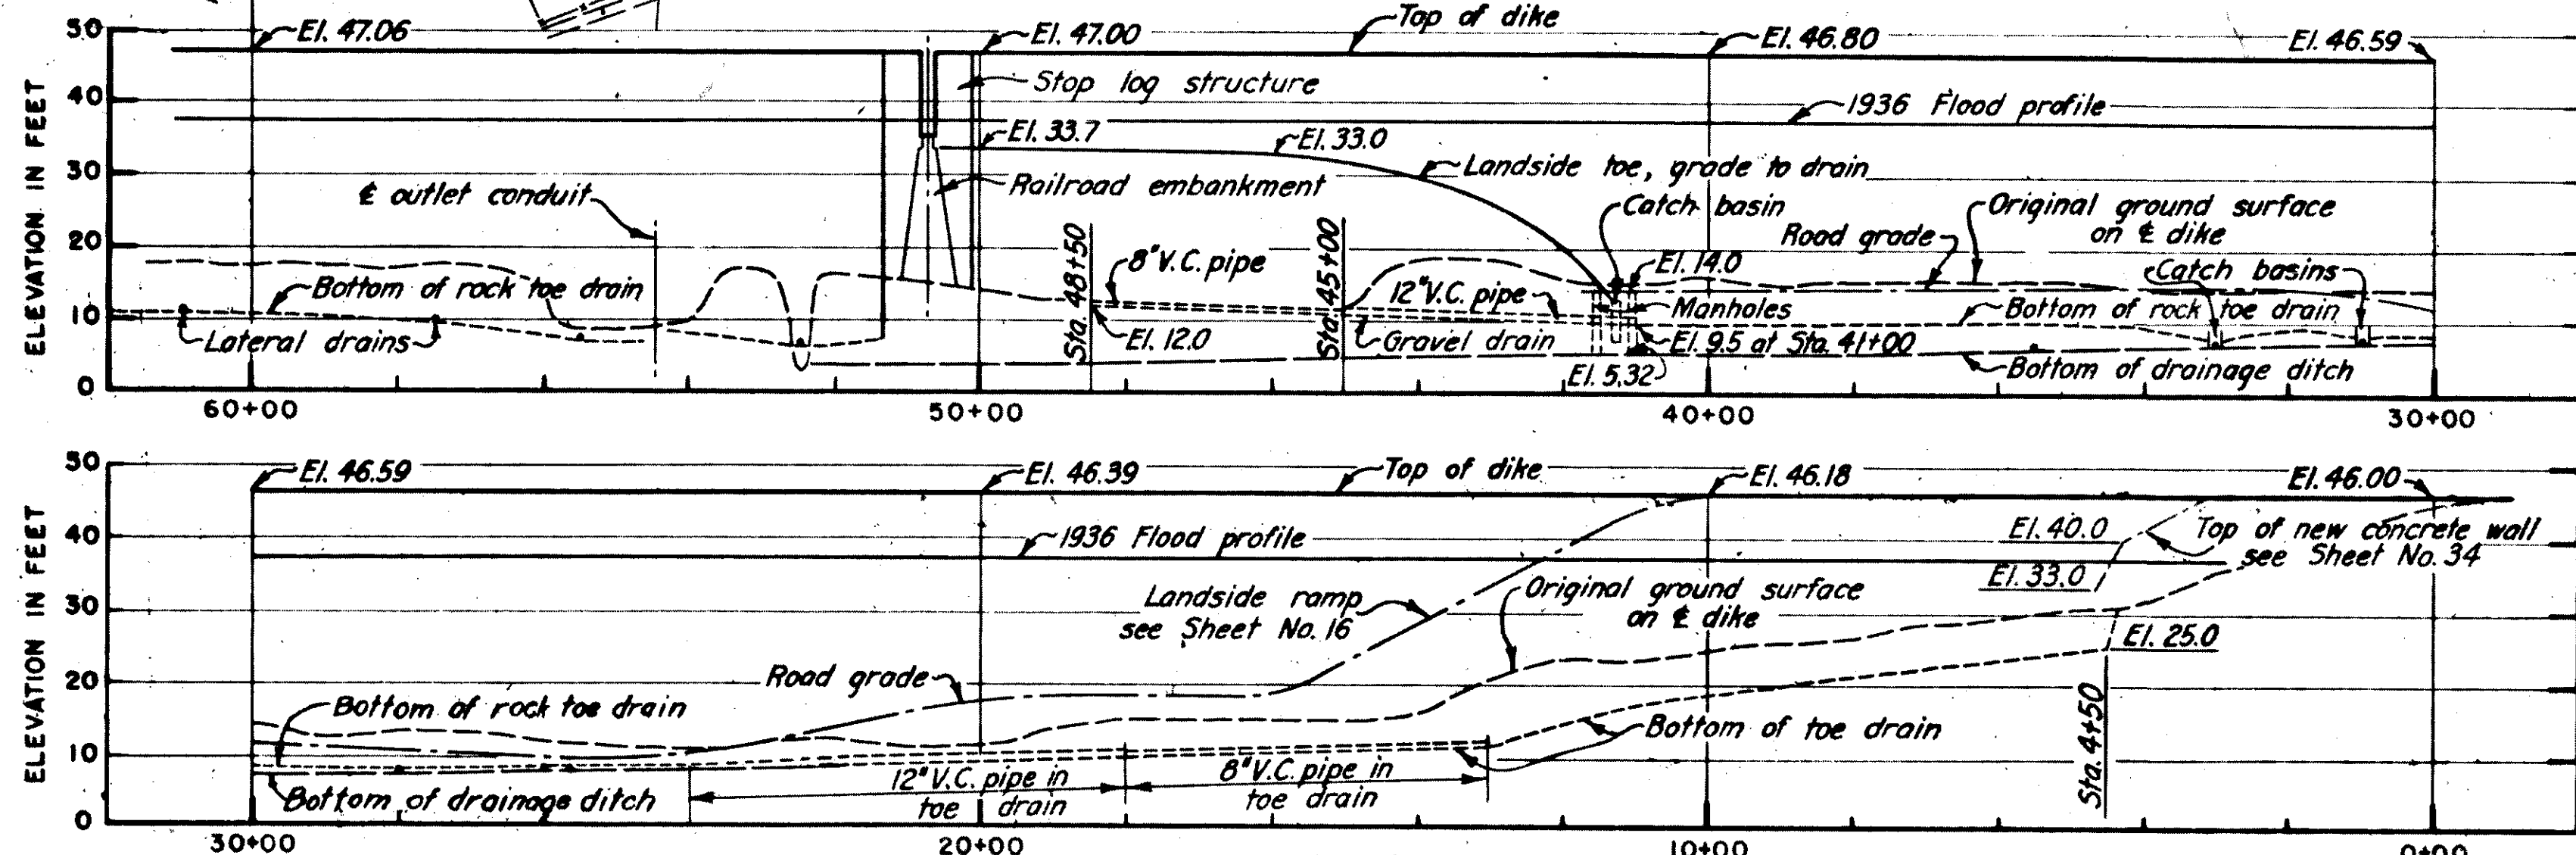

PROFILE ALONG E DIKE

SCALE: HOR. 1" = 200'
VERT. 1" = 20'

12-31-45	As-Built Revisions			
7-27-39	42" drain relocated	98	164	280
KEY	DATE	REVISION (indicated by Δ)	REV. BY	CK. BY
				APBY