



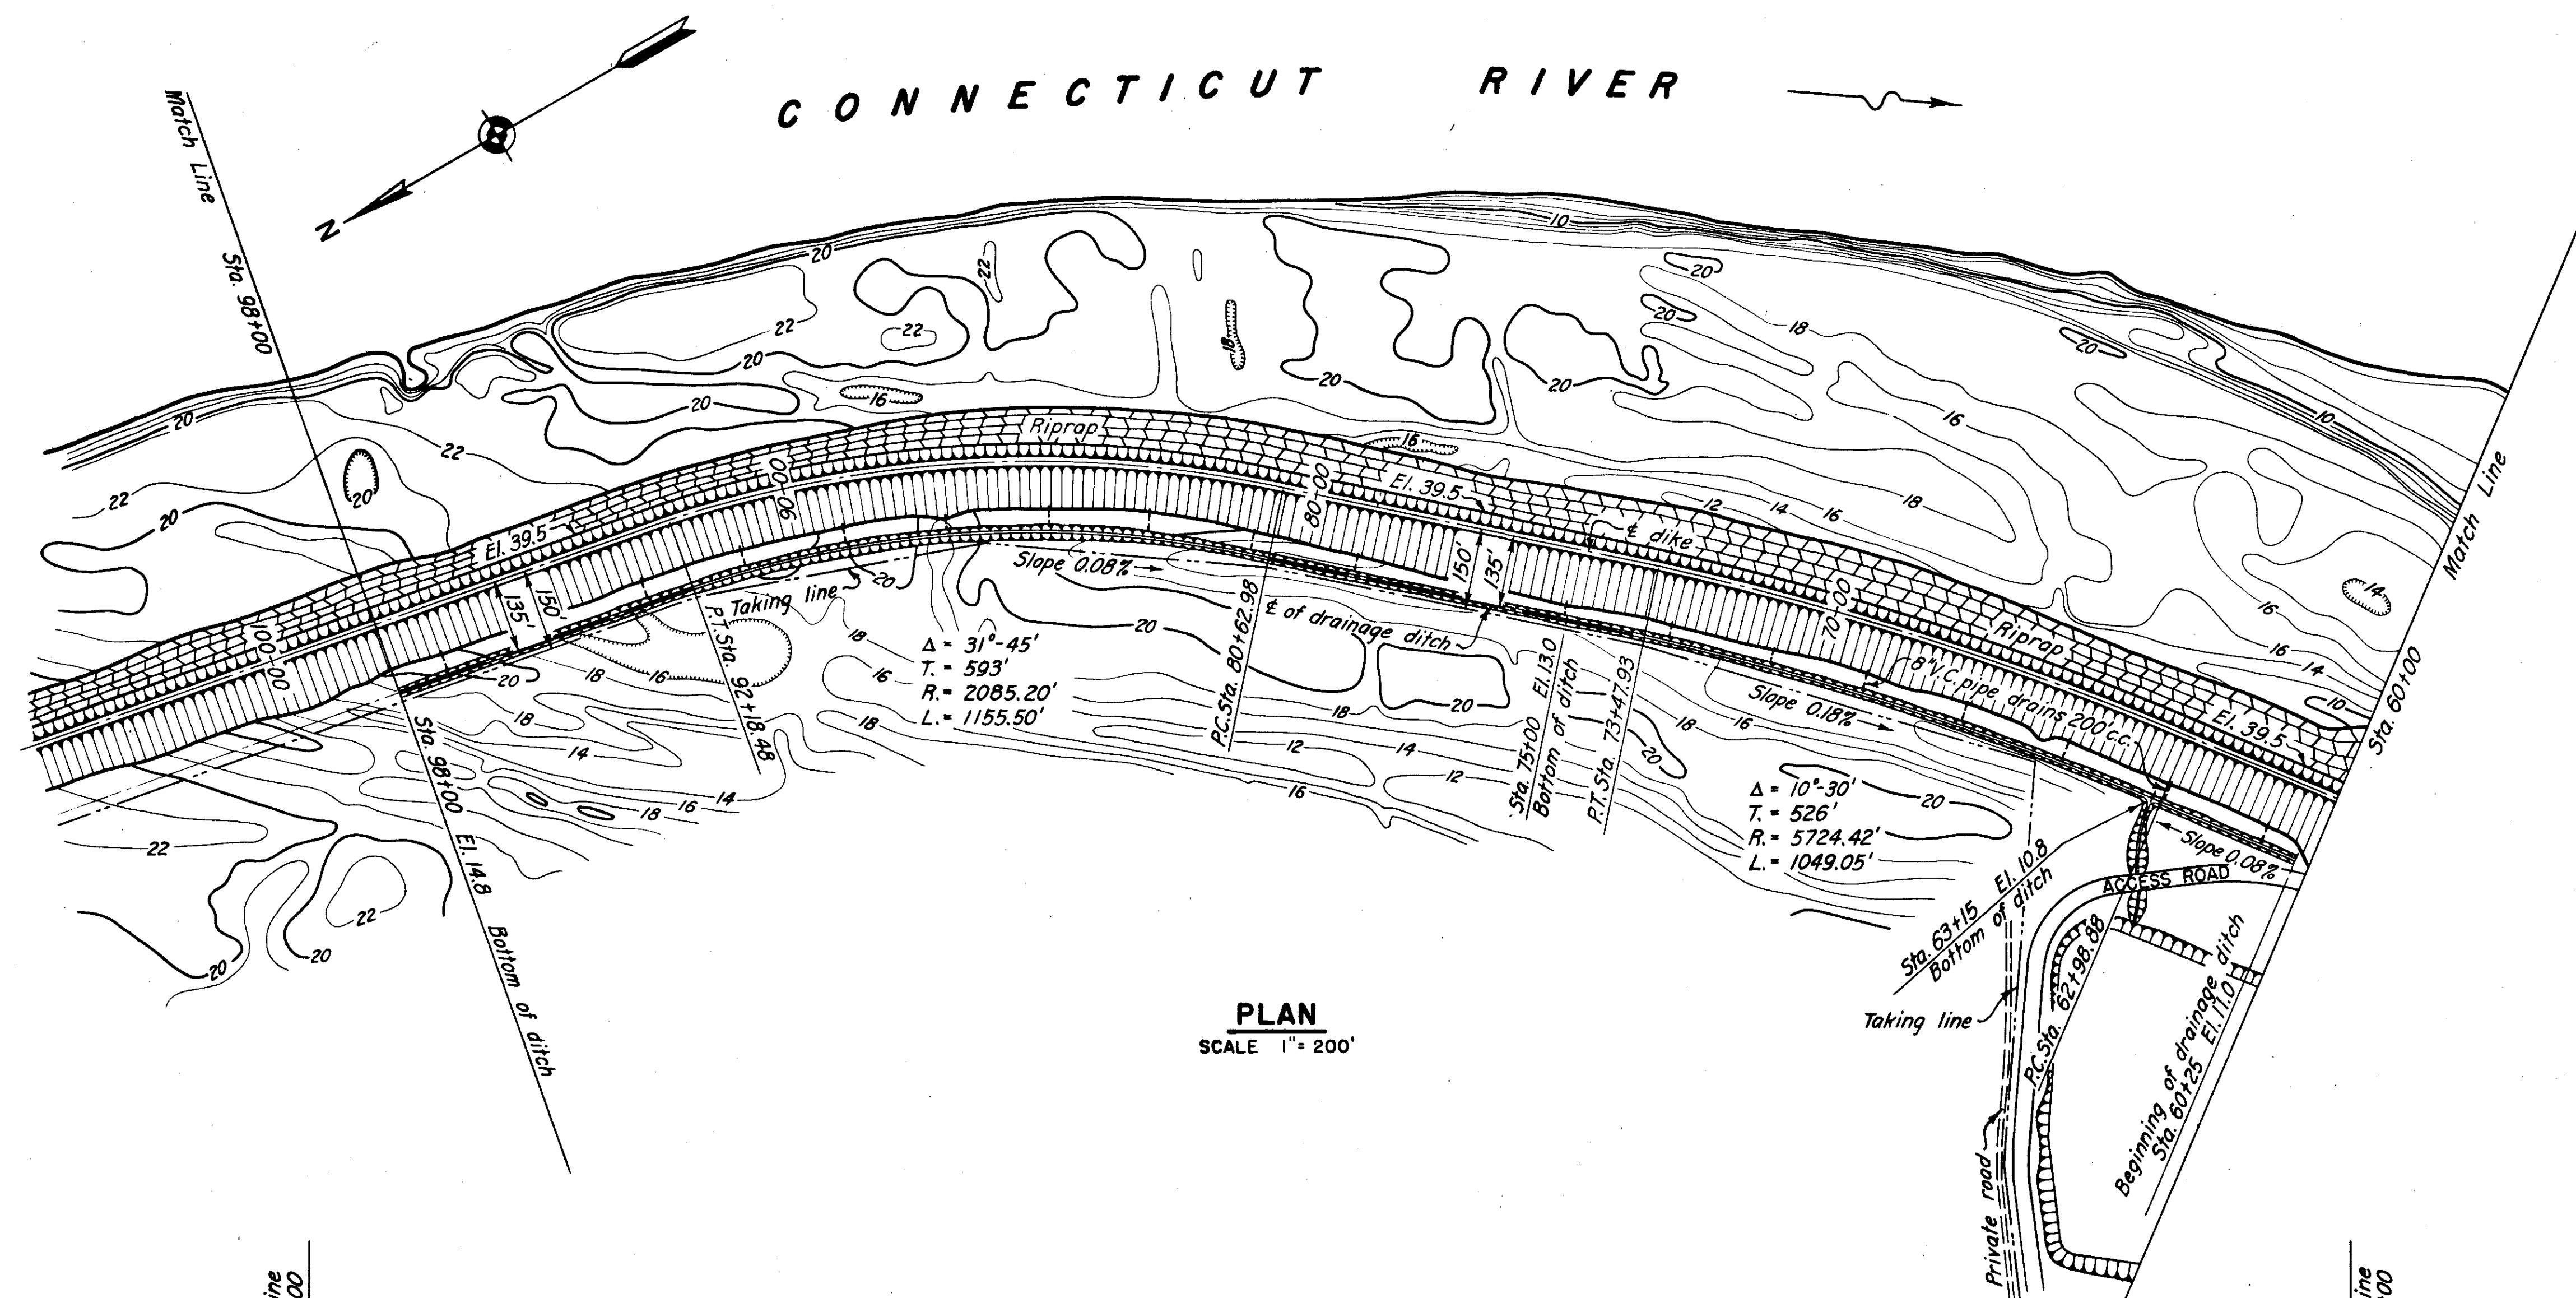

PLAN
SCALE 1" = 200'

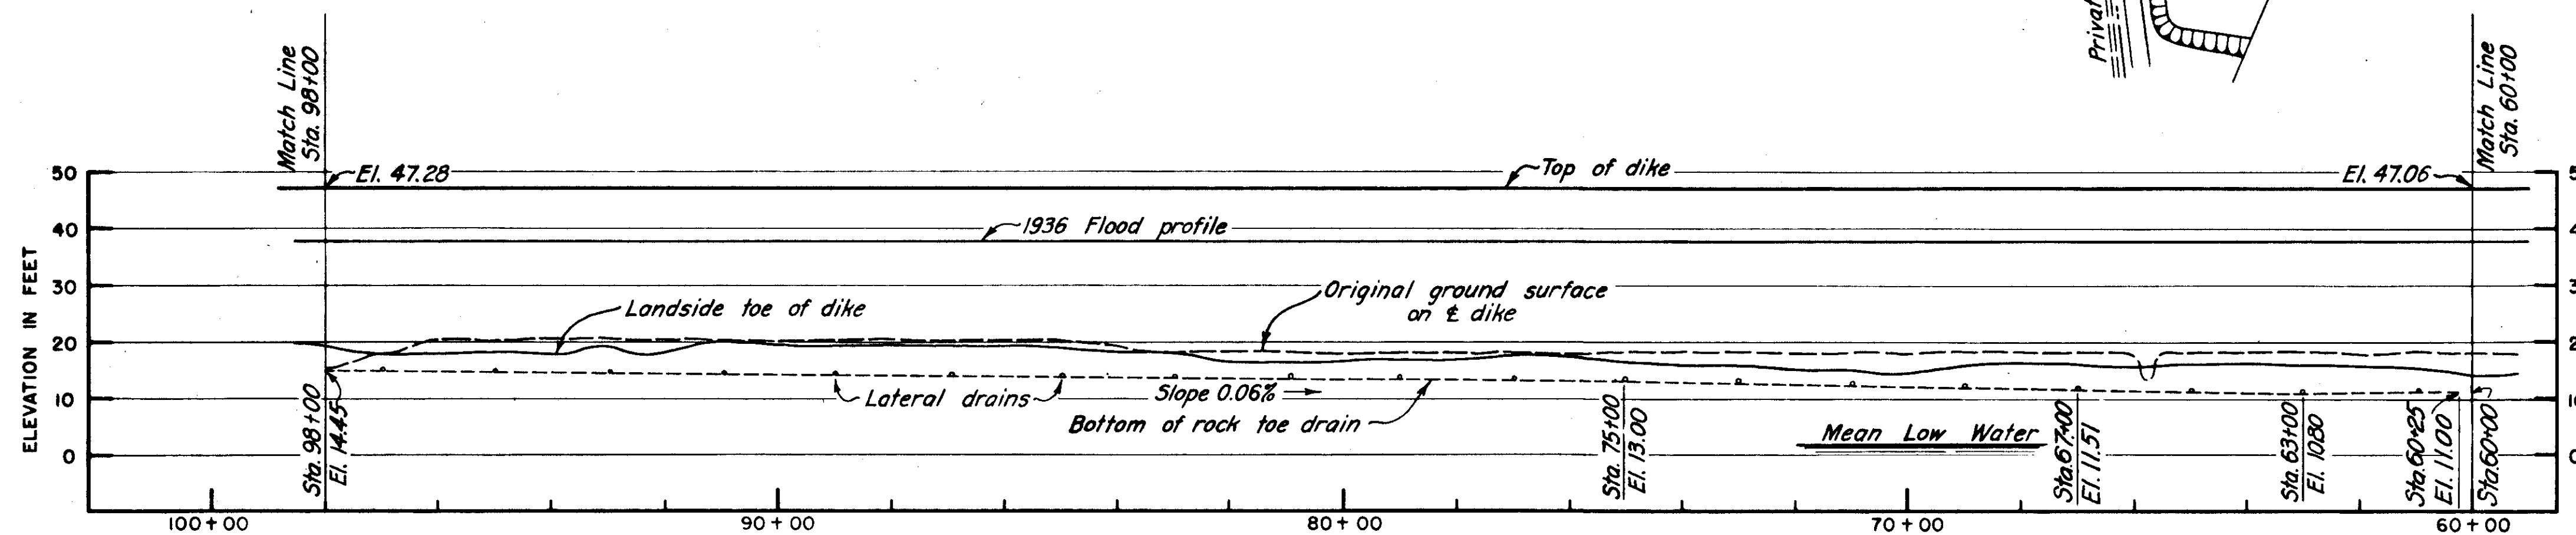

PROFILE ALONG DIKE

SCALE: HOR. 1" = 200'
VERT. 1" = 20'

NOTE:

For general notes applying to details shown on this sheet see Sheet No. 12

SCHEDULE OF 8" V.C. LATERAL TILE DRAINS

STATION	LIN. FT.
3+83	76
24+00	74
26+00	78
28+00	78
31+00	86
33+00	22
35+50	88
38+00	26
52+40	58
55+50	198
57+50	242
61+00	38
63+00	38
65+00	42
67+00	40
69+00	40
71+00	40
73+00	36
75+00	36
77+00	40
79+00	38
81+00	38
83+00	46
85+00	46
87+00	46
89+00	48
91+00	54
93+00	50
95+00	42
97+00	44
102+00	38
104+00	50
106+00	50
108+00	50
110+00	46
112+00	48
114+00	46
119+00	56
121+00	54
123+00	50
125+00	50
127+00	50
129+00	24
131+00	30
133+00	26
135+00	42
140+00	36
142+00	36
144+00	36
146+00	40
148+00	36
150+00	36
152+00	36

CONNECTICUT RIVER FLOOD CONTROL

NORTH MEADOWS DIKE

FISCAL YEAR 1939 SECTION

GENERAL PLAN NO. 2

HARTFORD, CONN.

CONNECTICUT RIVER

CONNECTICUT

IN 66 SHEETS

SCALE 1 IN. = 200 FT.

SHEET NO. 13

U. S. ENGINEER OFFICE, PROVIDENCE, R. I., APRIL, 1939

SUBMITTED: *Wm. B. Niles*APPROVAL RECOMMENDED: *J. B. Burns*APPROVED: *J. B. Burns*

SENIOR ENGINEER

PRINCIPAL ENGINEER

COL., CORPS OF ENGINEERS

HEAD DESIGN SECTION

CHIEF F. C. ENGINEERING DIV.

DISTRICT ENGINEER

DESIGNED: *J. Hartley*

DRAWN: M. B. ME. & P. D.

FILE NO. CT-4-1442

CHECKED: *W. B. Niles*

L. P. D.

CHECKED: *W. B. Niles*

DATE	REVISION	REV. BY	CH. BY	AP. BY
12-31-45	As Built Revisions			