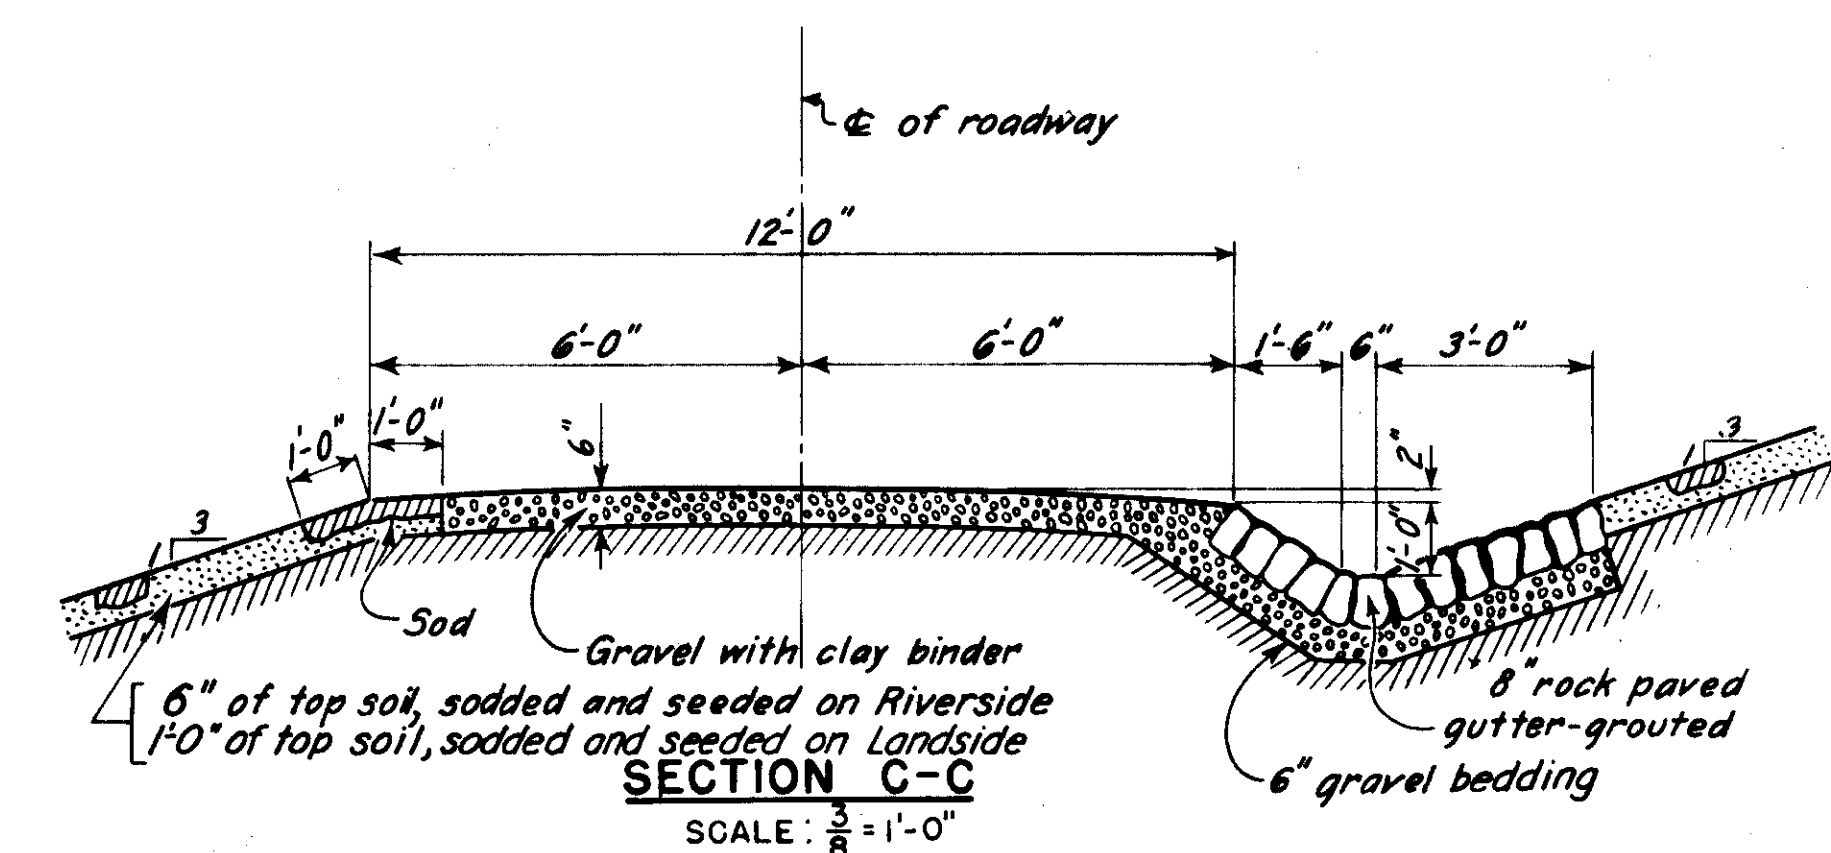
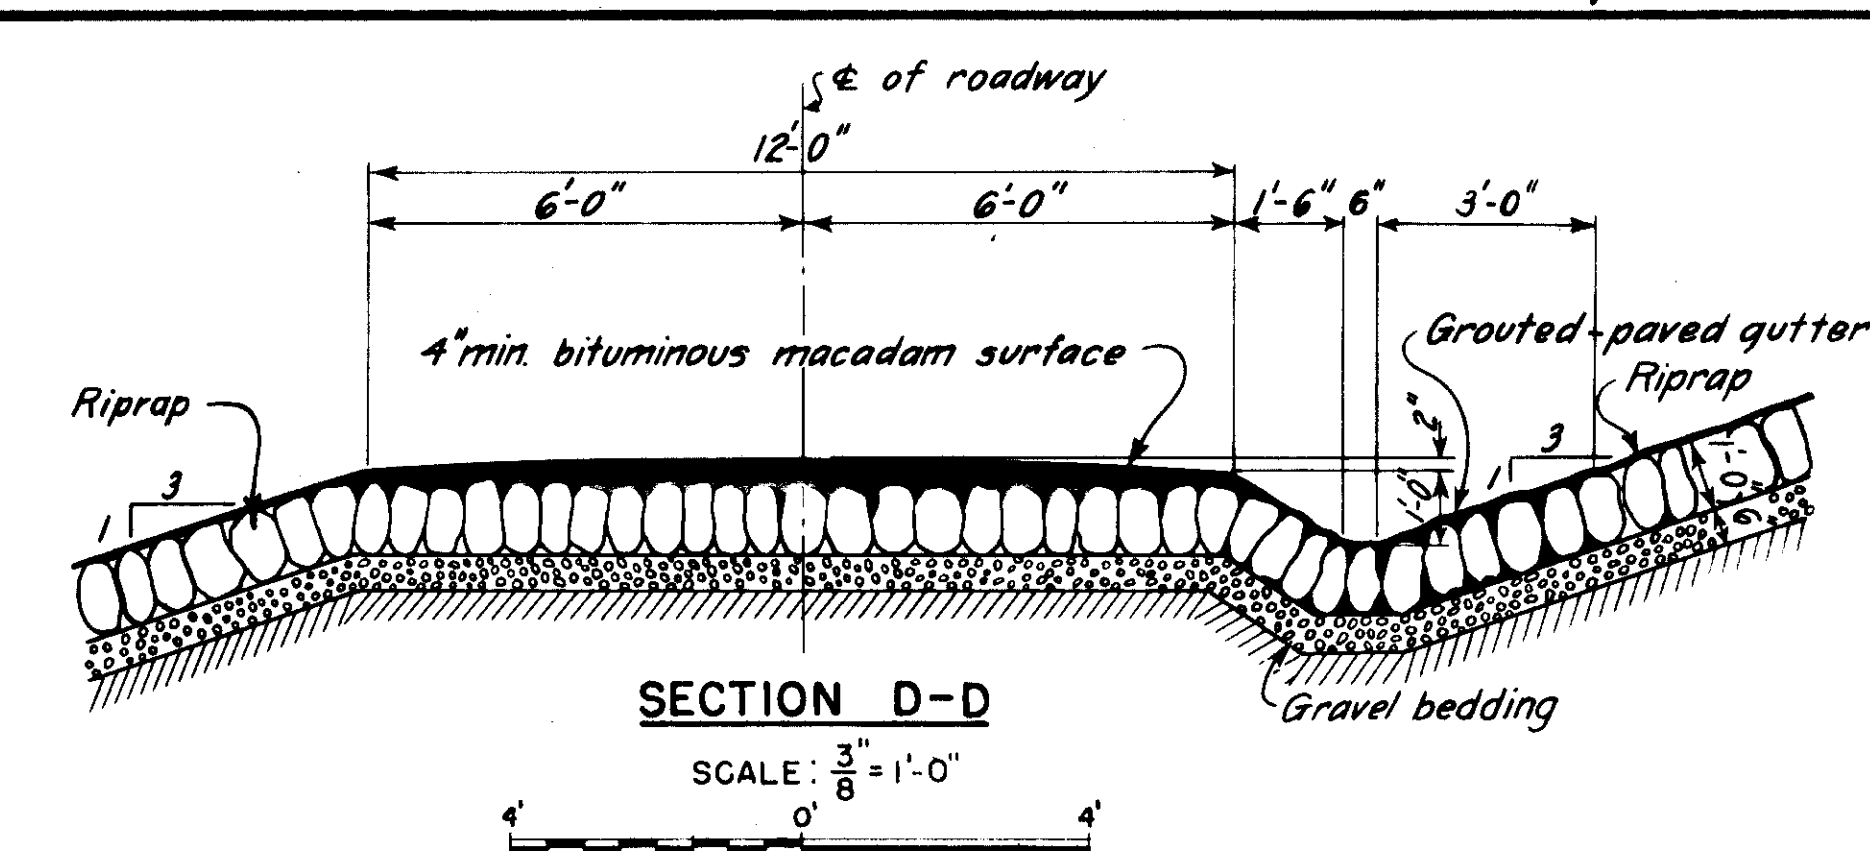
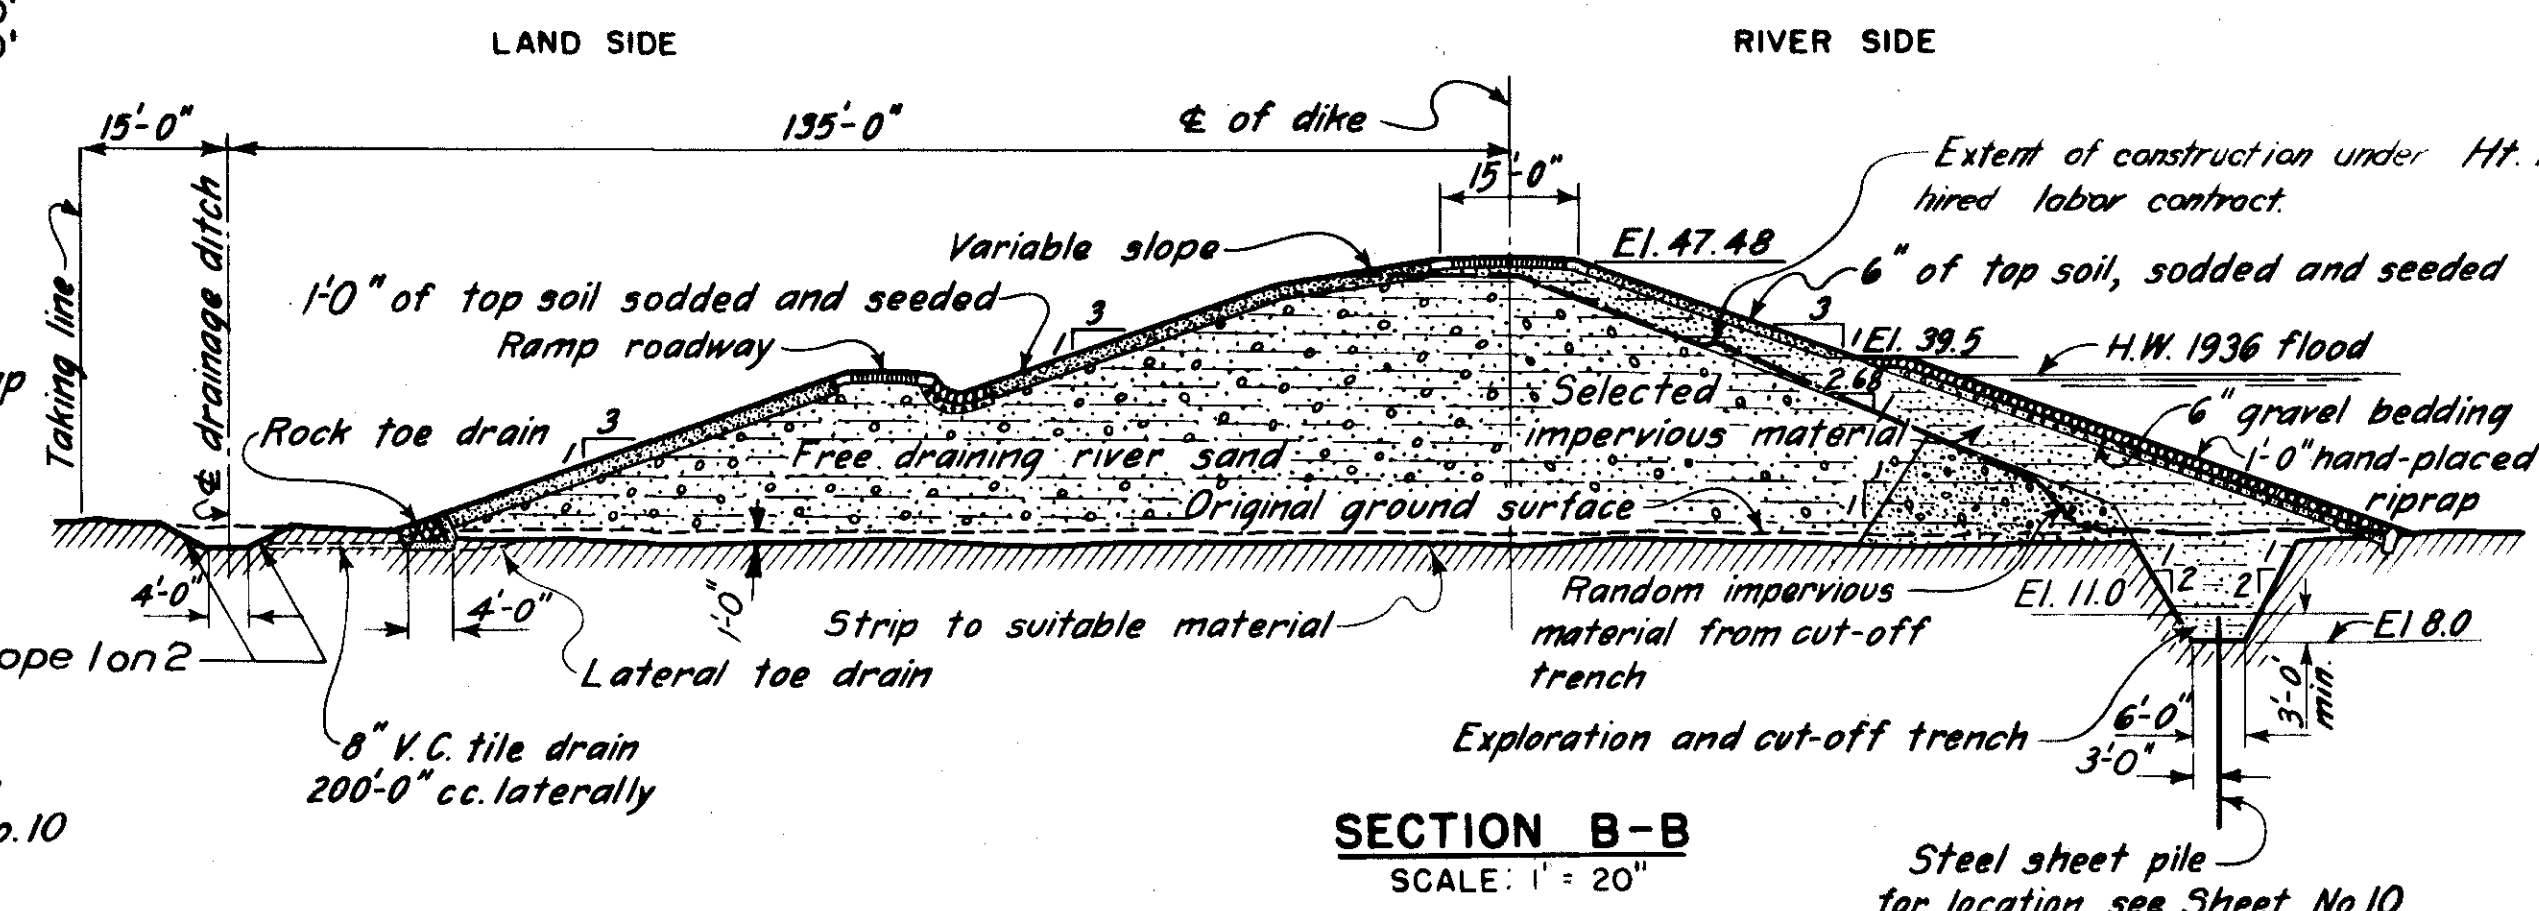
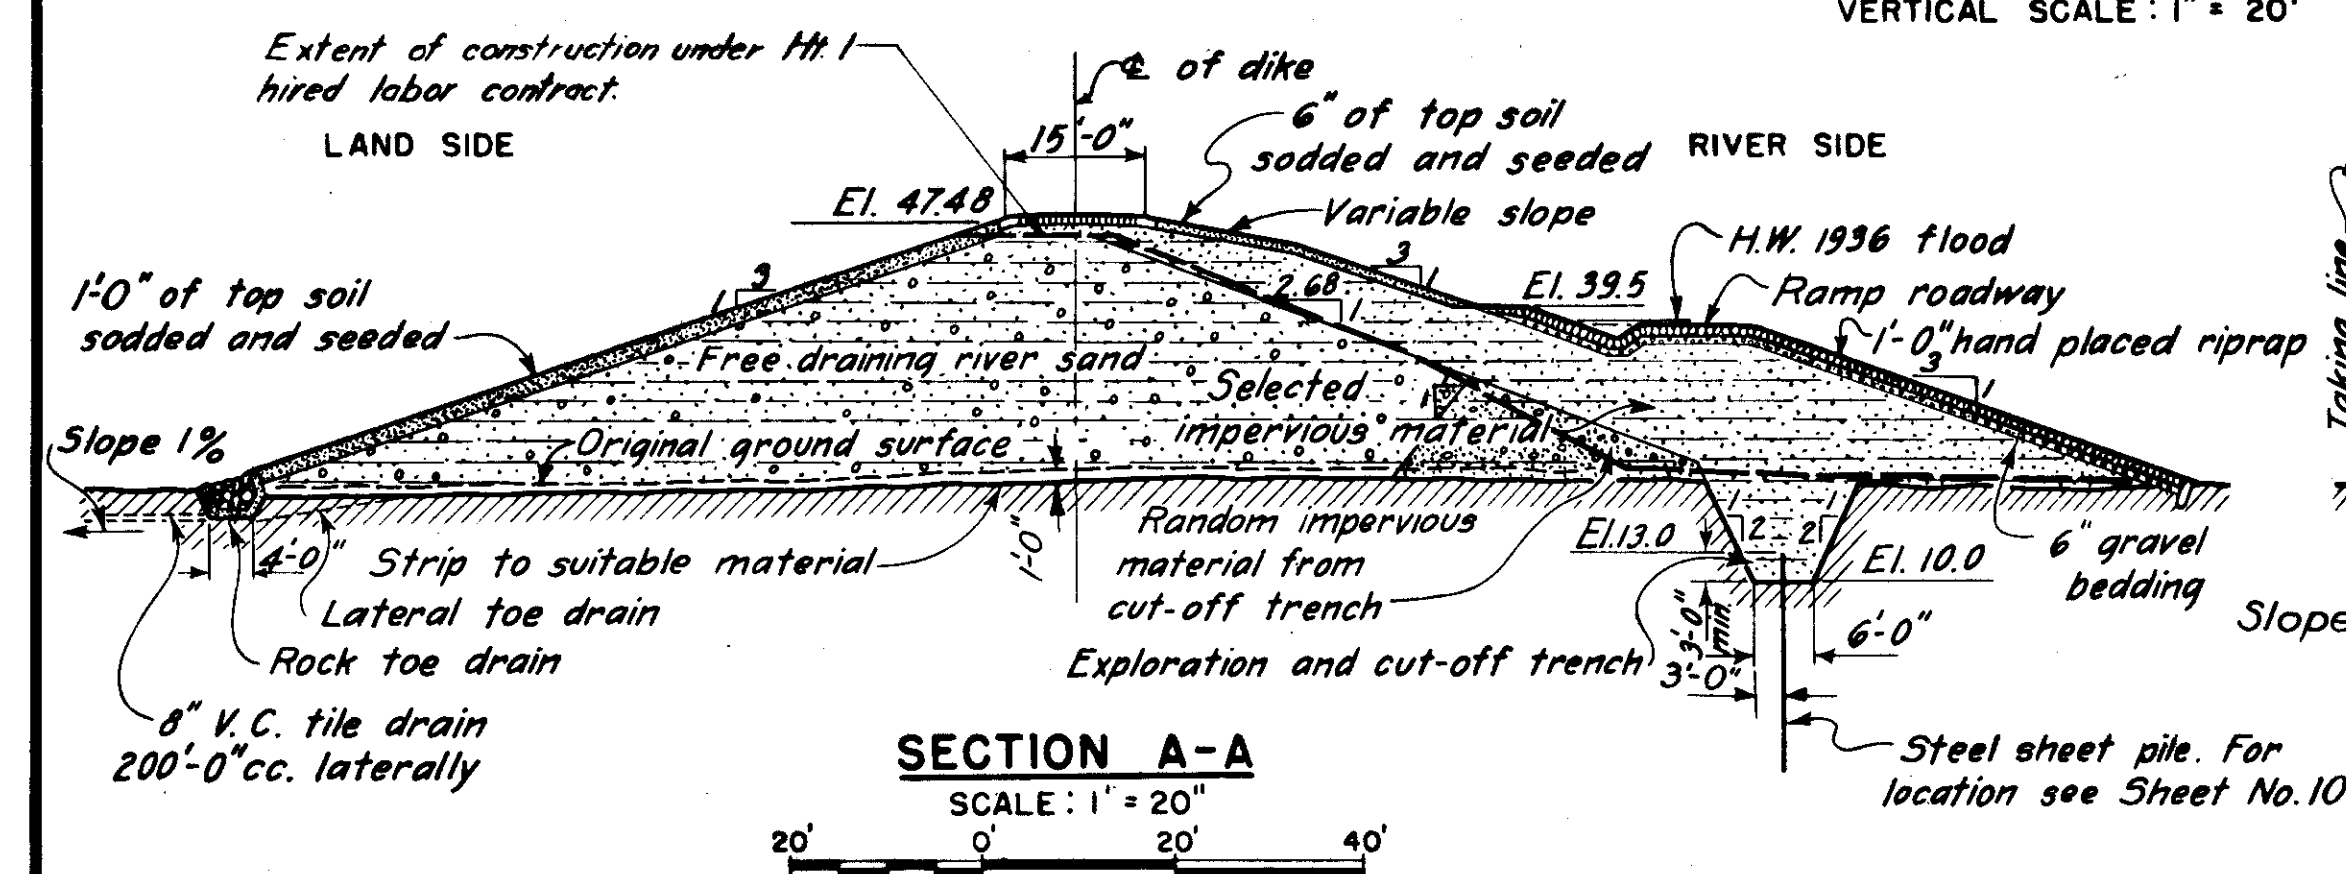
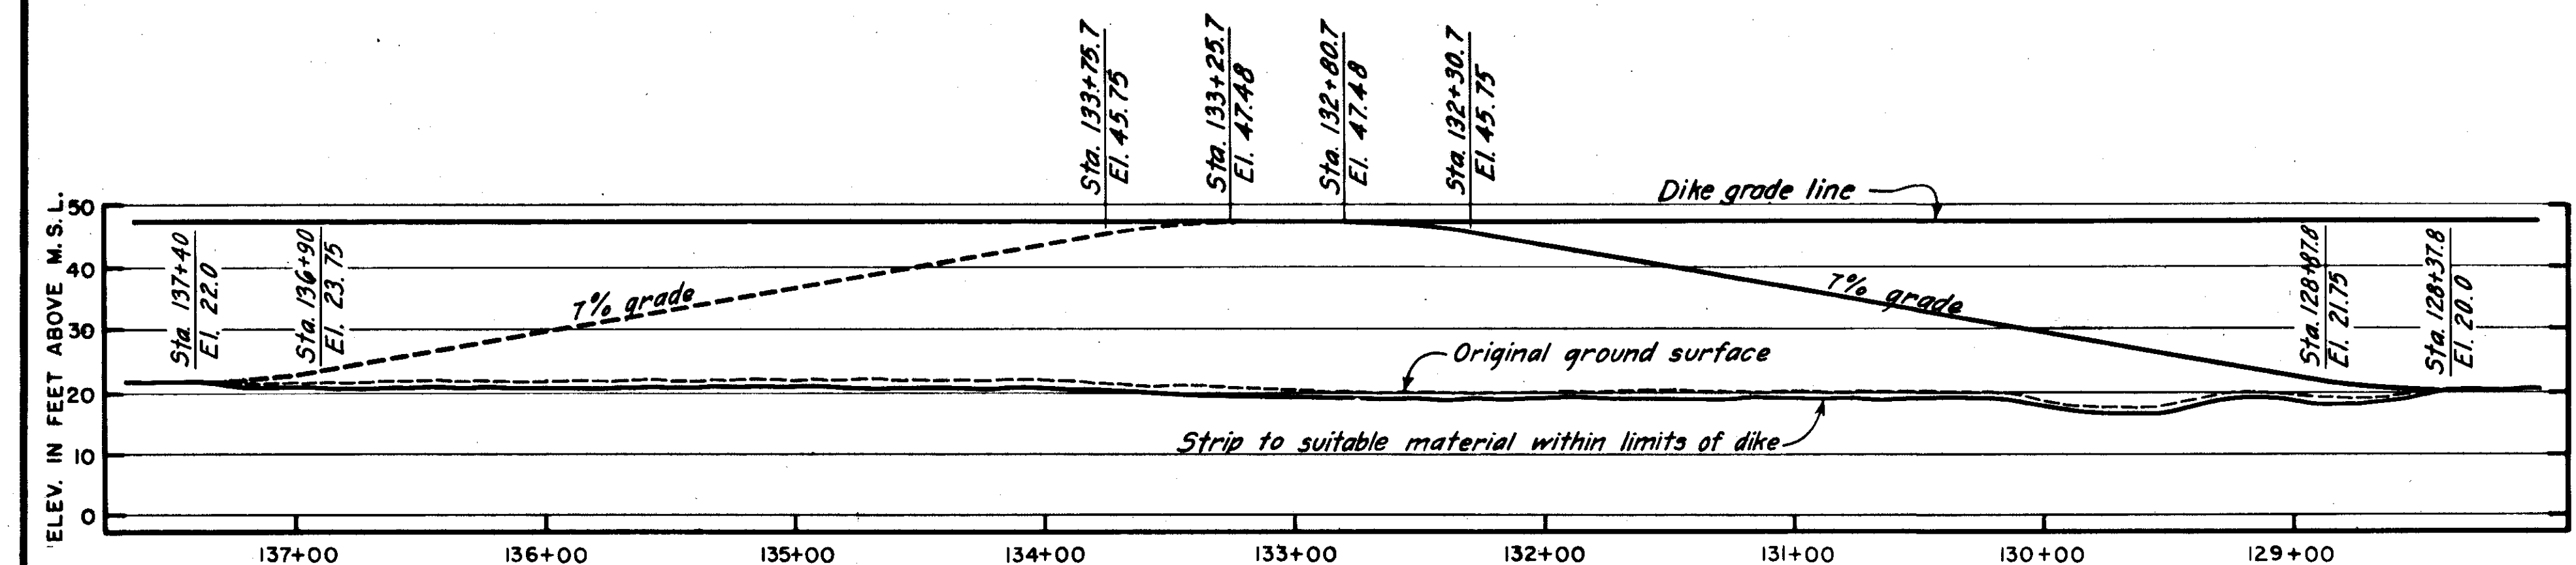
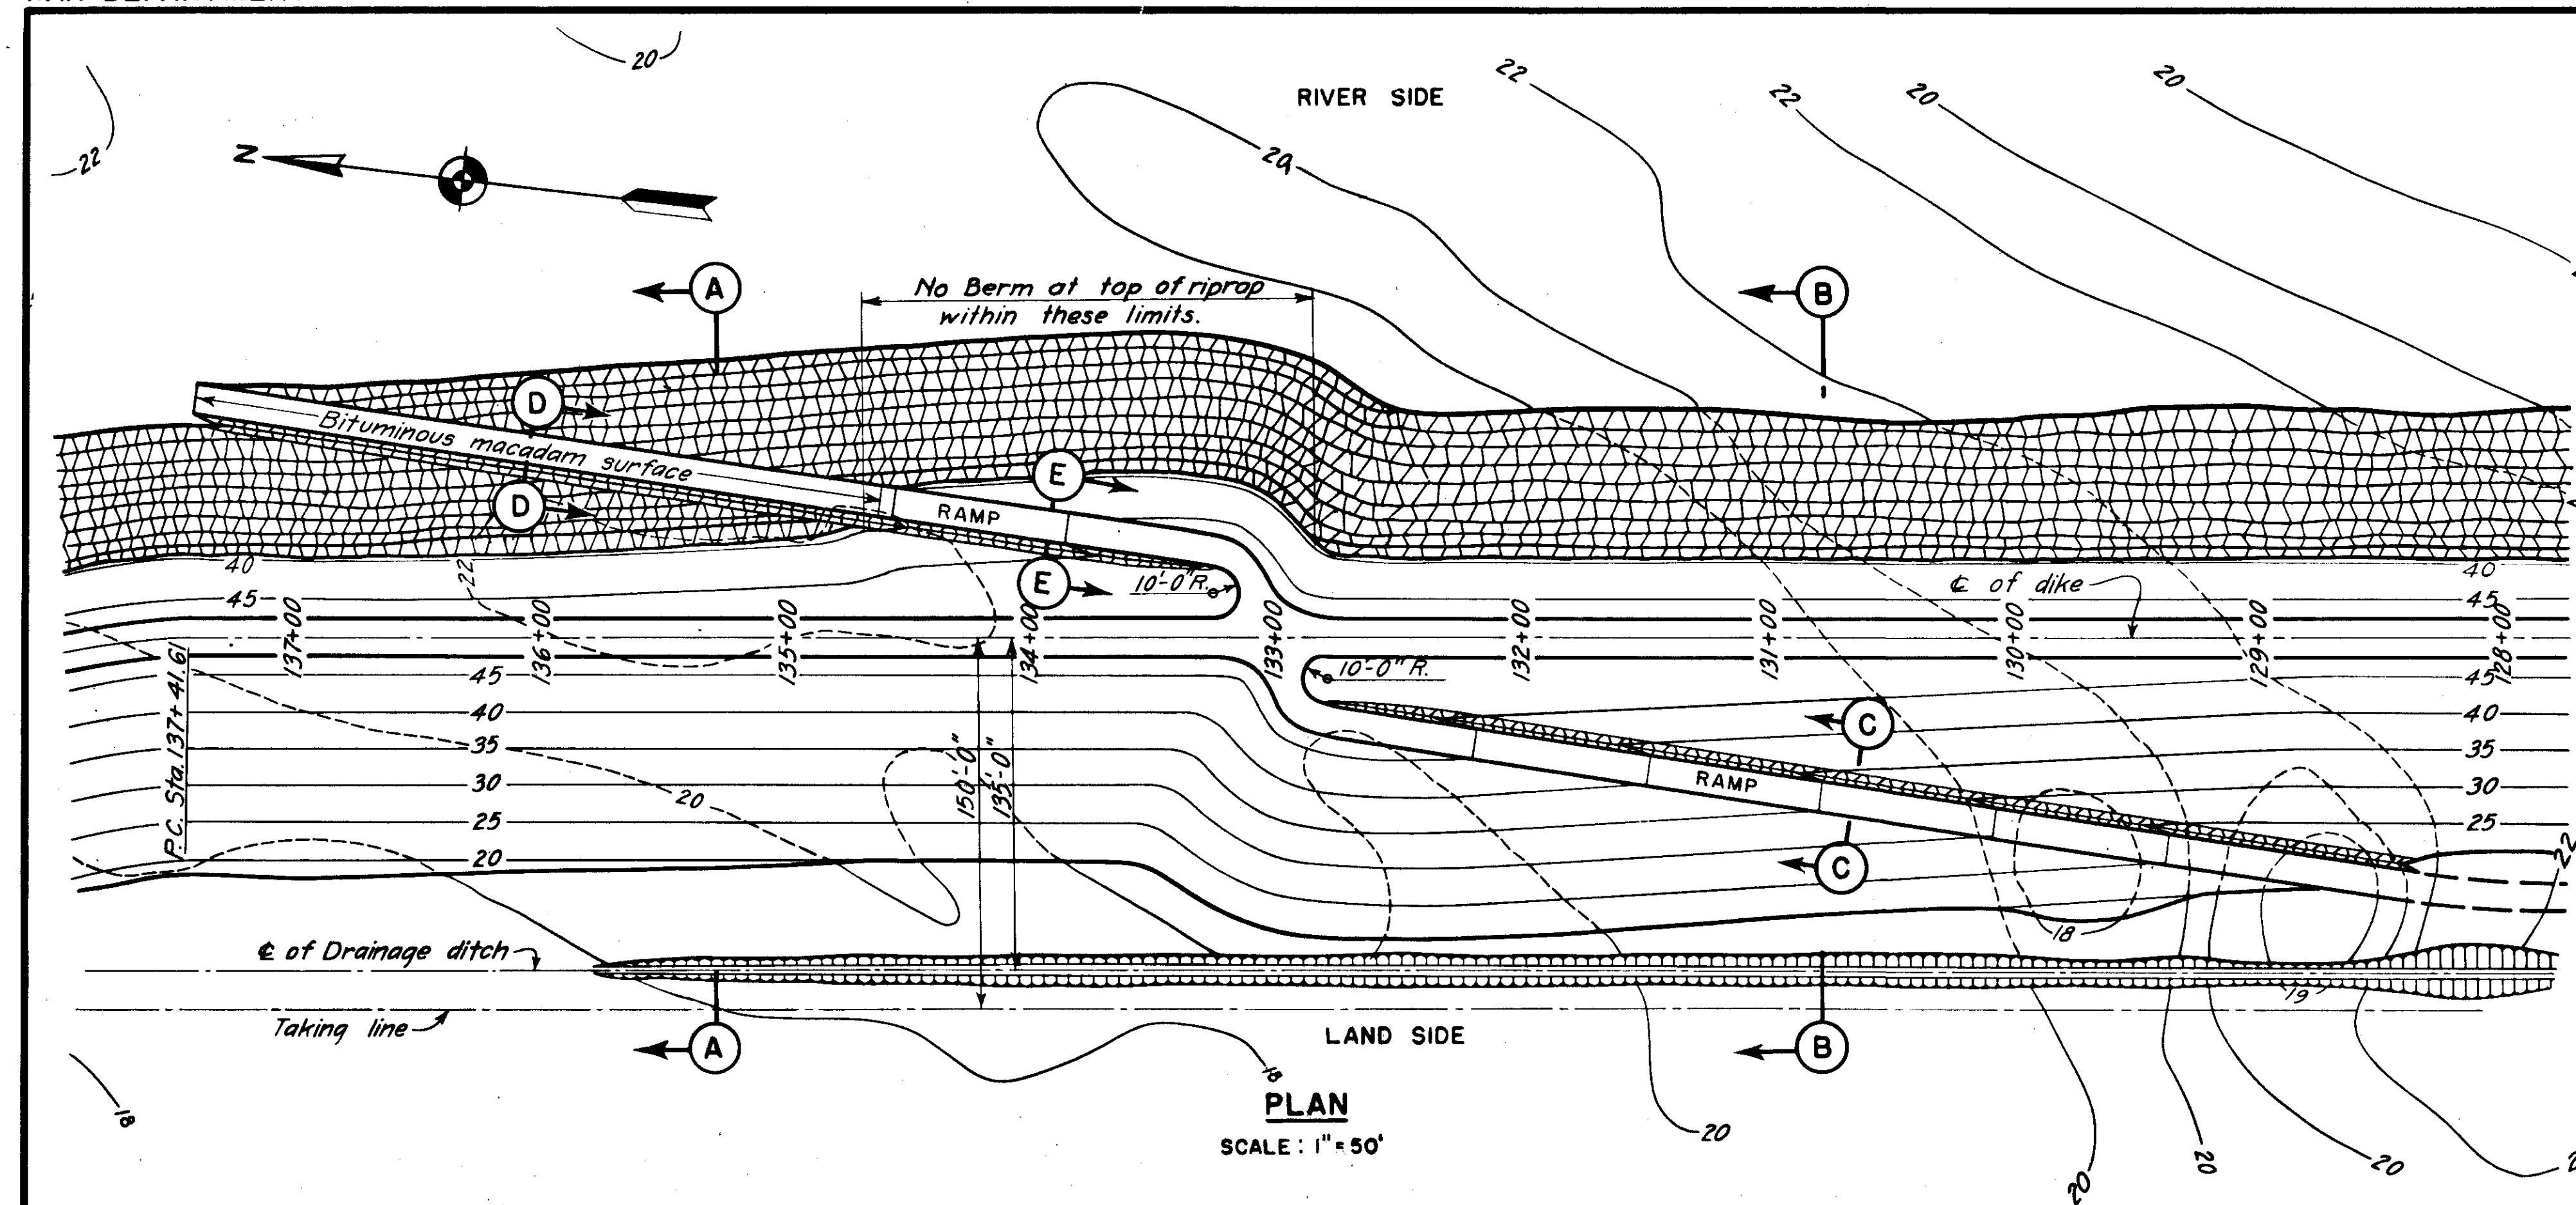


**NOTES**

Elevations refer to Mean Sea Level datum.
For Section E-E see Sheet No. 14.

12-31-45 As built, revisions

HARTFORD-W.P.A.-NORTH MEADOWS PROJECT

CONNECTICUT RIVER FLOOD CONTROL

NORTH MEADOWS DIKE**RAMPS, NO. 1****HARTFORD, CONN.**

CONNECTICUT RIVER, CONNECTICUT

IN 15 SHEETS SCALE: 1" = 50' FT SHEET NO. 13

U. S. ENGINEER OFFICE, PROVIDENCE, R. I., OCT. 1938

SUBMITTED: J. S. Burns APPROVED: R. B. McKee

PRINCIPAL ENGINEER CAPT. CORPS OF ENGINEERS LT. COL. CORPS OF ENGINEERS

CHIEF ENGINEERING SECTION CHIEF FLOOD CONTROL DIV. DISTRICT ENGINEER

DESIGNED: Harold B. Nelson TO ACCOMPANY SPECIFICATIONS FILE NO. CT-4-1119

SENIOR ENGINEER CHECKED BY: J. H. D. I. C. W. DATED: OCT. 1, 1938