



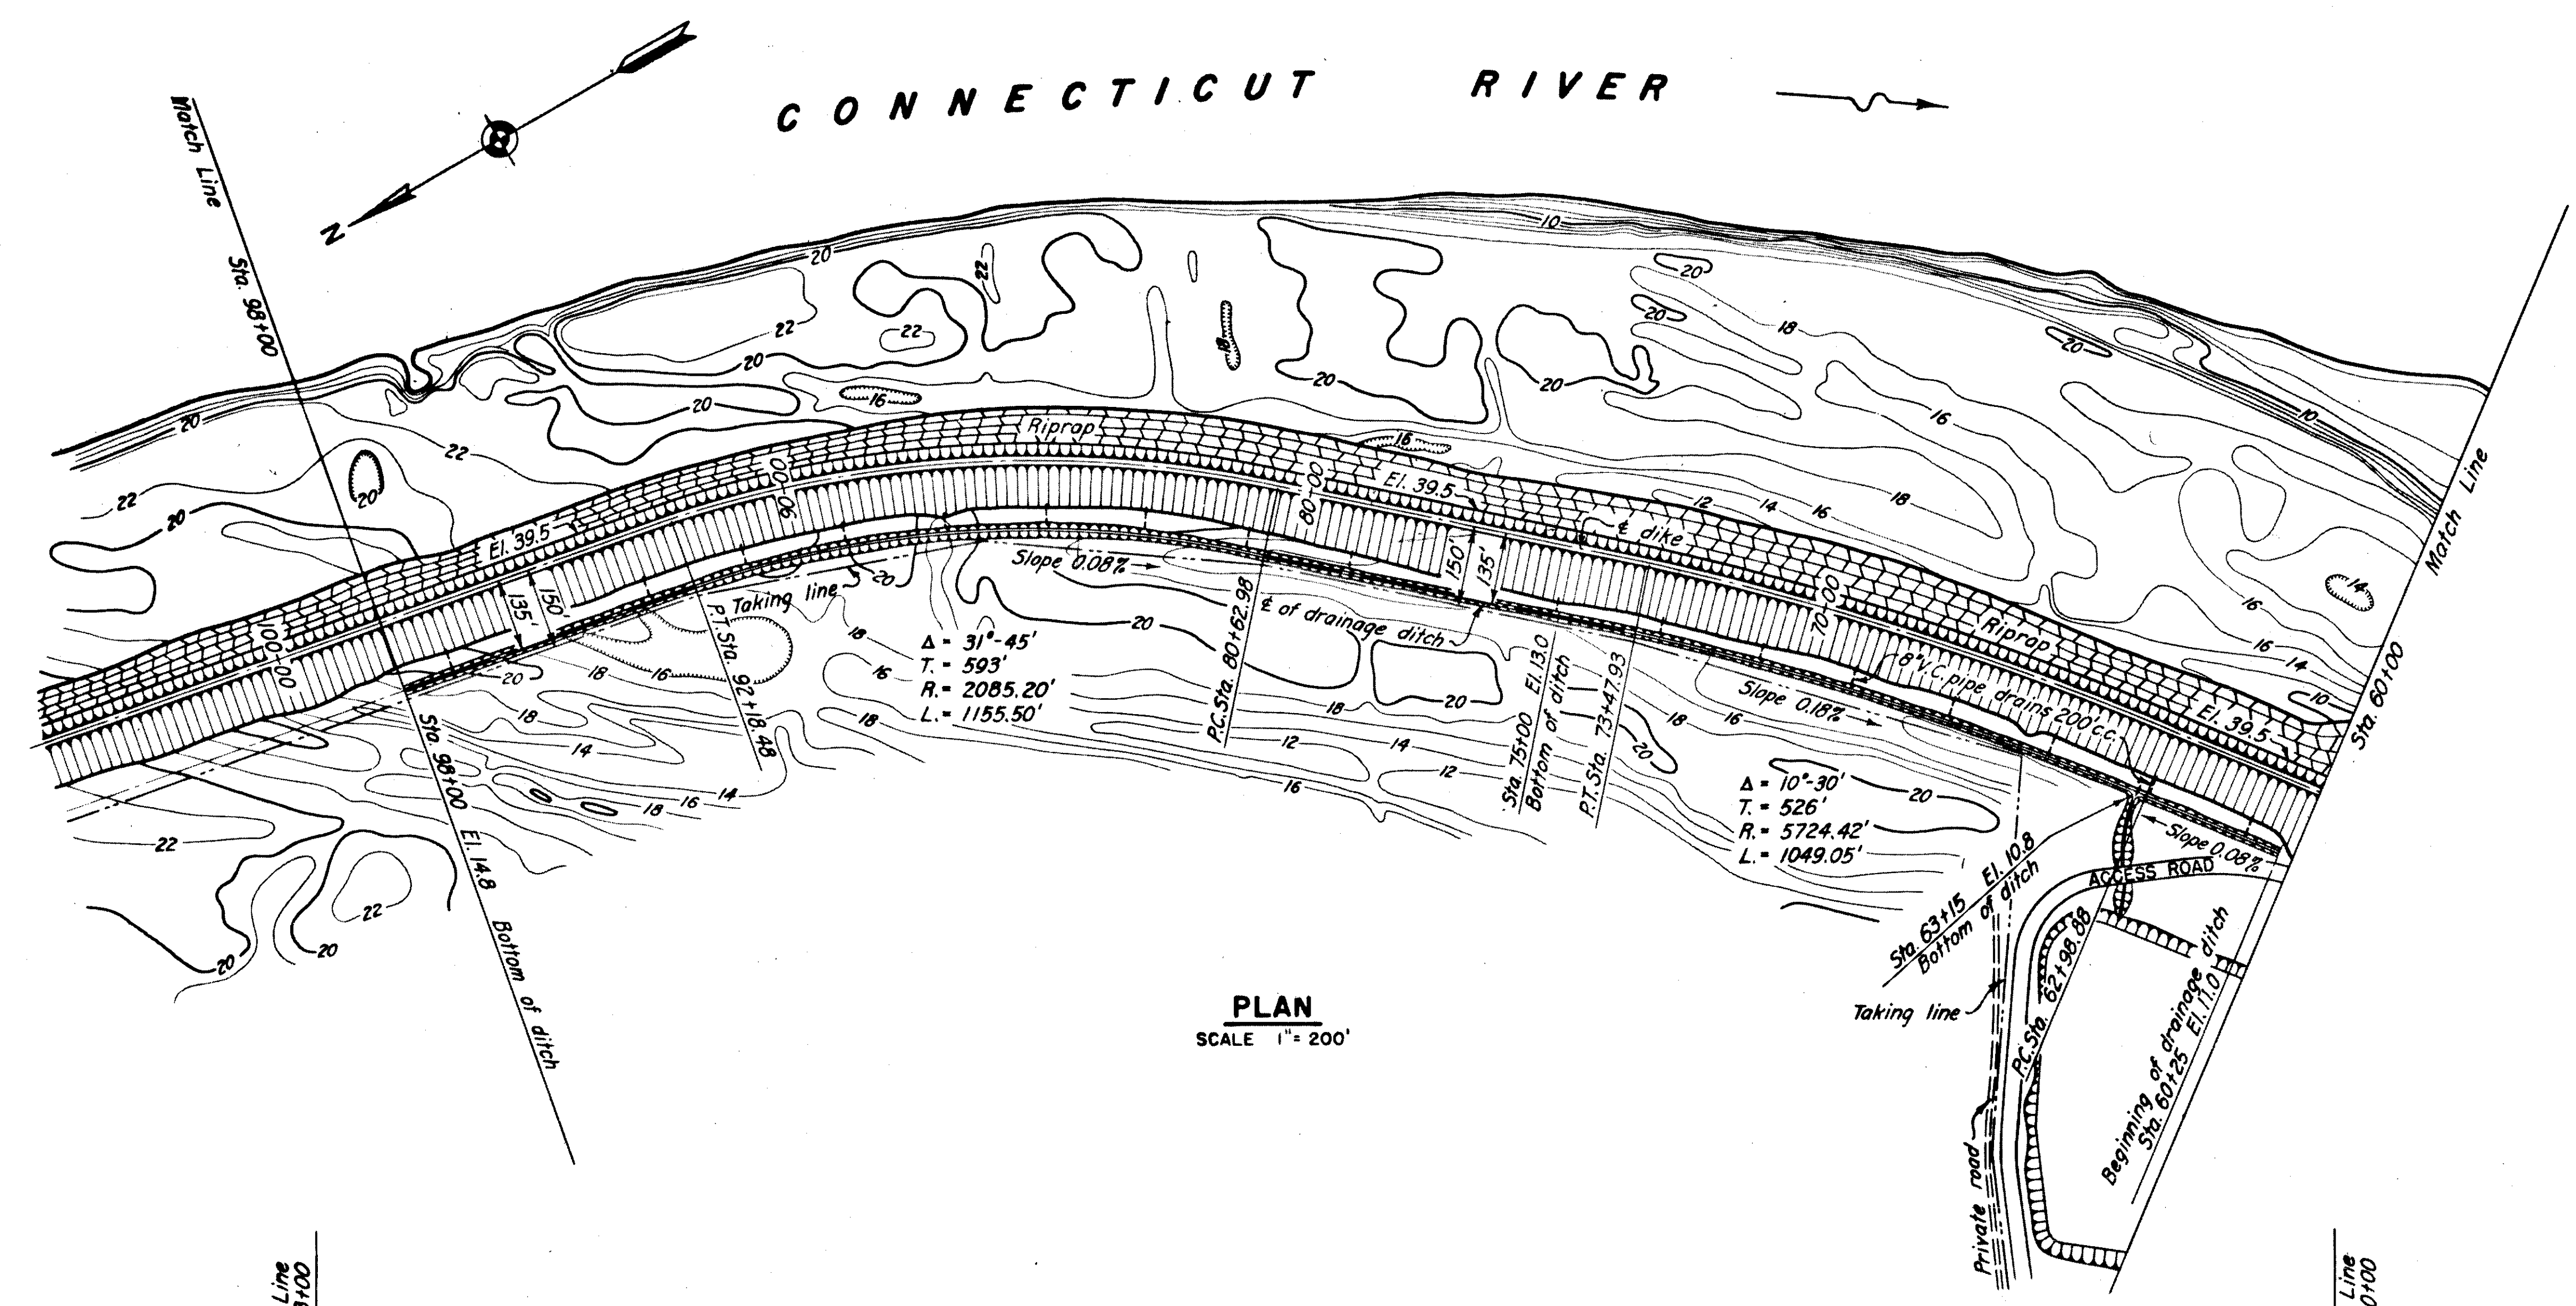

PLAN
SCALE 1" = 200'

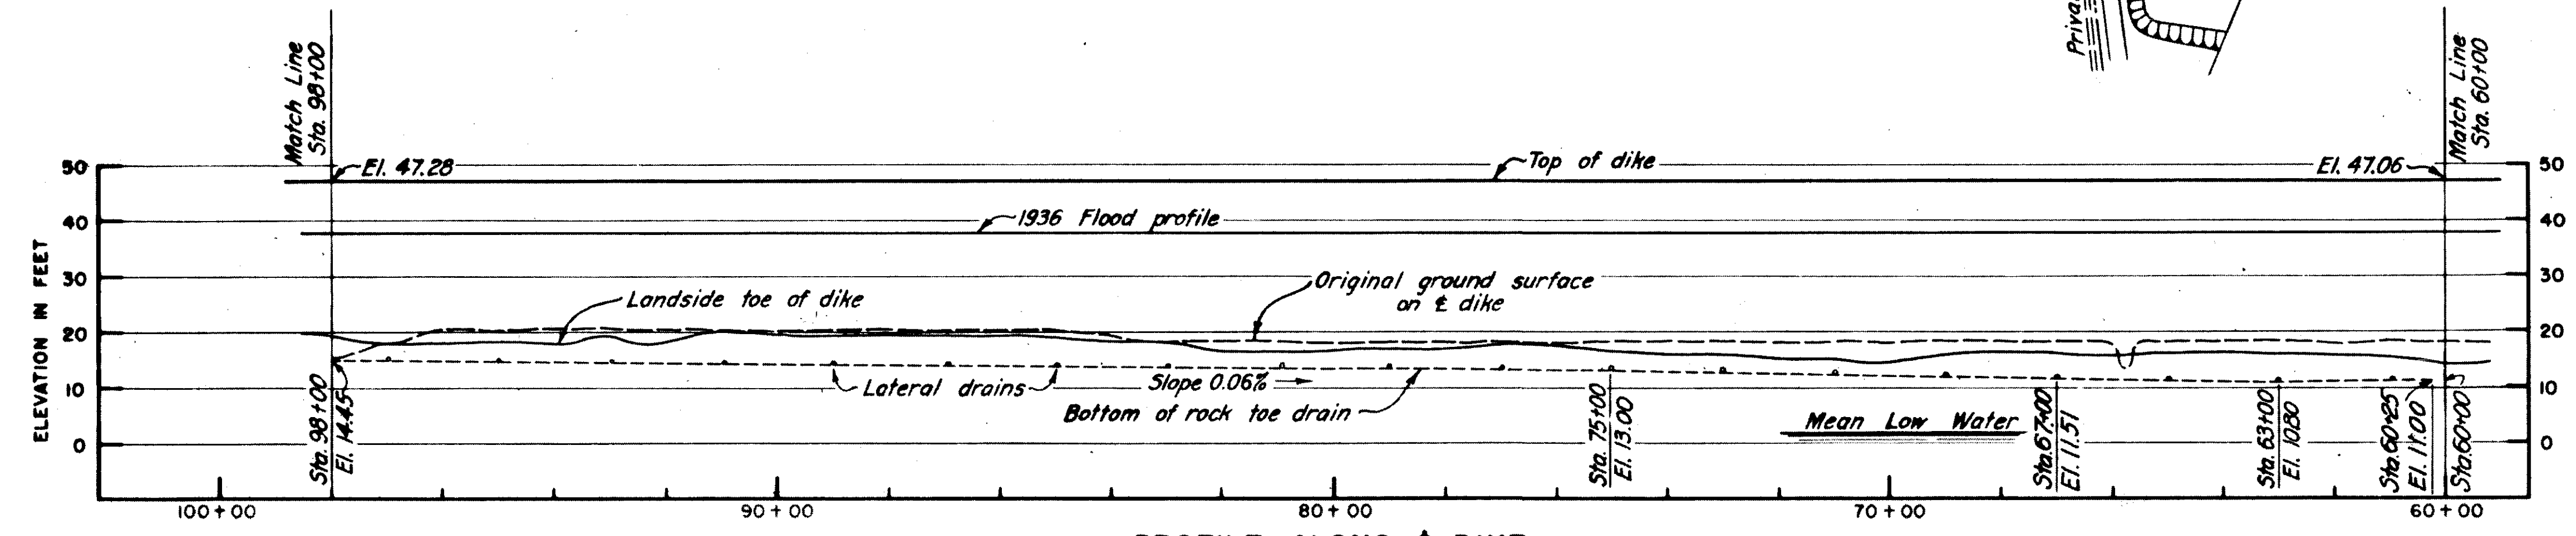

PROFILE ALONG DIKE
SCALE: HOR. 1" = 200'
VERT. 1" = 20'

SCHEDULE OF 8" V.C. LATERAL TILE DRAINS	
STATION	LIN. FT.
3 + 83	76
24 + 00	74
26 + 00	78
28 + 00	78
31 + 00	86
33 + 00	22
35 + 50	88
38 + 00	26
52 + 40	58
55 + 50	198
57 + 50	242
61 + 00	38
63 + 00	38
65 + 00	42
67 + 00	40
69 + 00	40
71 + 00	40
73 + 00	36
75 + 00	36
77 + 00	40
79 + 00	38
81 + 00	38
83 + 00	46
85 + 00	46
87 + 00	46
89 + 00	48
91 + 00	54
93 + 00	50
95 + 00	42
97 + 00	44
102 + 00	38
104 + 00	50
106 + 00	50
108 + 00	50
110 + 00	46
112 + 00	48
114 + 00	46
119 + 00	56
121 + 00	54
123 + 00	50
125 + 00	50
127 + 00	50
129 + 00	24
131 + 00	30
133 + 00	26
135 + 00	42
140 + 00	36
142 + 00	36
144 + 00	36
146 + 00	40
148 + 00	36
150 + 00	36
152 + 00	36

NOTE:
For general notes applying to details shown on this sheet see Sheet No. 12

12-31-45	As Built Revisions			
DATE	REVISION	REV. BY	CH. BY	AP. BY