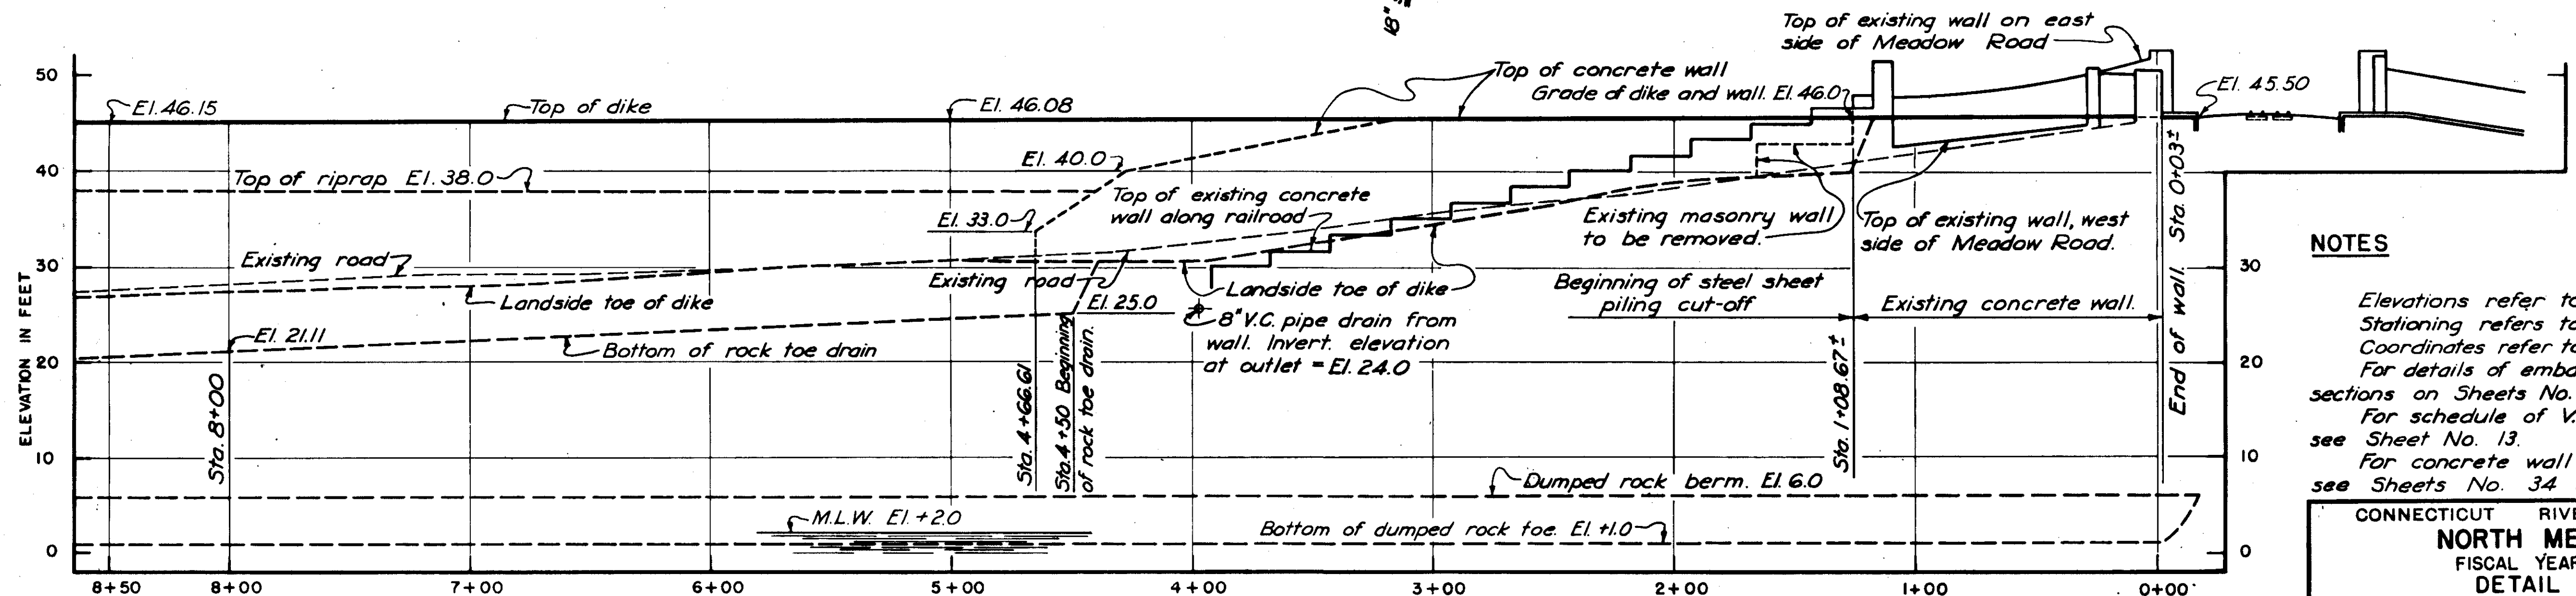
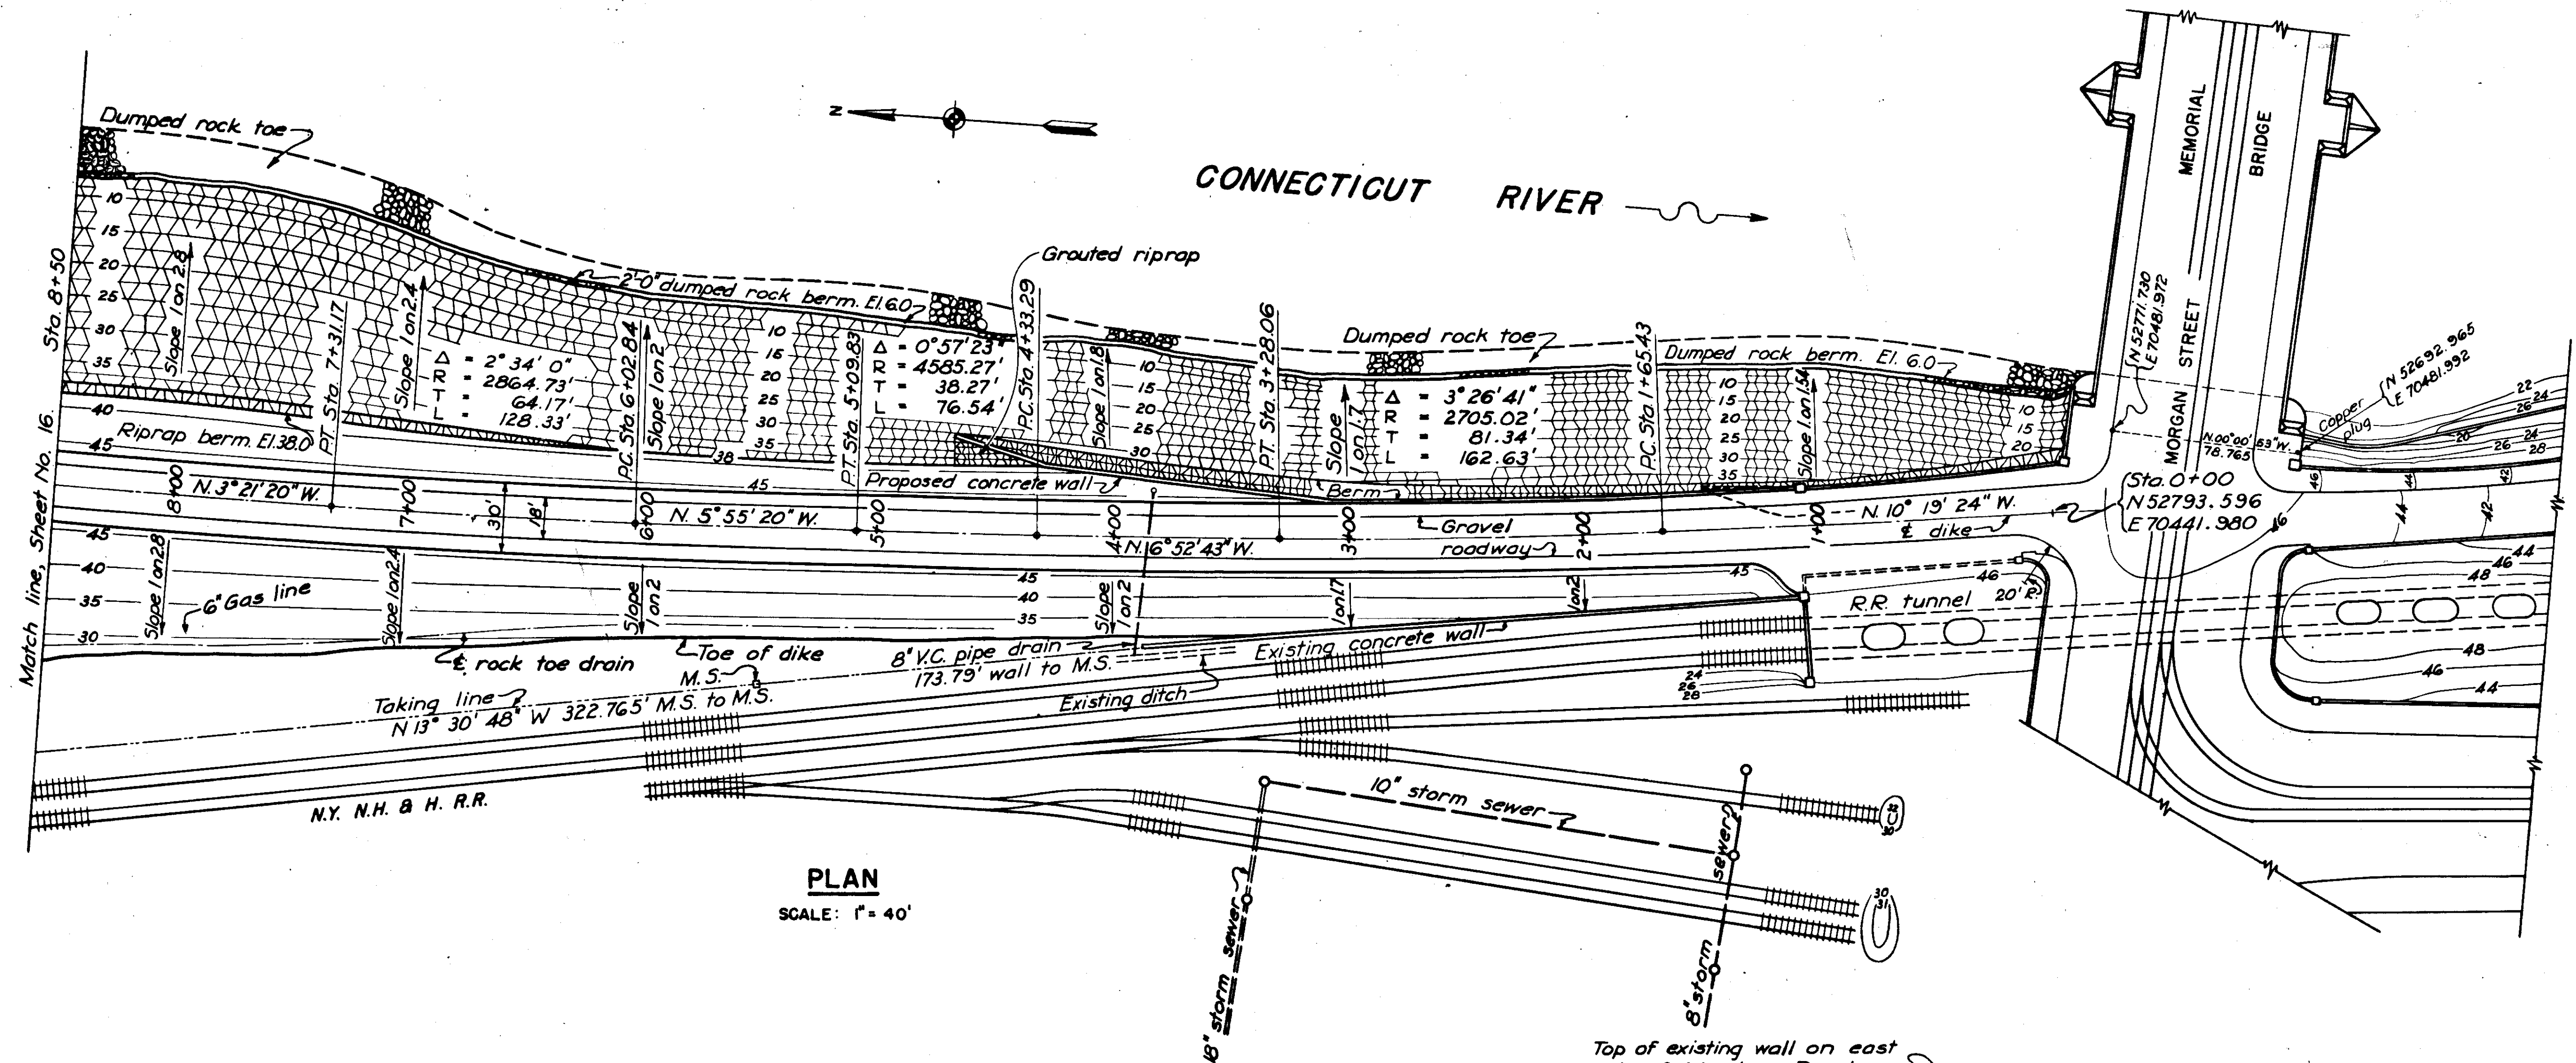


**NOTES**

Elevations refer to Mean Sea Level Datum.
 Stationing refers to E dike.
 Coordinates refer to City of Hartford system.
 For details of embankment see typical sections on Sheets No. 26, 27, 28 and 29.
 For schedule of V.C. pipe lateral drains see Sheet No. 13.
 For concrete wall alignment and details see Sheets No. 34 and 35.

CONNECTICUT RIVER FLOOD CONTROL
NORTH MEADOWS DIKE
 FISCAL YEAR 1939 SECTION
DETAIL PLAN NO. 1
 STA. 0+00 TO STA. 8+50
 HARTFORD, CONN.

CONNECTICUT RIVER FLOOD CONTROL
 IN 66 SHEETS SCALE: 1 IN. = 40 FT. SHEET NO. 15

U. S. ENGINEER OFFICE, PROVIDENCE, R. I., APRIL 1939

SUBMITTED: *W. B. Nichols* APPROVED: *W. B. Nichols*
 SENIOR ENGINEER PRINCIPAL ENGINEER
 HEAD, DESIGN SECTION CHIEF, F. C. ENGINEERING DIV.
 DESIGNED: *J. H. H. H.* DRAWN: *N. J. K.* FILE NO. CT-4-1444
 TRACED: *D. B. C.* CHECKED: *W. B. C.*

12-31-45	As Built Revisions				
DATE	REVISION	REV. BY	CK. BY	AP. BY	