



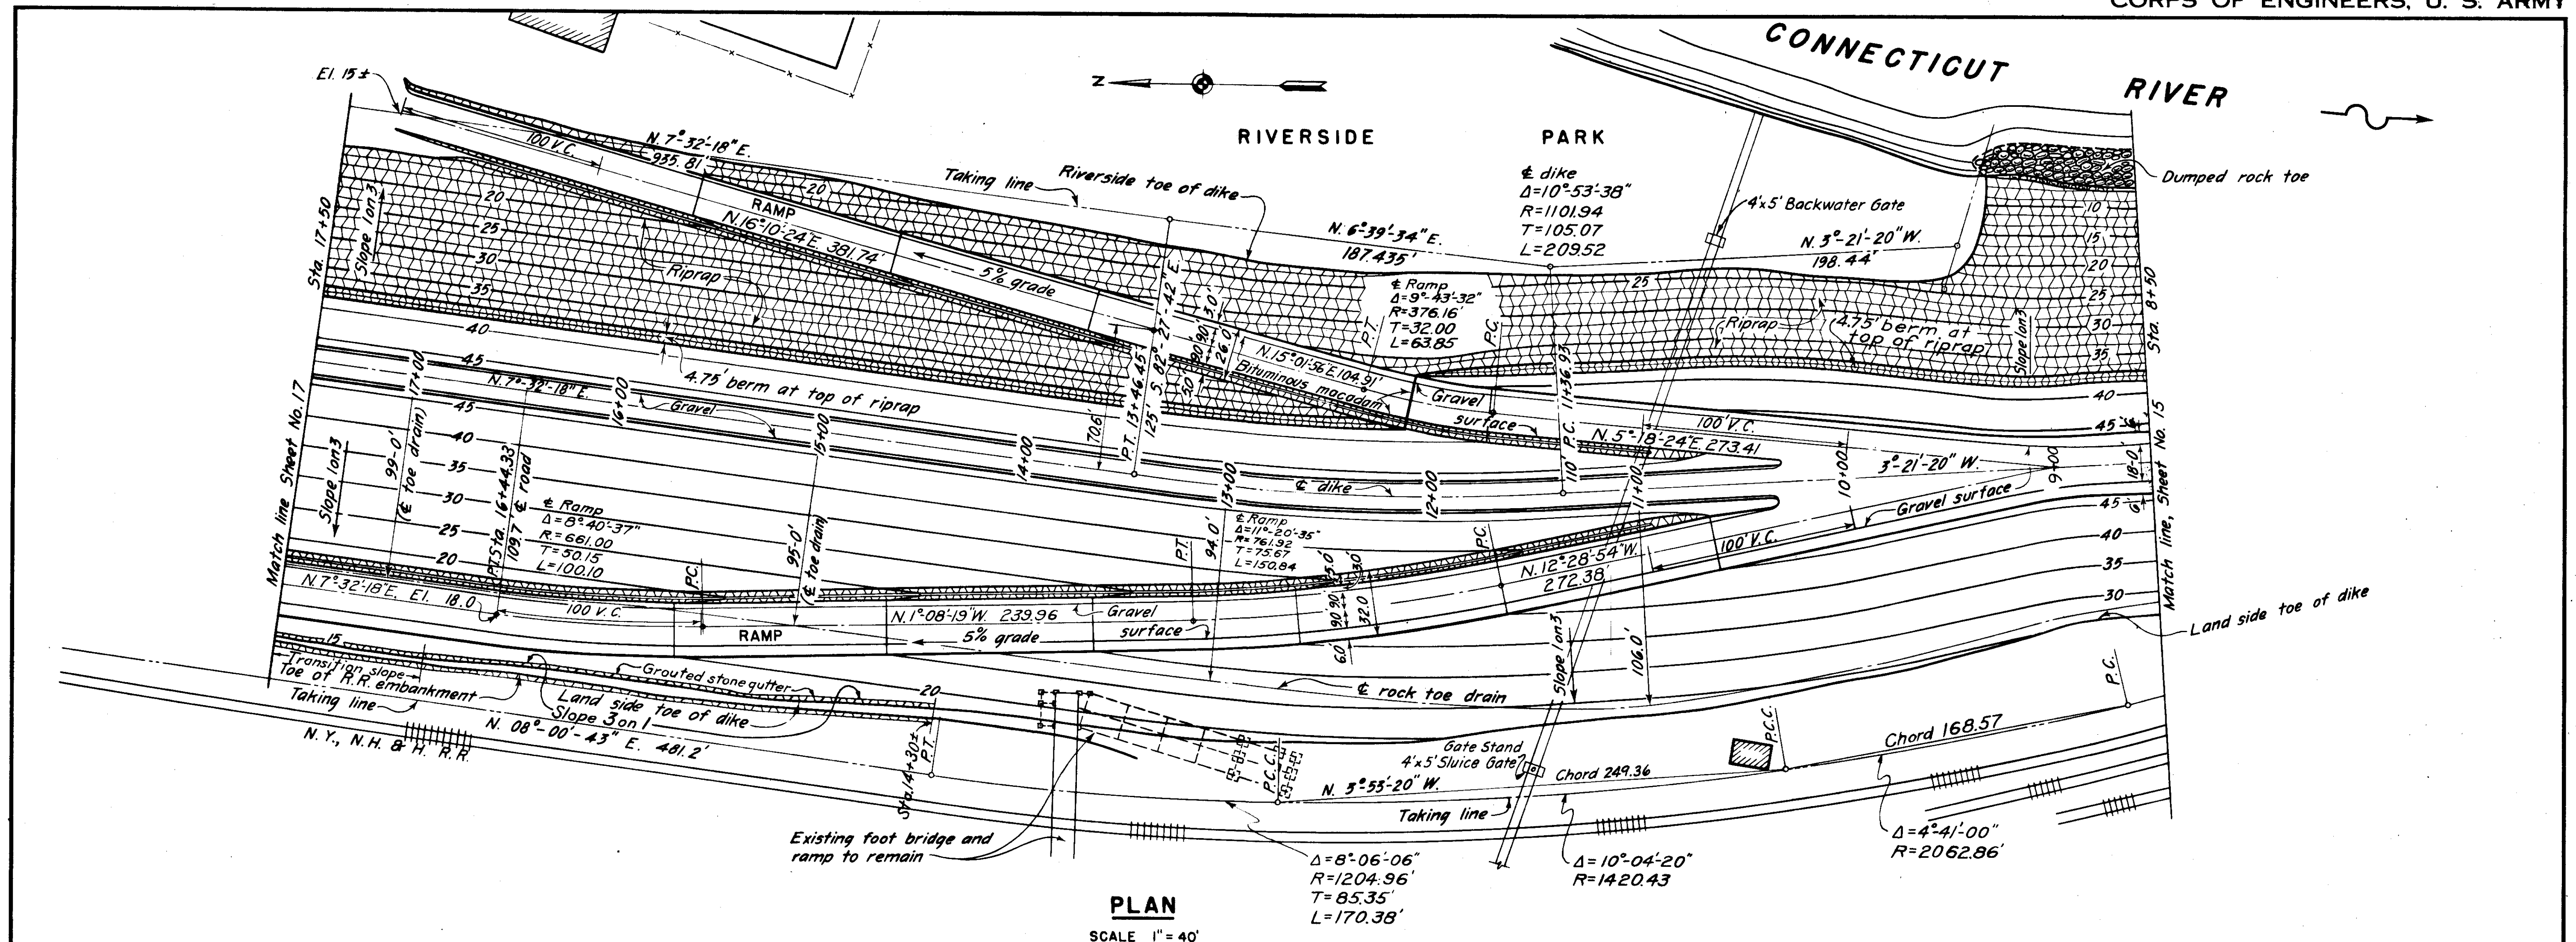

PLAN

SCALE 1" = 40'

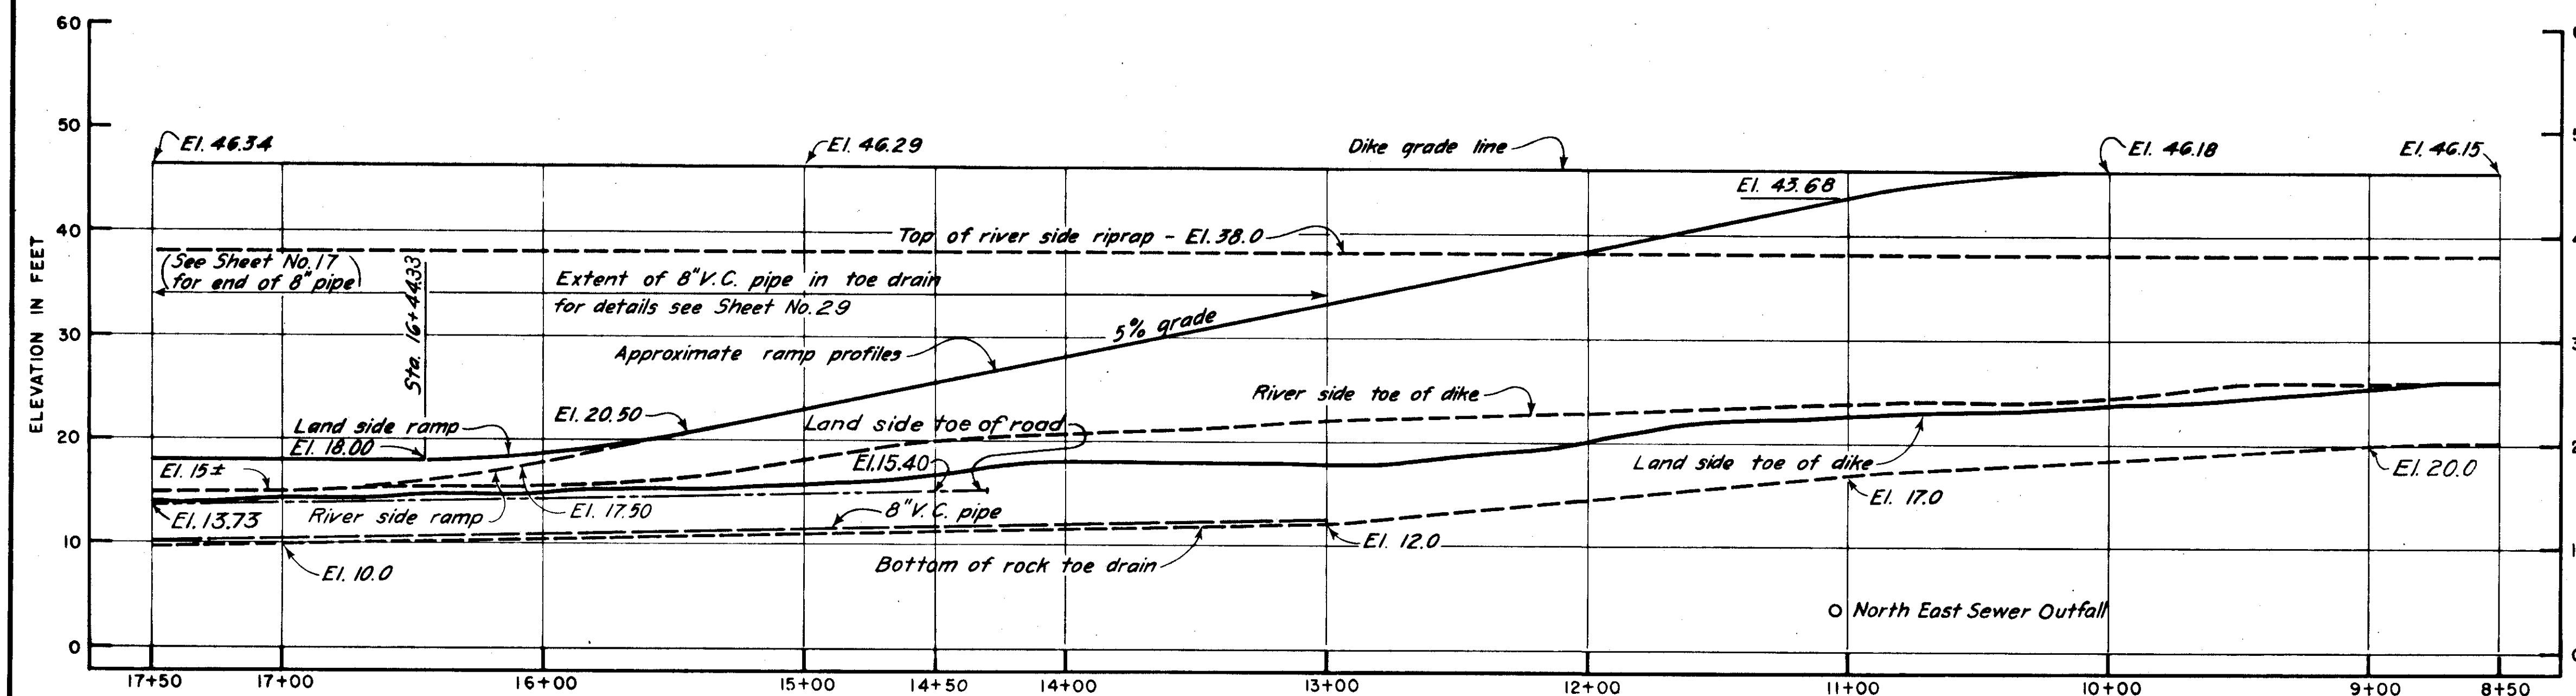

PROFILE

NOTES

For general notes applying to details shown on this sheet see Sheet No. 15

CONNECTICUT RIVER FLOOD CONTROL			
NORTH MEADOWS DIKE			
FISCAL YEAR 1939 SECTION			
DETAIL PLAN NO. 2			
STA. 8+50 TO STA. 17+50			
HARTFORD, CONN.			
CONNECTICUT RIVER			CONNECTICUT
IN 66 SHEETS	SCALE: 1" = 40 FT.		SHEET NO. 16
U. S. ENGINEER OFFICE, PROVIDENCE, R. I., APRIL 1939			
SUBMITTED:	APPROVAL RECOMMENDED:	APPROVED:	
by <i>B. N. Hiden</i>	by <i>J. D. Burns</i>	by <i>J. M. Haden</i>	
SENIOR ENGINEER	PRINCIPAL ENGINEER	DISTRICT ENGINEER	
HEAD, DESIGN SECTION	CHIEF, F. C. ENGINEERING DIV.		
DESIGNED: <i>J. Hartley</i>	DRAWN: M. B. M.	FILE NO. CT-4-1445	
TRACED: W. E. L.	CHECKED: W. E. L.		

DATE	REVISION	REVBY	CKBY	APBY
12-31-45	As Built Revisions			