




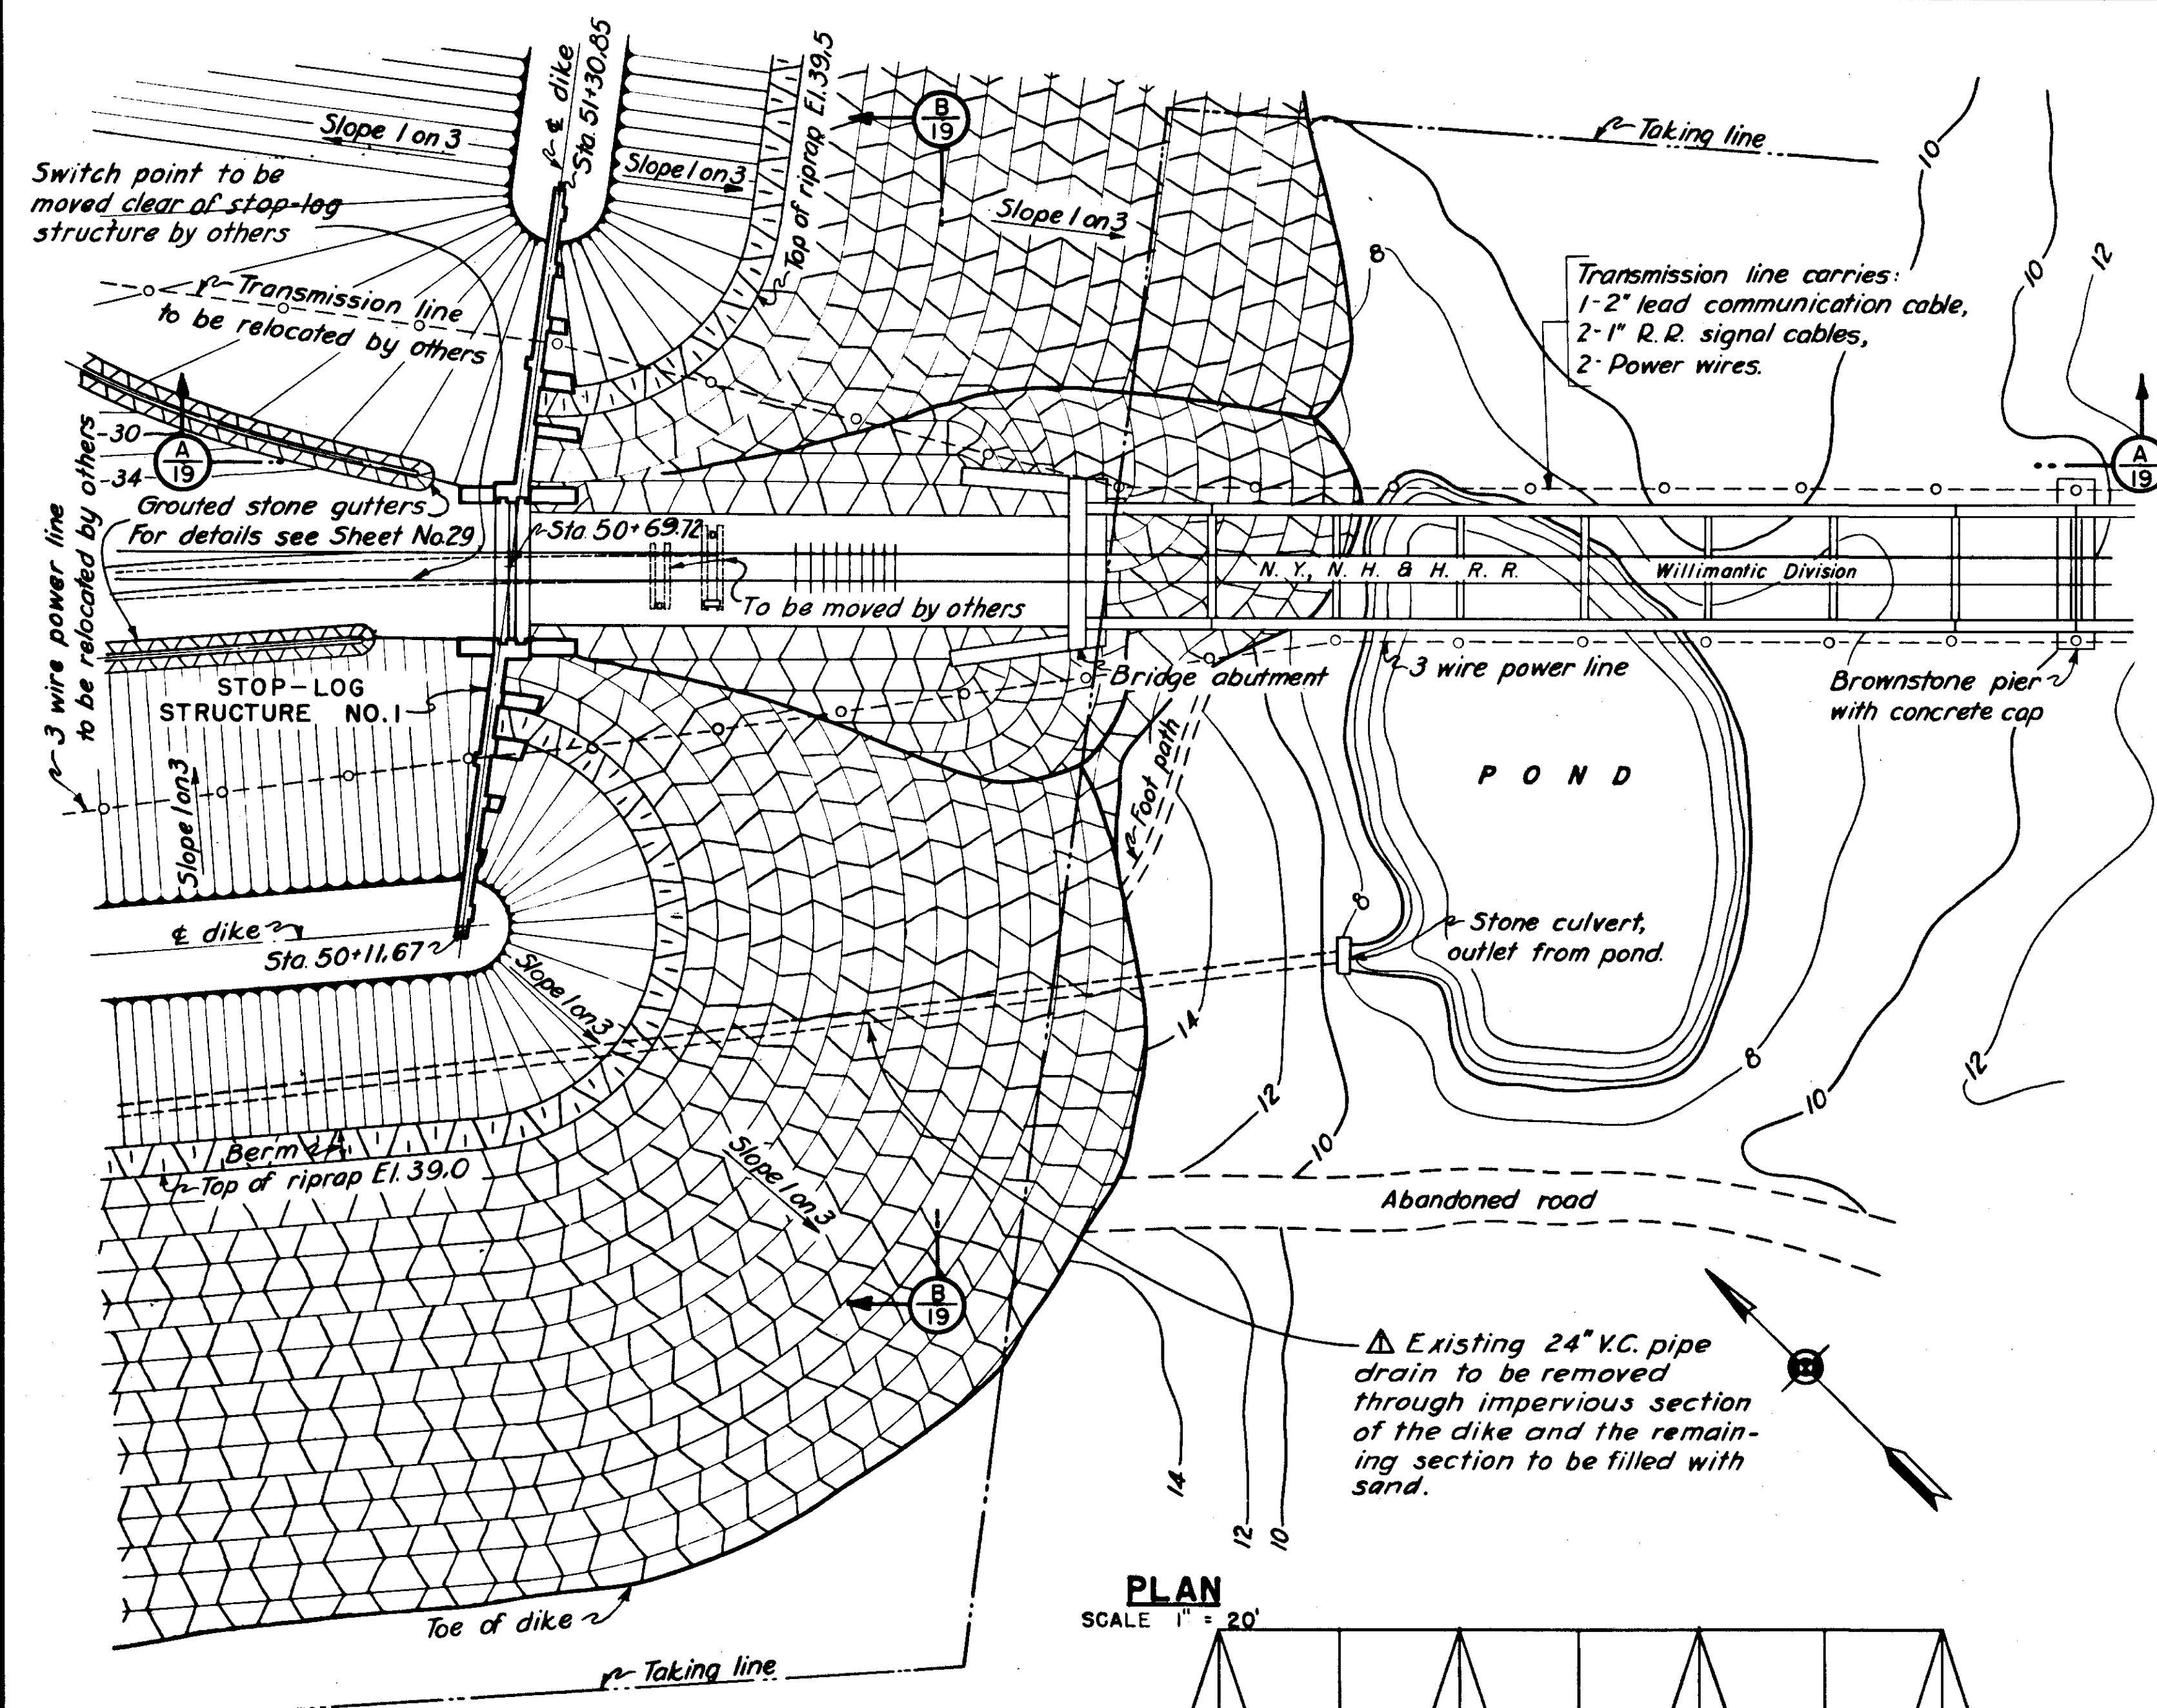


PLAN
SCALE 1" = 20'

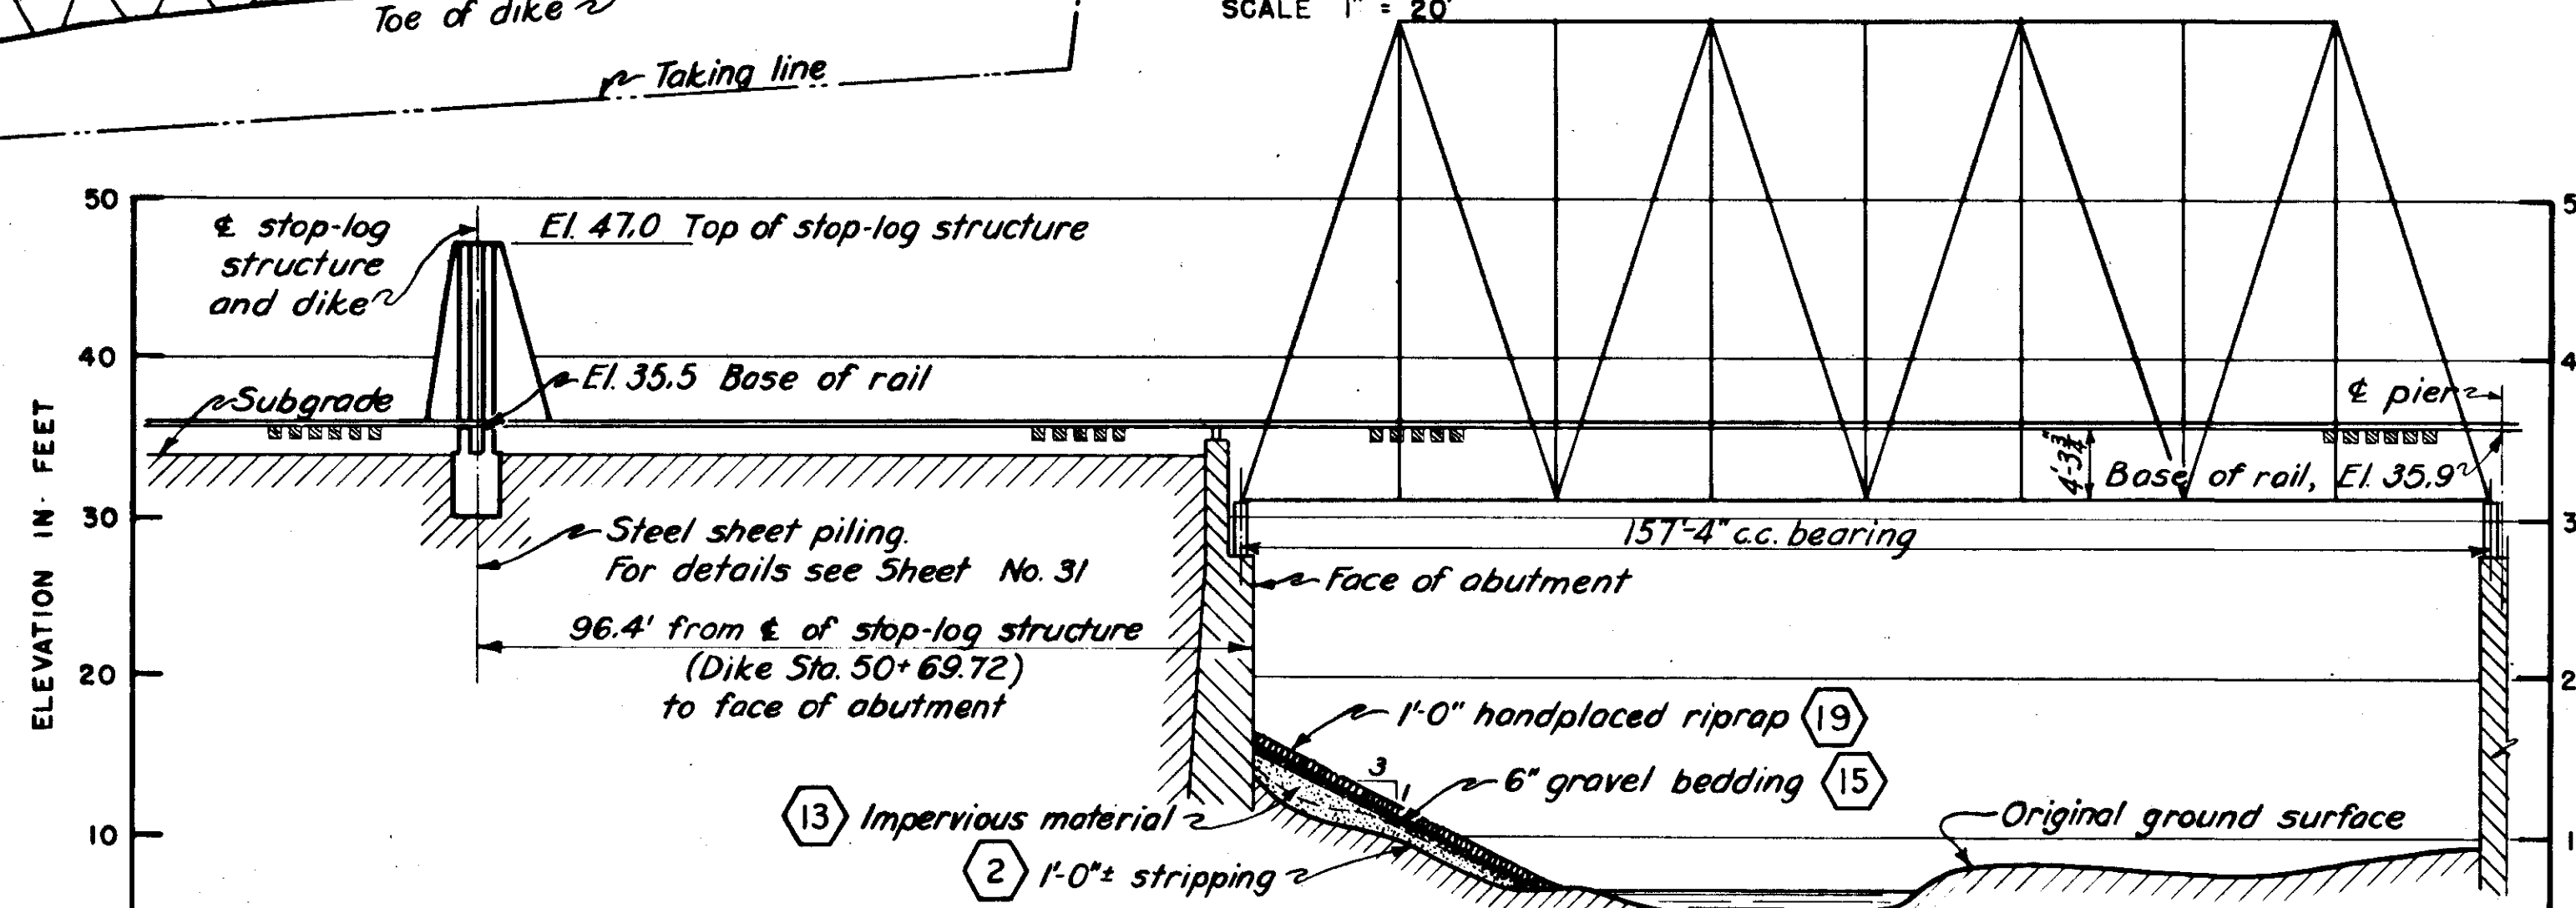

PROFILE ON C OF RAILROAD
SCALE HOR. 1" = 20'
VERT. 1" = 10'

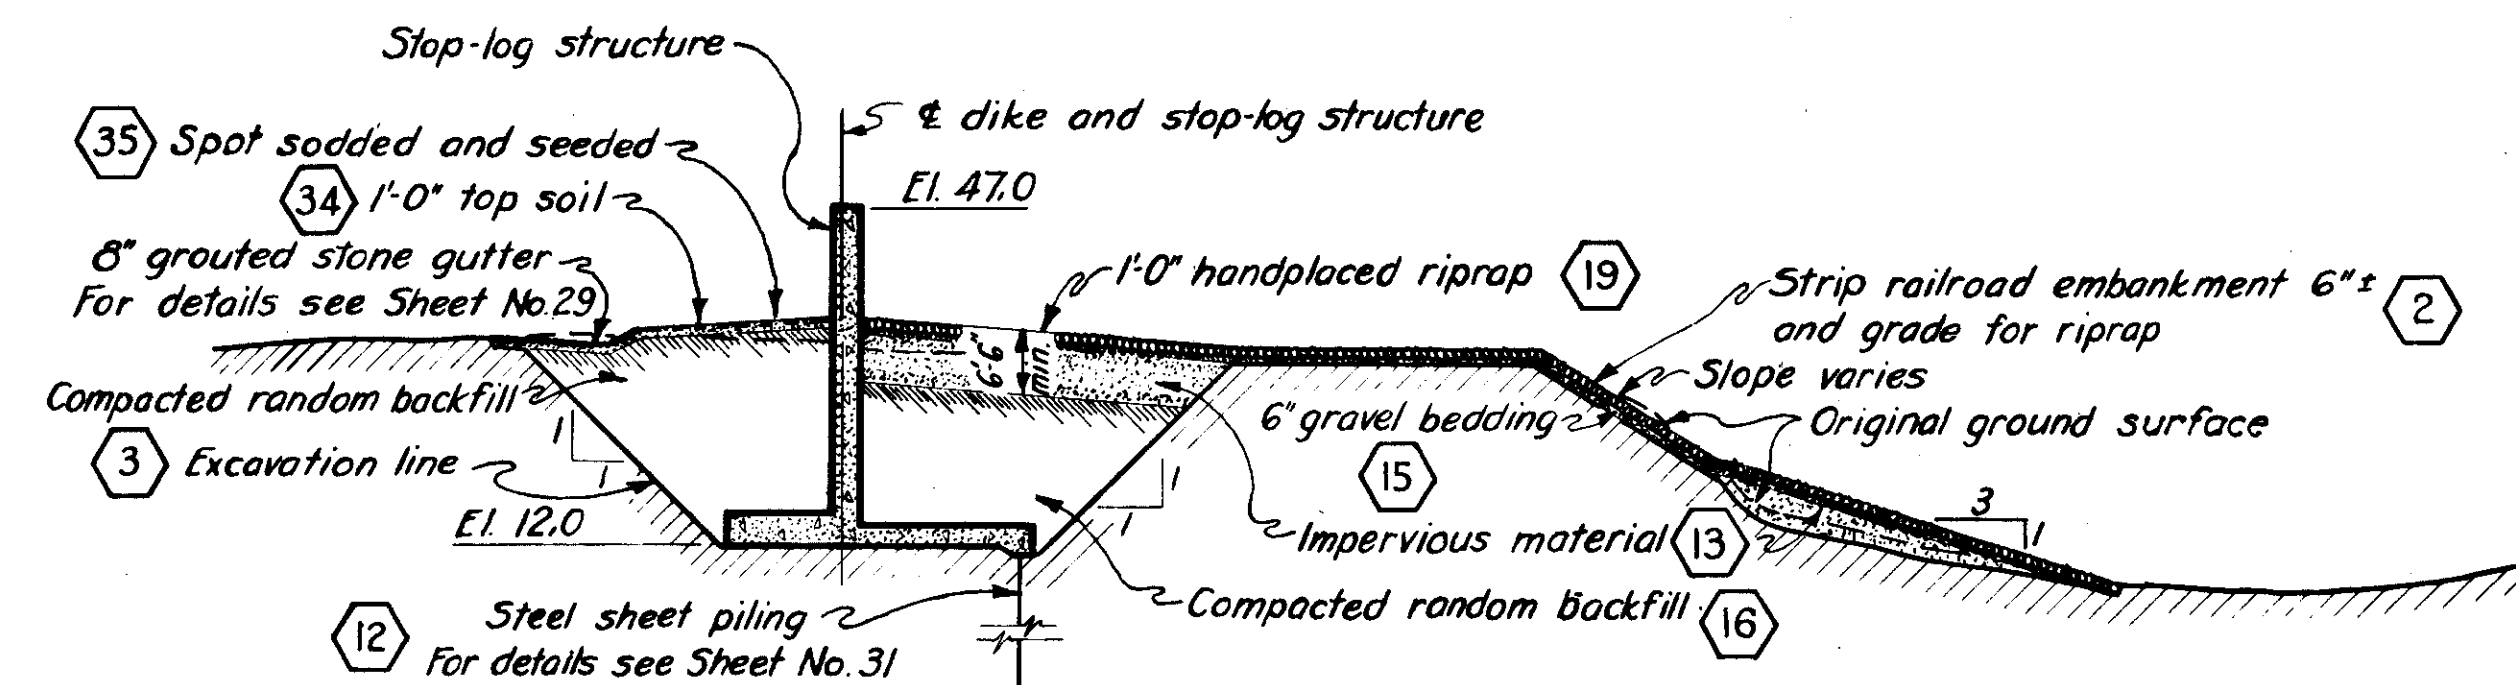

SECTION A-19
SCALE 1" = 20'

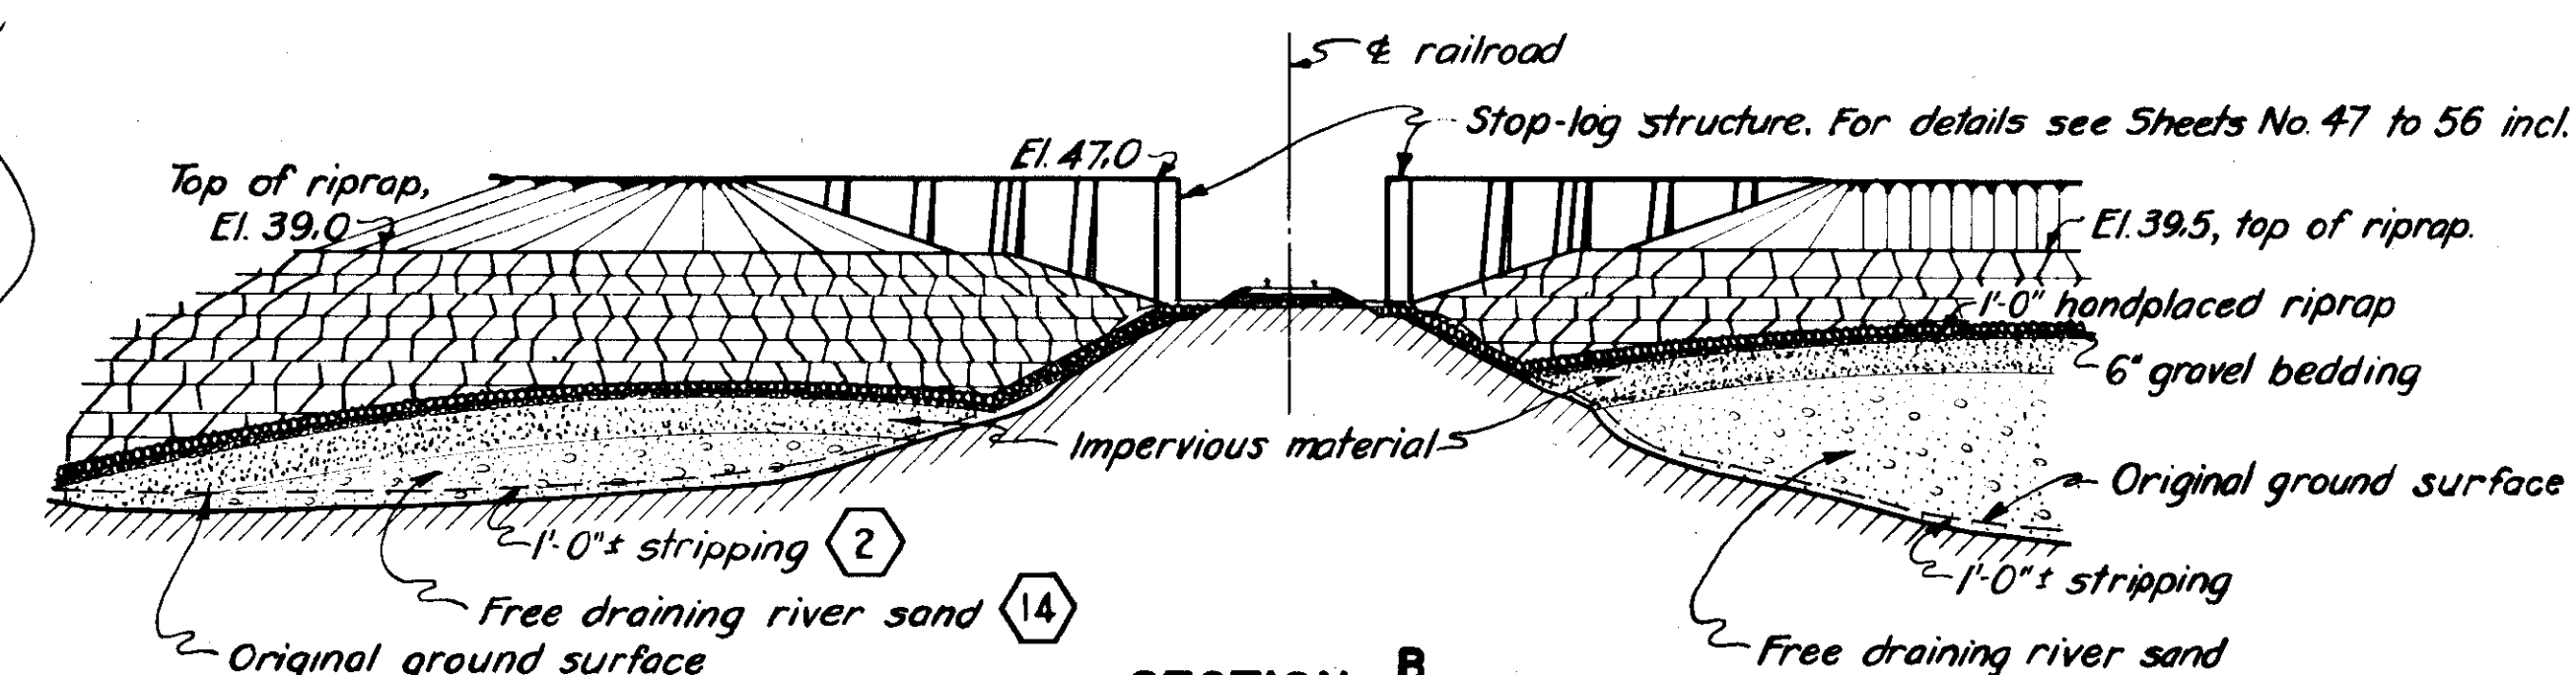

SECTION B-19
SCALE 1" = 20'

NOTES

- Elevations refer to Mean Sea Level Datum.
For general notes applying to details shown on this sheet see Sheet No. 15.
For details of Stop-log Structure No. 1 see Sheets No. 47 to 56 inclusive.
Figures in hexagons indicate item numbers under which payment will be made.

CONNECTICUT RIVER FLOOD CONTROL			
NORTH MEADOWS DIKE			
FISCAL YEAR 1939 SECTION			
DETAIL PLAN NO. 5			
STA. 50+00± TO STA. 51+30±			
HARTFORD, CONN.			
CONNECTICUT RIVER	SCALE 1 IN. = 20 FT.		CONNECTICUT
IN 66 SHEETS	0 20 40		SHEET NO. 19
U. S. ENGINEER OFFICE, PROVIDENCE, R. I., APRIL 1939			
SUBMITTED:	APPROVAL RECOMMENDED:	APPROVED:	
SENIOR ENGINEER	PRINCIPAL ENGINEER	COL. CORPS OF ENGINEERS	
HEAD DESIGN SECTION	CHIEF F. C. ENGINEERING DIV.	DISTRICT ENGINEER	
DESIGNED:	DRAWN:	P.D.M.	FILE NO. CT-4-1448
TRACED:	CHECKED:	K.H.W.	
KEY	DATE	REVISION (indicated by Δ)	REV. BY CK. BY AP. BY
	12/31/45	As-Built Revisions	
	8/1/39	24' drain shown and note added	