

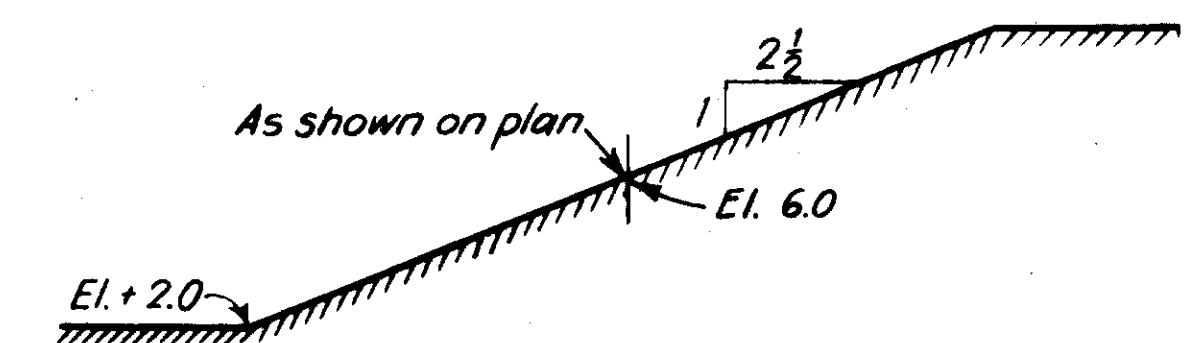
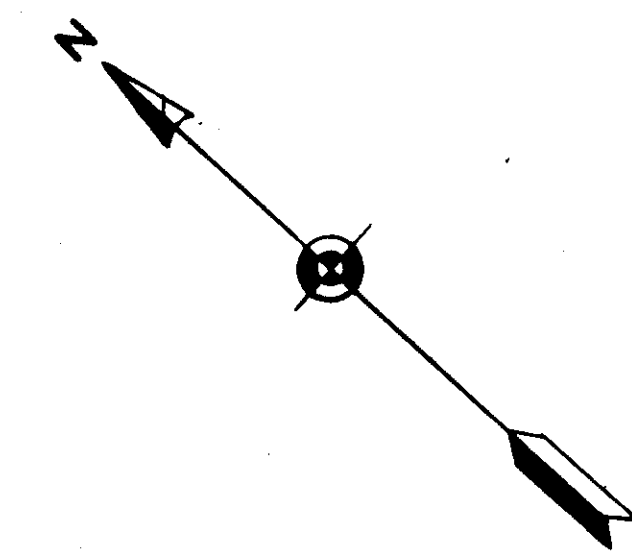


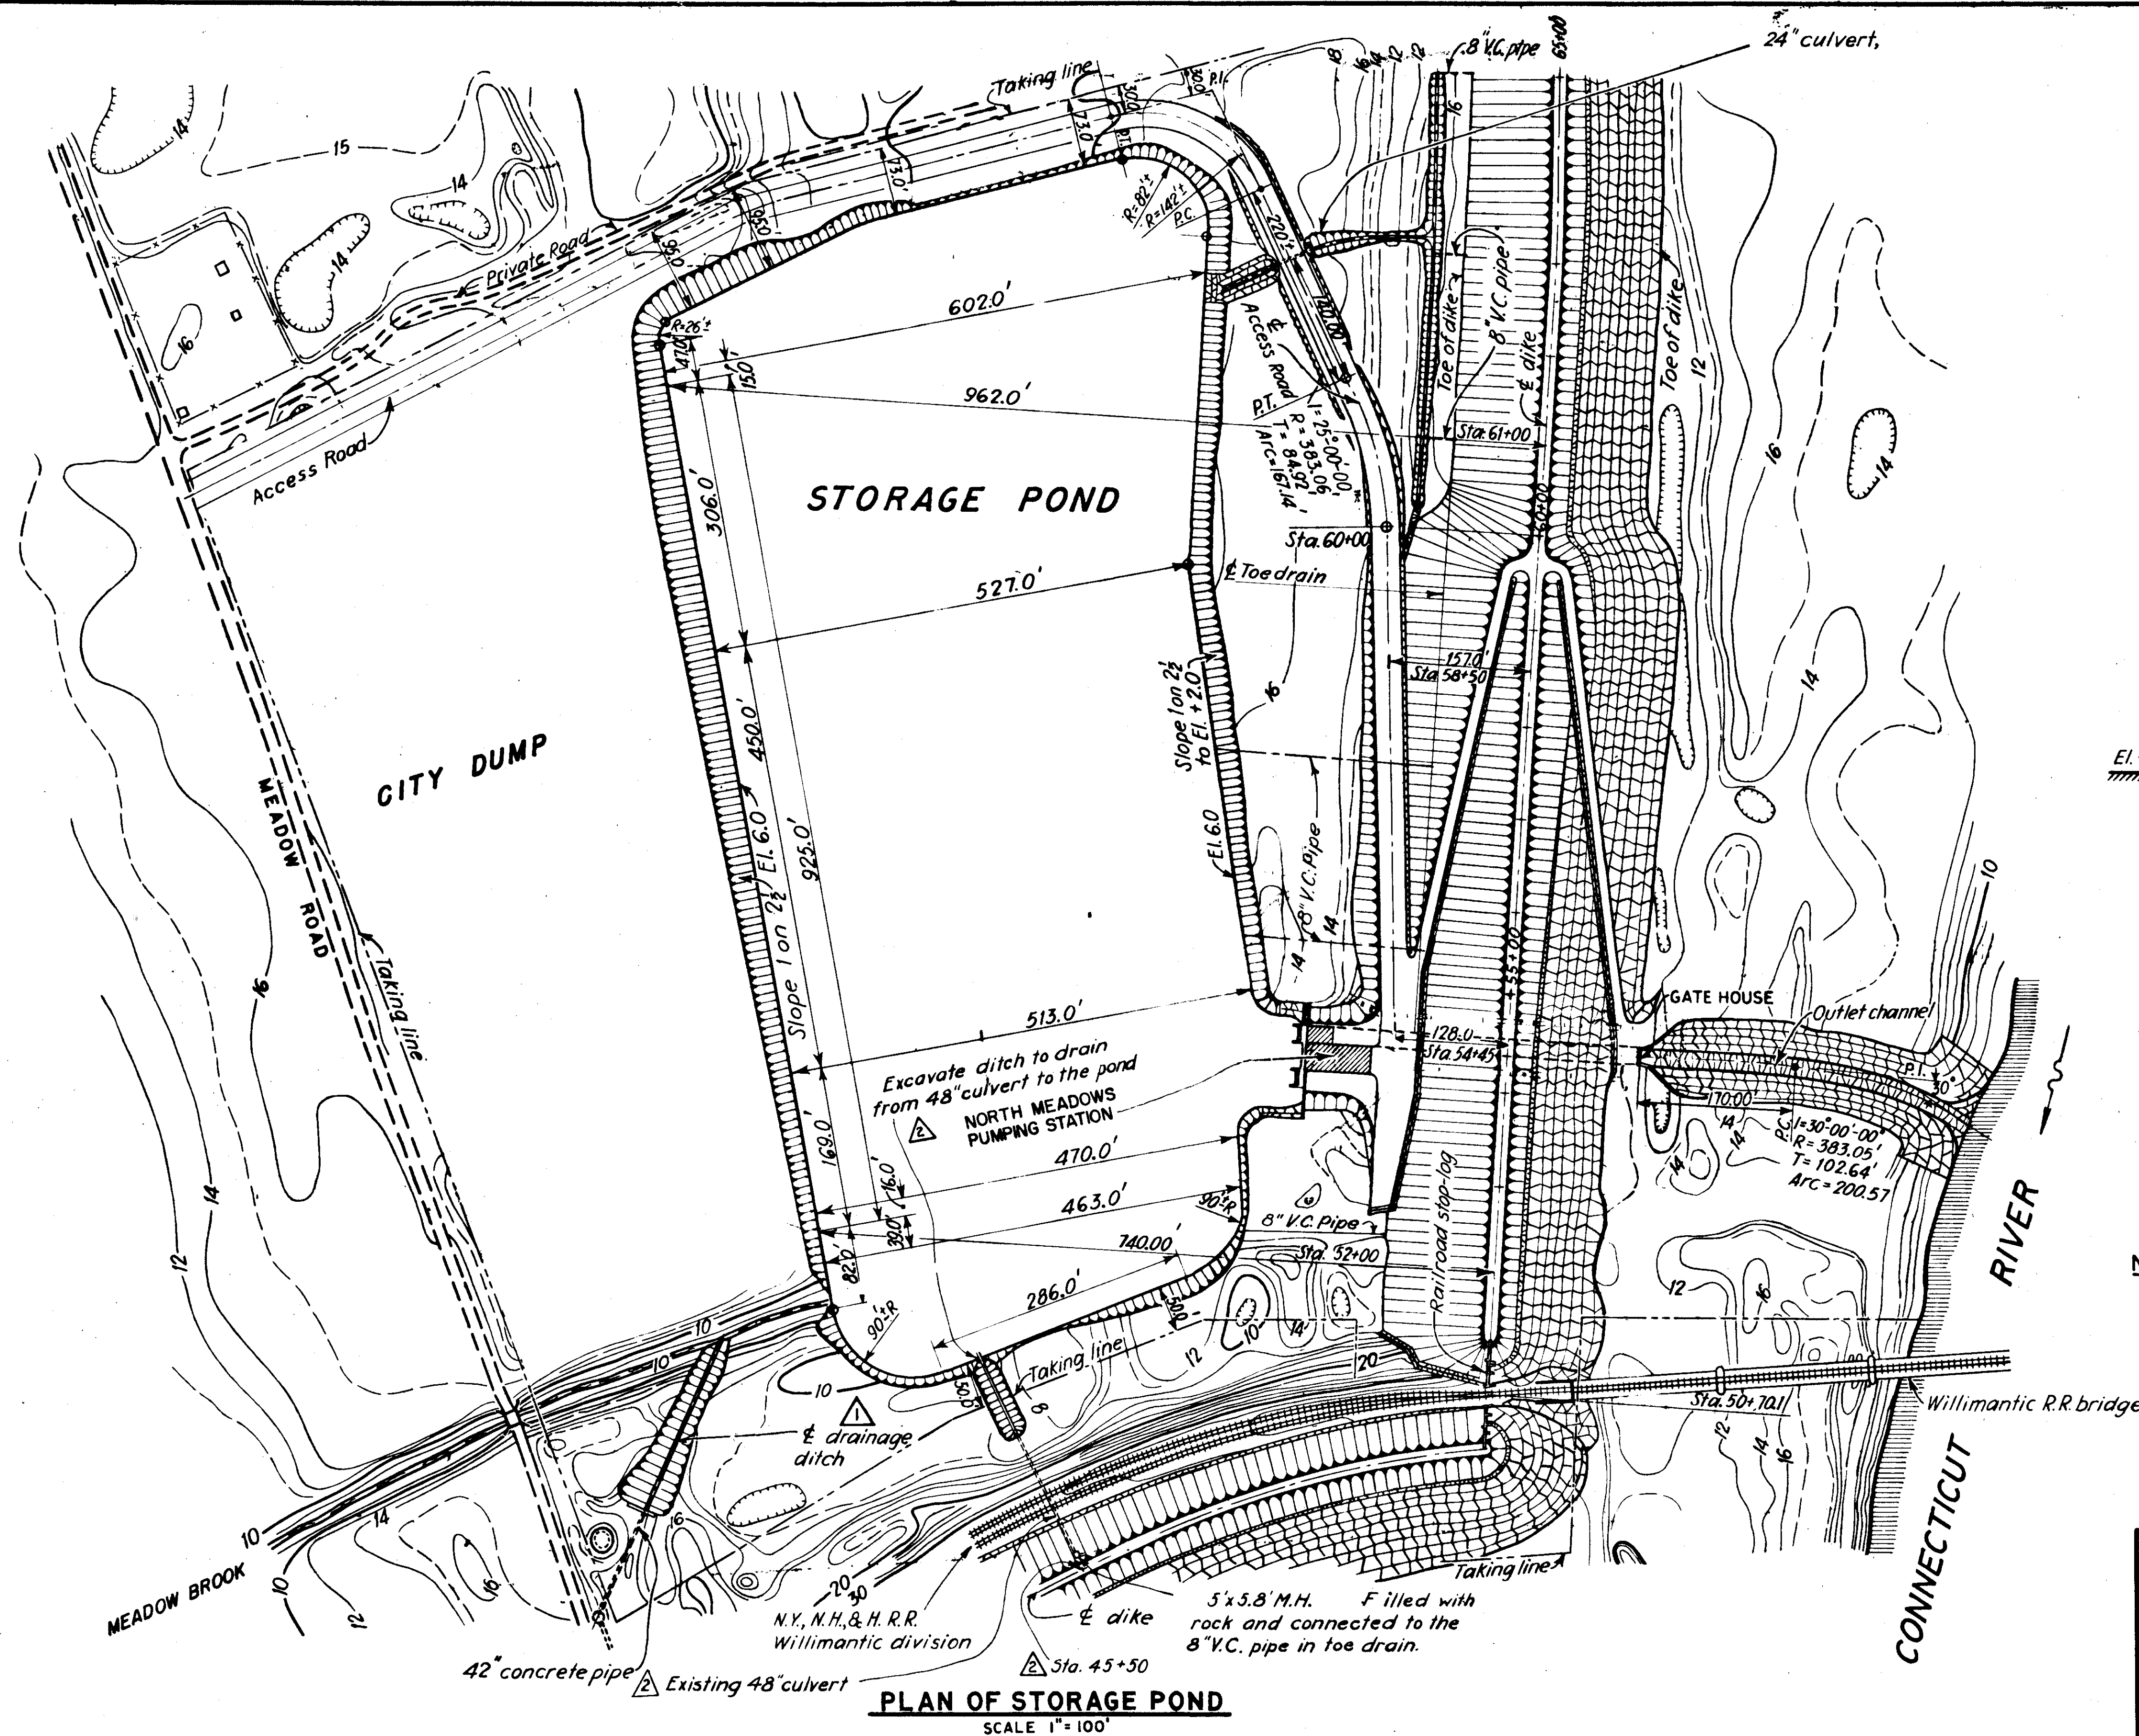

TYPICAL SLOPE SECTION

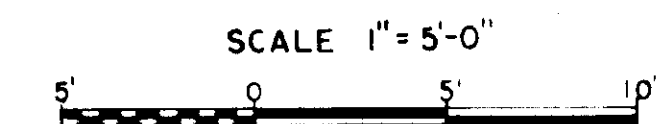

NOTES

Elevations refer to Mean Sea Level Datum

CONNECTICUT RIVER FLOOD CONTROL
NORTH MEADOWS DIKE
FISCAL YEAR 1939 SECTION
PUMPING STATION POND LAYOUT
HARTFORD, CONN.

CONNECTICUT RIVER FLOOD CONTROL
IN 66 SHEETS SCALE: 1" = 100 FT. SHEET NO. 20

U. S. ENGINEER OFFICE, PROVIDENCE, R. I., APRIL 1939

SUBMITTED: *[Signature]* APPROVED: *[Signature]*
HEAD, DESIGN SECTION CHIEF, F. C. ENGINEERING DIV. DISTRICT ENGINEER
DESIGNED: *[Signature]* DRAWN BY: P. D. M. TRACED BY: C. J. M. CHECKED BY: G. G. G.
FILE NO. CT-4-1449

12-31-45	As built revisions				
8/1/39	48" culvert, manhole, 24" drain, and notes added	JH	AS	JHB	
7/27/39	Drain relocated	JH	AS	JHB	
KEY	DATE	REVISION (Indicated by Δ)	REV. BY	CK. BY	AP. BY